



## 4 LANE TYPICAL CROSS SECTION Scale H 1:100 V 1:50

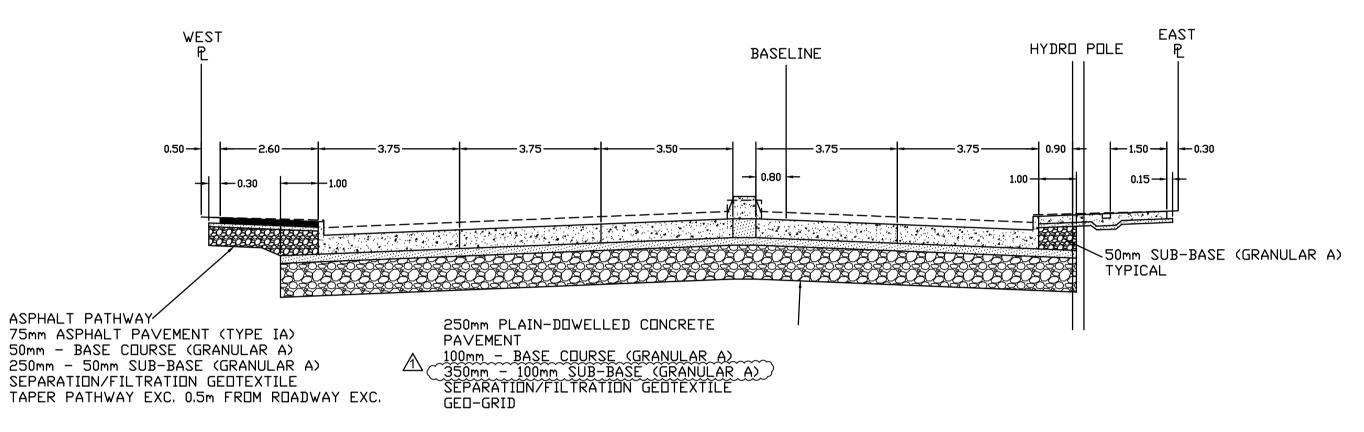


## **5 LANE TYPICAL CROSS-SECTION**

Scale H 1:100 V 1:50

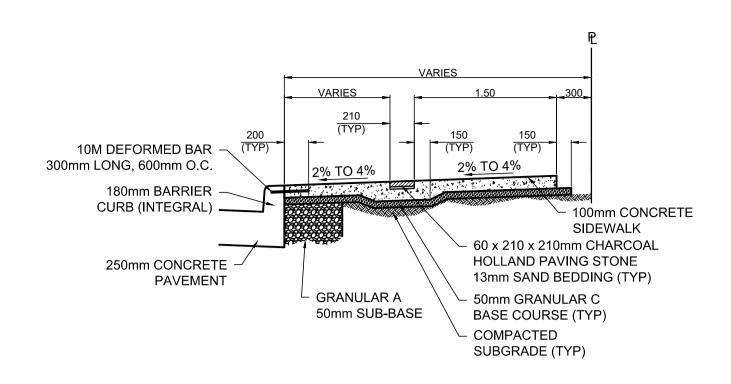

## 100mm CONCRETE SIDEWALK WITH PAVING BAND

NTS

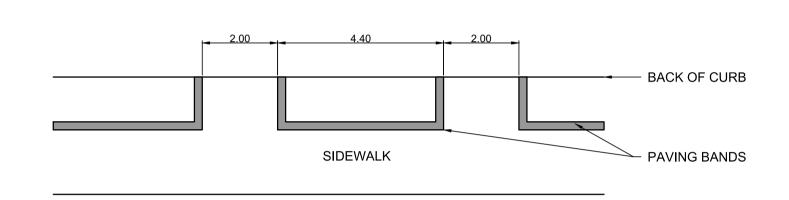

## **PAVING BAND AT BUS STOP**


NTS

ISSUED FOR TENDER
NOT FOR CONSTRUCTION
Date: 2021/01/27



METRIC
WHOLE NUMBERS INDICATE MILLIMETRES
DECIMALIZED NUMBERS INDICATE METRES

		_												
150 mm W.M.	WATERMAIN	150 mm W.M.		HYDRO		—- <del>×</del>	€ PROFILE		LOCATION APPROVED	B.M. 33-005 Rue Archibald W. side, N. of Kavanagh St., Tblt. in E. Conc. foundation of North American Van Lines Bldg. No. 501				
<b>\$</b>	HYDRANT	+		M.T.S.		<u>×</u>	WEST GUTTER		· •	ELEV. 232.087 Archibald, 0.5m S. & 0.5m below precast Conc. wall of N.E. Cor. of Bldg.				
⊗	VALVE	8		CONCRETE	<u> </u>	<b></b> ⊕	EAST GUTTER		UNDERGROUND STRUCTURES					
300mm L.D.S.	LAND DRAINAGE SEWER	300mm L.D.S.		ASPHALT		⊗	N/W PROPERTY LINE		SUPV. U/G STRUCTURES DATE					
250mm W.W.S.	WASTEWATER SEWER	250mm W.W.S.		PROPERTY LINE		⊗	S/E PROPERTY LINE		COMMITTEE				1	
0	MANHOLE	•	<del>-</del>	SURVEY BAR					NOTE:		DESIGNED BY	RC	CHECKED BY BC	
	CATCH BASIN		235.750	ELEVATION	235.750				LOCATION OF UNDERGROUND STRUCTURES AS					
$\nabla$	CURB INLET	▼	<b>●</b> 500ø	TREE					SHOWN ARE BASED ON THE BEST INFORMATION AVAILABLE. BUT NO GUARANTEE IS GIVEN		DRAWN BY	RAM	APPROVED BY	
<del></del>	JUNCTIONS	<del></del>		SIDEWALK RAMP					THAT ALL EXISTING UTILITIES ARE SHOWN OR	ADDENDUM #2 02/09/2021 RC	LIOD COALE:	1:250	RELEASED FOR	
	CULVERT			CONCRETE SIDEWALK	***************************************				THAT THE GIVEN LOCATIONS ARE EXACT.  CONFIRMATION OF EXISTENCE AND EXACT	0 ISSUED FOR TENDER 01/27/2021 RAM	HOR. SCALE: VERTICAL:	1.250 N/A	CONSTRUCTION BY:	F
	GAS		×	FENCE					LOCATION OF ALL SERVICES MUST BE OBTAINED FROM THE INDIVIDUAL UTILITIES	A ISSUED FOR REVIEW 10/21/2020 RAM	VERTIONE.	14// (		
EXISTING	LEGEND - PLAN	PROPOSED	EXISTING	LEGEND - PLAN	PROPOSED	EXISTING	LEGEND - PROFILE	PROPOSED	BEFORE PROCEEDING WITH CONSTRUCTION.	NO. REVISIONS DATE BY	DATE 202	21/01/27	DATE	

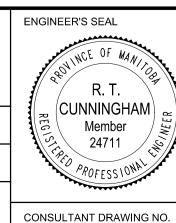

CT-14

	0			_			Ν	IPEG	
	Winnipeg	PUBLIC ENGINEE	WORKS ERING I	S DE	EPARTI SION	MENT			
2019-2022 ARCHIBALD STREET PAVEMENT RENEWALS								TY DRAWING NUME P-3529-31	BEF

2019-2022 ARCHIBALD STREET PAVEMENT RENEWALS	CITY DRAWING NUMBER P-3529-31				
2021 ARCHIBALD STREET PAVEMENT RECONSTRUCTION	SHEET OF 24				
ARCHIBALD STREET					
CROSS SECTIONS AND DETAILS					