



FLOOR PLAN

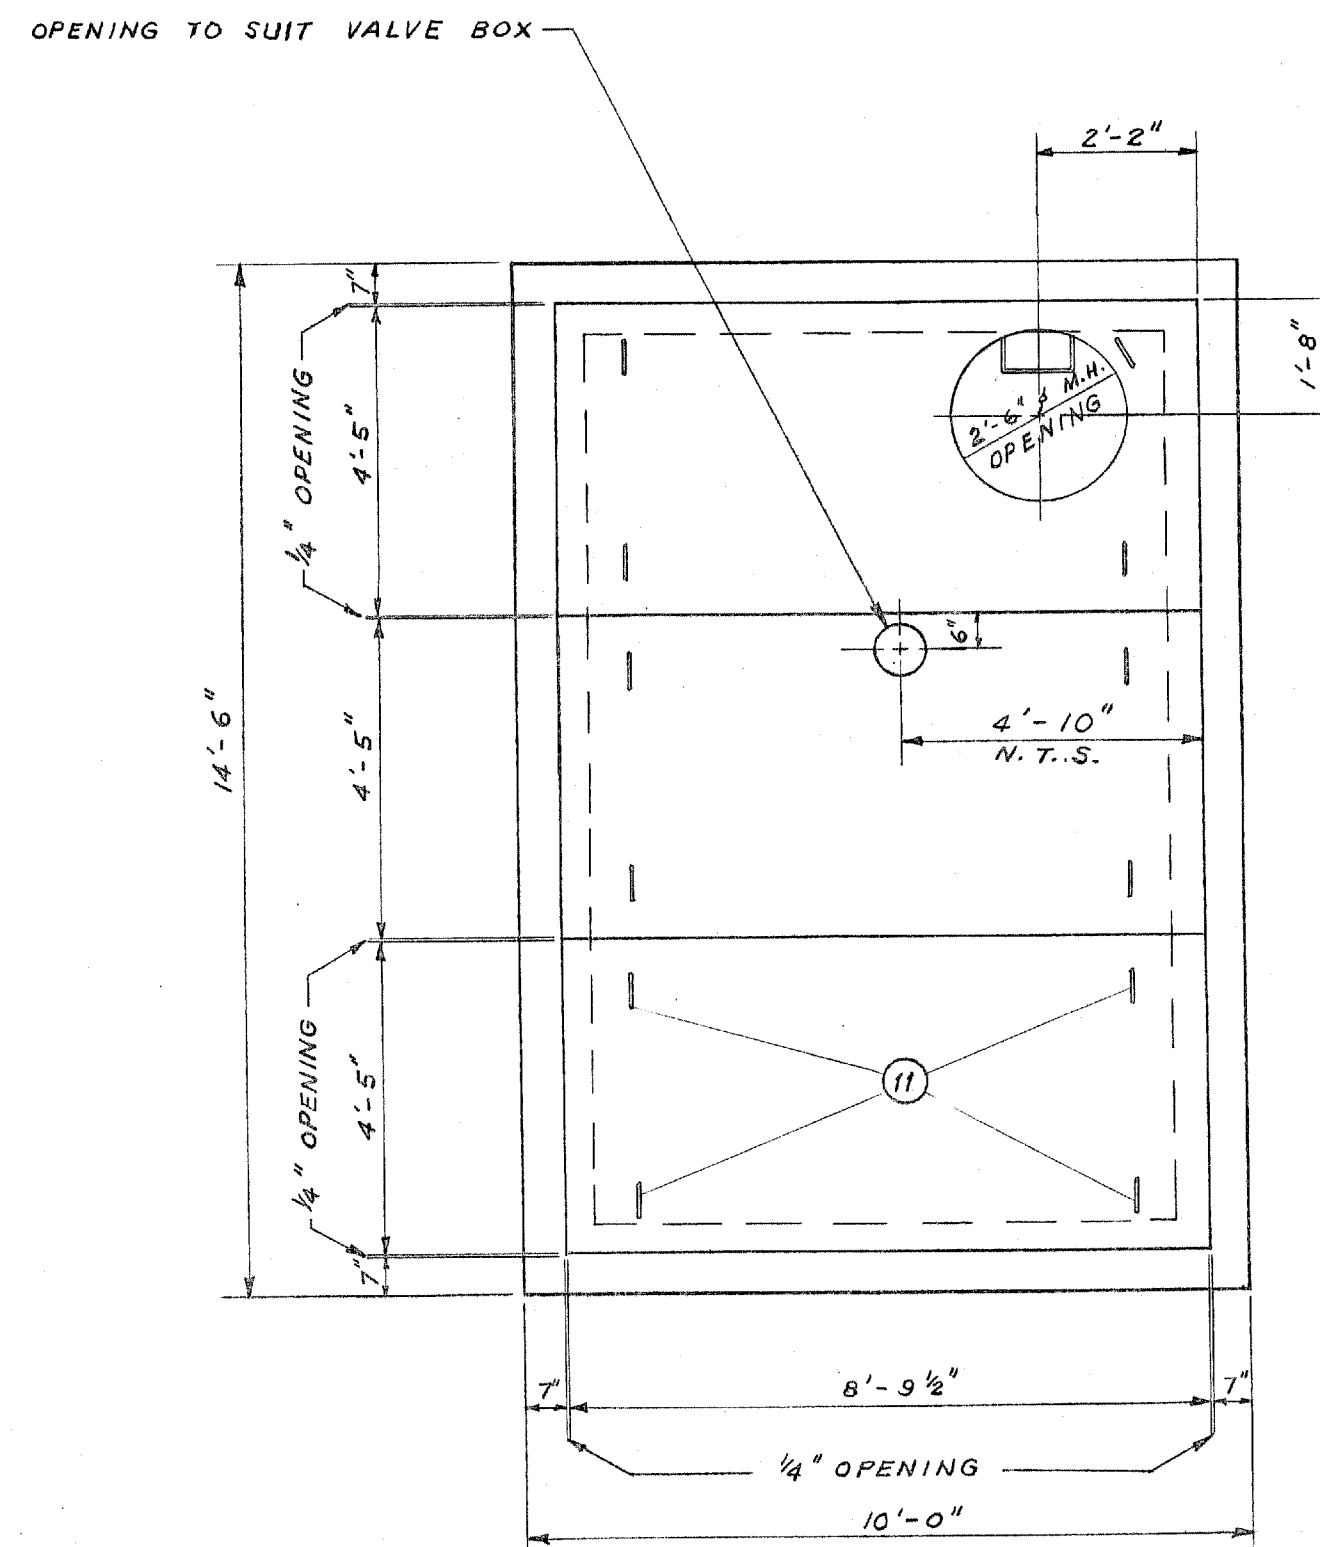


ROOF PLAN

LIST OF MATERIALS				
No.	DESCRIPTION	SIZE	QUANTITY	SEE DETAIL ON DWG. No.
1	48" ϕ CONG. PIPE - SPIGOT TO FLANGE		1	
2	48" ϕ BUTTERFLY VALVE ϕ OPERATOR		1	
3	48" ϕ STYLE #44 VICTAULIC COUPLING		1	
4	48" ϕ CONG. PIPE - FLANGE TO BELL		1	
5	4" ϕ SCREWED BRONZE NIPPLE	0'-6" L.	1	
6	4" ϕ SCREWED GALV. IRON CAP		1	
7	STD. METRO WATERWORKS M.H. FRAME AND SOLID COVER		1	A-796
8	30" ϕ PRECAST M.H. SECTIONS WITH "RAM-NEK" GASKETS			
9	STD. METRO WATERWORKS M.H. STEPS	3/4" @ 12" C-C.		A-817
10	LARGE ADJUSTABLE VALVE BOX WITH STD. METRO WATERWORKS COVER		1	A-798
11	3/8" GALV. LIFTING LUG - 4 PER SLAB		12	A-878

SUPPLIED BY METRO CORPORATION

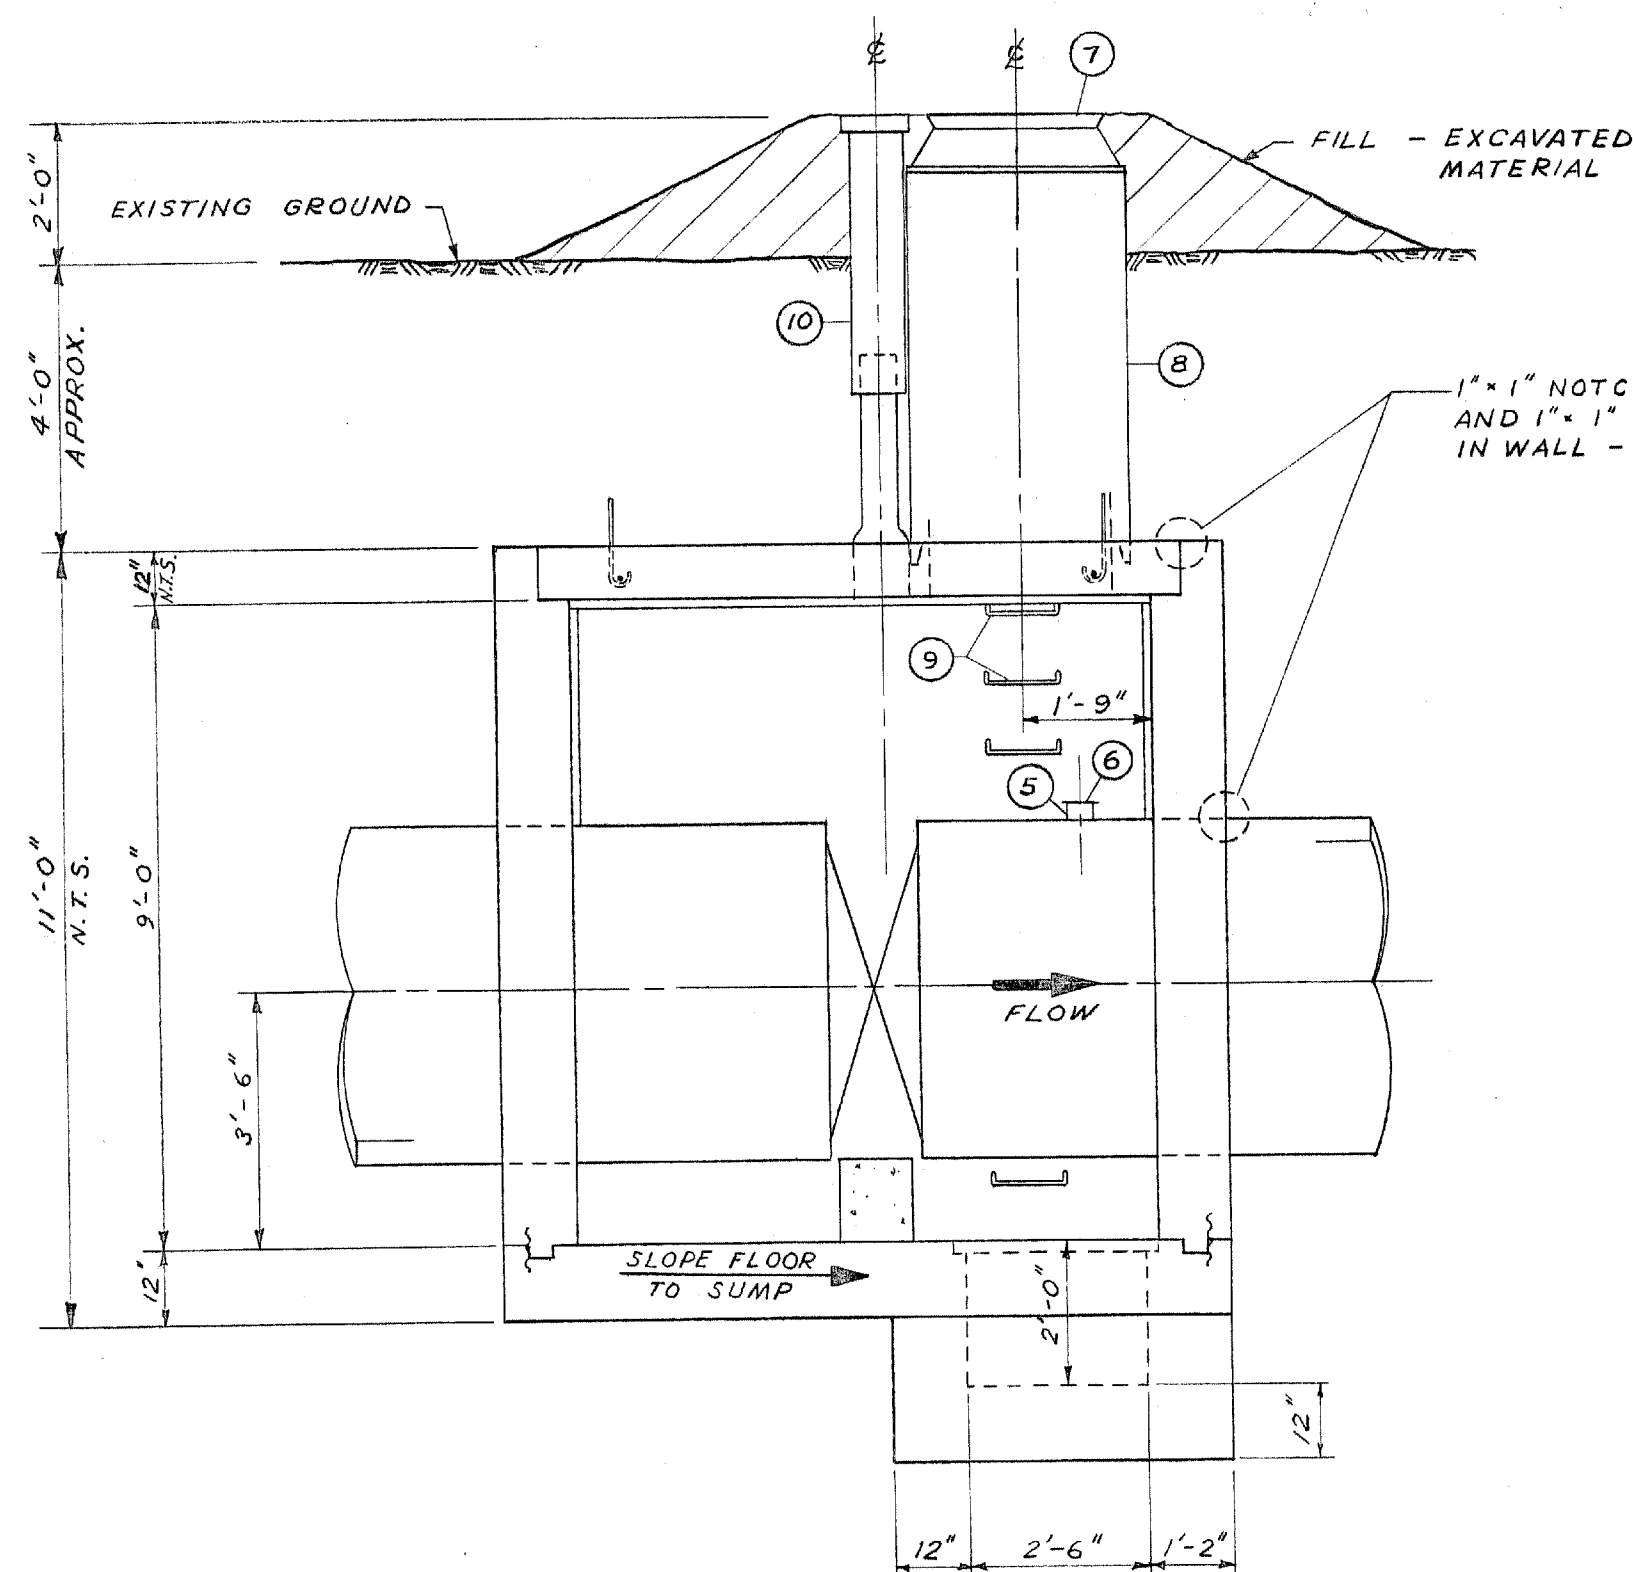

SEC. A-A

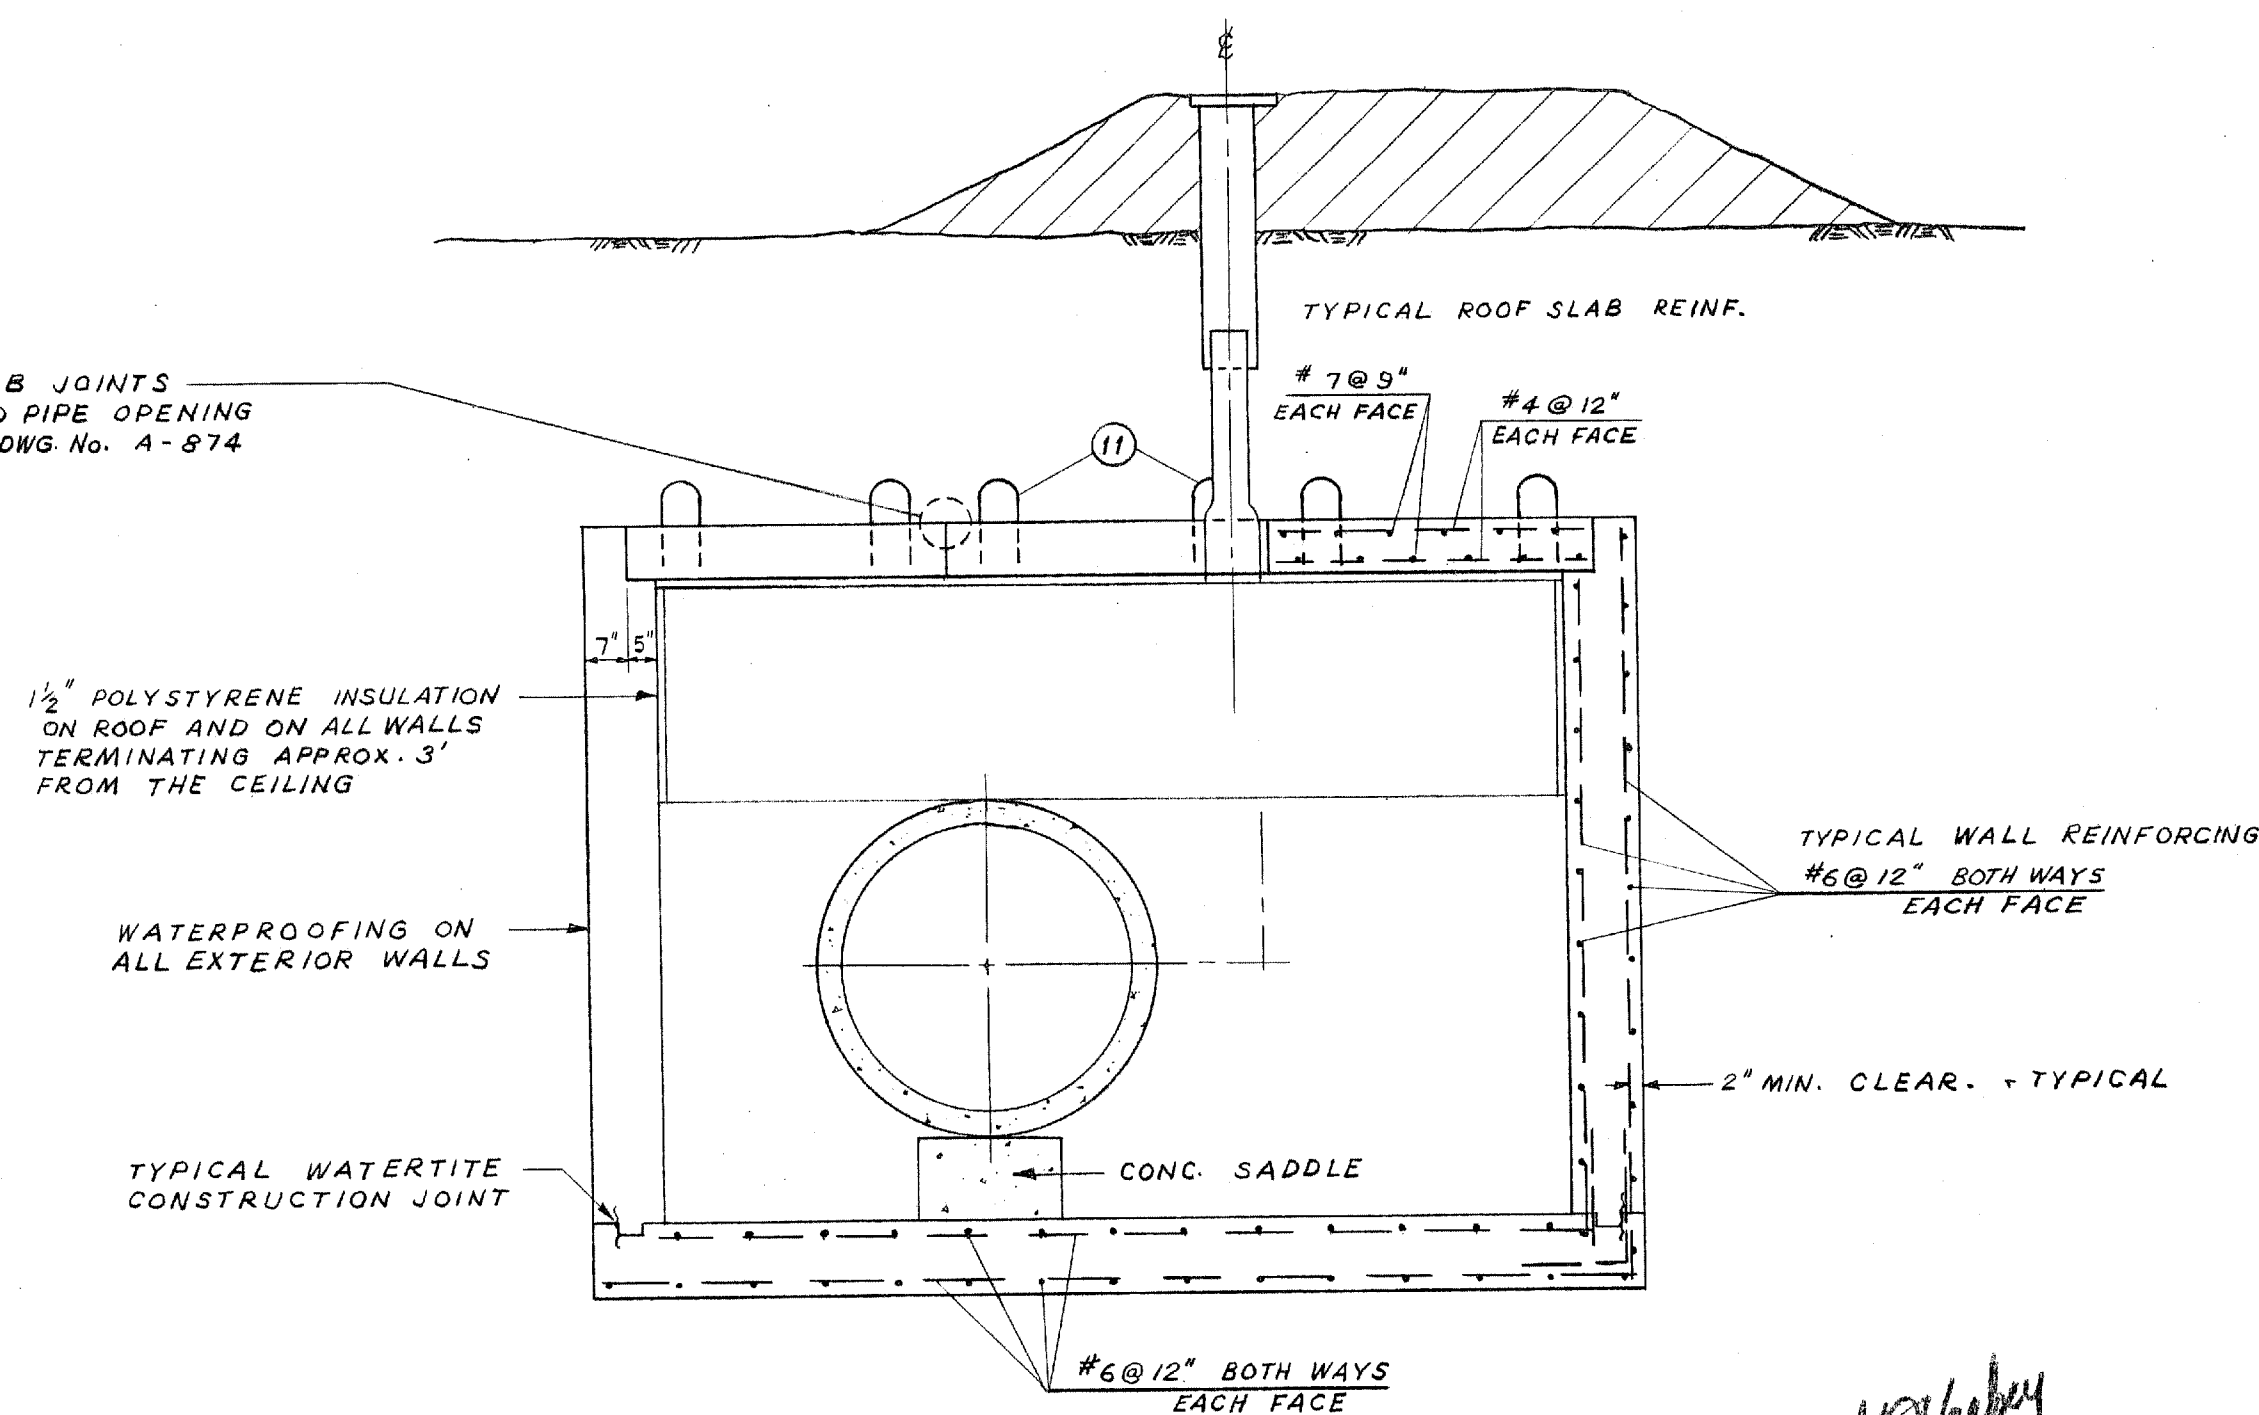


SEC. B-B

ISSUED FOR INFORMATION WITH BID OPPORTUNITY 35-2006

SURVEYED & PLAN CHECKED BY: APPROVED AS BUILT BY: V.D. Apr. 173

MICROFILMED mar77

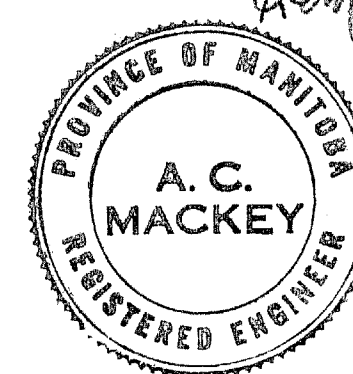

THE METROPOLITAN CORPORATION OF GREATER WINNIPEG
WATERWORKS & WASTE DISPOSAL DIVISION
A. PENMAN - DIRECTOR

WATERWORKS DEPT. DES. CH'KD. DRN. W.A.C. DATE APR. 70. ENG. RES. APPROVED. DEACON RESERVOIR STAGE I OUTLET CONTROL VALVE CHAMBER

SCALE: 3/8" = 1'-0"
DRAWING NO. D-1232

VC 305