

LEGEND

	EXISTING CONSTRUCTION TO REMAIN
	NEW CONSTRUCTION
EX	EXISTING TO REMAIN
R	RELOCATED - REFER TO DEMOLITION PLANS FOR ORIGINAL LOCATION
3 FS	3 HOUR FIRE SEPARATION
2 FS	2 HOUR FIRE SEPARATION
1 FS	1 HOUR FIRE SEPARATION
45 FS	45 MIN. FIRE SEPARATION
NFS	NON-RATED FIRE SEPARATION
	AUTOMATIC DOOR OPERATOR

AS BUILT DRAWING

3 JAN. 16, 2004	ISSUED FOR CONSTRUCTION		
2 OCT. 30, 2003	ISSUED FOR TENDER		
1 OCT. 22, 2003	ISSUED FOR REVIEW		
No.	Date	Description	By
ISSUE / REVISION			

DRAWN BY:
PRINTING DATE:

L:\2002\0230\3-WD\LM-P Seal02.tif

Drawings and specifications, as instruments of service are the property of the architect, the copyright in the same being reserved to them. No reproduction may be made without the permission of the architect, and when made, must bear their names all printed or be returned.

The contractor is to verify dimensions and data noted herein with conditions on the site and is held responsible for reporting any discrepancy to the architect for adjustment.

LM Architectural Group / Patkau Architects Inc.
500-136 MARKET AVE.
WINNIPEG, MANITOBA R3B 0P4
PH: (204)442-0081 FAX: (204)943-8676



PLANNING PROPERTY AND DEVELOPMENT DEPARTMENT
3rd Floor - 85 Garry Street, Winnipeg, MB R3C 4K4

CENTENNIAL LIBRARY MILLENNIUM PROJECT
251 Donald Street Winnipeg
CITY OF WINNIPEG PROJECT NO. 2001-233


MAIN FLOOR PLAN

COMM. NO.: 0230 SHEET: **A2.3**

GRAHAM AVENUE

SMITH STREET

DONALD STREET

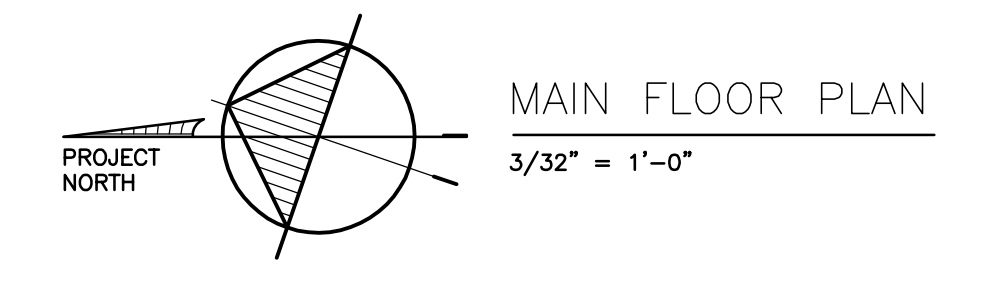

MAIN FLOOR PLAN
3/32" = 1'-0"