

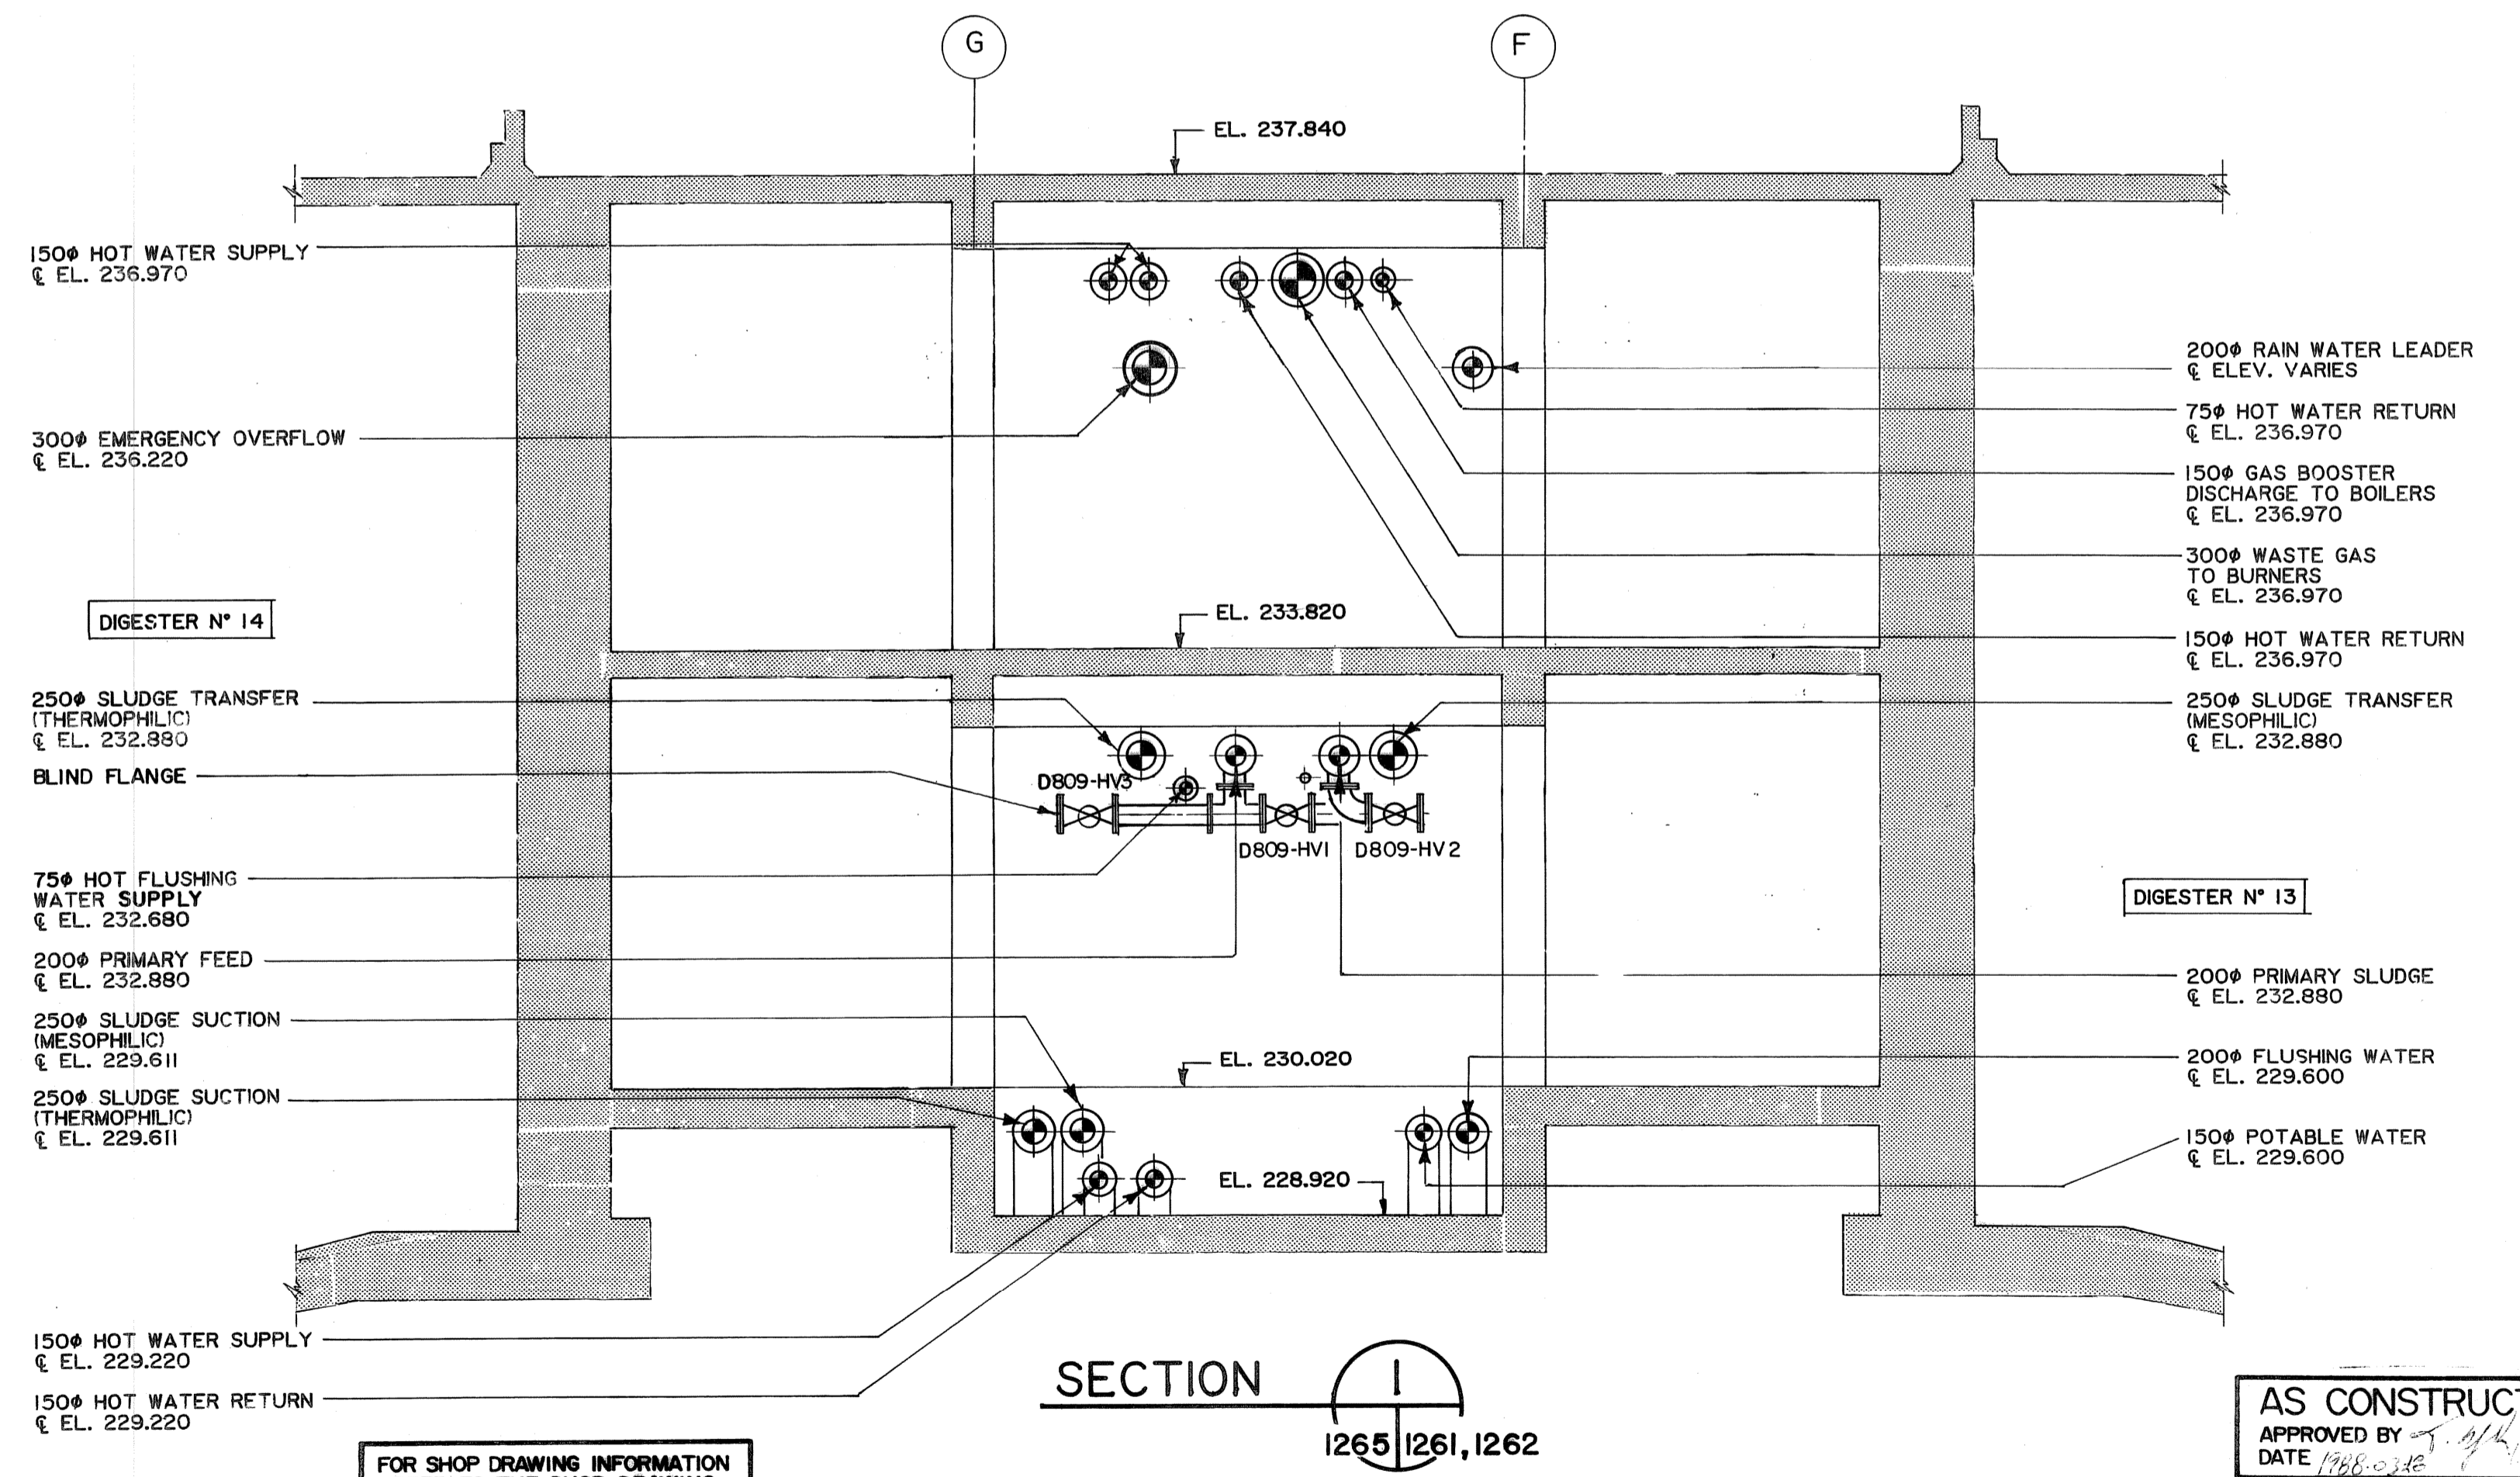
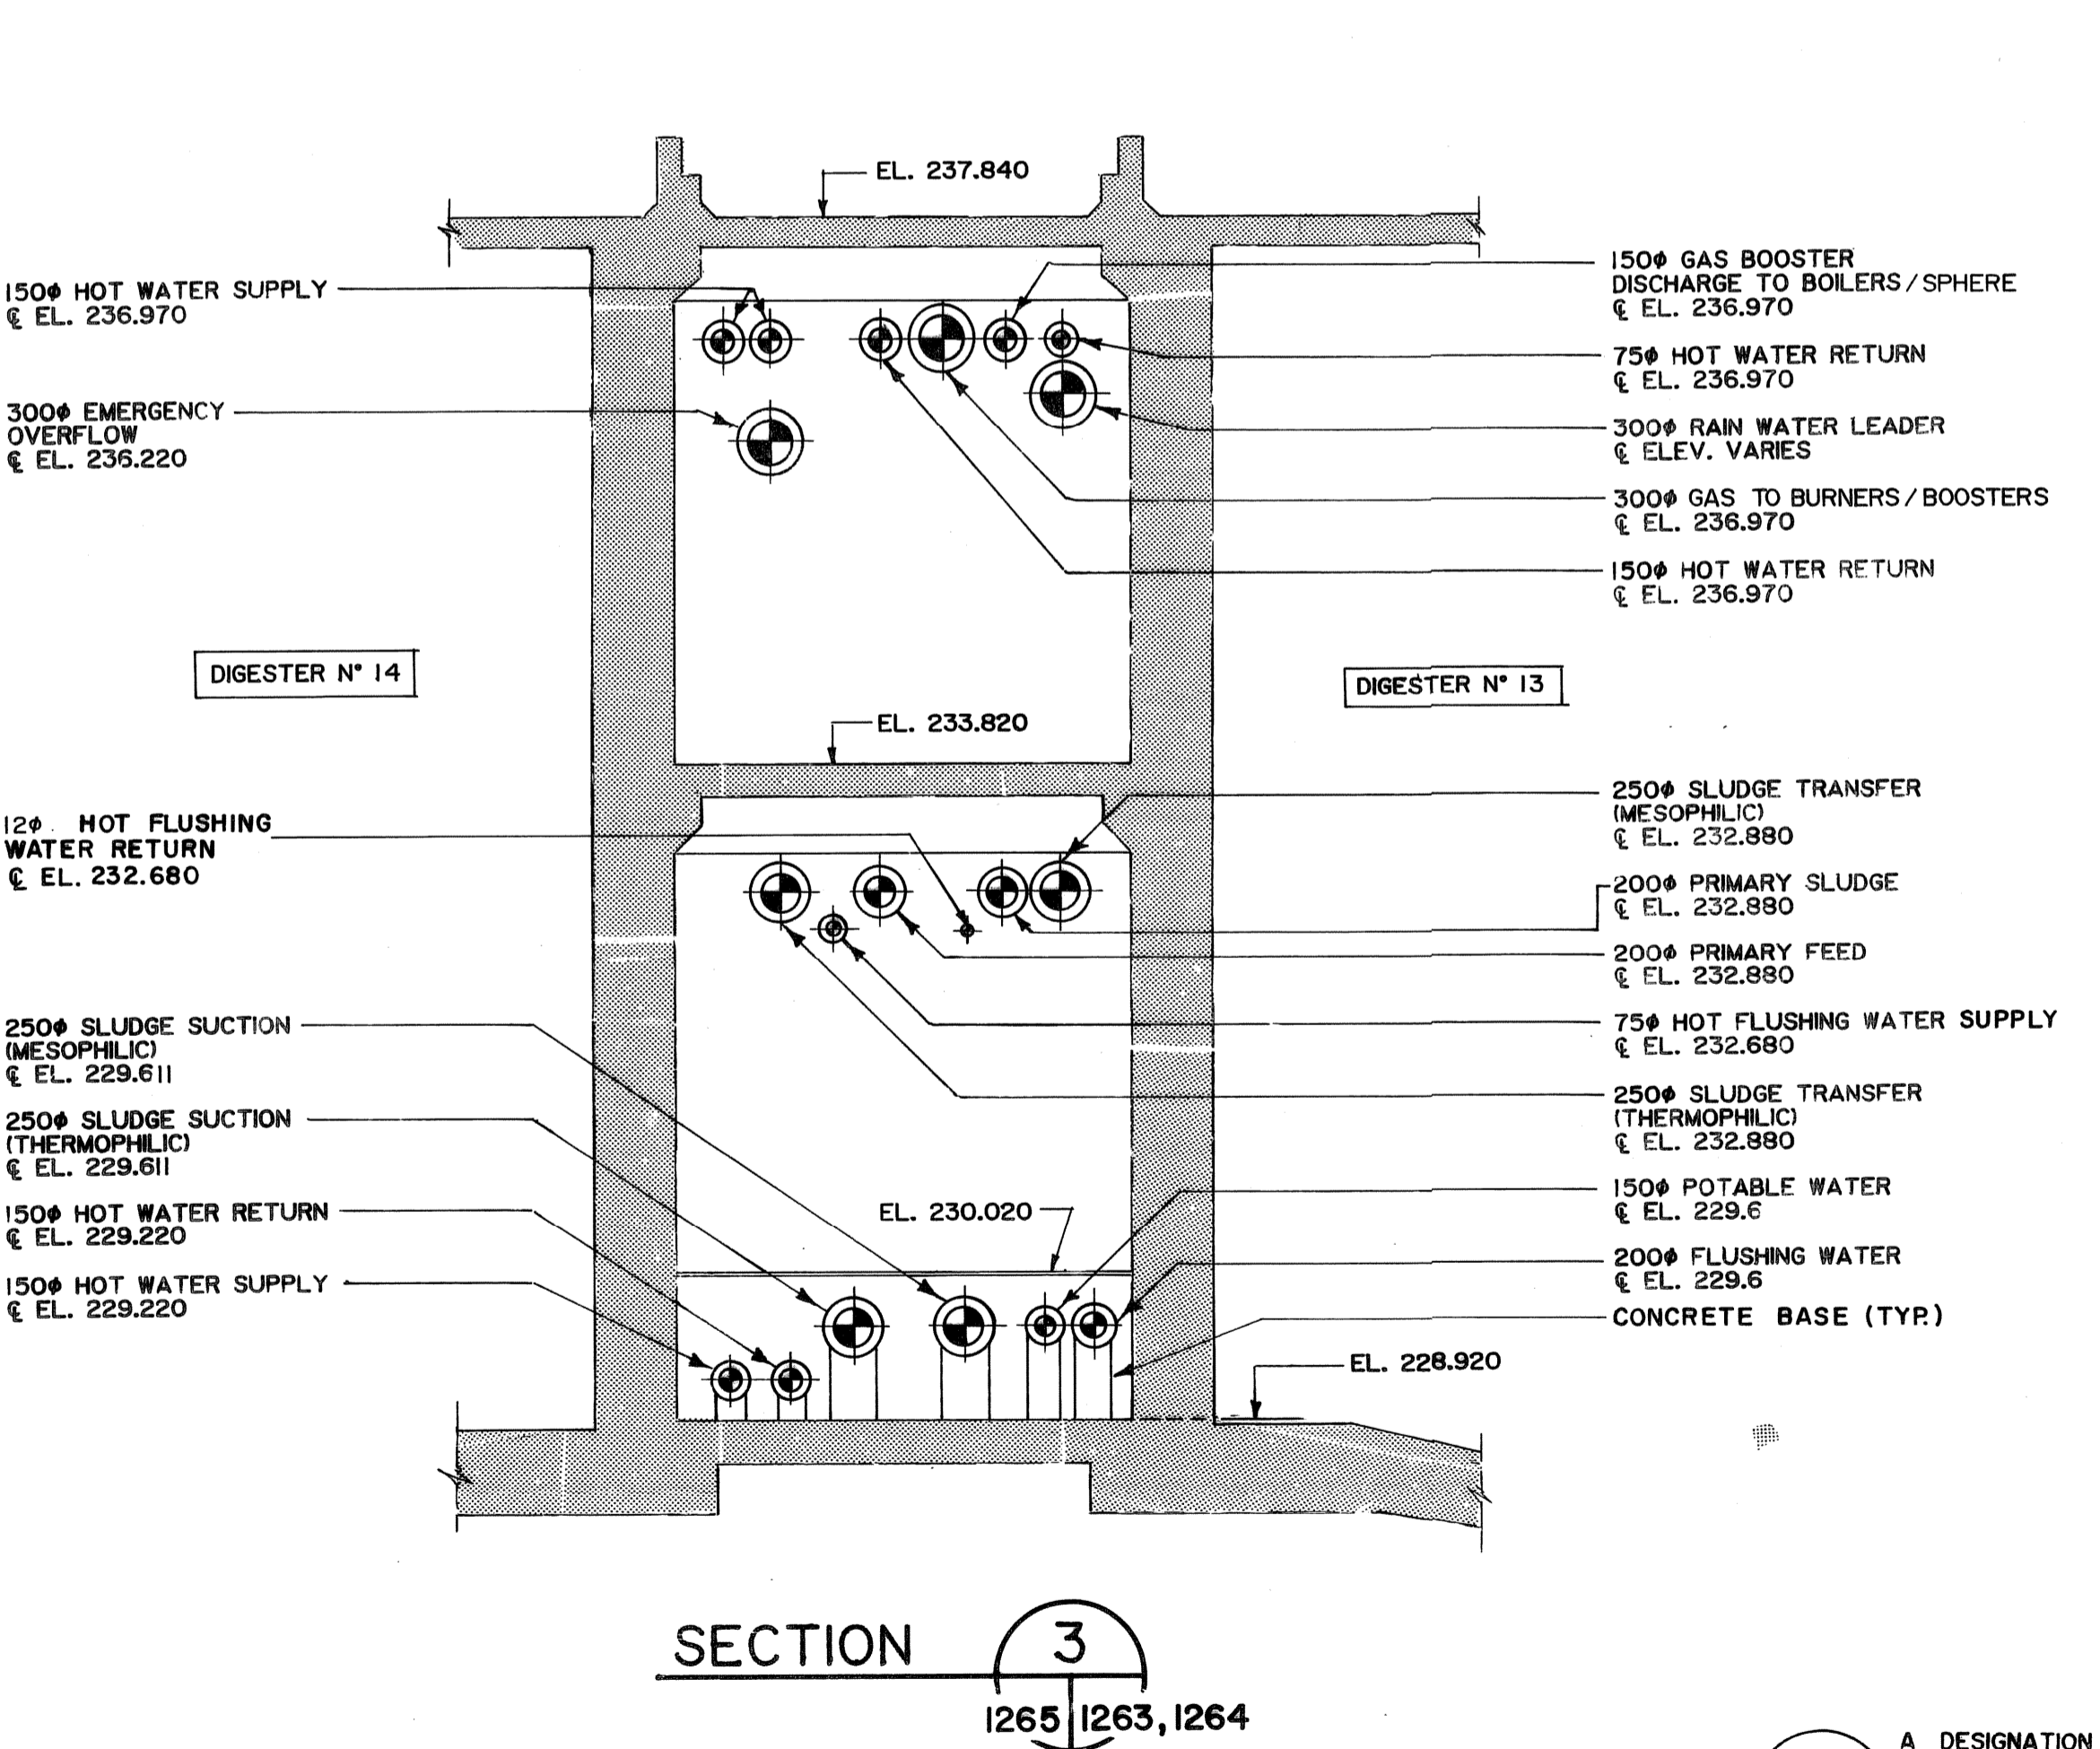
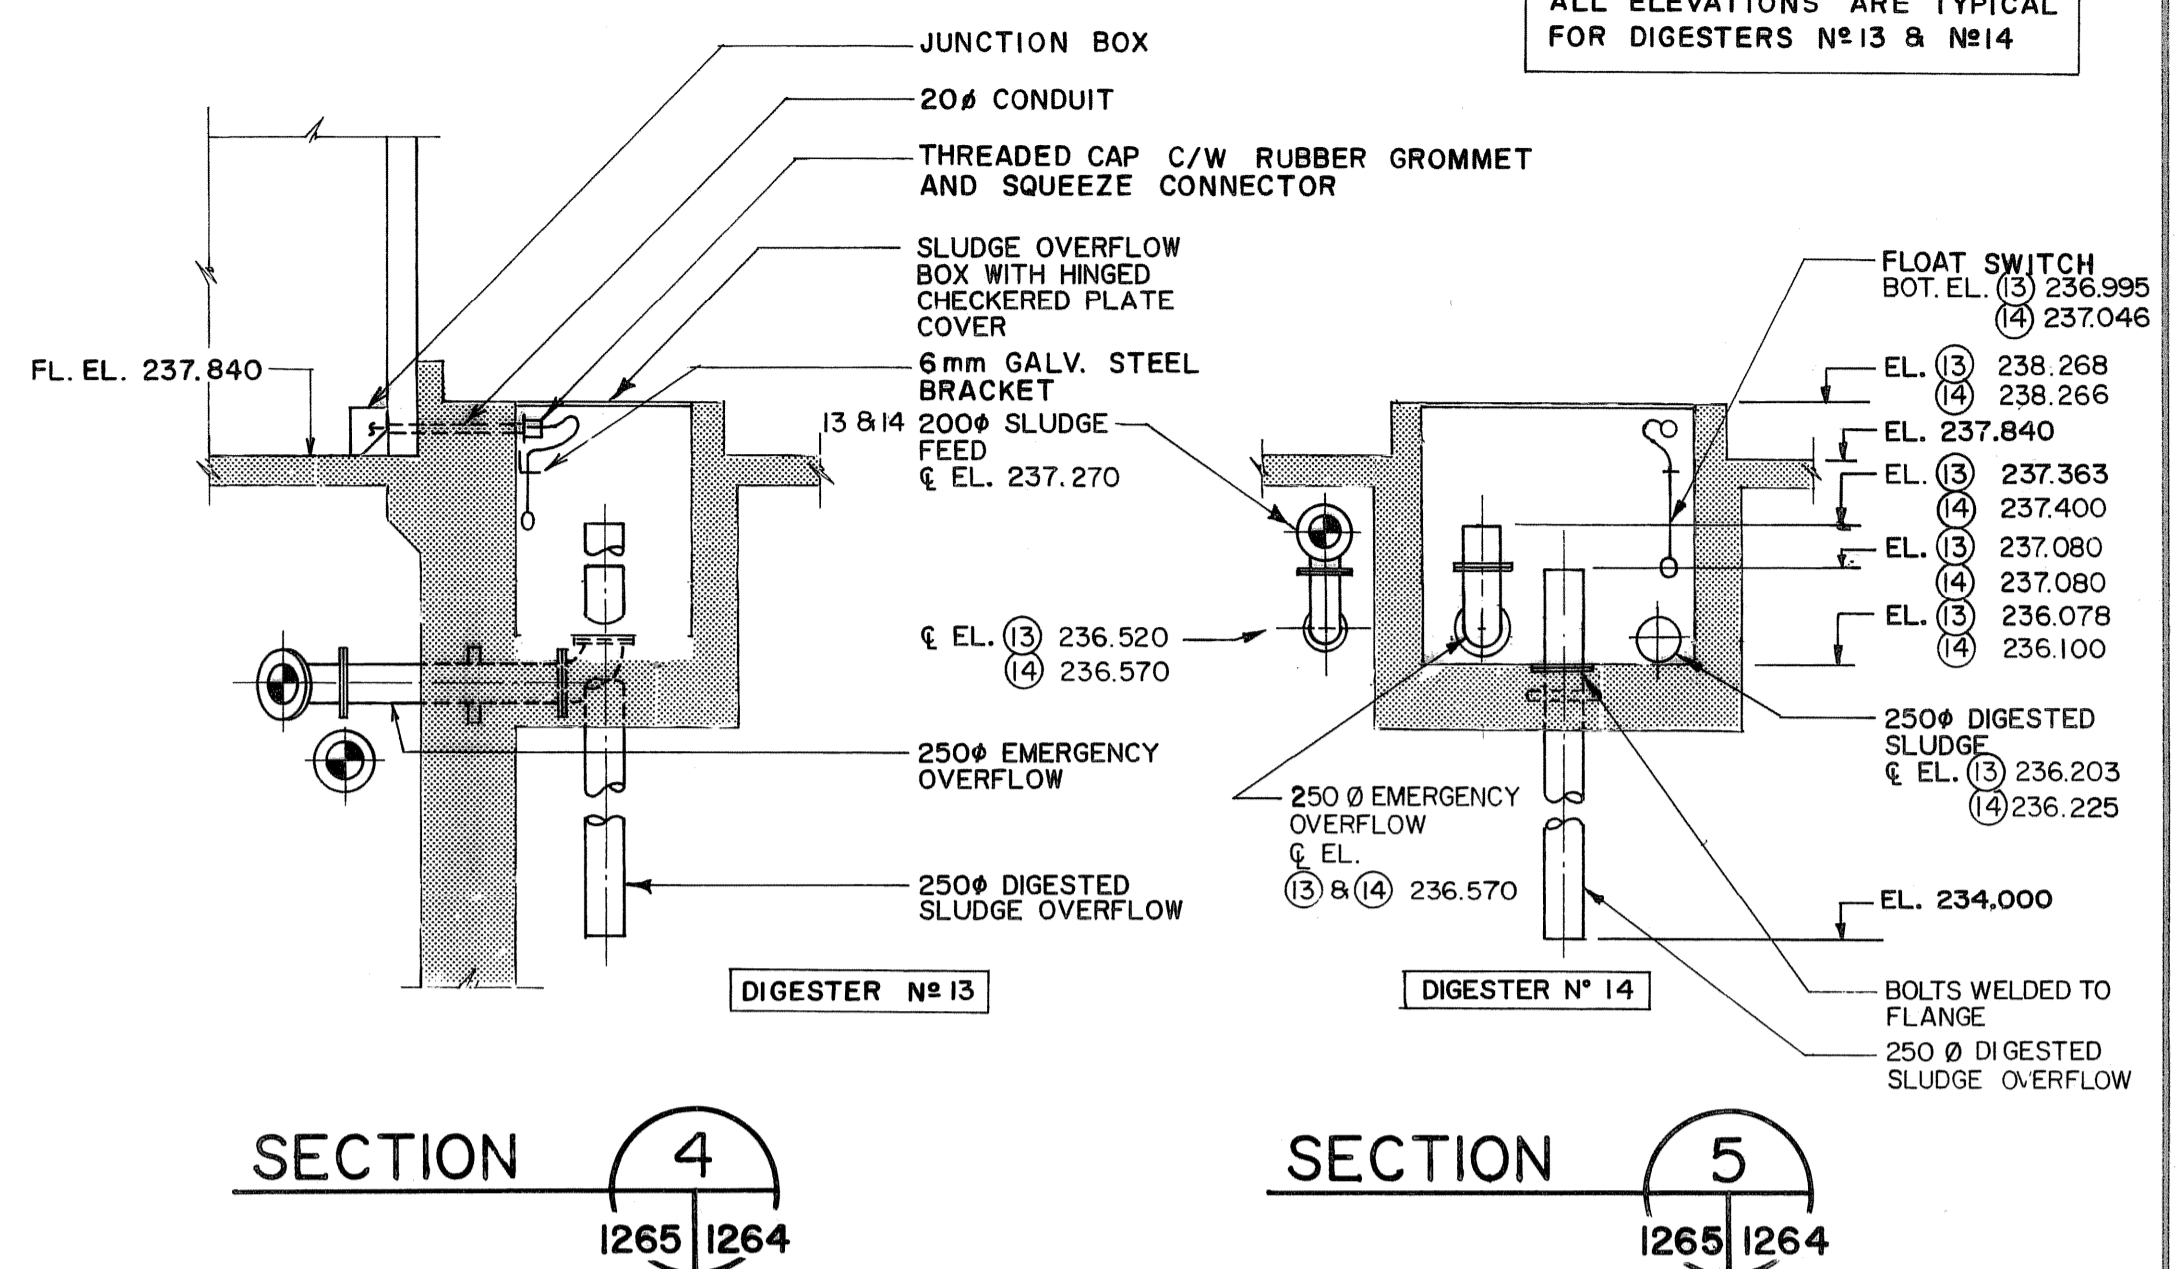


NOTE:
ALL ELEVATIONS ARE TYPICAL
FOR DIGESTERS N°13 & N°14

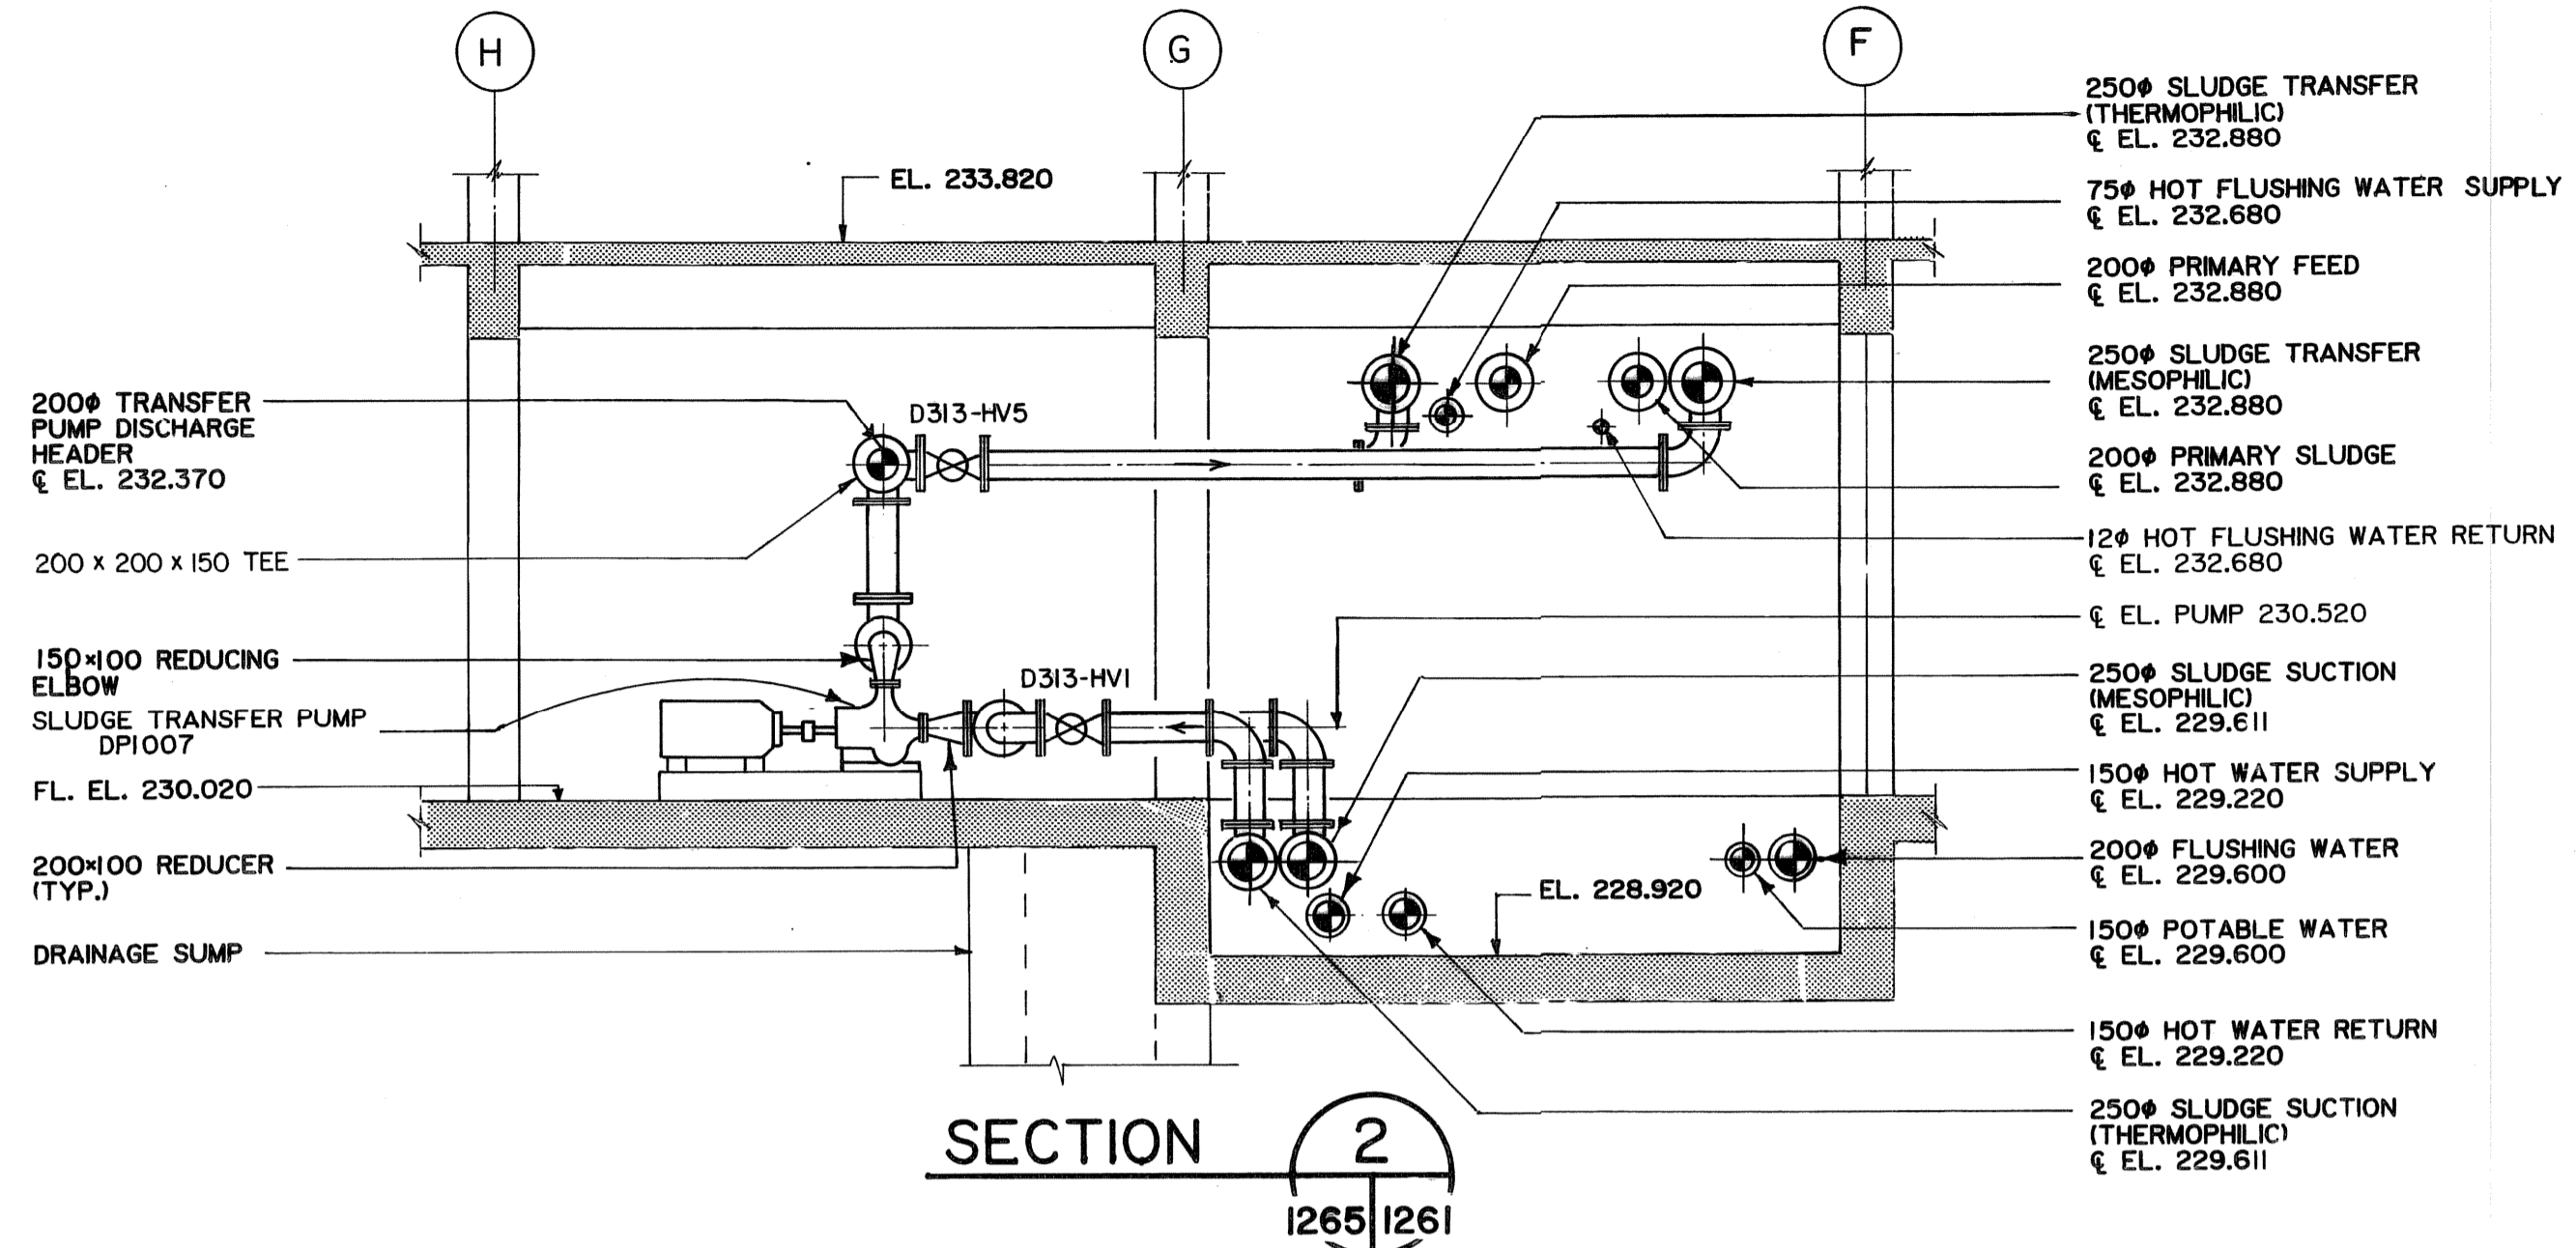

A DESIGNATION
B ITEM ORIGIN
C ITEM LOCATION

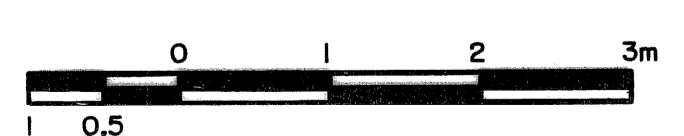

FOR SHOP DRAWING INFORMATION REFER TO THE SHOP DRAWING CROSS REFERENCE INDEX

AS CONSTRUCTED
APPROVED BY: [Signature]
DATE: 1985-03-26

"TO OBTAIN PLANT DATUM SUBTRACT 221.764 METRES"

<p>Underwood McLellan Ltd. Consulting Engineers and Planners GORE & STORRIE LIMITED CONSULTING ENGINEERS</p>		<p>THE CITY OF WINNIPEG WORKS & OPERATIONS DIVISION WATERWORKS, WASTE & DISPOSAL DEPARTMENT</p>	<p>NORTH END WATER POLLUTION CONTROL CENTRE SLUDGE DIGESTION EXPANSION DIGESTION GALLERIES No. 6 & 7 PROCESS SECTIONS</p>
<p>DESIGNED BY: J. CHENG CHECKED BY: J. CHENG</p>	<p>DRAWN BY: C.L. S.N. DATE: JUNE/85</p>		
<p>APPROVED BY: [Signature] DATE: JUNE/85</p>		<p>AS NOTED</p>	

NR 11442 8 S FILE 651.01-AI-04049