


5 PARAPET AT ROOF HIGH PT. SCALE 1:10


8 SECTION SCALE 1:10

11 PARAPET AT ROOF LOW POINT SCALE 1:10

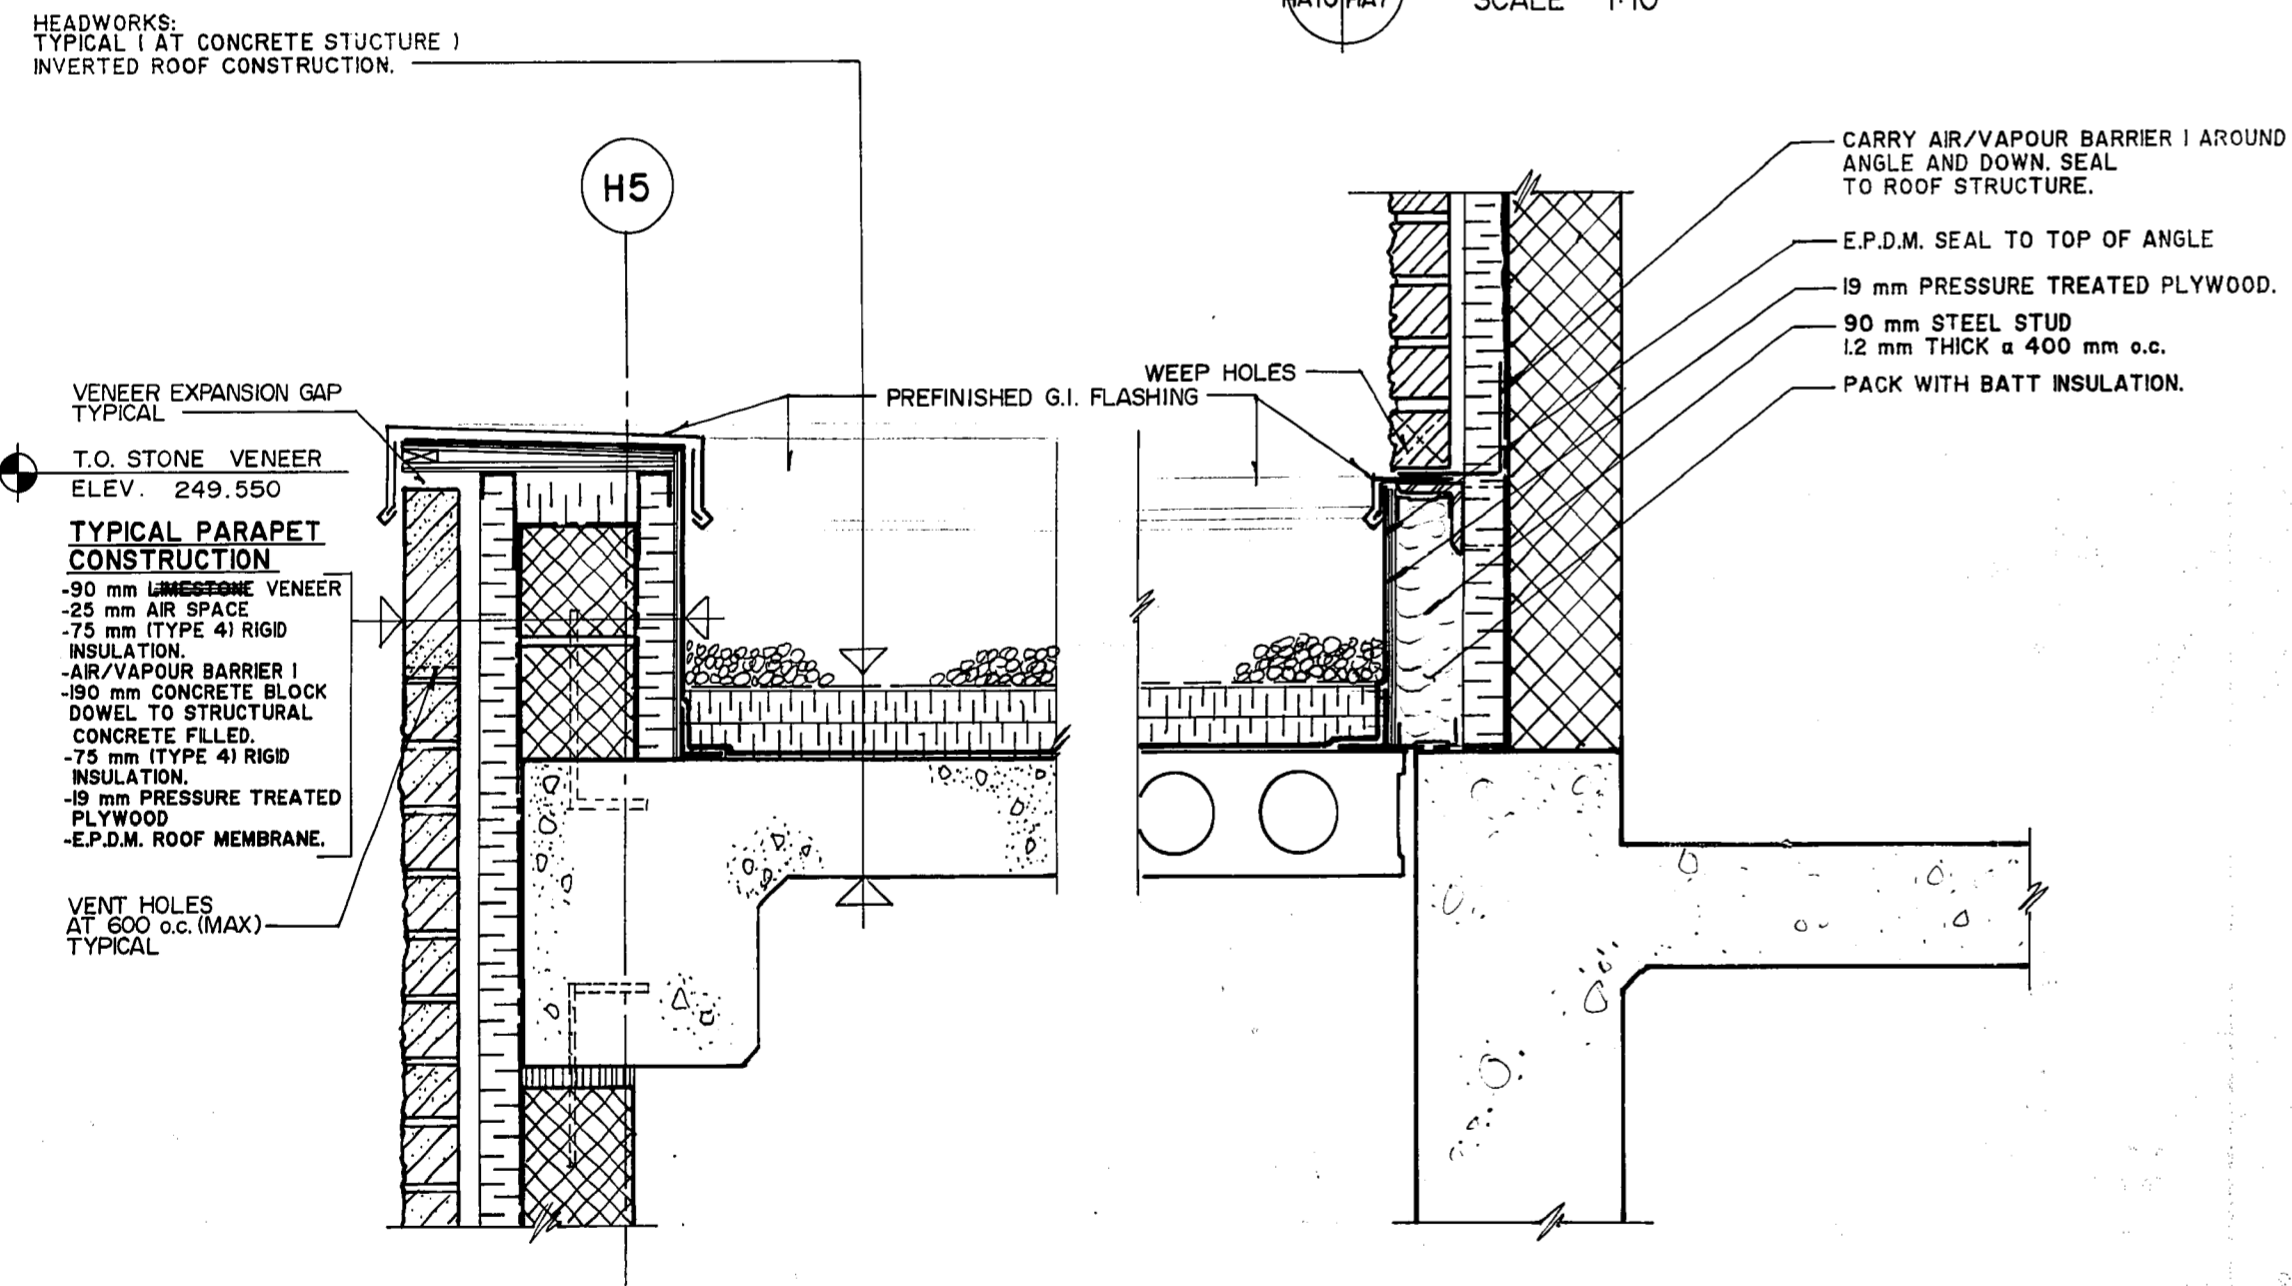

3 TYPICAL PARAPET SCALE 1:10

6 PARAPET CONNECTION SCALE 1:10

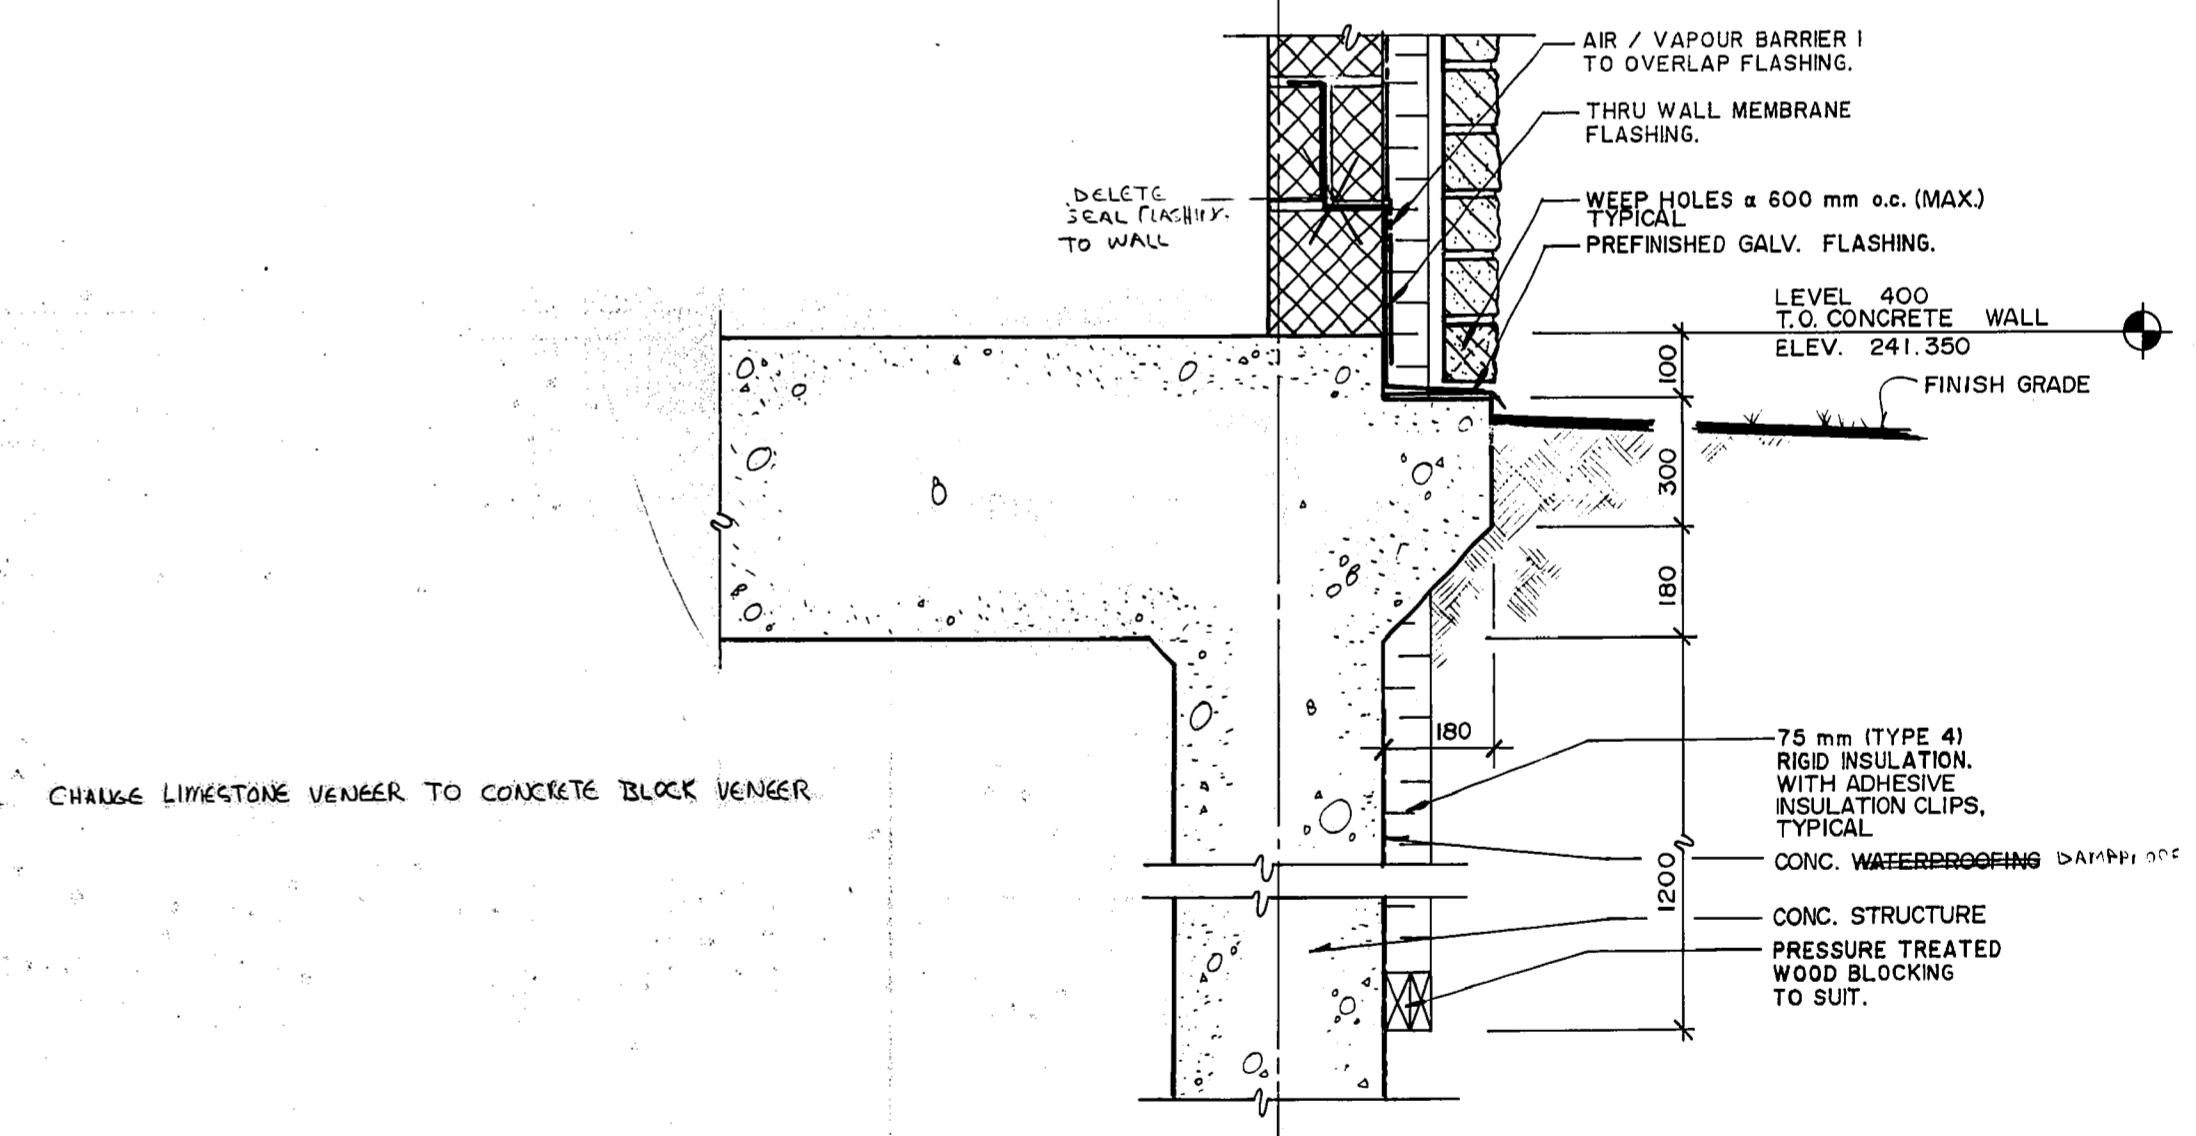

12 TYPICAL BUILDING PERIMETER SCALE 1:10

REID, CROWTHER & PARTNERS LIMITED
WINNIPEG
AS CONSTRUCTED
SIG. *[Signature]* DATE: 08-1-99

B.M. ELEV.					
DESIGNED BY	<i>[Signature]</i>	CHECKED BY			
DRAWN BY	DJP/OH	APPROVED BY	<i>[Signature]</i>		
HOR. SCALE	H0	RELEASED FOR CONSTRUCTION	<i>[Signature]</i>		
VERTICAL SCALE	H0	DATE	91-04-12		
NO. REVISIONS		DATE			

ENGINEER'S SEAL

THE CITY OF WINNIPEG
WORKS AND OPERATIONS DIVISION
WATERWORKS WASTE AND DISPOSAL DEPT.

WEST END WATER POLLUTION CONTROL CENTRE
AREA H - HEADWORKS

ARCHITECTURAL SECTIONS & DETAILS

WEP-114

2 file # WS 10165