



THE CITY OF WINNIPEG

WORKS & OPERATIONS DEPARTMENT
STREETS & TRANSPORTATION DIVISION

ROUTE 165

FORT GARRY · ST. VITAL CORRIDOR

BRIDGE ALTERNATE A

STEEL BOX GIRDER
P. D. NO. 77-23A


AS - BUILT		
DATE	FB. NO.	PAGE
Nov. 14/70		





W.L. WARDROP & ASSOCIATES LTD.

ENGINEERING CONSULTANTS

WINNIPEG THUNDER BAY REGINA BARRIE EDMONTON

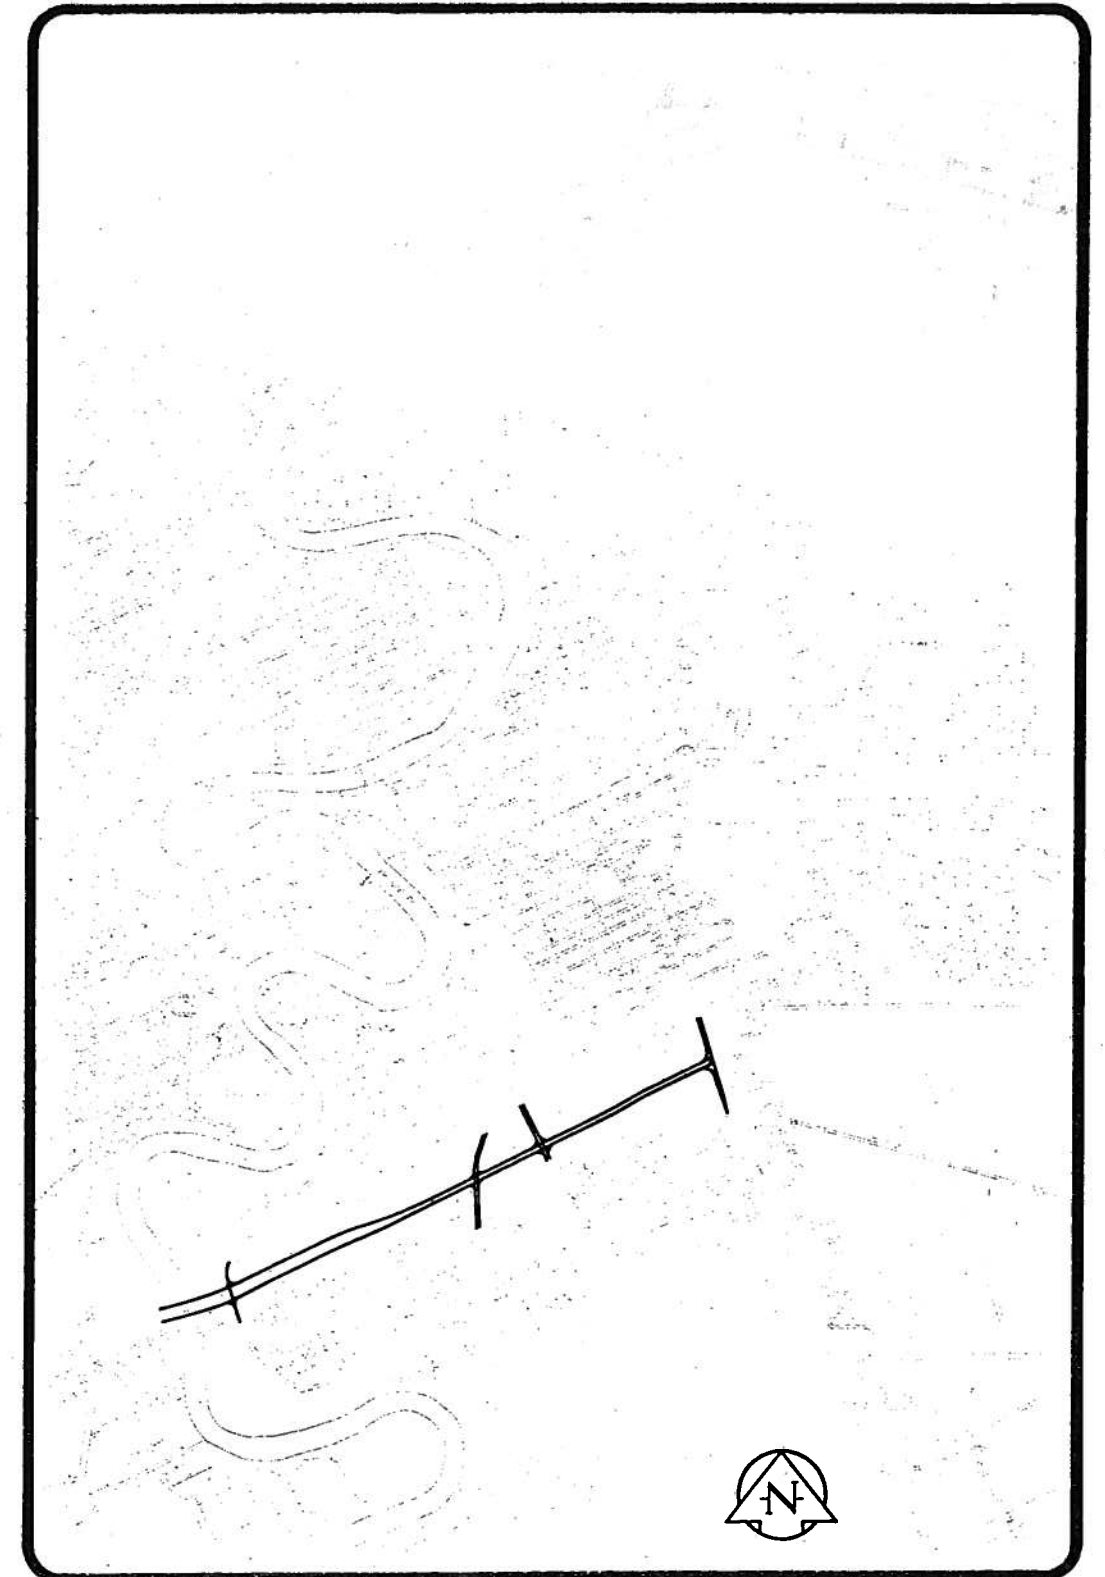

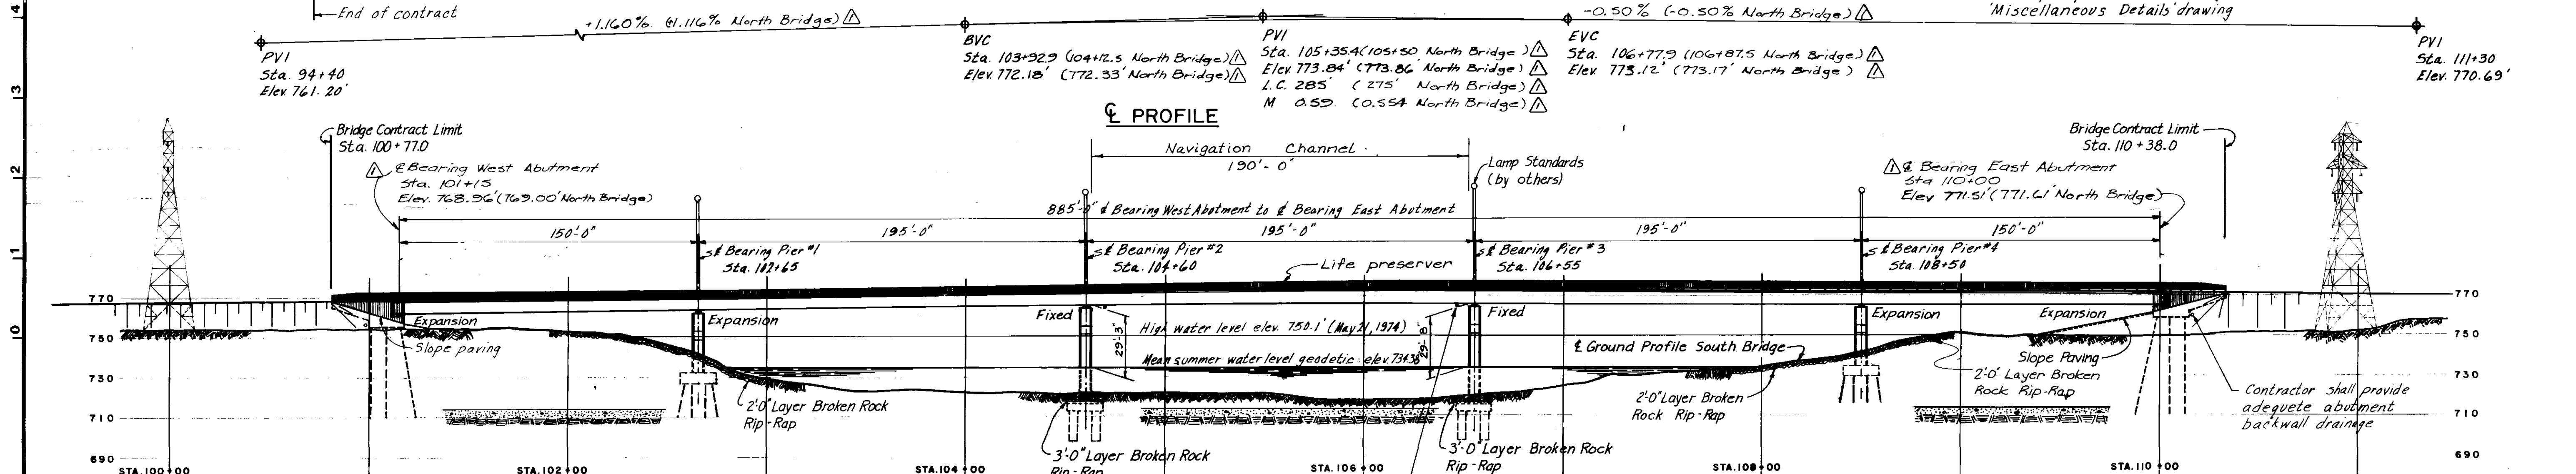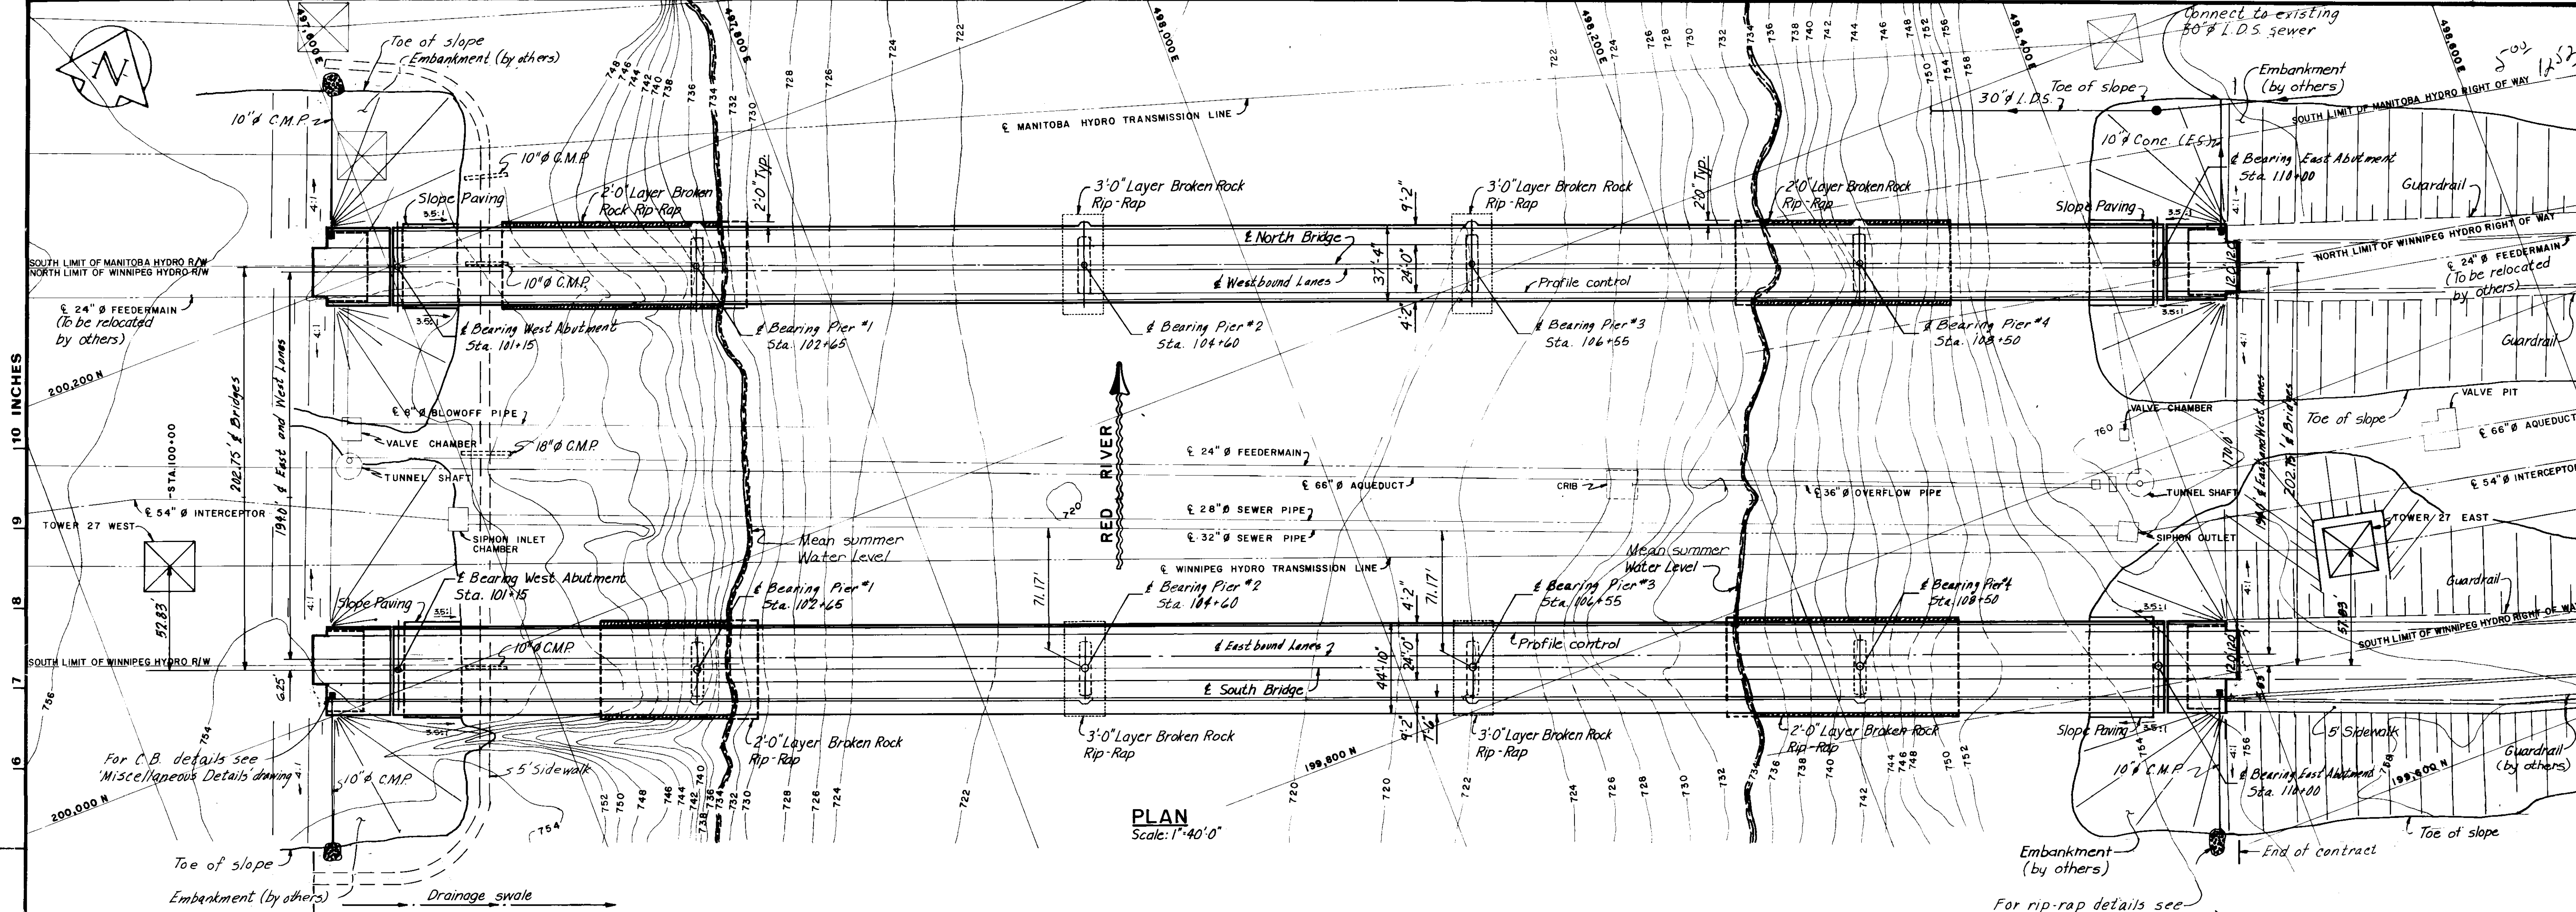

DEPOSITED IN THE WINNIPEG LAND TITLES OFFICE AS THIS 6th DAY OF July 1977 AT 12:52 AS RAILWAY DEPOSIT NO. 730


ELEVATION - SOUTH BRIDGE
Scale: 1"=40' 0"

AS - BUILT		
DATE	FB NO.	PAGE
Nov. 16/77		

LOCATIONS OF UNDERGROUND STRUCTURES AS SHOWN ARE BASED ON THE BEST INFORMATION AVAILABLE, BUT NO GUARANTEE IS GIVEN THAT ALL EXISTING UTILITIES ARE SHOWN OR THAT THE GIVEN LOCATIONS ARE EXACT. CONFIRMATION OF EXISTENCE AND EXACT LOCATION OF ALL SERVICES MUST BE OBTAINED FROM THE INDIVIDUAL UTILITIES BEFORE PROCEEDING WITH CONSTRUCTION.

LOCATION APPROVED UNDERGROUND STRUCTURES
MARCH 25/77 *L. Martyn* Supervisor

NO.	REVISIONS	DATE	BY
1	Adjusted final elevations, as indicated	June 20/78	S.T.K.
2	ISSUED FOR TENDER	4.4.77	

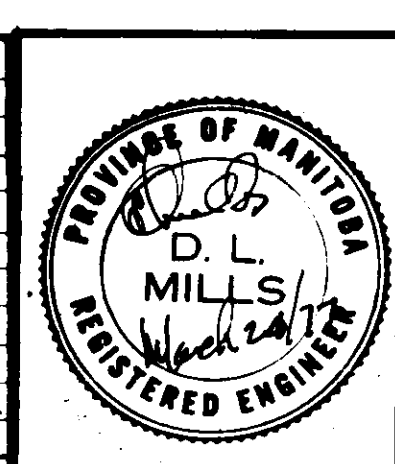

THE CITY OF WINNIPEG
WORKS & OPERATIONS DEPARTMENT
STREETS & TRANSPORTATION DIVISION

APPROVED BY: *[Signature]* DATE 25 Mar 77

W.L. WARDROP & ASSOCIATES LTD.
ENGINEERING CONSULTANTS
WINNIPEG - THUNDER BAY - REGINA - BARRIE - EDMONTON

DRAWN BY: J.I.K. DATE DEC 76
PRELIM. CHK. S.T.K. JAN 77

DESIGN S.T.K. DATE DEC 76
CHECK D.L.M. DATE JAN 77


ROUTE 165

GENERAL PLAN AND ELEVATION


APPROVED BY: *[Signature]* DATE 25/3/77
MANAGER OF STREETS AND TRAFFIC

SCALE: AS SHOWN


DRAWING NO. B-5092-201

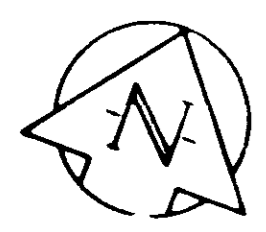


10 INCHES
19
18
17
16
14
13
12
11
10

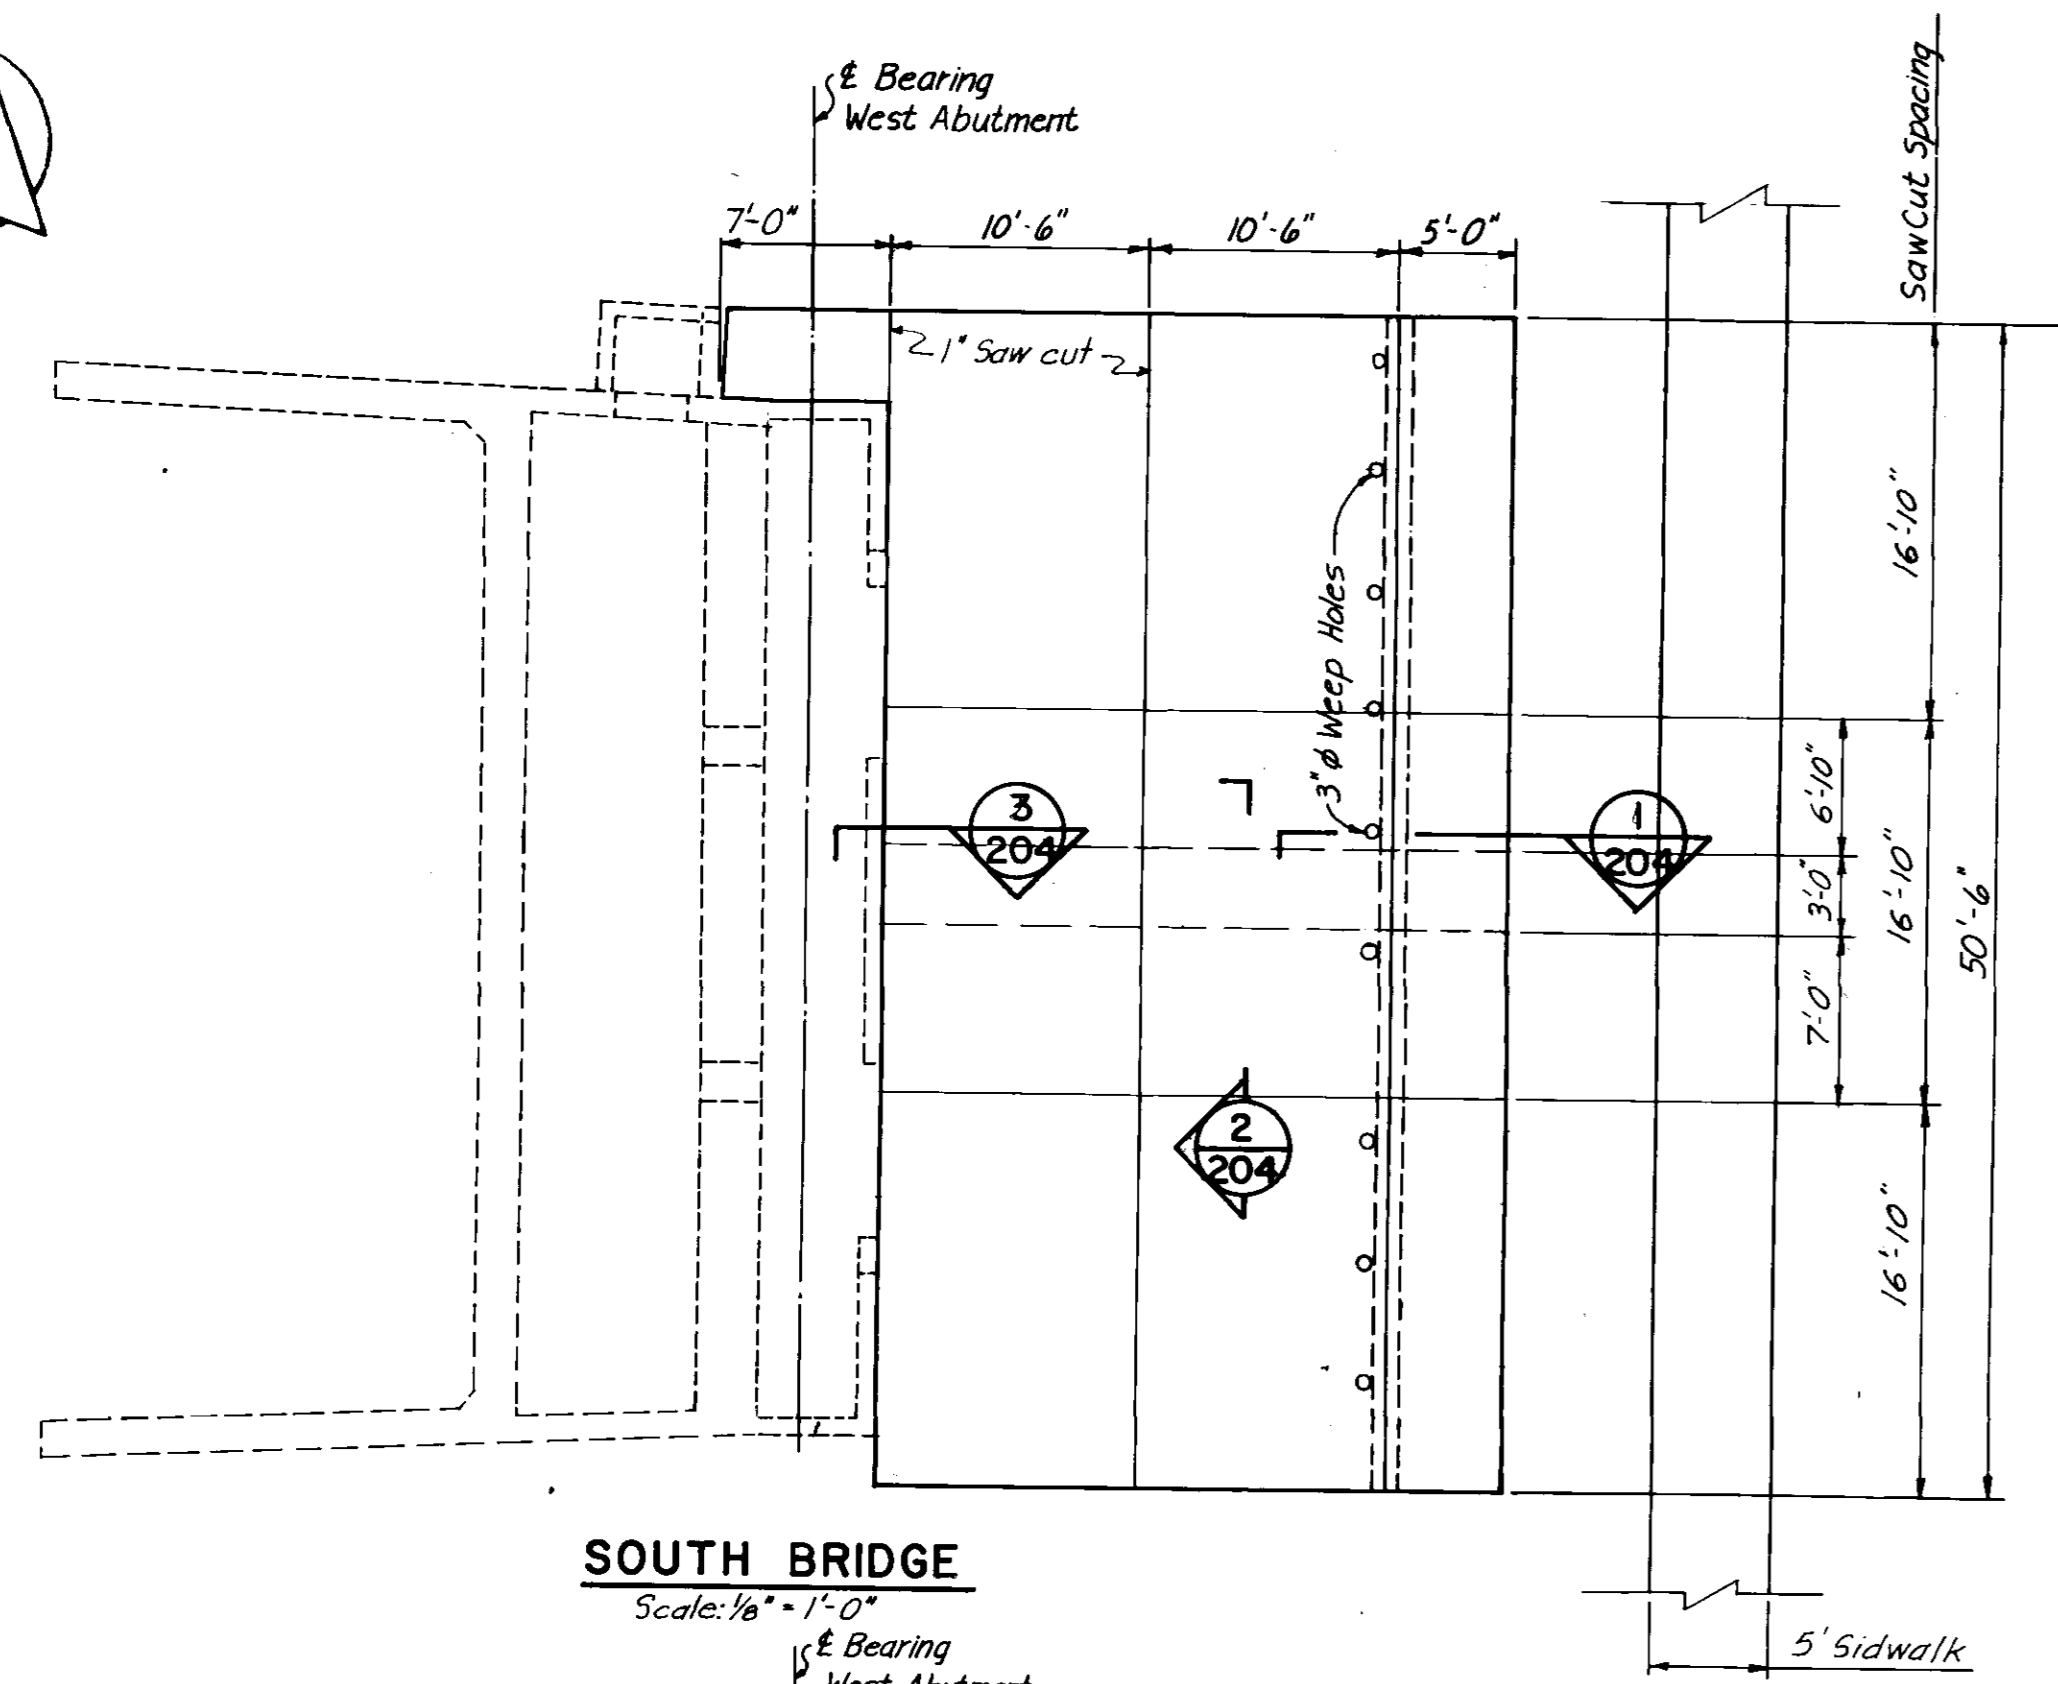



SOUTH BRIDGE
Scale: 1/8" = 1'-0"

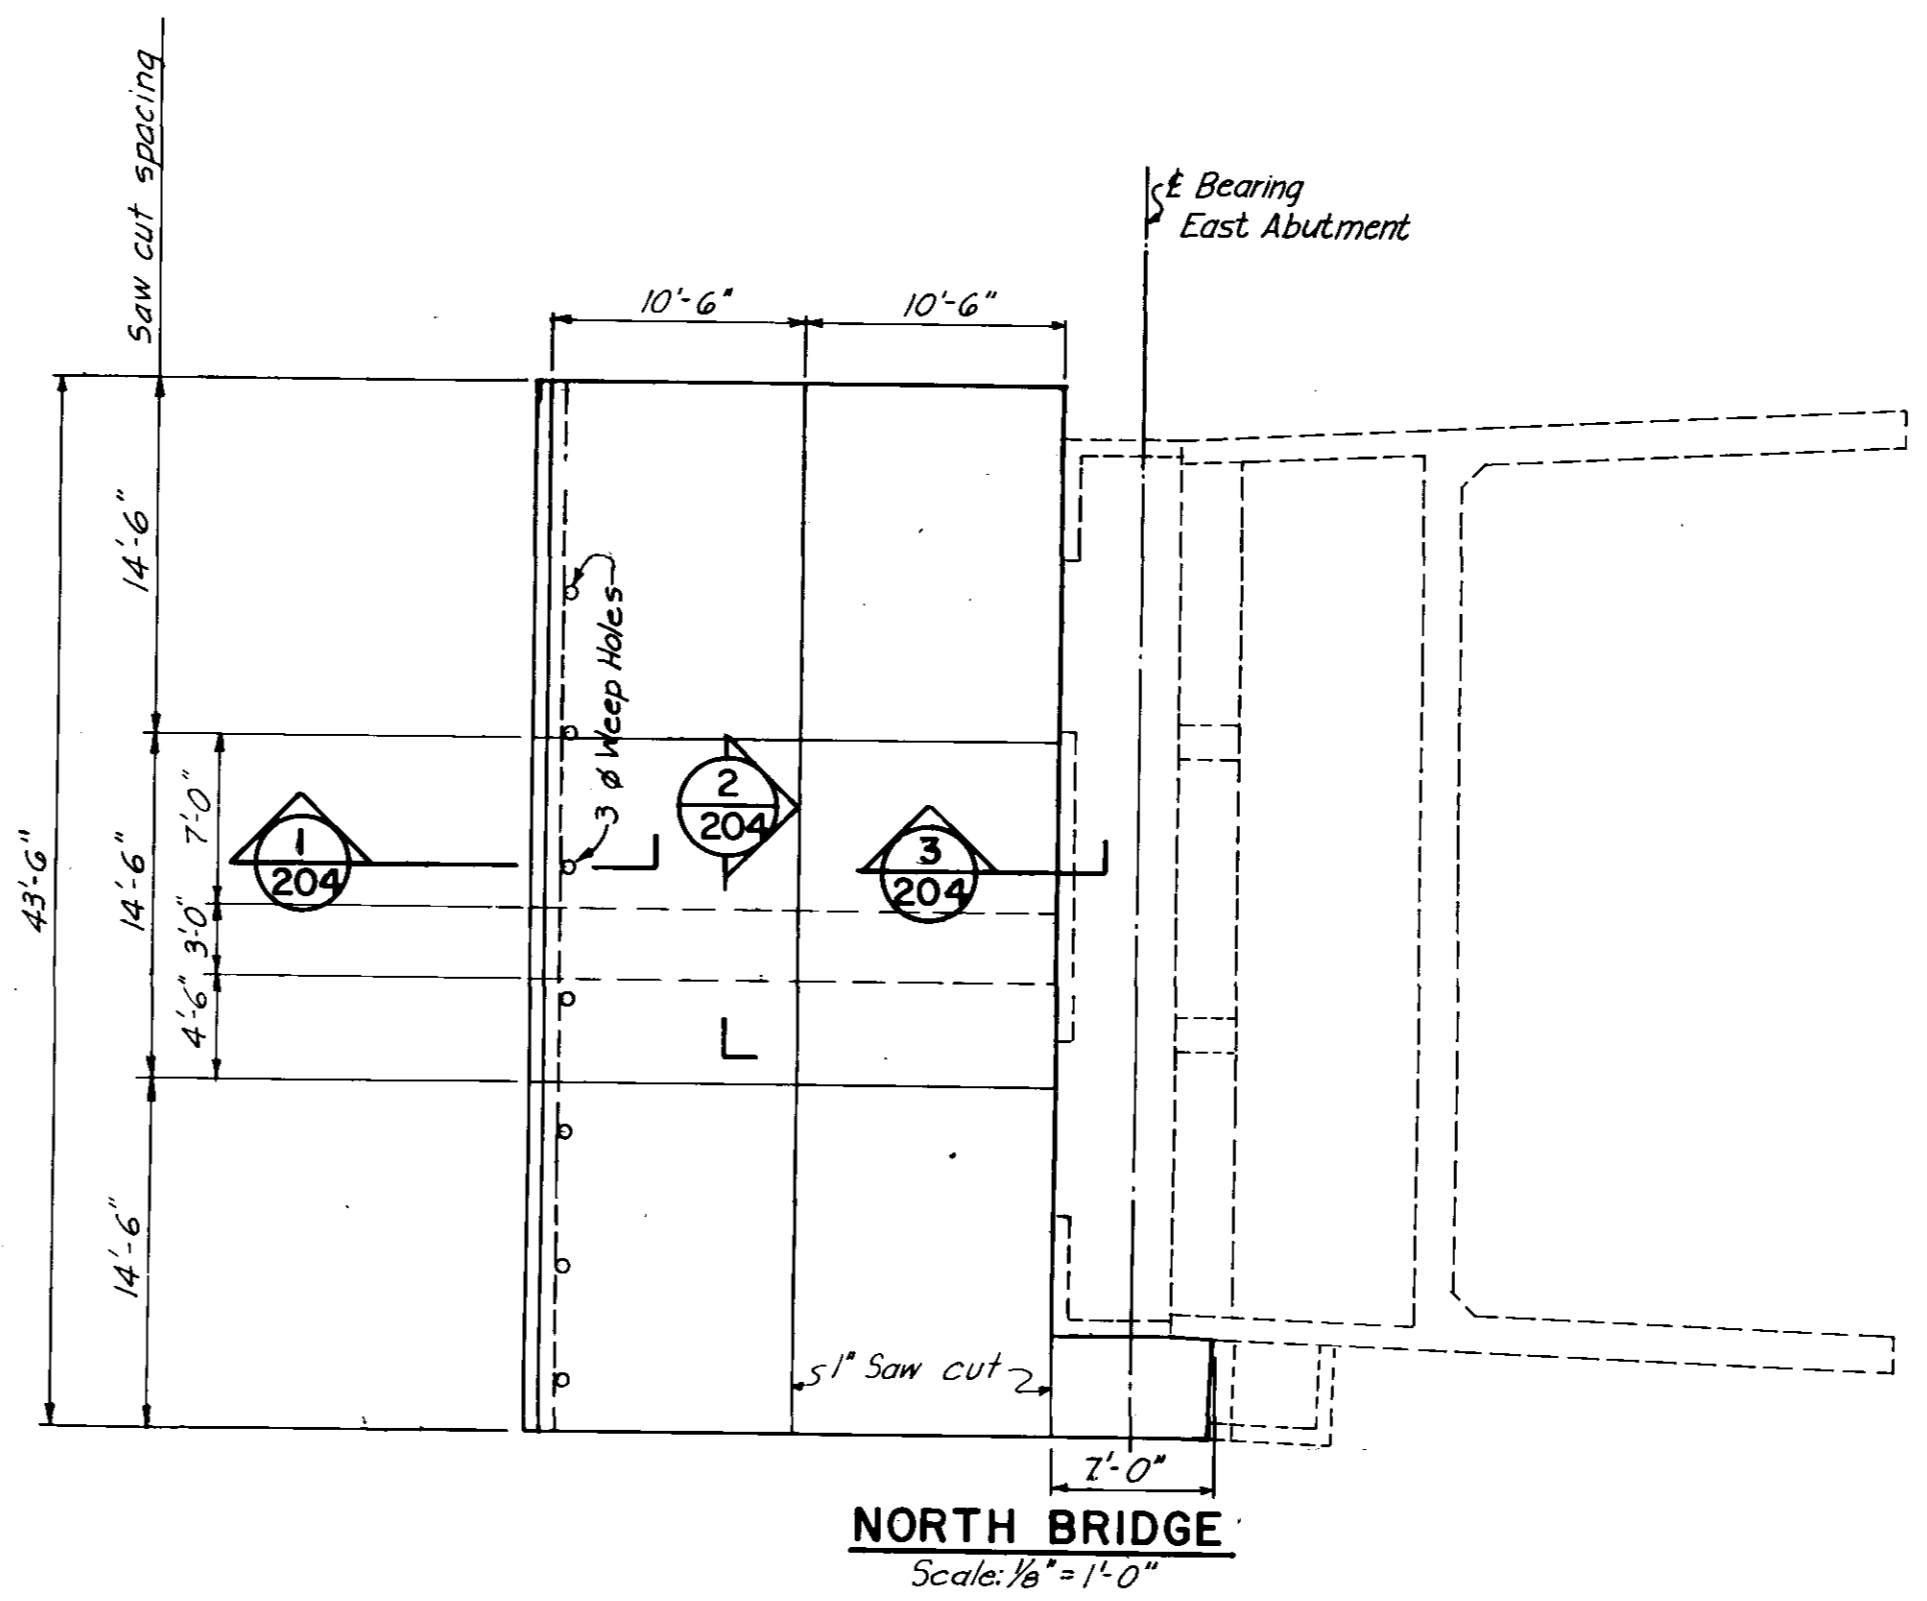


NORTH BRIDGE
Scale: 1/8" = 1'-0"

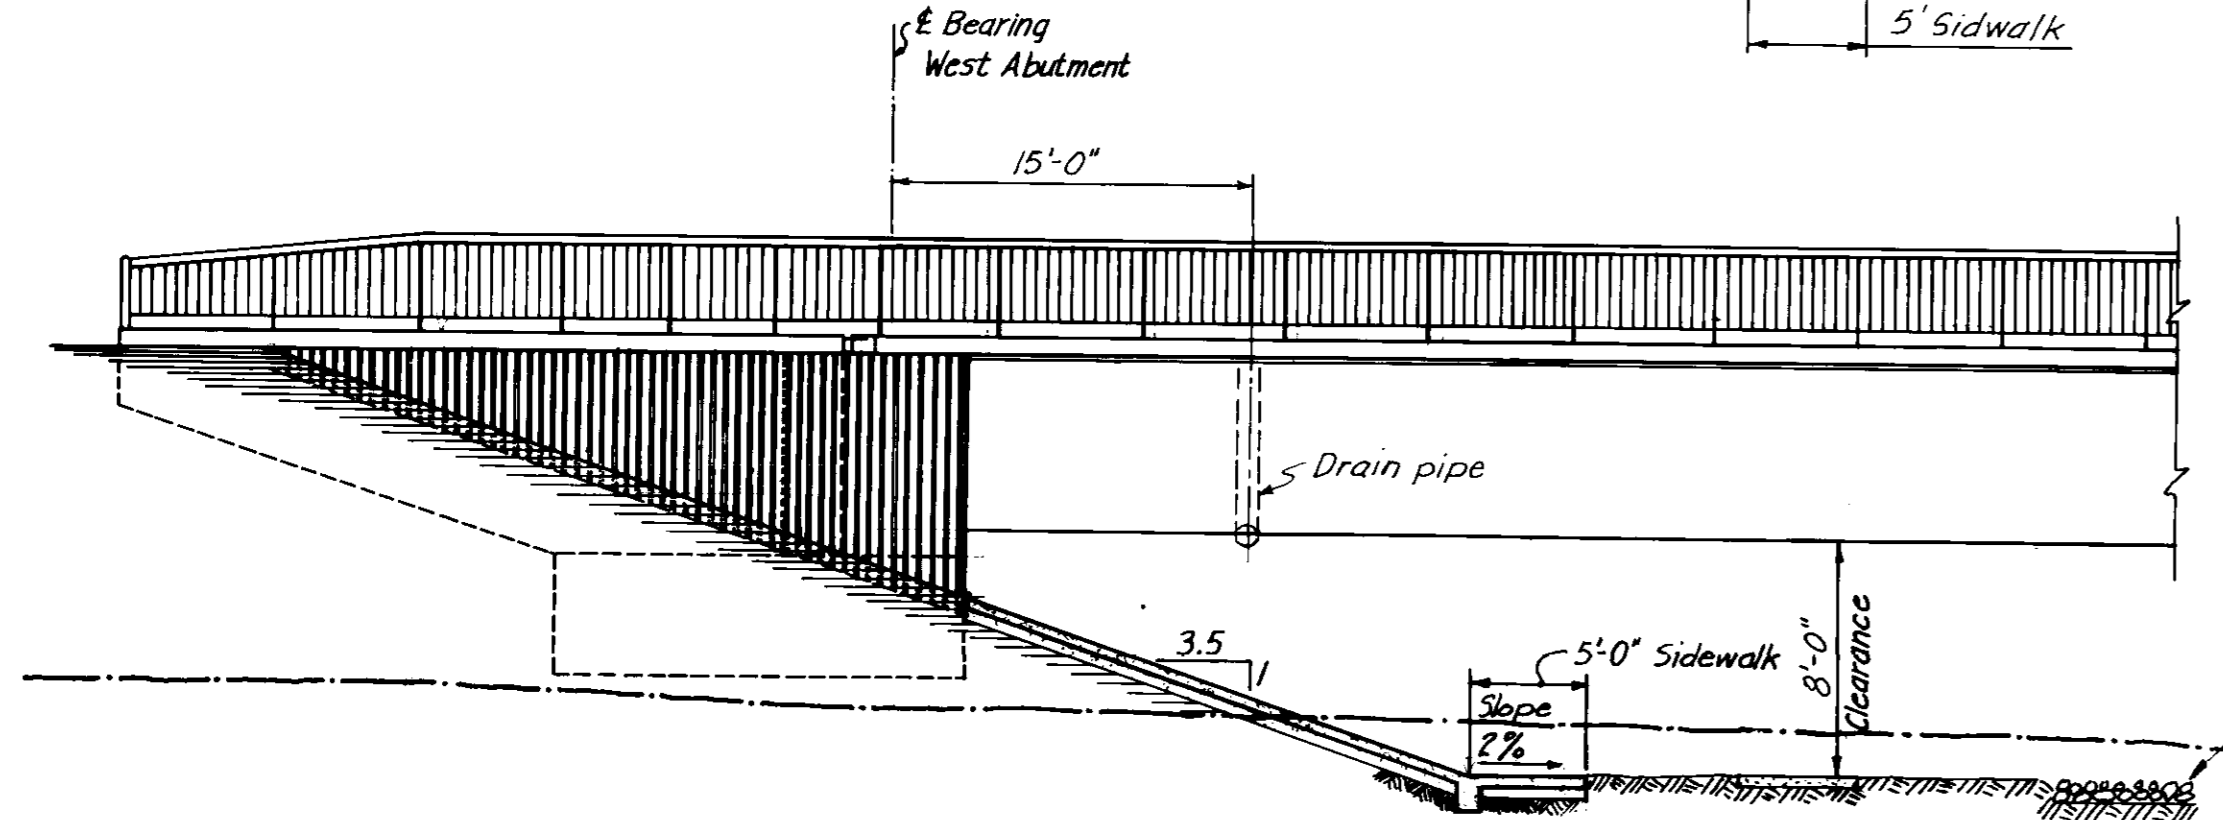

PARTIAL ELEVATION - SOUTH BRIDGE
Scale: 1/8" = 1'-0"

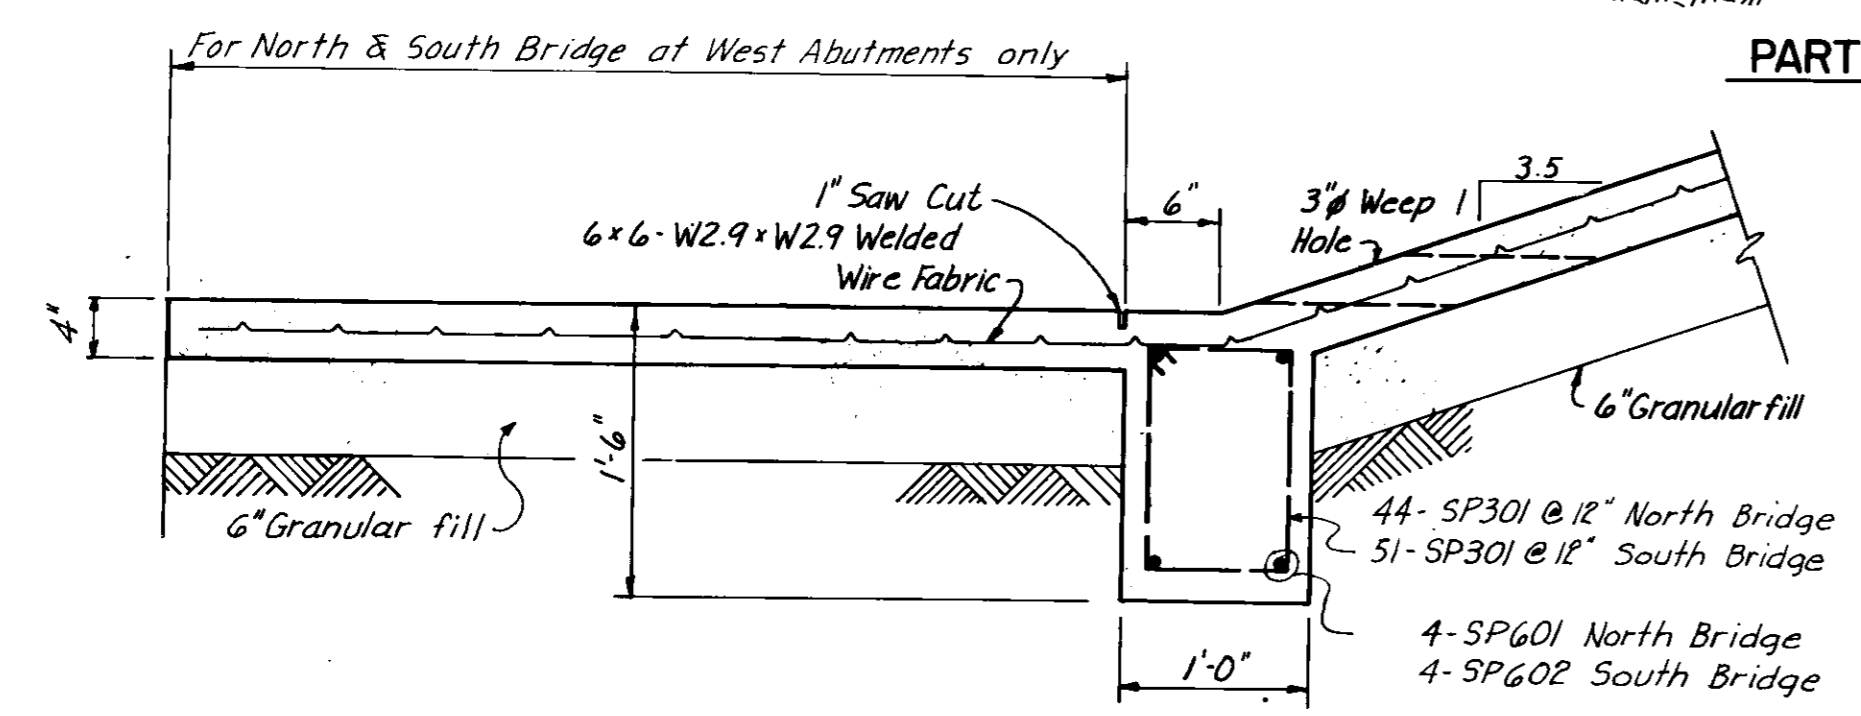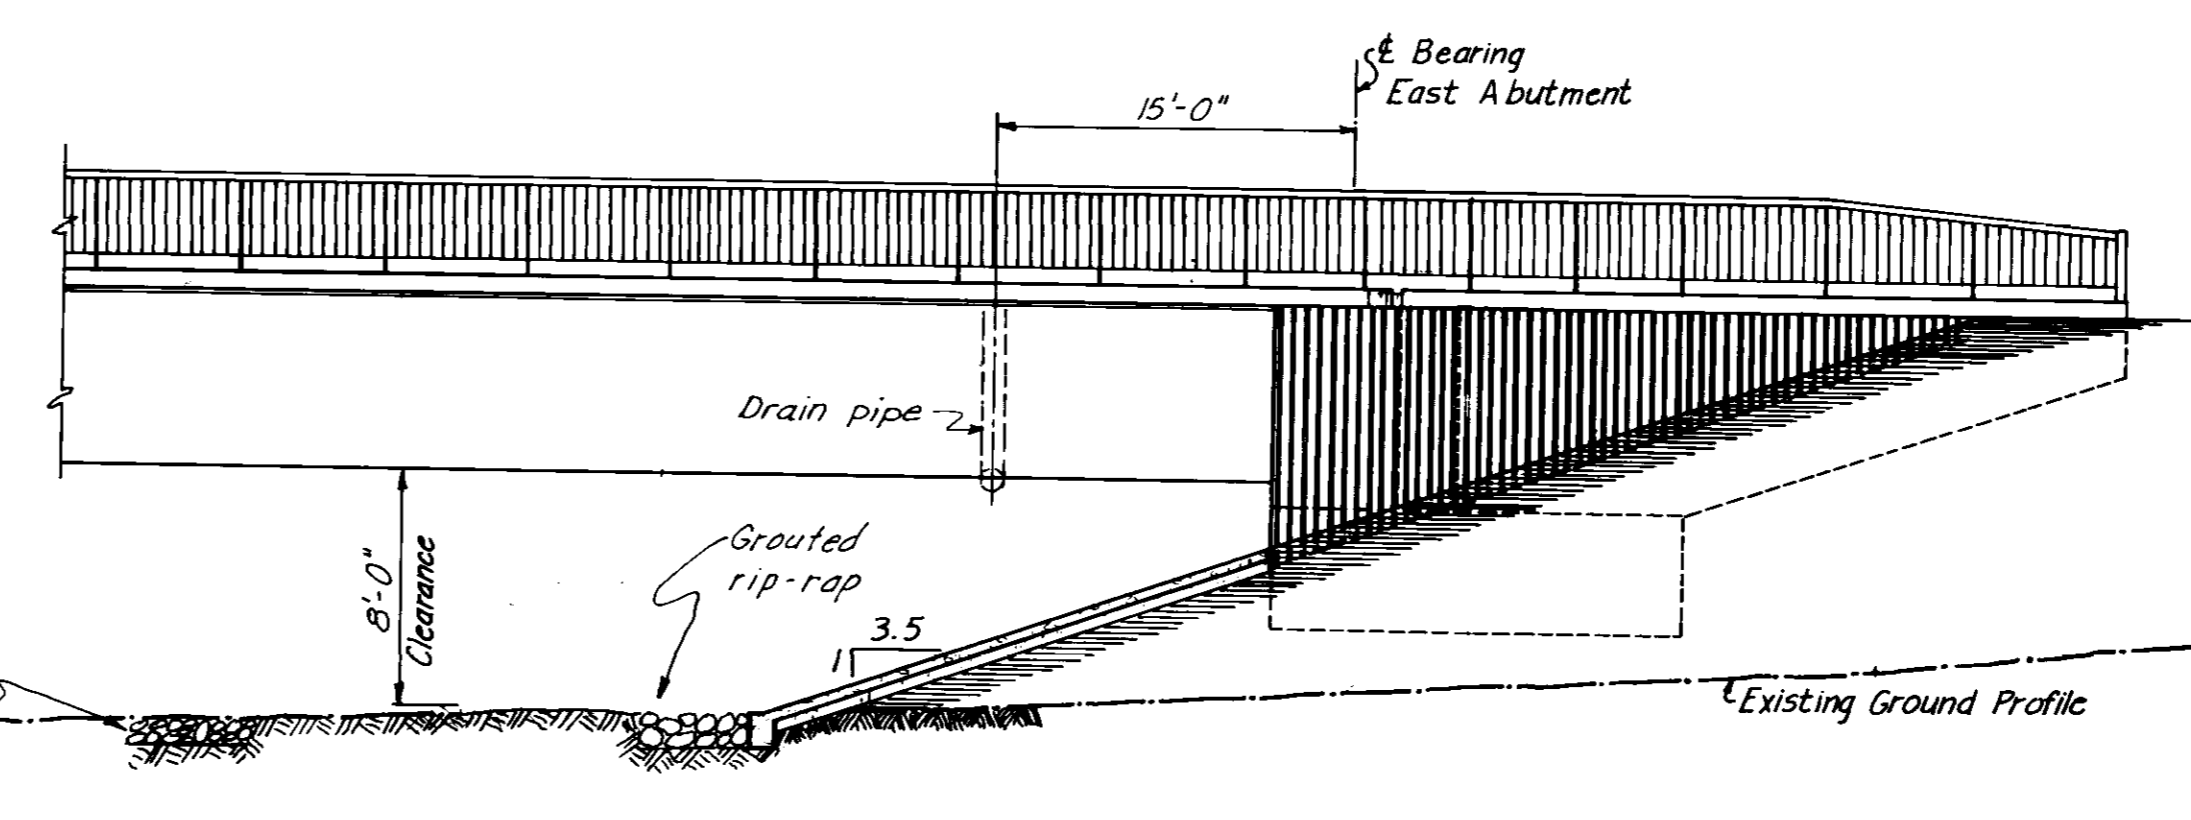


1 SECTION
204 Scale: 1" = 1'-0"

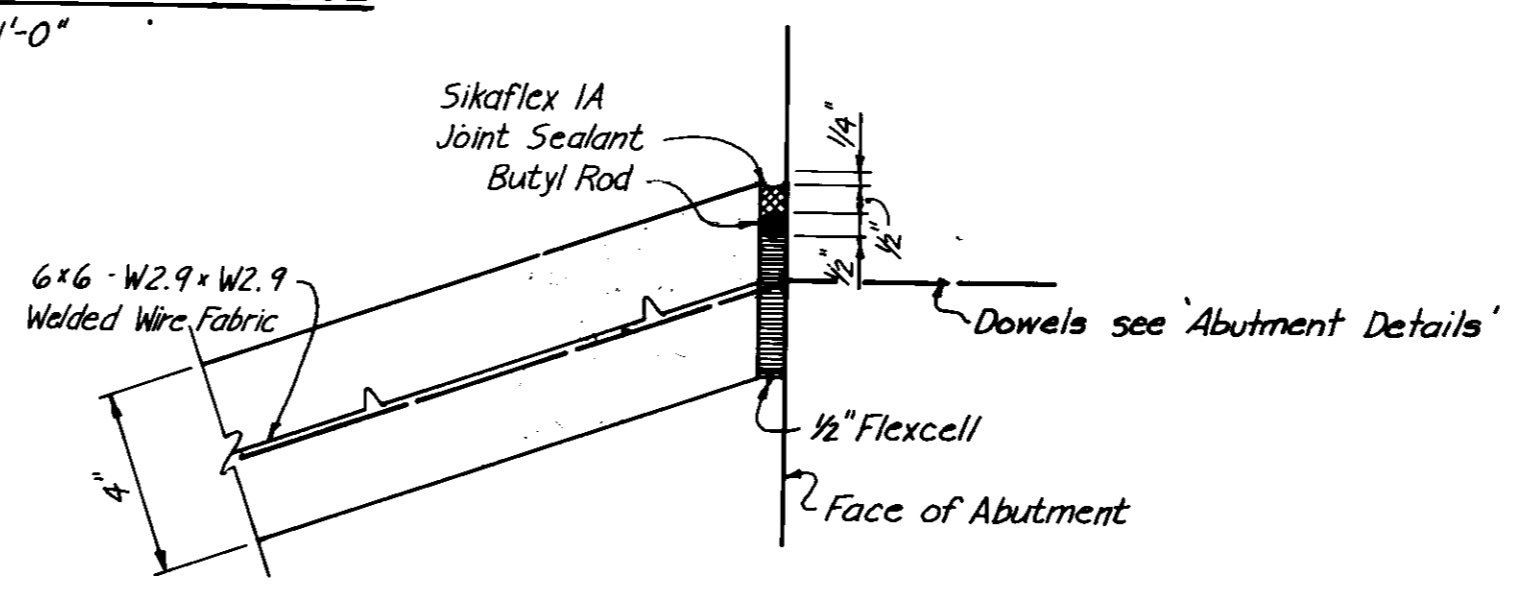

3 SECTION
204 Scale: 3" = 1'-0"

Notes:
1. The welded wire fabric shall be included as part of the concrete price for slope paving.

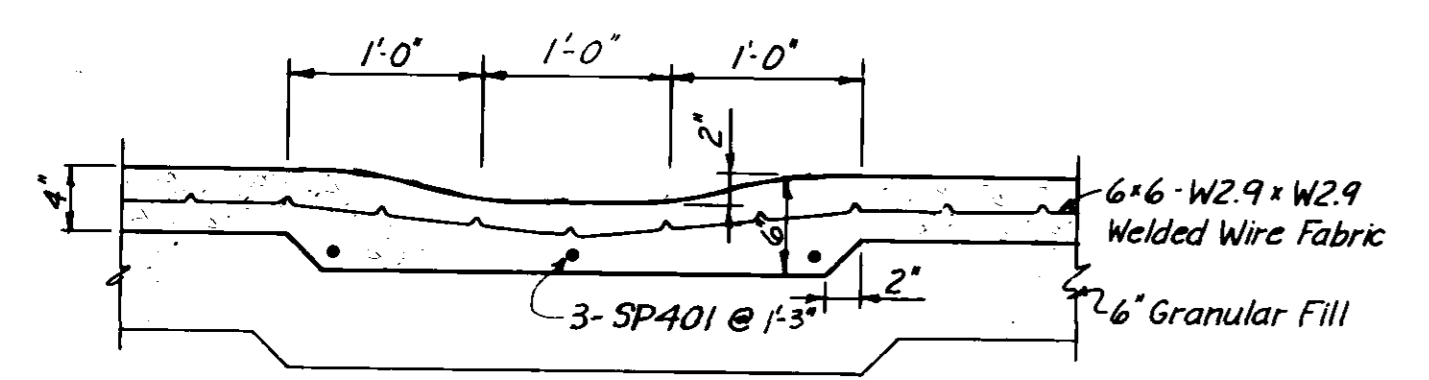


2 SECTION
204 Scale: 1" = 1'-0"

LOCATION APPROVED UNDERGROUND STRUCTURES
MARCH 28/77 *d. Martineau*
Supervisor

LOCATIONS OF UNDERGROUND STRUCTURES AS SHOWN ARE BASED ON THE BEST INFORMATION AVAILABLE, BUT NO GUARANTEE IS GIVEN THAT ALL EXISTING UTILITIES ARE SHOWN OR THAT THE GIVEN LOCATIONS ARE EXACT. CONFIRMATION OF EXISTENCE AND EXACT LOCATION OF ALL SERVICES MUST BE OBTAINED FROM THE INDIVIDUAL UTILITIES BEFORE PROCEEDING WITH CONSTRUCTION.

NO.	ISSUED FOR TENDER	DATE	BY
0	ISSUED FOR TENDER	4-4-77	
	REVISIONS		

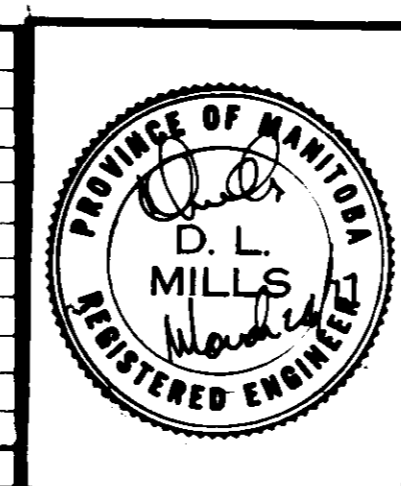

THE CITY OF WINNIPEG
WORKS & OPERATIONS DEPARTMENT
STREETS & TRANSPORTATION DIVISION

W.L. WARDROP & ASSOCIATES LTD.
ENGINEERING CONSULTANTS
WINNIPEG - THUNDER BAY - REGINA - BARRIE - EDMONTON

APPROVED BY: *[Signature]* DATE: 2/25/77

DRAWN BY: J.I.K. JAN 77
PRELIM. CHK. K.W.S. JAN 77

DESIGN: S.I.K. JAN 77
CHECK: J.H. JAN 77

ROUTE 165


SLOPE PAVING DETAILS

SCALE: AS SHOWN


DRAWING NO. B-5092-204

APPROVED BY: *[Signature]* DATE: 2/25/77
MANAGER OF STREETS AND TRAFFIC

NO. 16/75

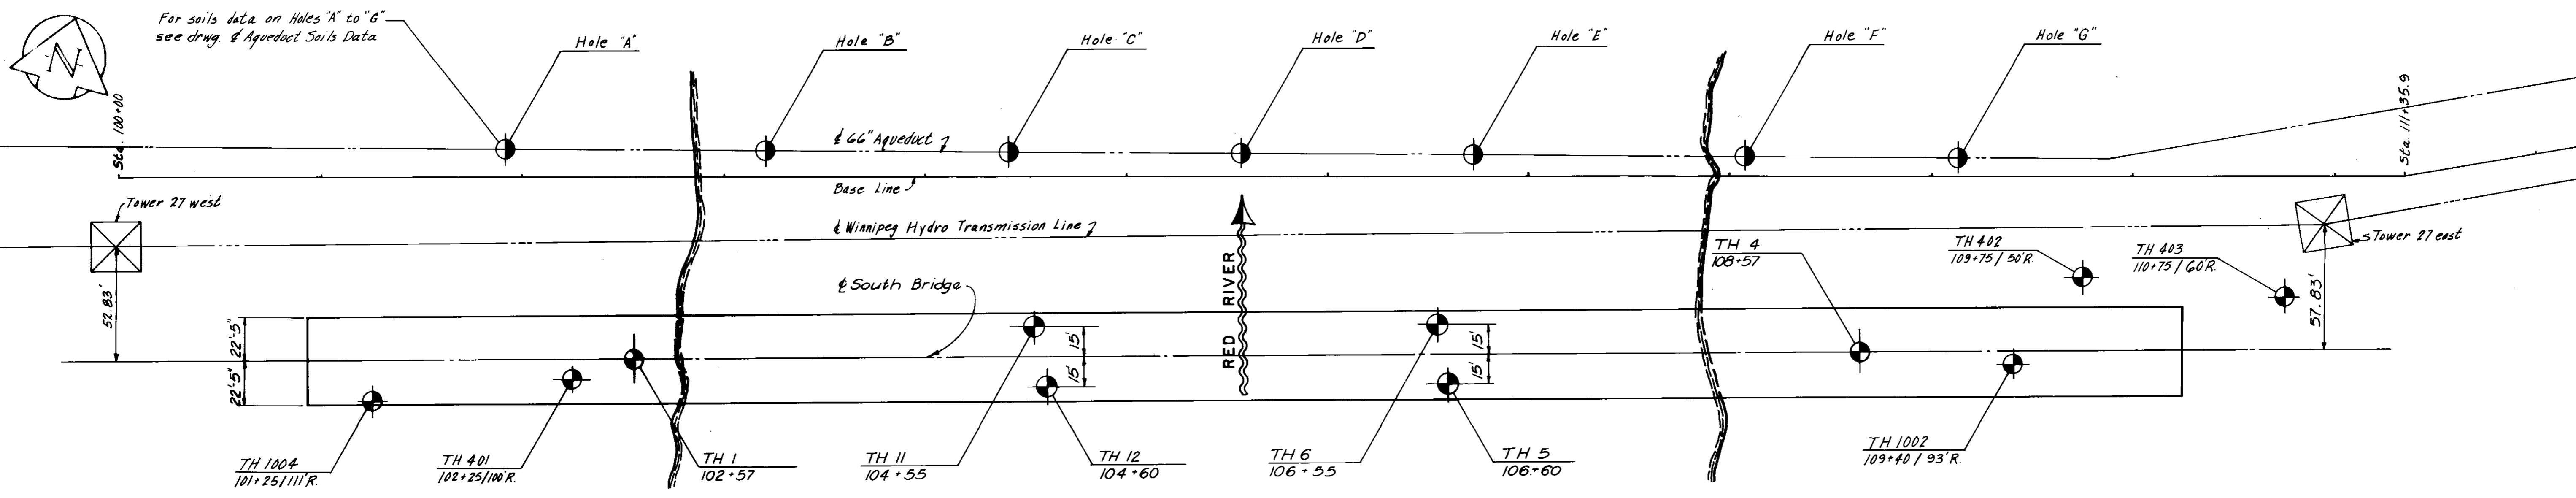

TEST HOLE LOCATION PLAN
Scale: 1"=40' 0"

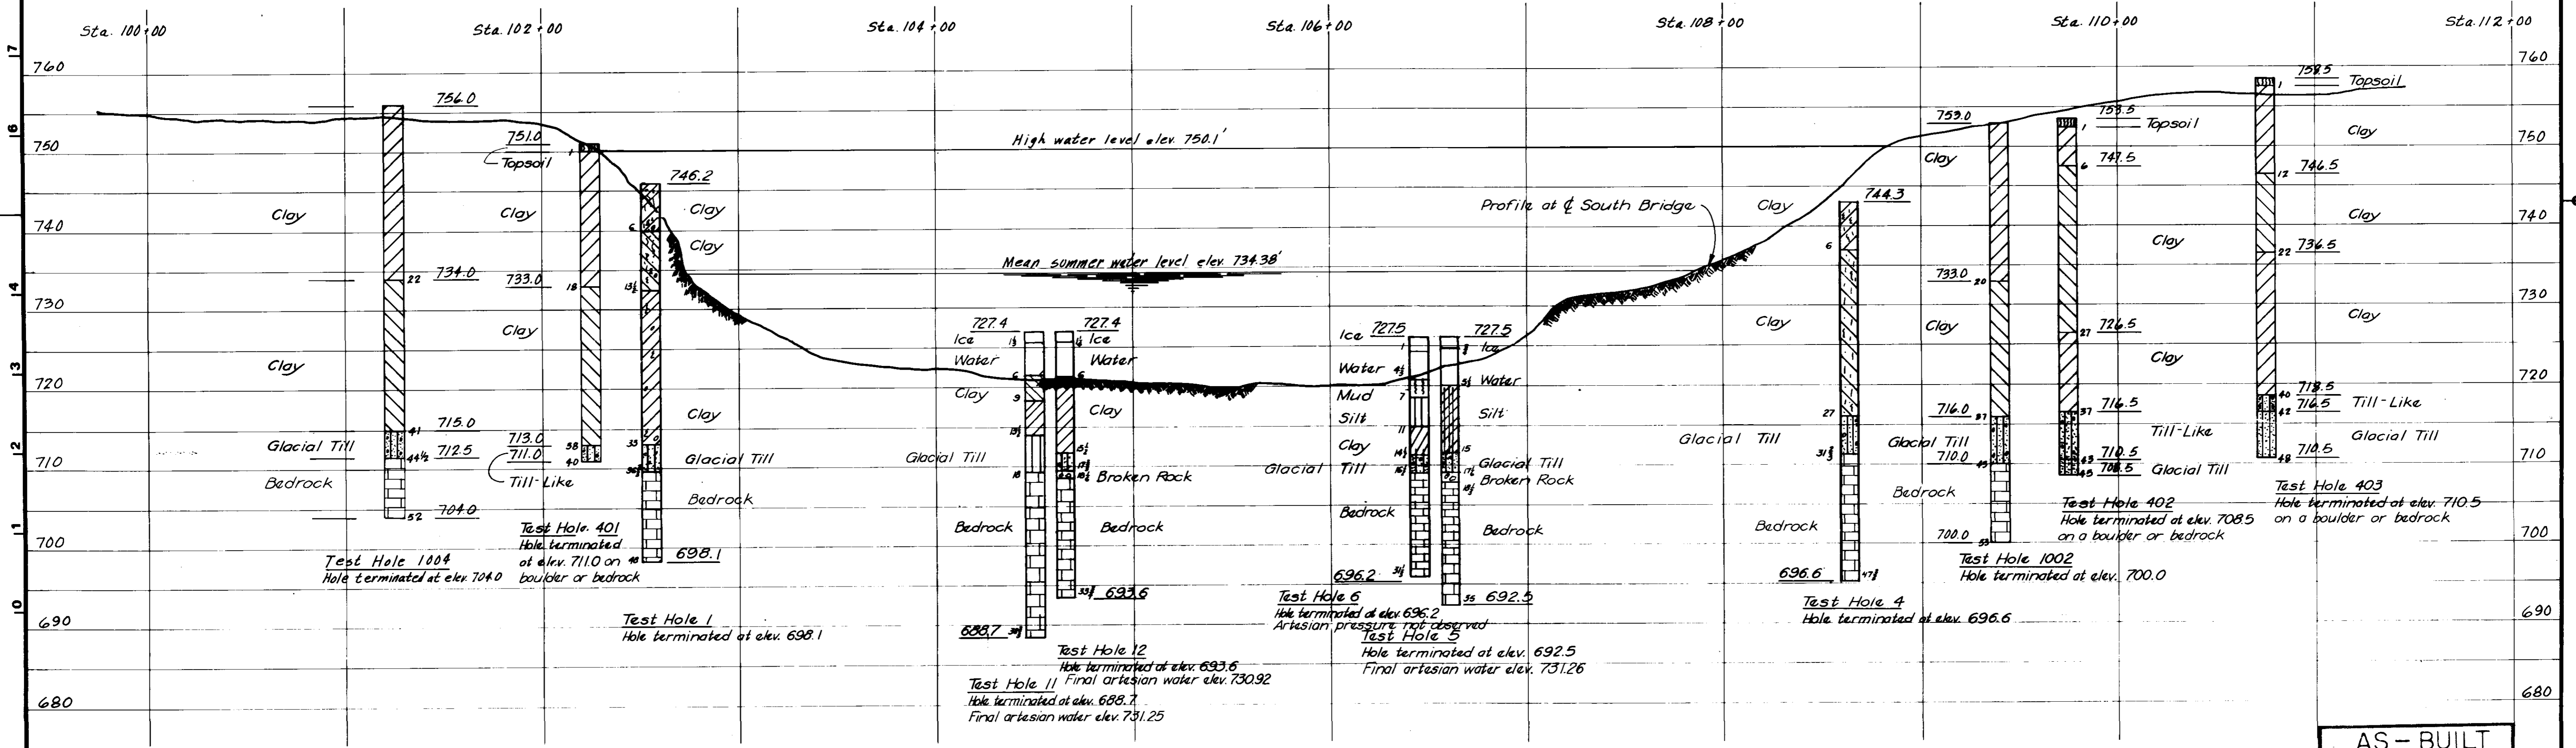

Legend:
 ● Bridge test holes
 ○ Aqueduct test holes for information only, taken from existing data (1960) see aqueduct soils data.

Notes:
 1. Subsurface information shown on this drawing was obtained solely for use in establishing design controls for the project. This information is not guaranteed to be accurate or all-inclusive and it is not to be construed as part of the plans governing construction of the project. The Contractor is to satisfy himself as to actual conditions prevailing at the site.
 2. Water levels measured at James Avenue Pumping Station.
 3. The above drawing should be read in conjunction with Klohn Leonoff Consultants Ltd's Report W-1064.


TEST HOLE DATA
Scale: Horiz. 1"=40' 0"
Vert. 1"=10' 0"

AS-BUILT
DATE: FB NO. PAGE
Nov 16/79


1. Subsurface information shown on this drawing was obtained solely for use in establishing design controls for the project. This information is not guaranteed to be accurate or all-inclusive and it is not to be construed as part of the plans governing construction of the project. The Contractor is to satisfy himself as to actual conditions prevailing at the site.
 2. Water levels measured at James Avenue Pumping Station.
 3. The above drawing should be read in conjunction with Klohn Leonoff Consultants Ltd's Report W-1064.

NO.	REVISIONS

	THE CITY OF WINNIPEG WORKS & OPERATIONS DEPARTMENT STREETS & TRANSPORTATION DIVISION	ROUTE 165		
	W.L. WARDROP & ASSOCIATES LTD. ENGINEERING CONSULTANTS WINNIPEG - THUNDER BAY - REGINA - BARRIE - EDMONTON	SOUTH BRIDGE SOILS DATA	SCALE: AS SHOWN	
APPROVED BY: <i>[Signature]</i> DATE: 25/11/79	DRAWN BY: LMG DATE: 12/11/77 PRELIM. CHK: L.S. DATE: 12/11/77	DESIGN: K.W.R. DATE: NOV 79 CHECK: [Signature] DATE: 25/11/79	APPROVED BY: <i>[Signature]</i> DATE: 25/11/79 MANAGER OF STREETS AND TRAFFIC	DRAWING NO. B-5092-205

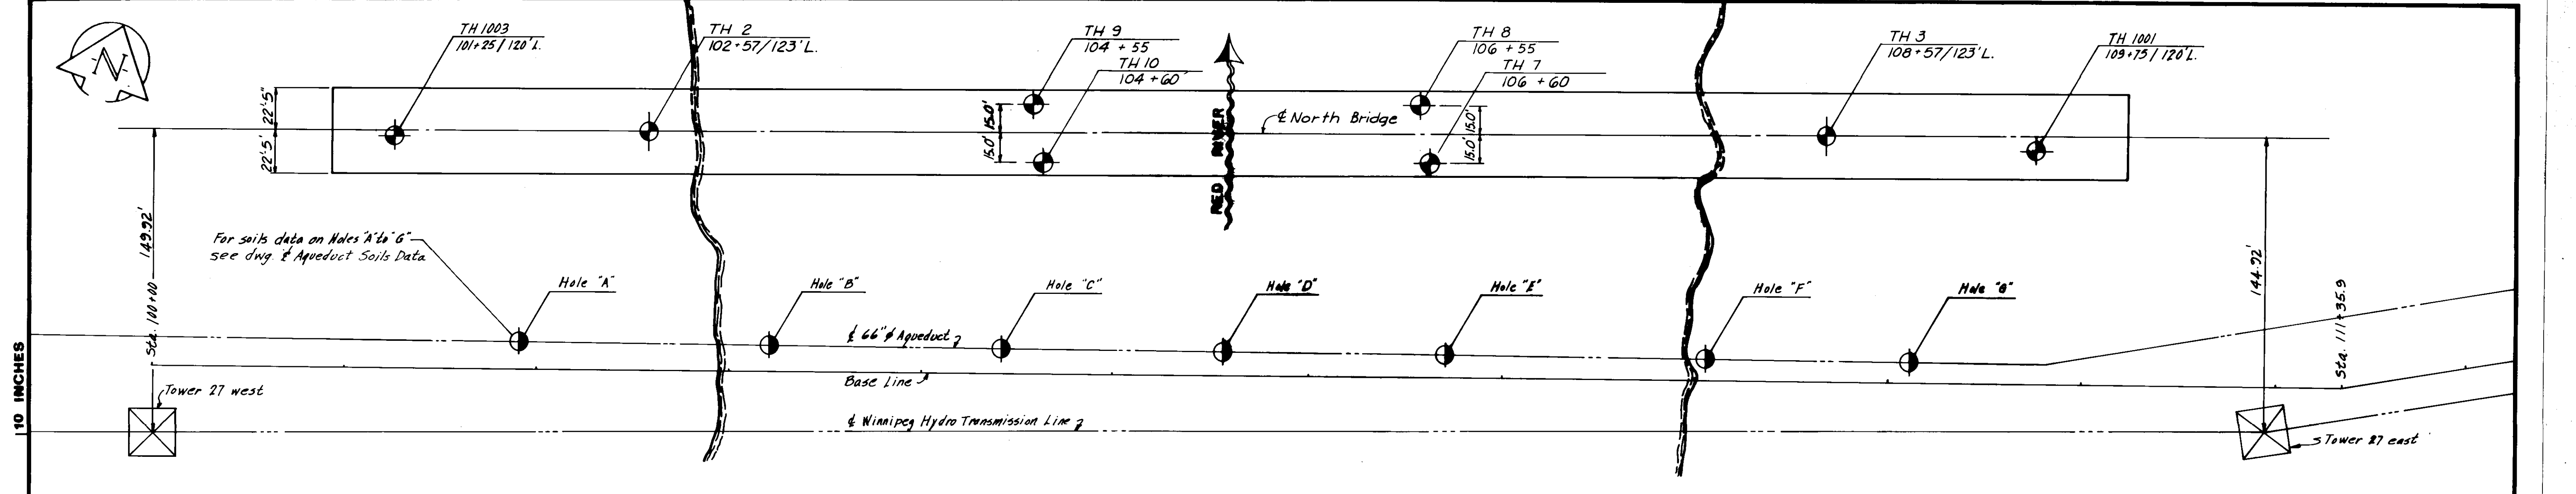

TEST HOLE LOCATION PLAN
Scale: 1" = 40'-0"

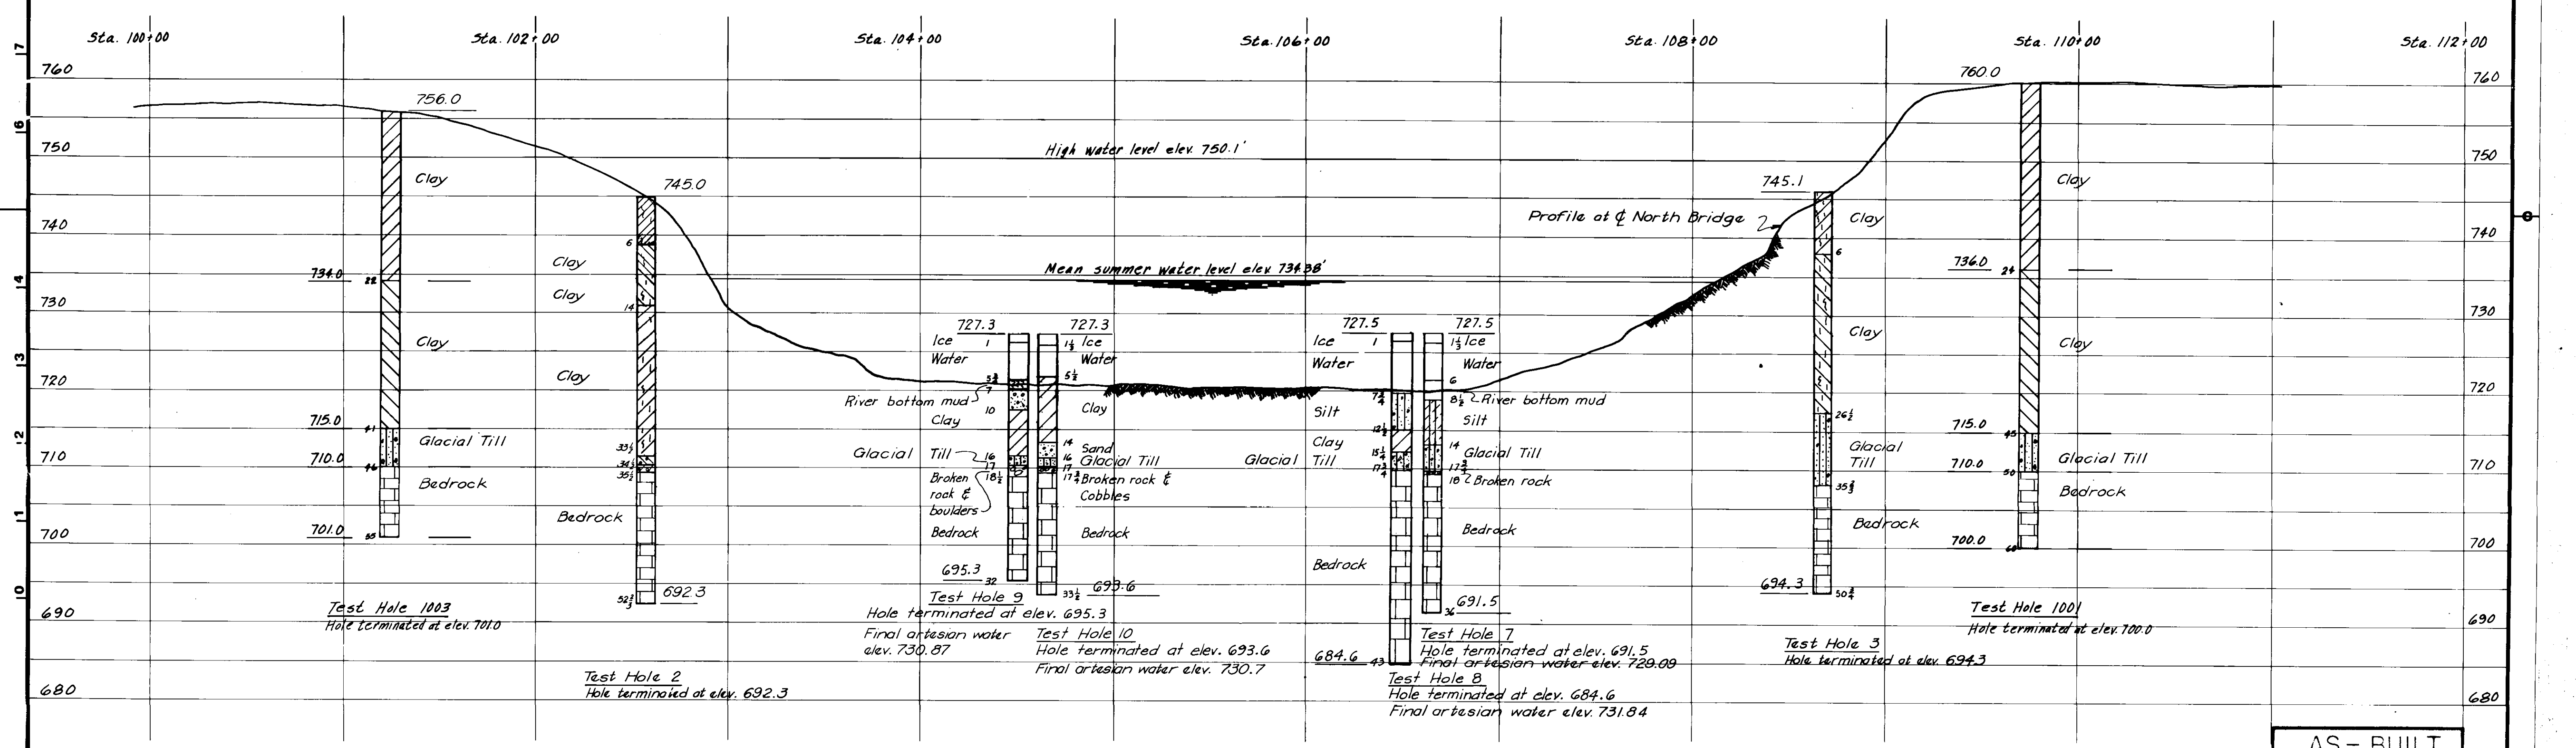

Legend:
 ● Bridge test holes
 ○ Aqueduct test holes for information only, taken from existing data (1960) see aqueduct soils data.


Notes:
 1. Subsurface information shown on this drawing was obtained solely for use in establishing design controls for the project. This information is not guaranteed to be accurate or all-inclusive and it is not to be construed as part of the plans governing construction of the project. The Contractor is to satisfy himself as to actual condition prevailing at the site.
 2. Water levels measured at James Avenue Pumping Station.
 3. The above drawing should be read in conjunction with Klohn Leonoff Consultant Ltd's Report W-1064.

TEST HOLE DATA
Scale: Horiz. 1" = 40'-0"
Vert. 1" = 10'-0"

AS-BUILT
DATE: FB NO. PAGE
Nov. 16/79

1. Subsurface information shown on this drawing was obtained solely for use in establishing design controls for the project. This information is not guaranteed to be accurate or all-inclusive and it is not to be construed as part of the plans governing construction of the project. The Contractor is to satisfy himself as to actual condition prevailing at the site.
 2. Water levels measured at James Avenue Pumping Station.
 3. The above drawing should be read in conjunction with Klohn Leonoff Consultant Ltd's Report W-1064.

NO.	REVISIONS	DATE	BY

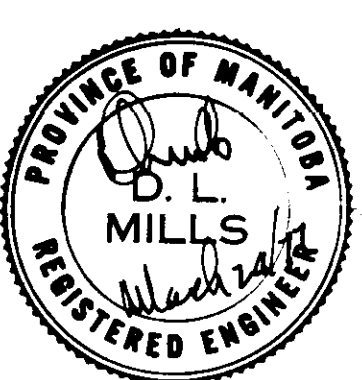

THE CITY OF WINNIPEG
WORKS & OPERATIONS DEPARTMENT
STREETS & TRANSPORTATION DIVISION

APPROVED BY: [Signature] DATE: 23 Nov 79

DESIGNED BY: J.M.S. DATE: NOV 79
 PRELIM. CHK. L.V.S. DATE: 21 79

ROUTE 165


NORTH BRIDGE SOILS DATA

APPROVED BY: [Signature] DATE: 25/11/79
 MANAGER OF STREETS AND TRAFFIC

SCALE:
AS SHOWN


DRAWING NO.
B-5092-206

DETAILS 74012-21

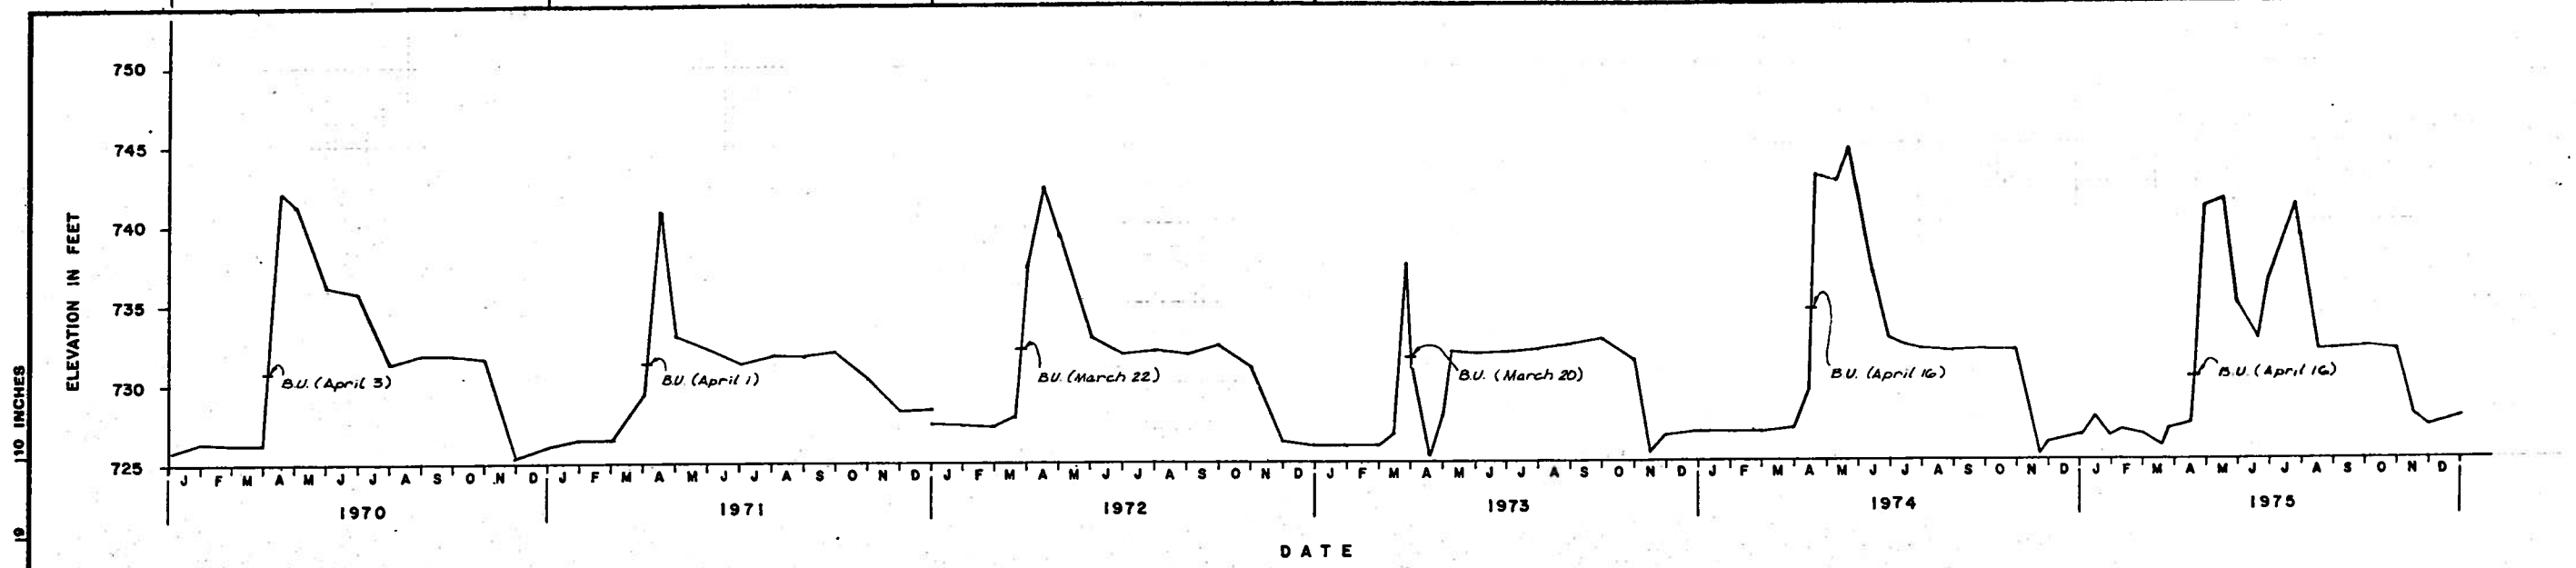

RED RIVER WATER LEVELS - (1970-1975)

- Notes:
1. Water levels were taken from "Surface Water Data Manitoba" Water Surveys of Canada manuals.
 2. 1970 and 1971 were taken at Winnipeg station no. 050J001.
 3. 1972 to 1975 were taken at James Ave. pumping station no. 050J015.
 4. Add 2' to all levels to adjust to bridge site.
 5. B.U. means Break Up.

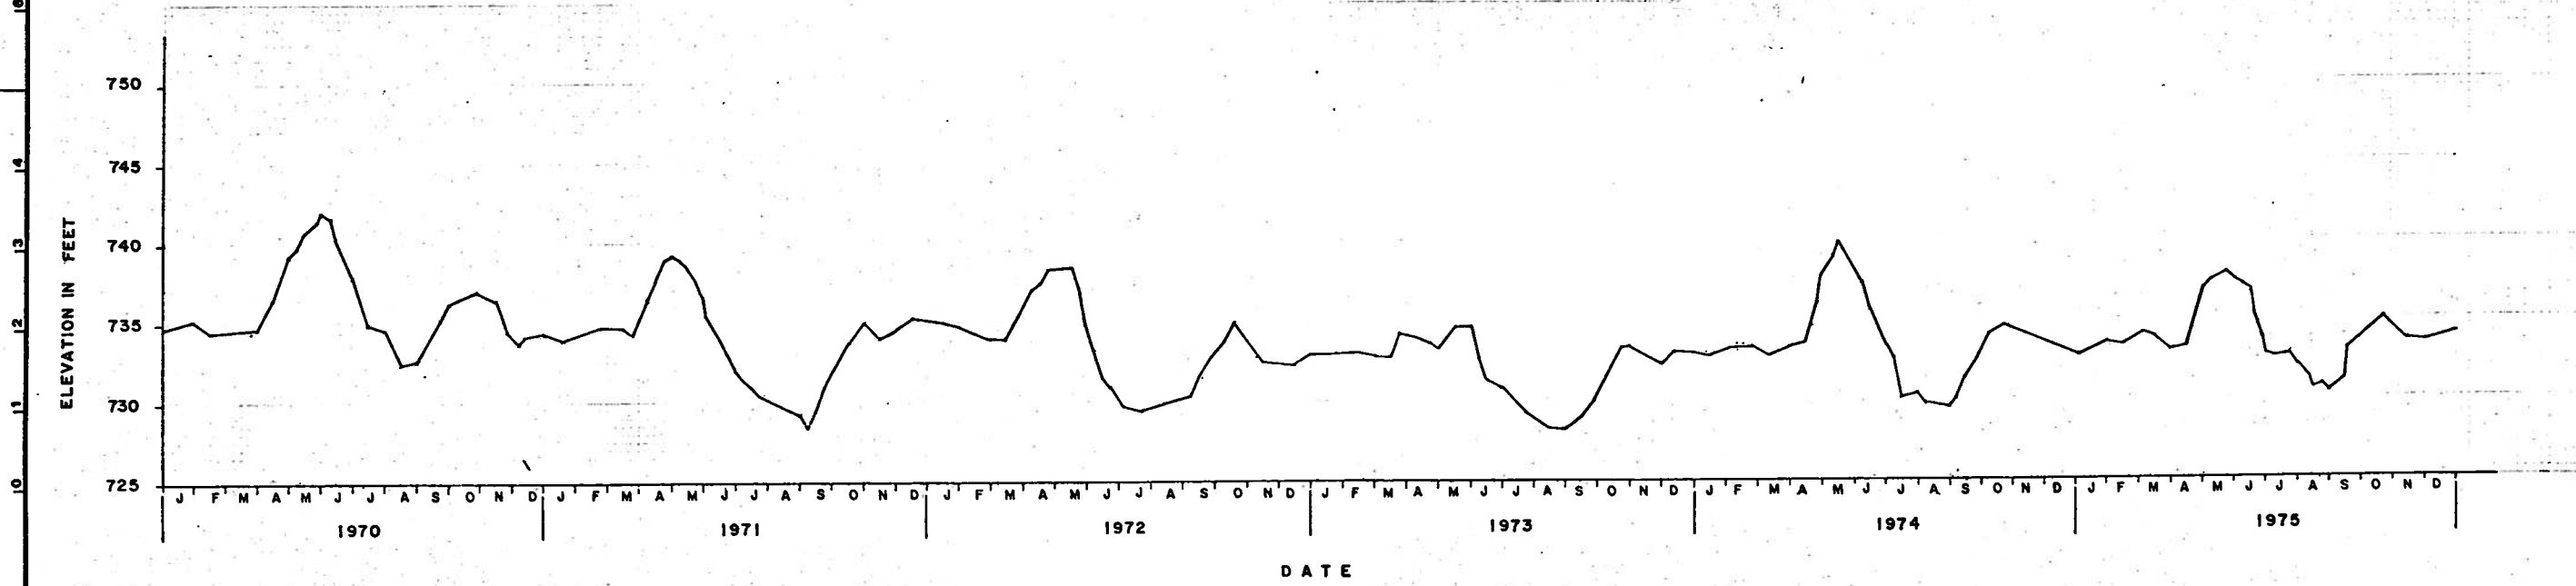


GROUNDWATER LEVEL HYDROGRAPH - (1970-1975)

Note:
Water levels information shown on this drawing was obtained solely for use in establishing design controls for the project. This information is not guaranteed to be accurate or all-inclusive and it is not to be construed as part of the plans governing construction of the project. The Contractor is to satisfy himself as to actual conditions prevailing at the site.

- Notes:
1. Data was taken from Province of Manitoba, Water Resources Branch file no. 10-1-7-1138.
 2. The data was taken at station 067, 50C-MN5

AS - BUILT		
DATE	FB NO.	PAGE
Nov. 1/79		

ISSUED FOR TENDER	4-7-77
-------------------	--------

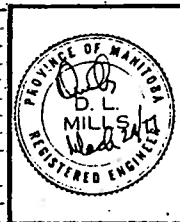

THE CITY OF WINNIPEG
WORKS & OPERATIONS DEPARTMENT
STREETS & TRANSPORTATION DIVISION

W.L. WARDROP & ASSOCIATES LTD.
ENGINEERING CONSULTANTS
WINNIPEG - THUNDER BAY - REGINA - SASKATOON

APPROVED BY: *[Signature]* DATE: 25 May 77

DRAWN BY: W.T. DATE: 2/11/77
PRELIM. CHK: DATE: 4/1/77
DESIGN: DATE: 4/1/77
CHECK: DATE: 4/1/77

ROUTE 165


WATER LEVEL DATA

SCALE:


DRAWING NO. B-5092-208

APPROVED BY: *[Signature]* DATE: 15/1/77
MANAGER OF STREETS AND TRAFFIC


10 INCHES
19
18
17
16
14
13
12
11
10

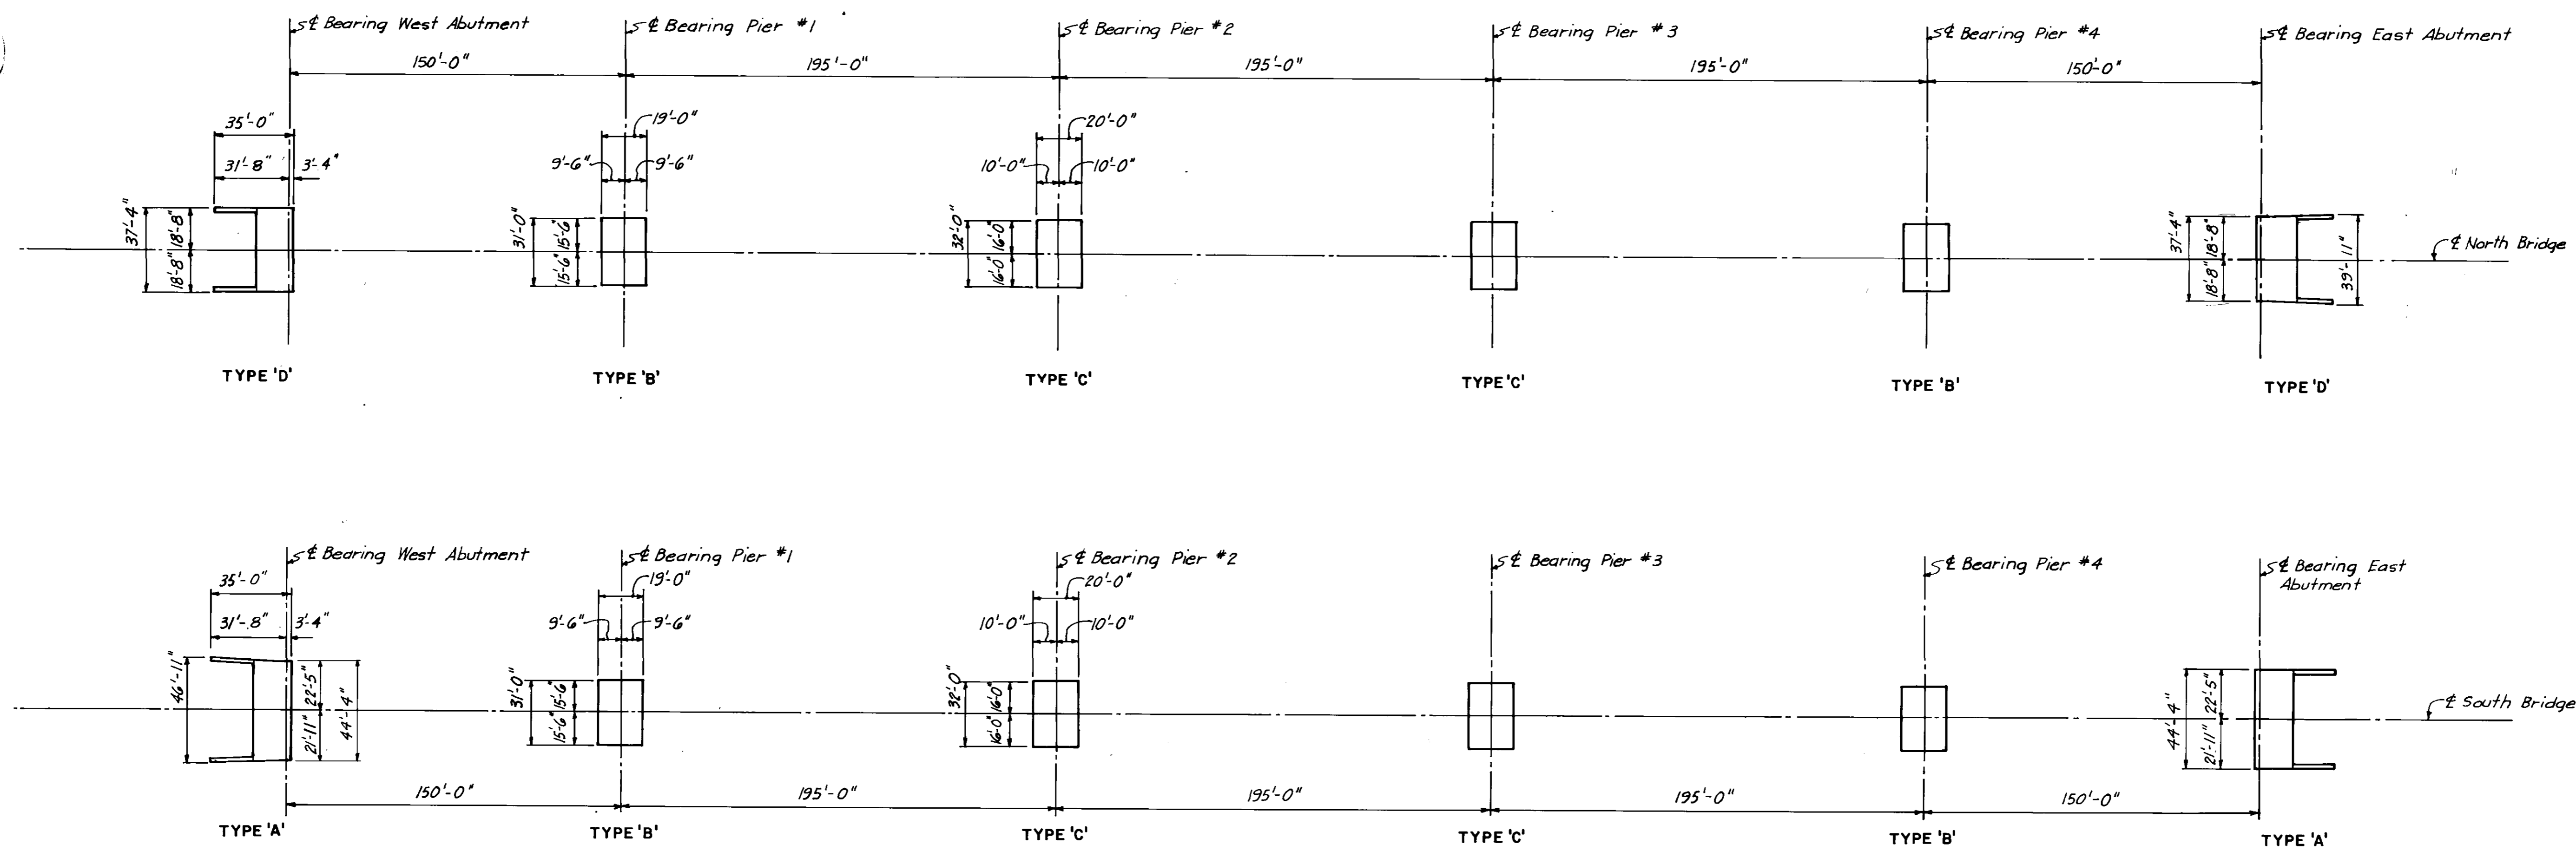


PLAN
Scale: 1" = 40'-0"

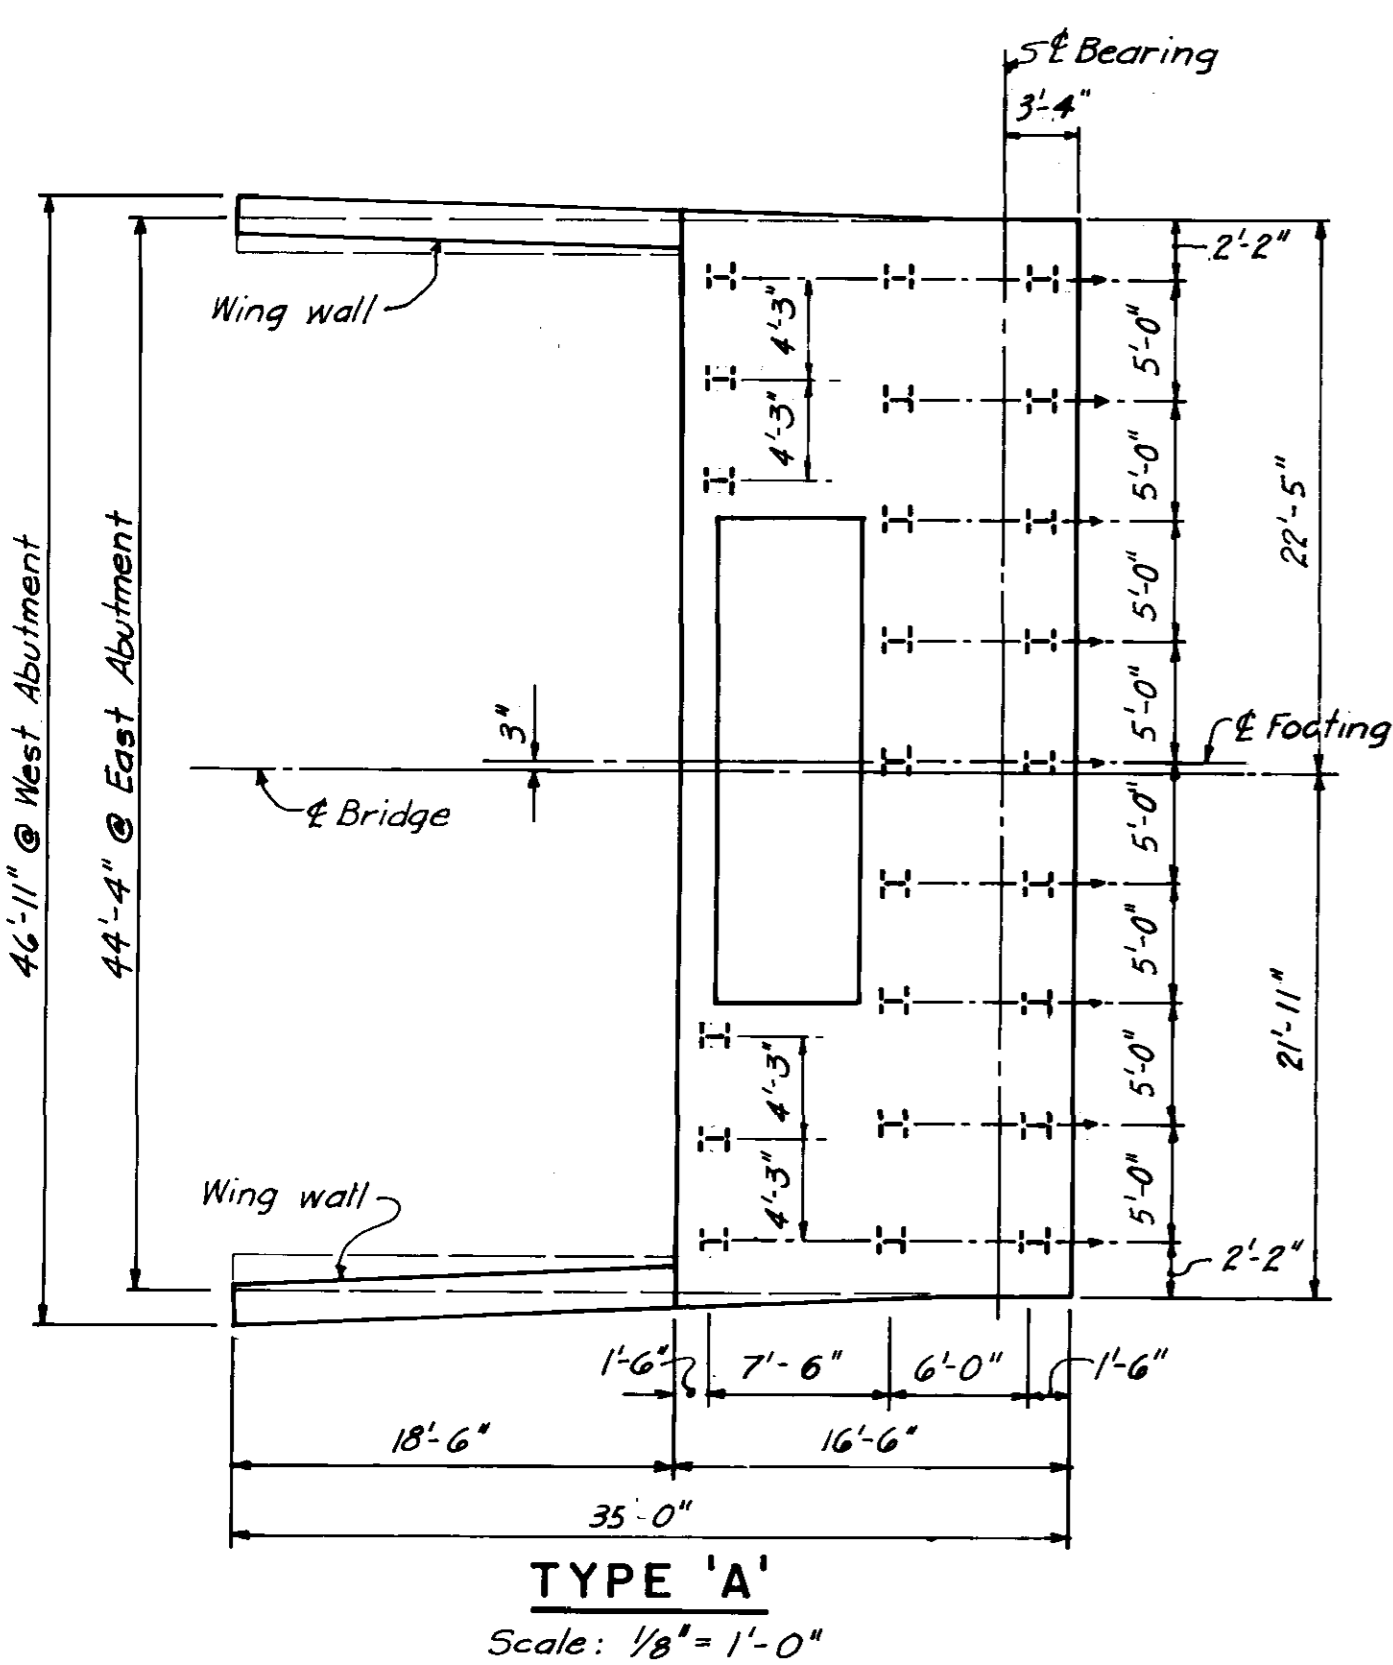


TYPE 'A'
Scale: 1/8" = 1'-0"

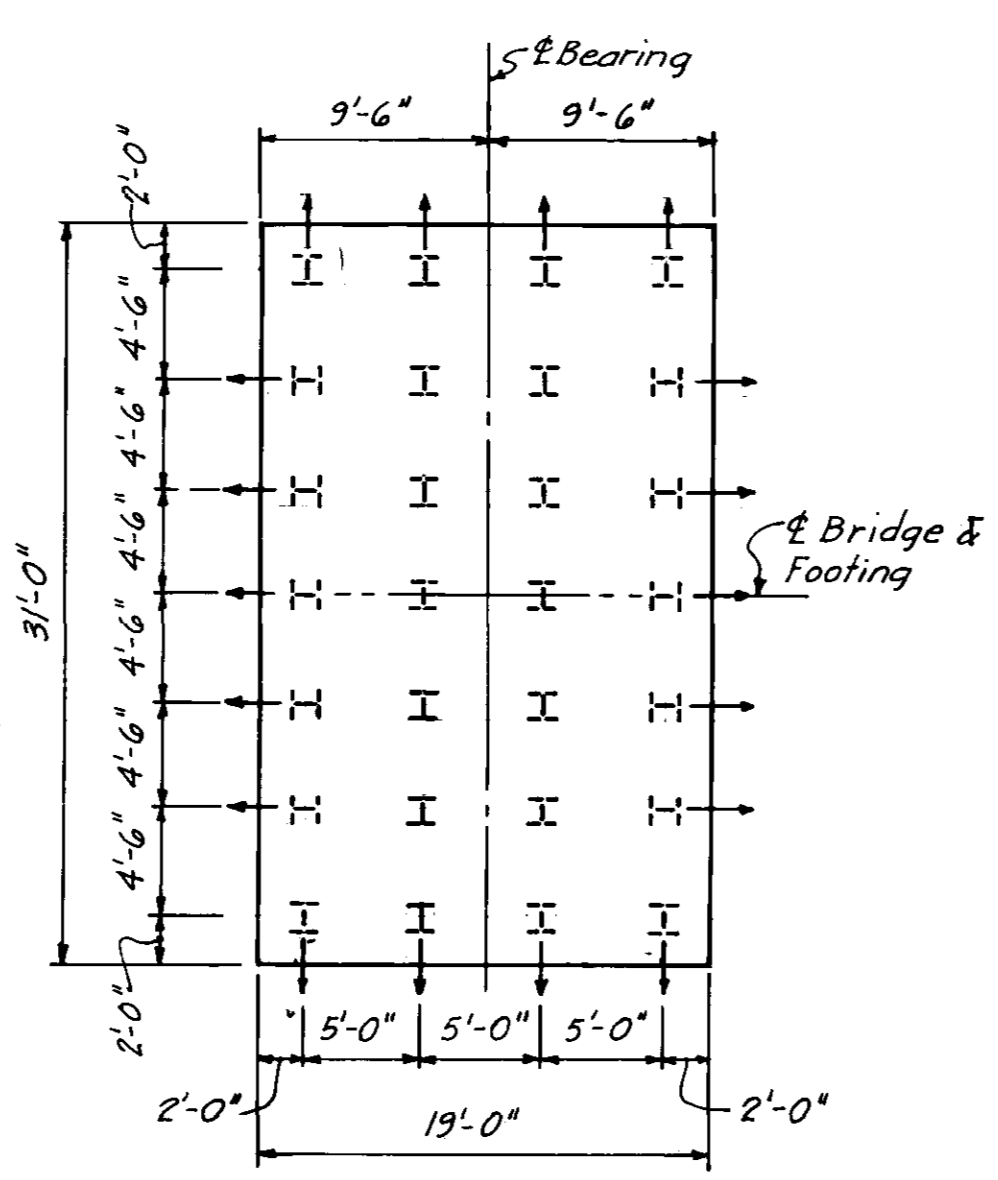

TYPE 'B'
Scale: 1/8" = 1'-0"

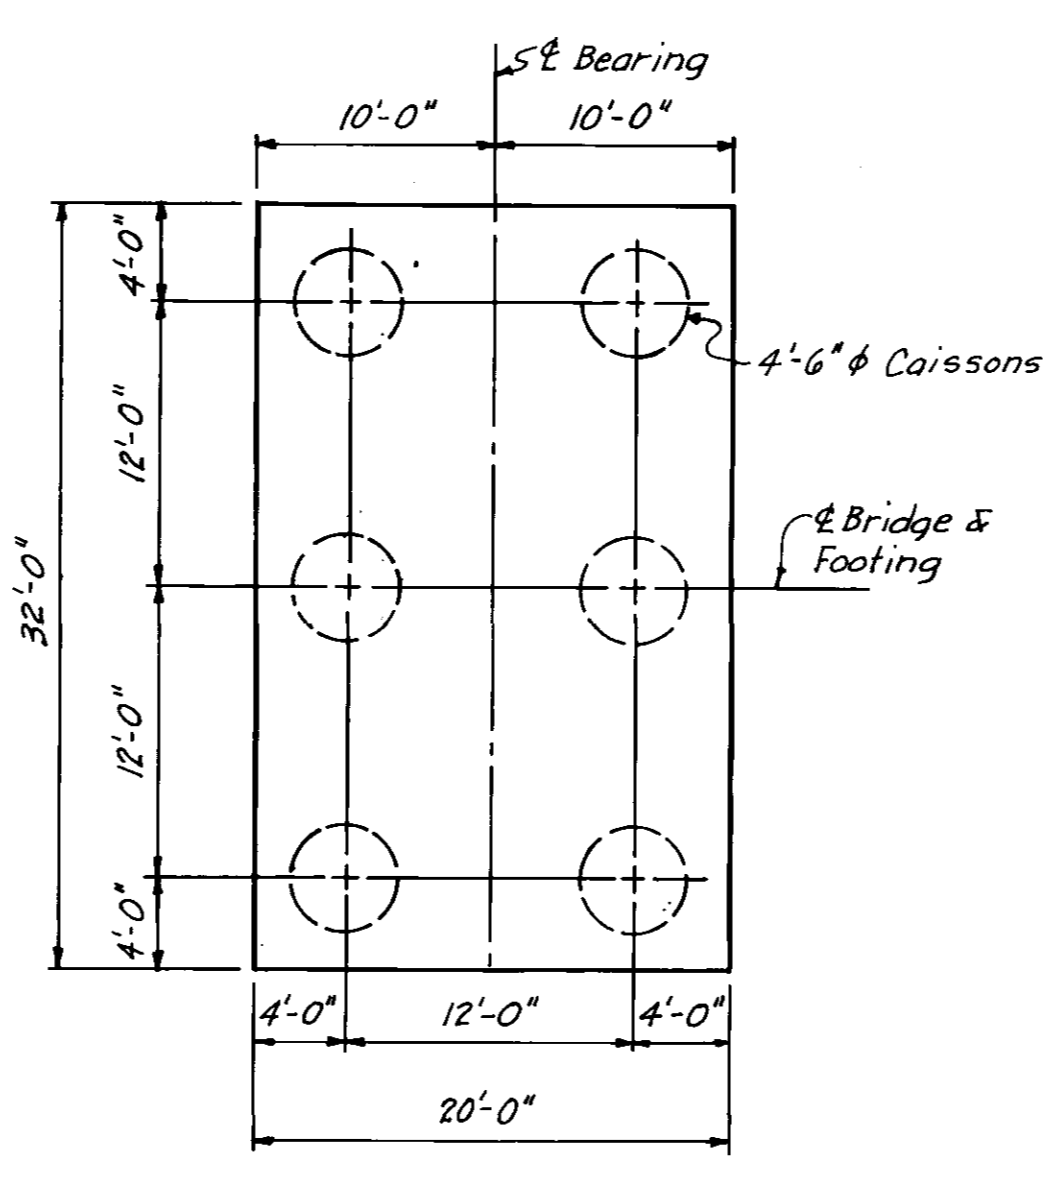

TYPE 'C'
Scale: 1/8" = 1'-0"

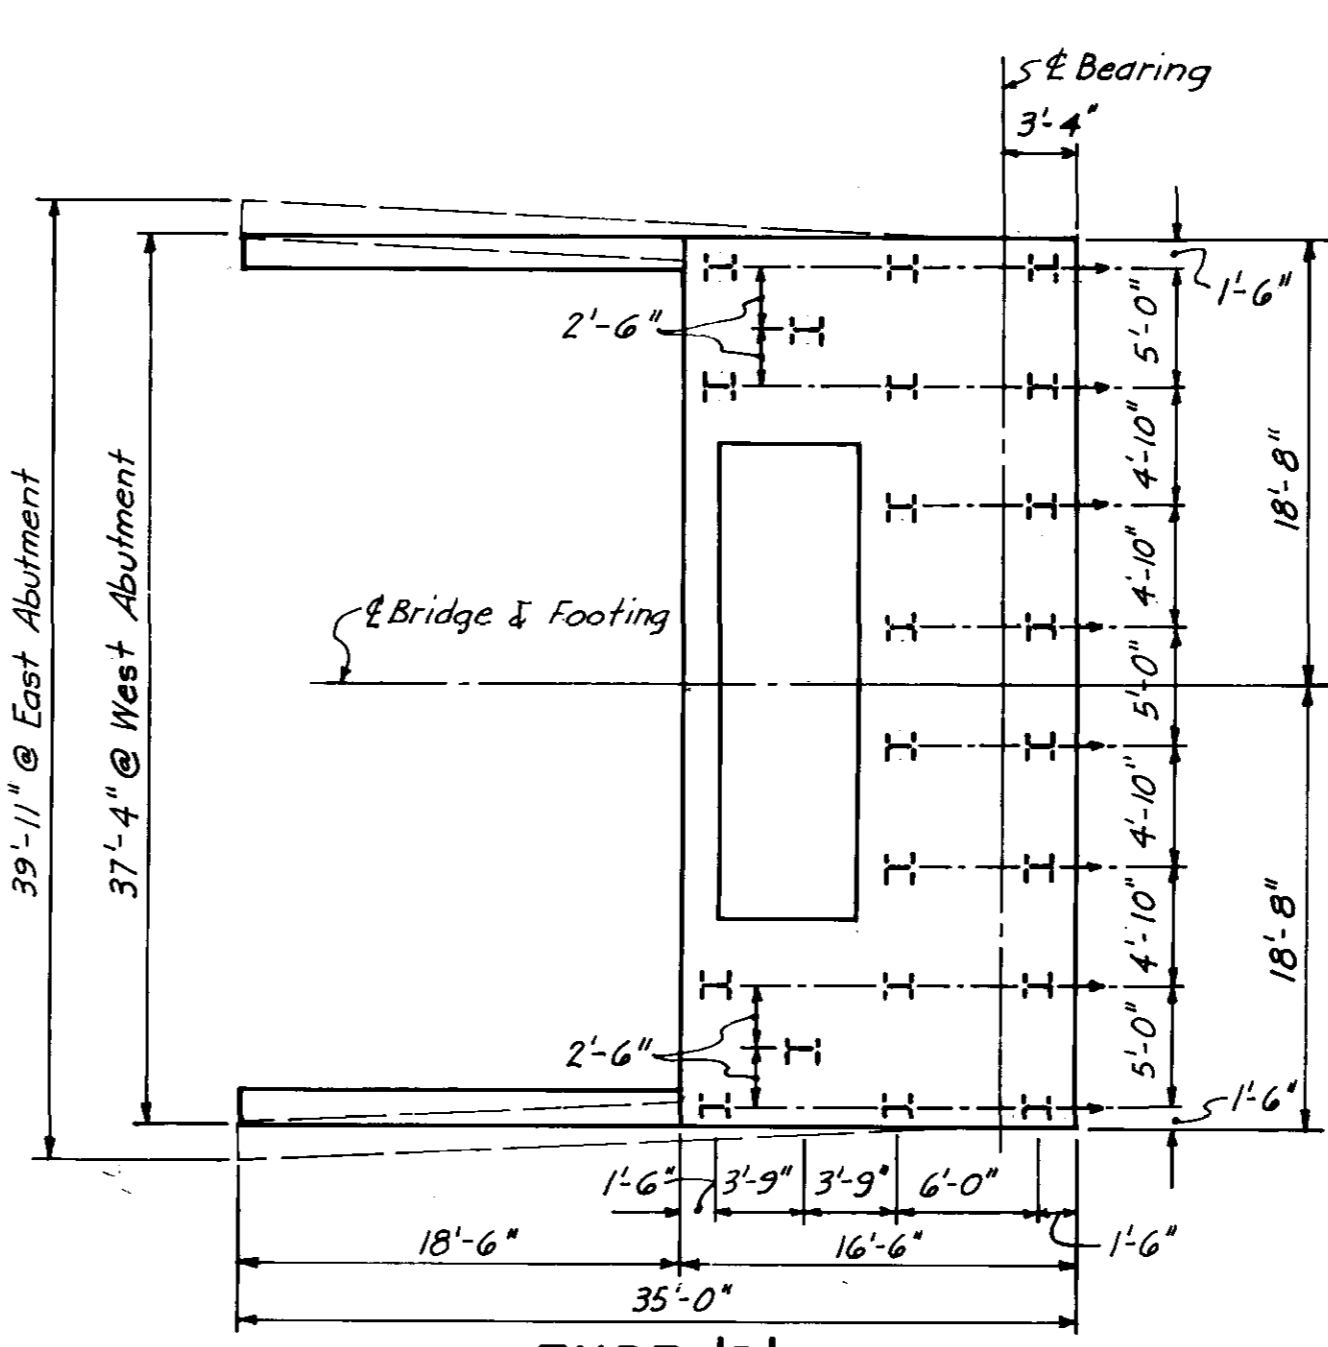


TYPE 'D'
Scale: 1/8" = 1'-0"

SUBSTRUCTURE LOADING			
UNIT	TYPE	LOADS	
		MAX./PILE	MIN./PILE
Abutments	HP 12 x 74	65 Tons	2 Tons
Piers 1 and 4	HP 12 x 74	75 Tons	13 Tons
Piers 2 and 3	Caissons (4'-6")	550 Tons	43 Tons

AS - BUILT		
DATE	FB. NO.	PAGE
Nov. 14/79		

NO.	REVISIONS	DATE	BY
0	ISSUED FOR TENDER	4-4-77	

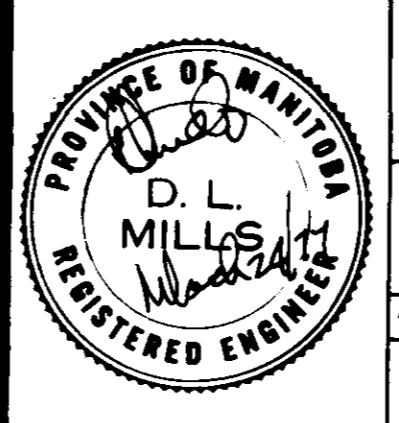

THE CITY OF WINNIPEG
WORKS & OPERATIONS DEPARTMENT
STREETS & TRANSPORTATION DIVISION

W. L. WARDROP & ASSOCIATES LTD.
ENGINEERING CONSULTANTS
WINNIPEG - THUNDER BAY - REGINA - BARRIE - EDMONTON

APPROVED BY: *[Signature]* DATE: 25 Nov 77
DRAWN BY: S.T. JAN 77 DESIGN: S.T.K. DEC 76
PRELIM. CHK: S.T.K. JAN 77 CHECK: D.L.M. JAN 77

ROUTE 165




FOUNDATION LAYOUT

APPROVED BY: *[Signature]* DATE: 25/11/77
MANAGER OF STREETS AND TRAFFIC

SCALE:
AS SHOWN








DRAWING NO.
B-5092-209

10 INCHES
9
18
17
16
15
14
13
12
11
10

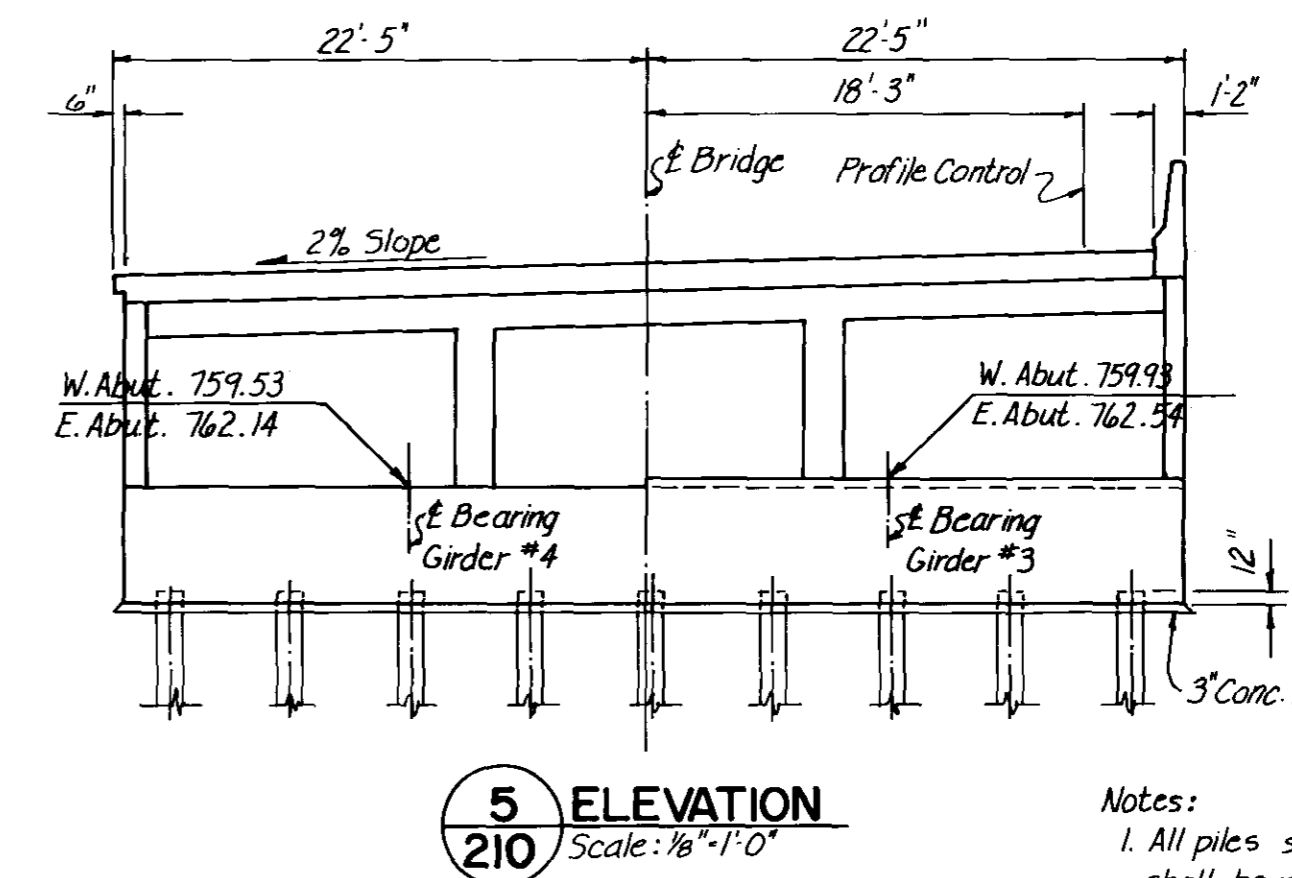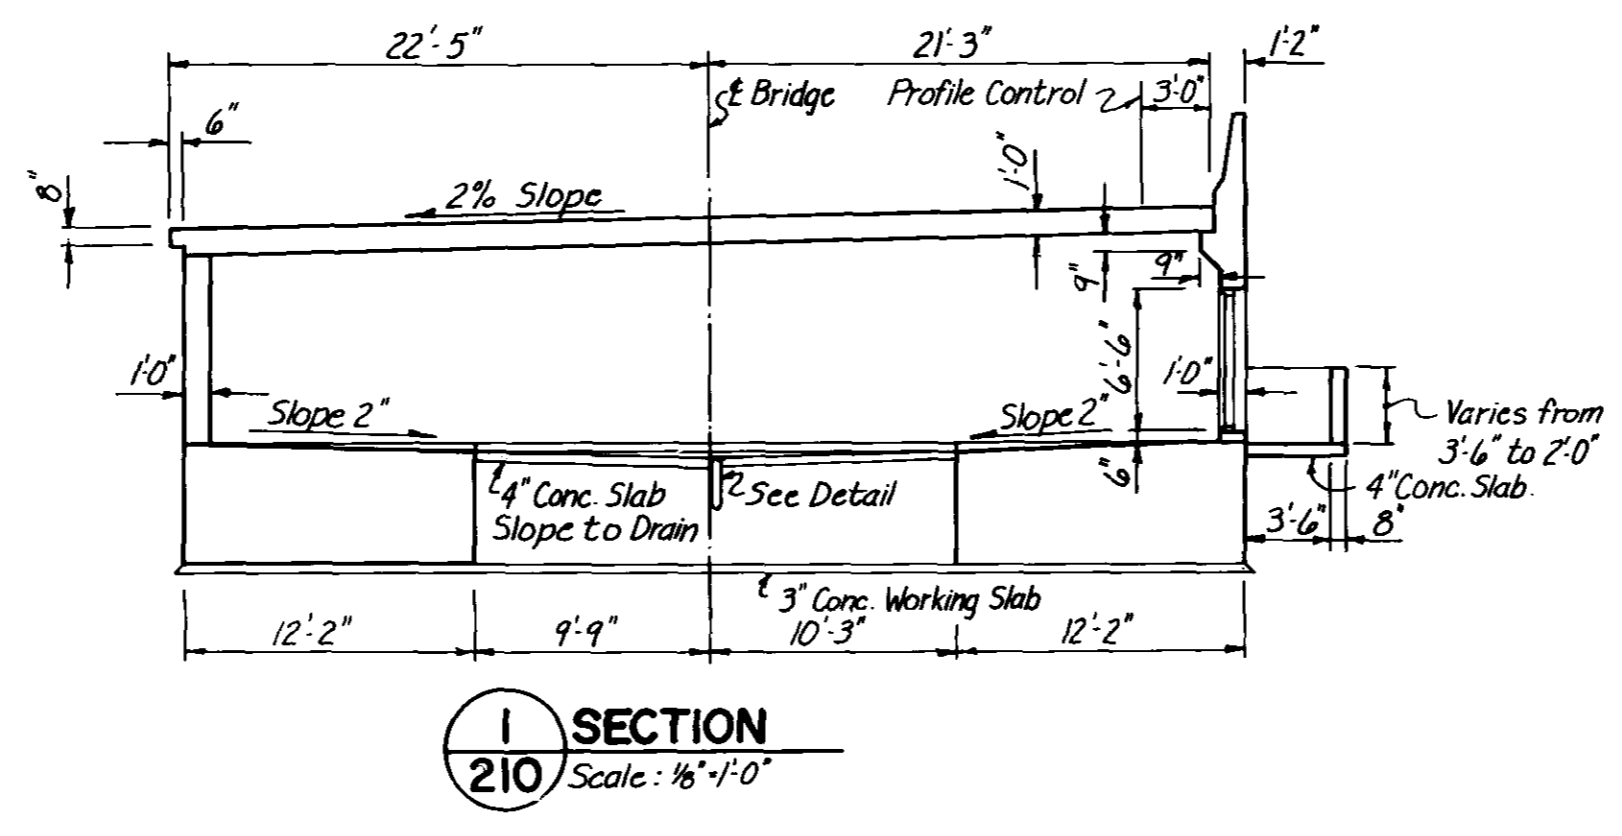
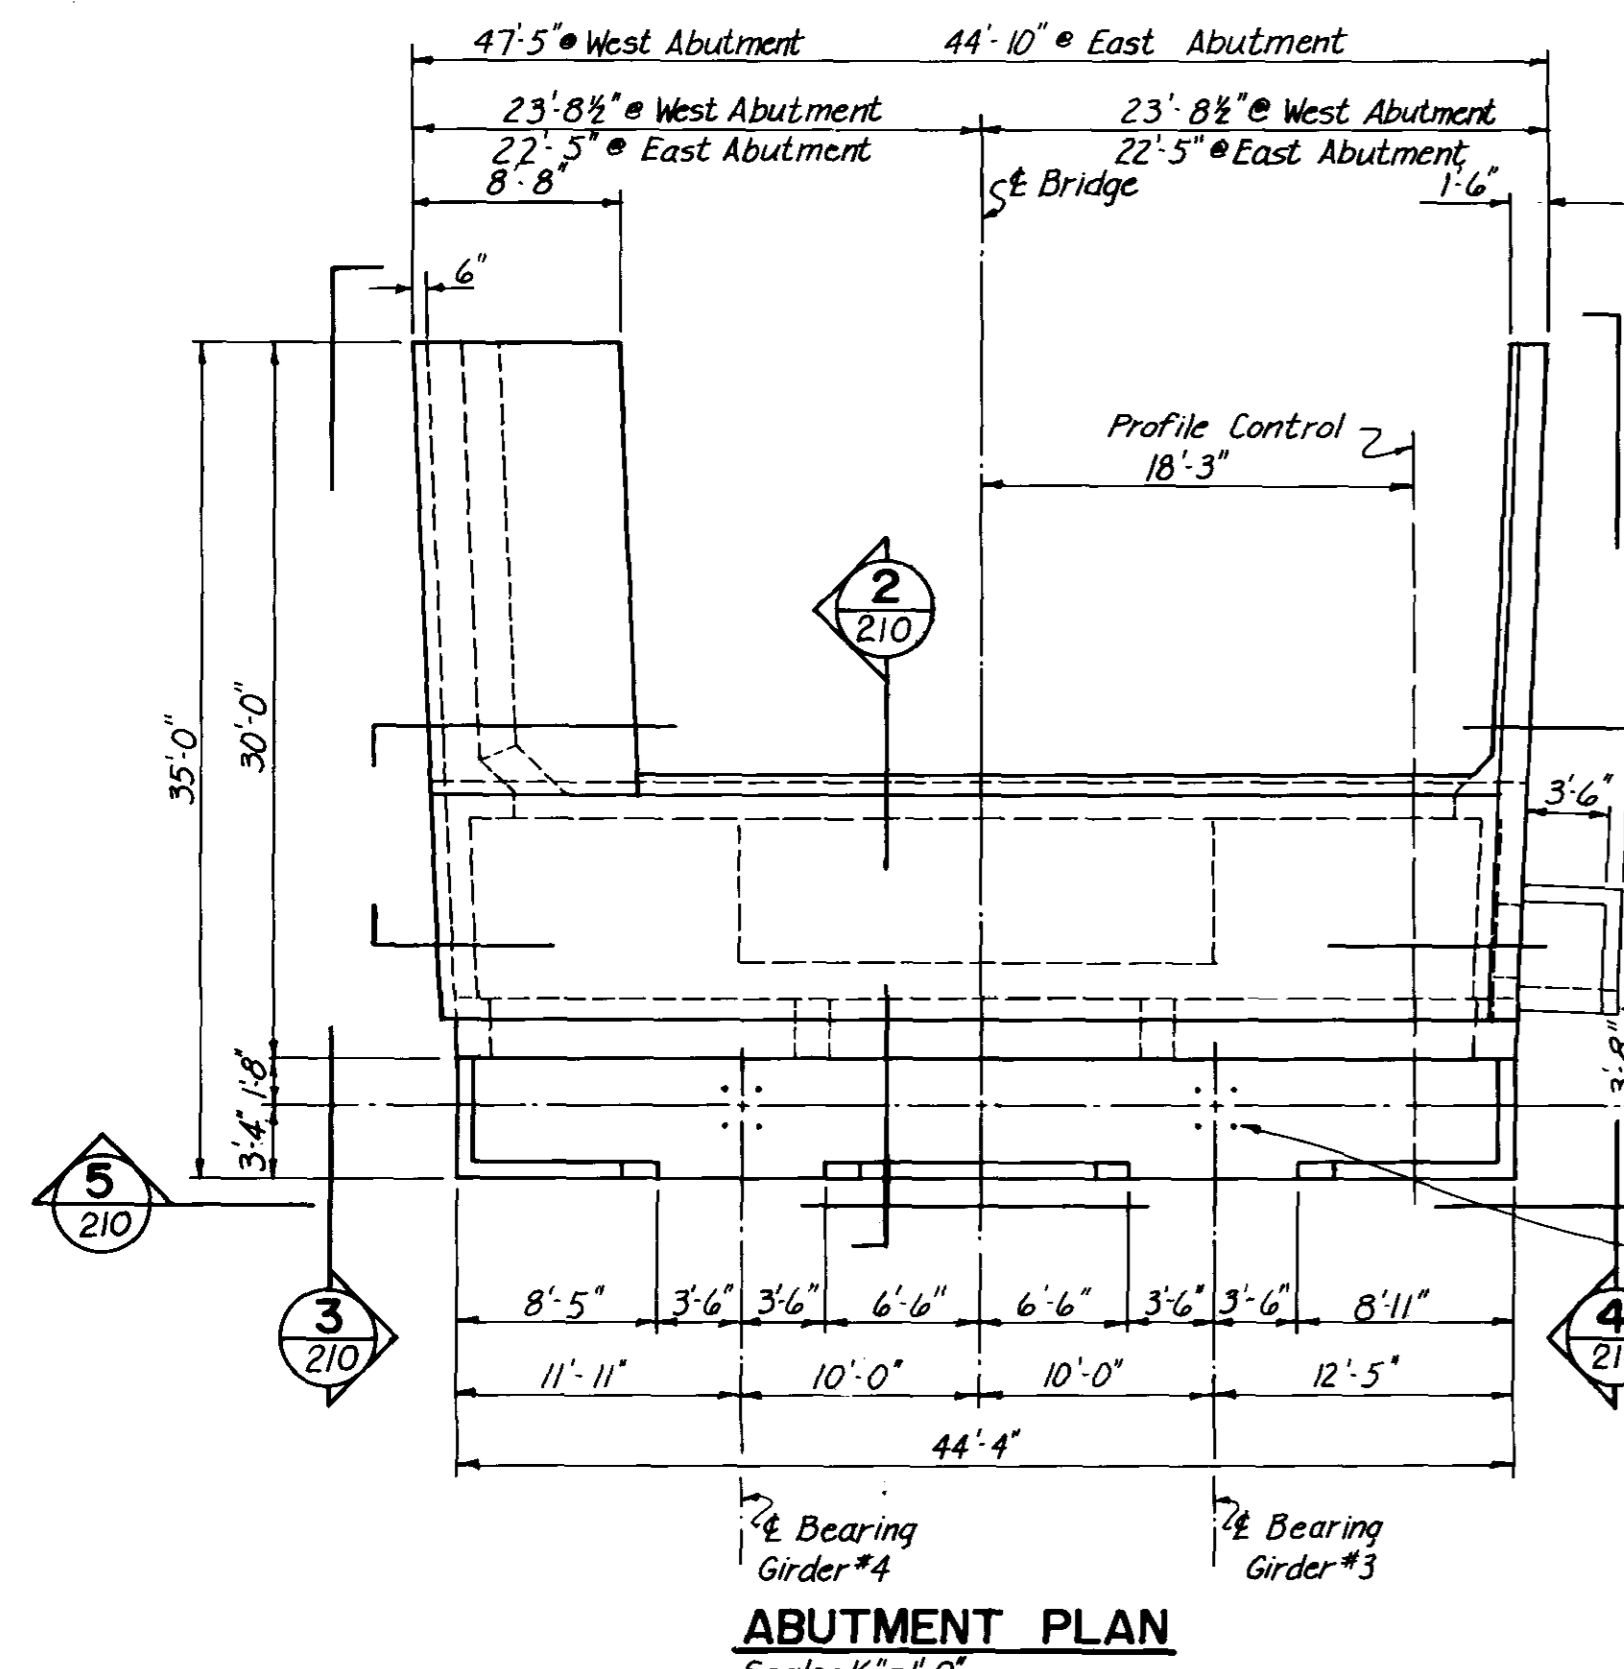


Note: Stepped section extended to backwall (West Abutment only)

- Notes:
- All piles shall be H-bearing piles HP12x74". All piles shall be placed vertical except where shown thus $\frac{1}{1.5}$, indicating direction and amount of batter.
 - Door assembly shall consist of the following items:
 - 3'0" x 6'6" x 1 3/4" Galvanized Steel Door.
 - 5 3/4" Galvanized Press-Steel Frame.
 - Weather stripping.
 - Aluminum Threshold.
 - 1 1/2" Pair FBB 191C15 Butts 4 1/2 x 4 (NRP)
 - Only 51PD x PLY/MET x 32D x TMS x 005 Lockset
 - Extreme accuracy and care shall be executed to maintain bearing seat levels at elevations shown. At bearing plate locations, surfaces shall be ground absolutely smooth and flat.
 - Elevations shown are taken at top of concrete.
 - See Drawing no. 204, Note 2.
 - Geodetic Bench Mark brass pin located on the top of the South wingwall, West Abutment.

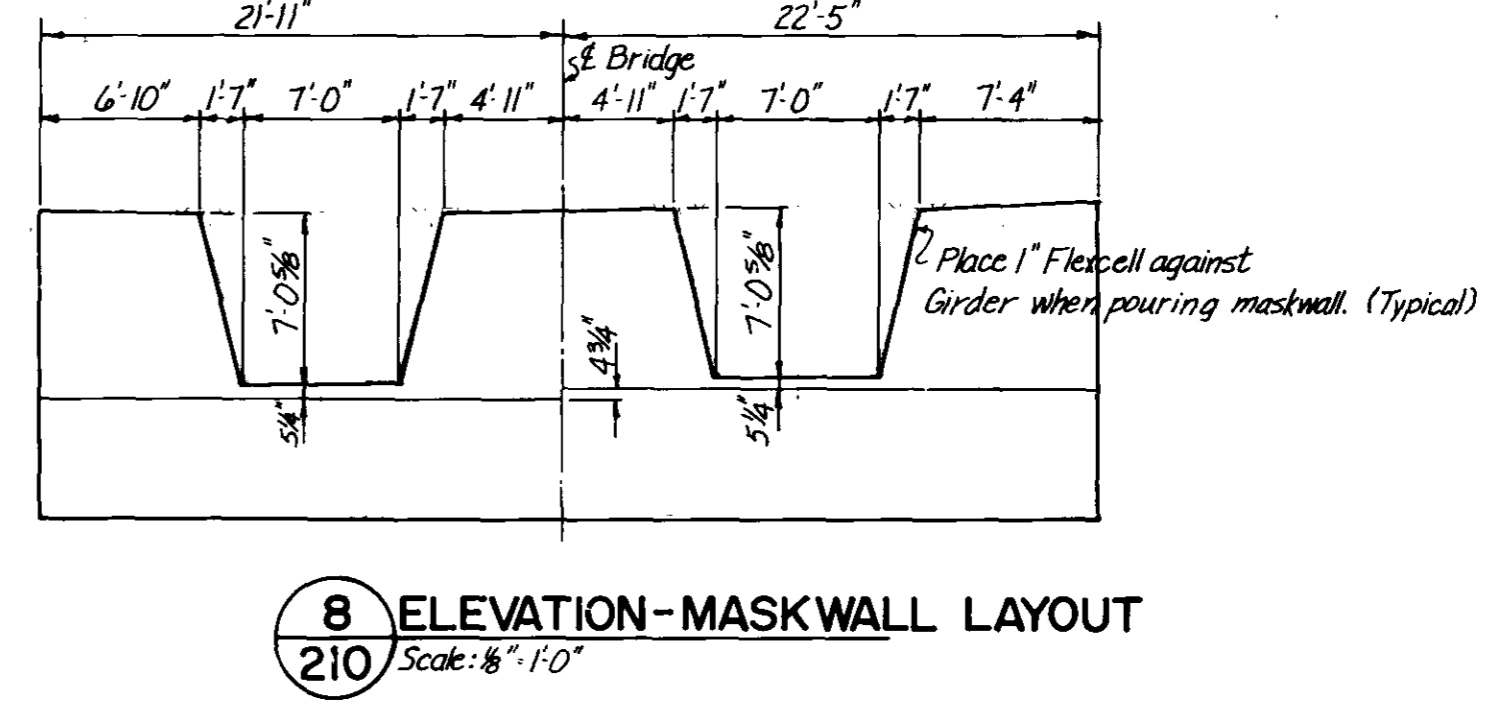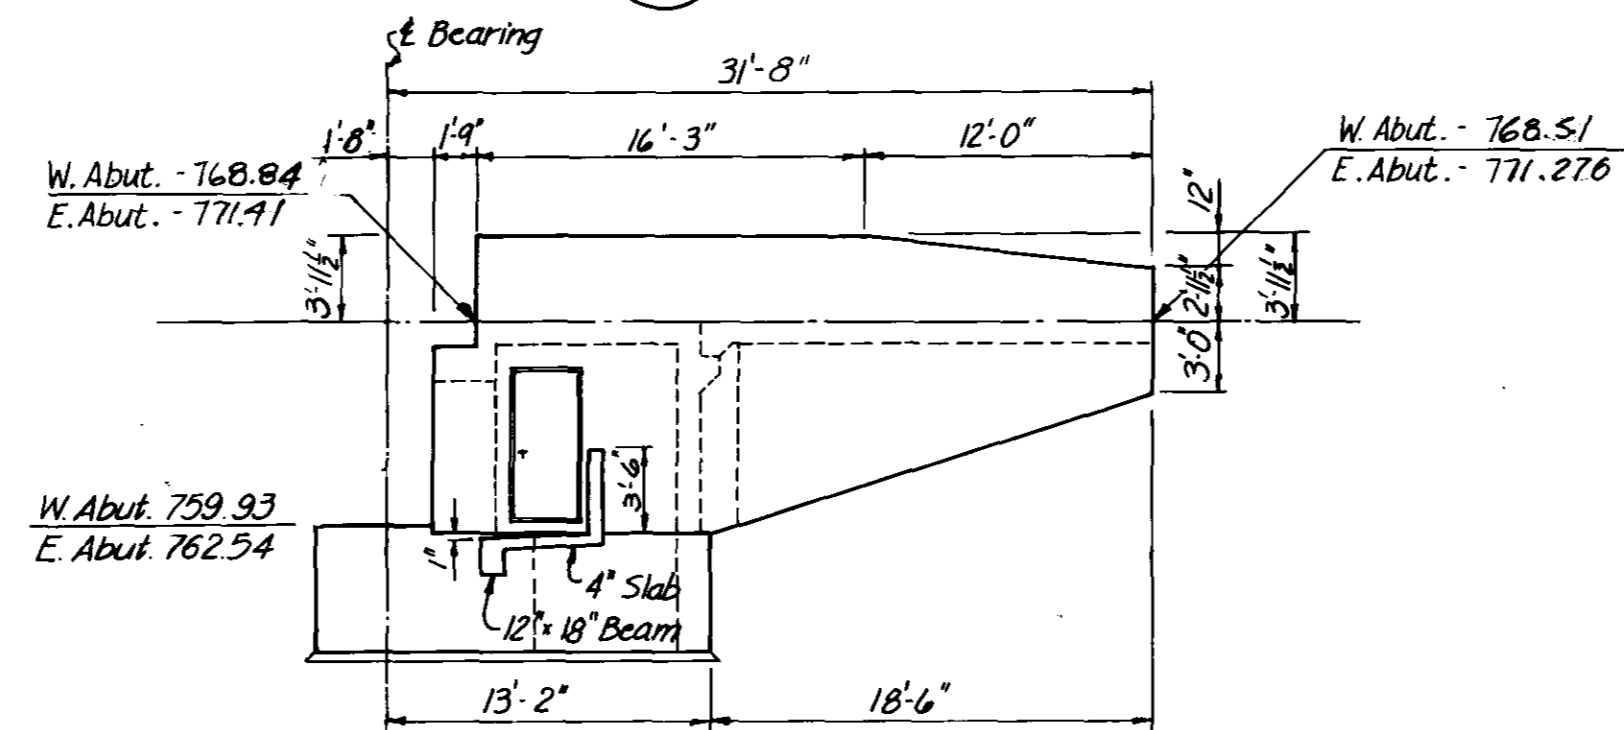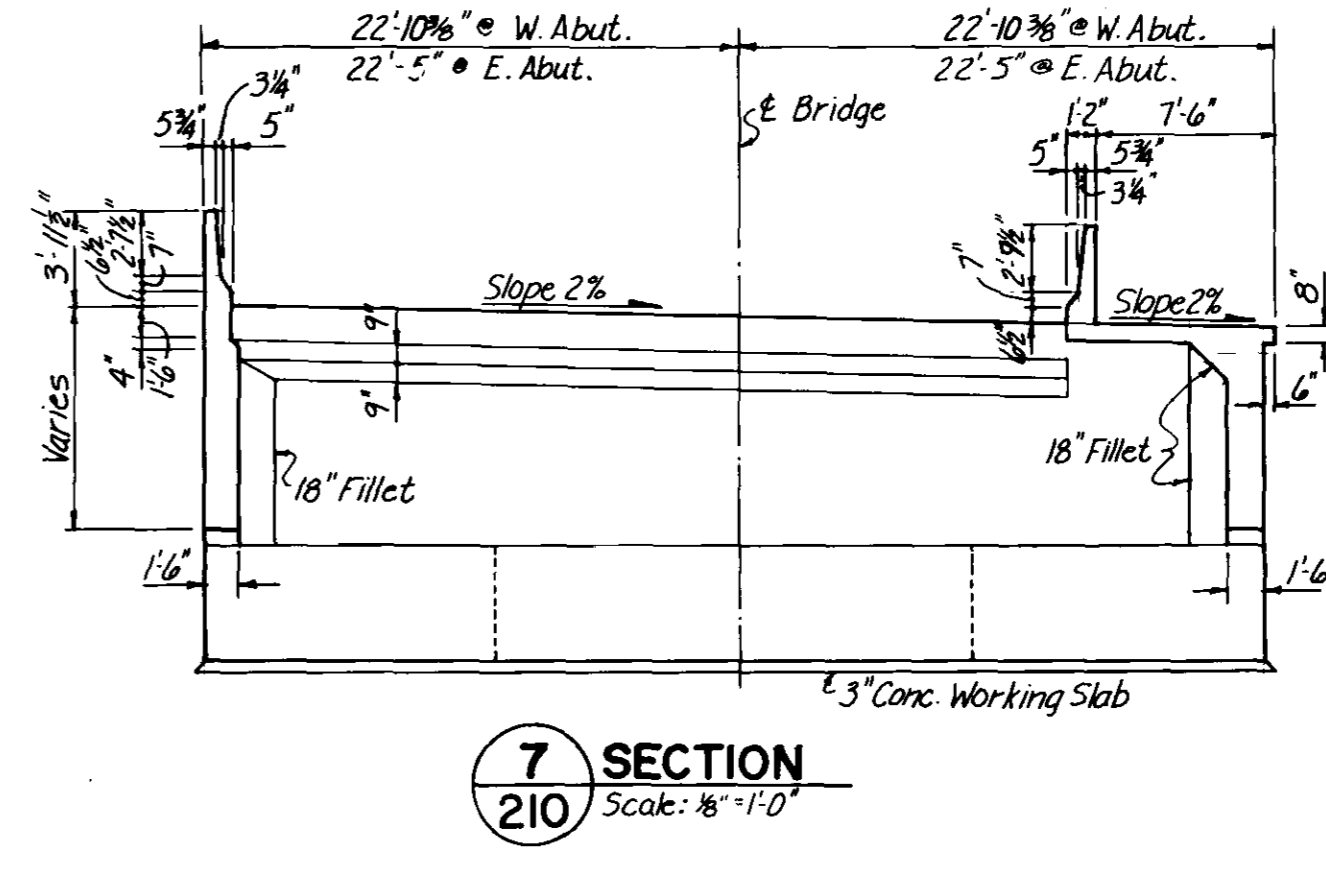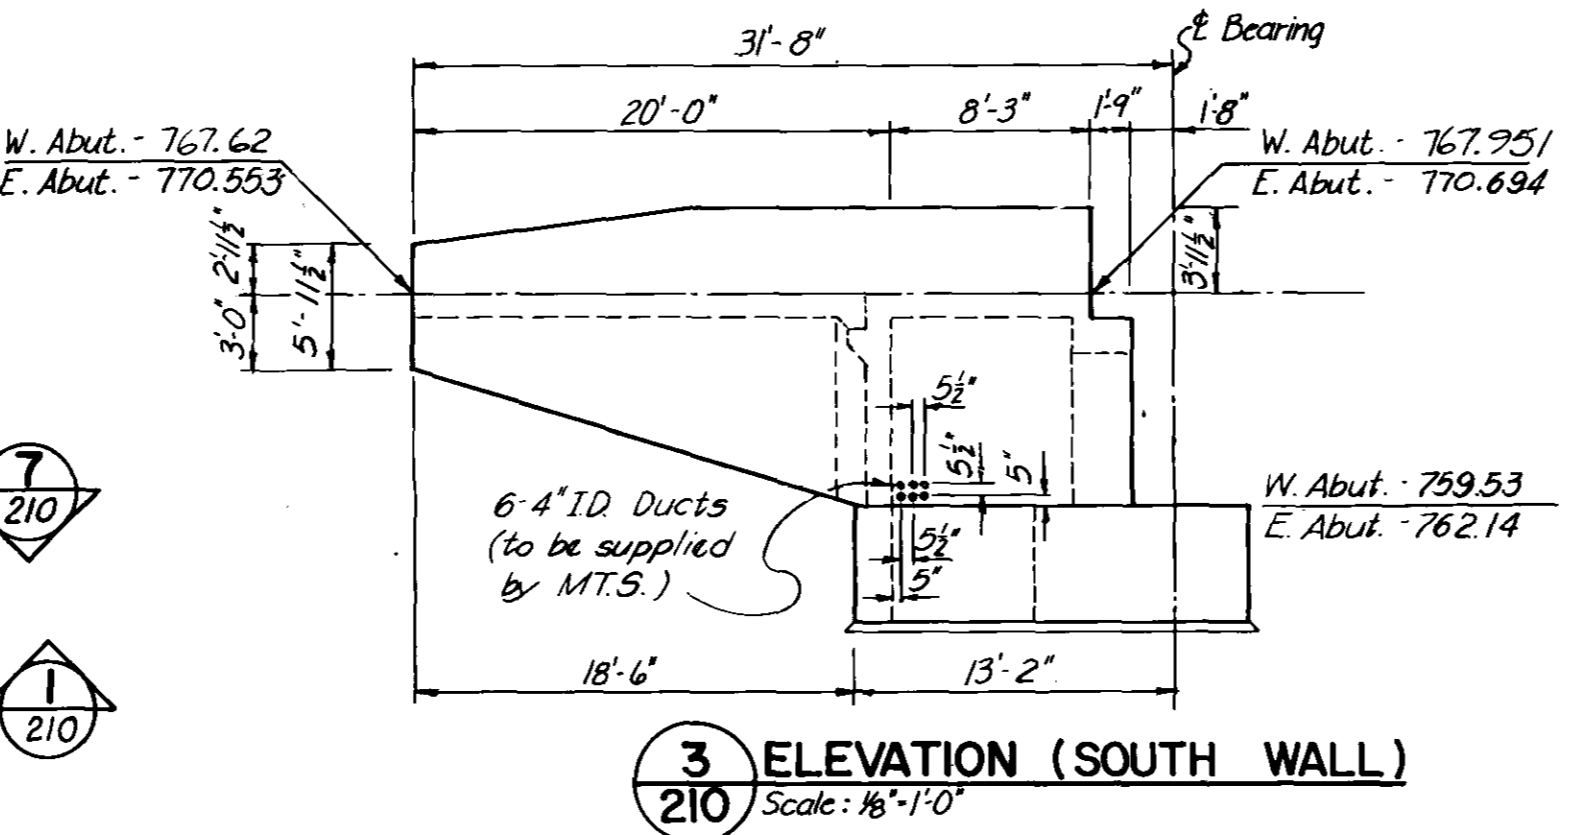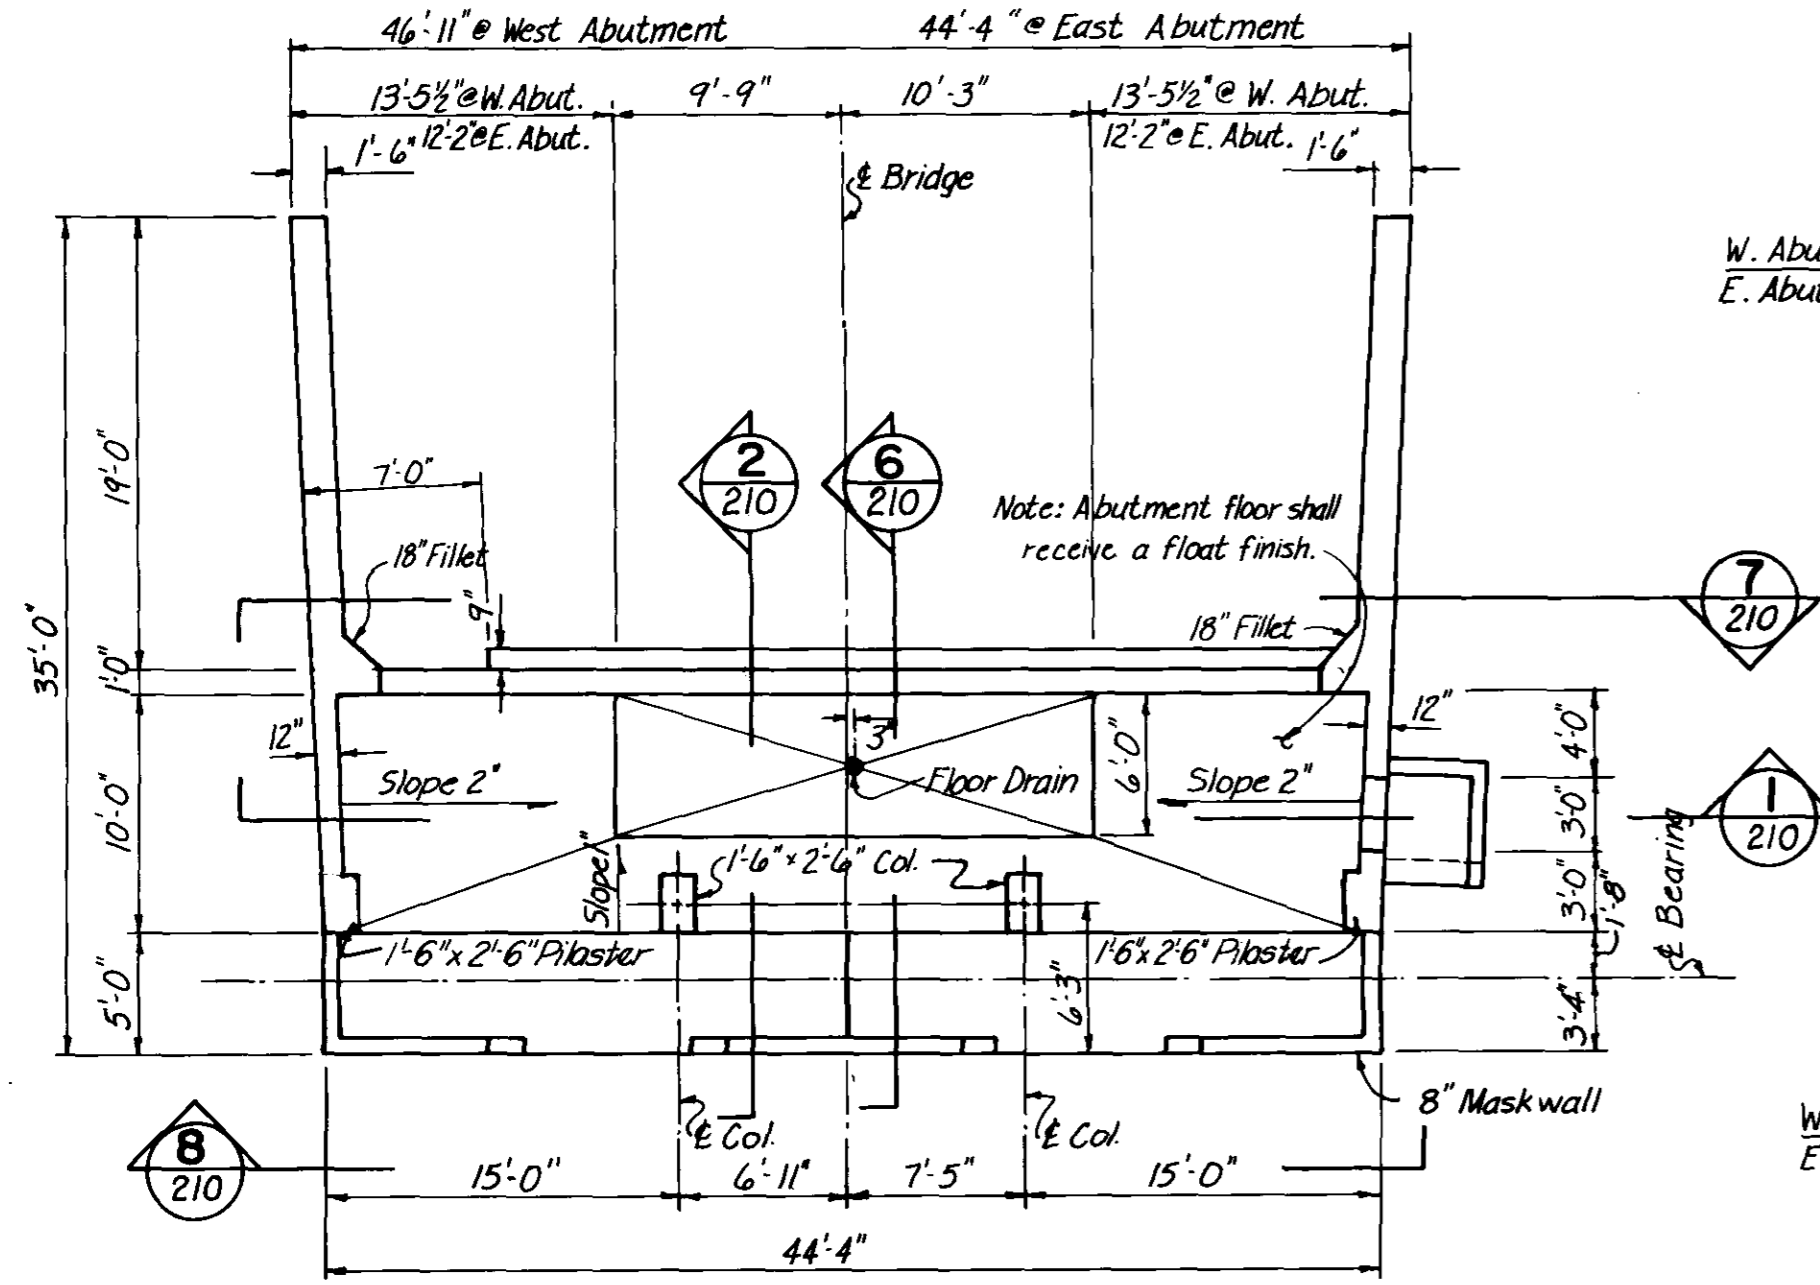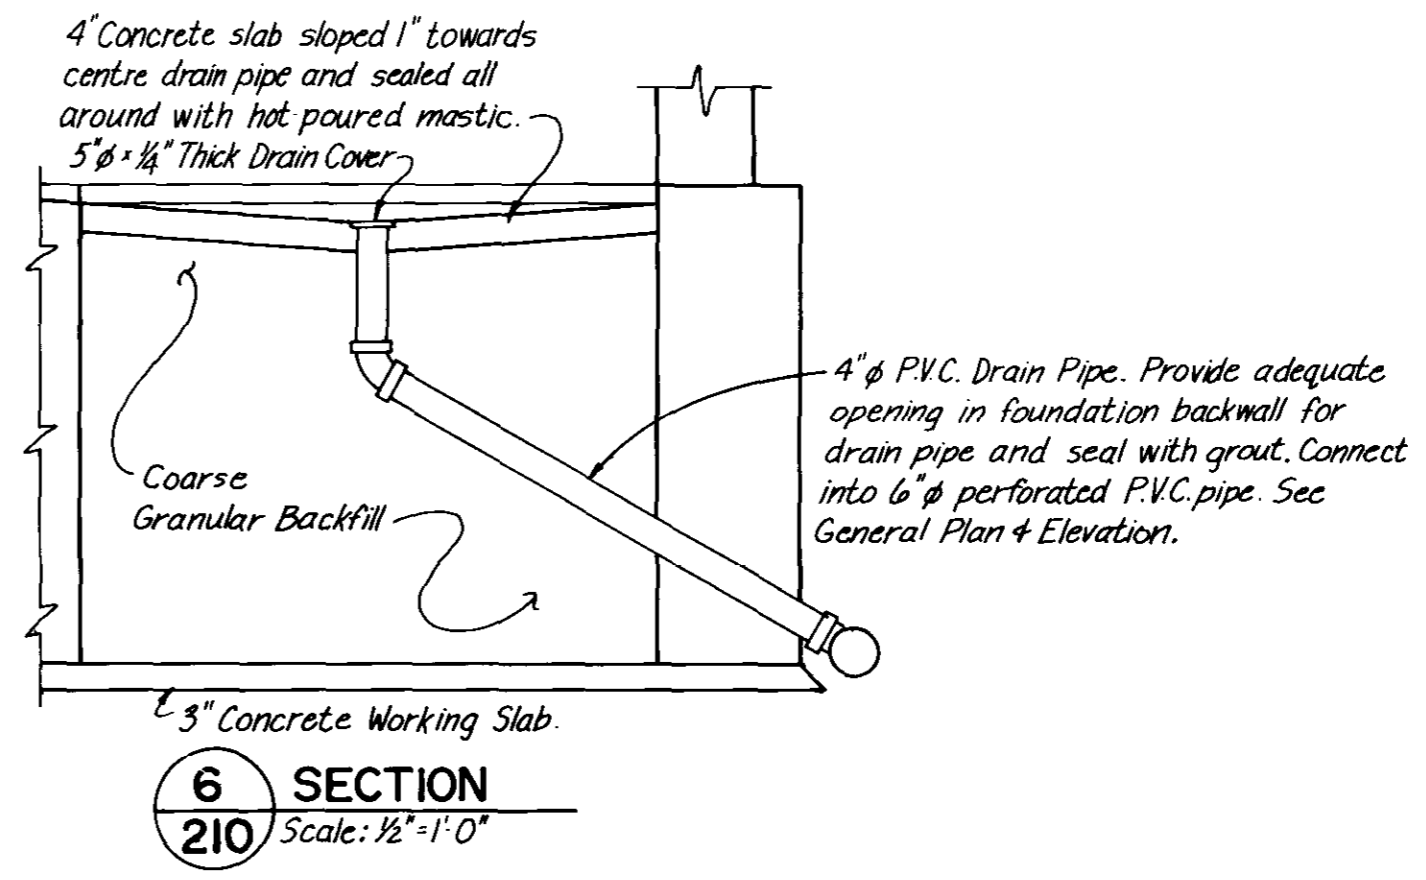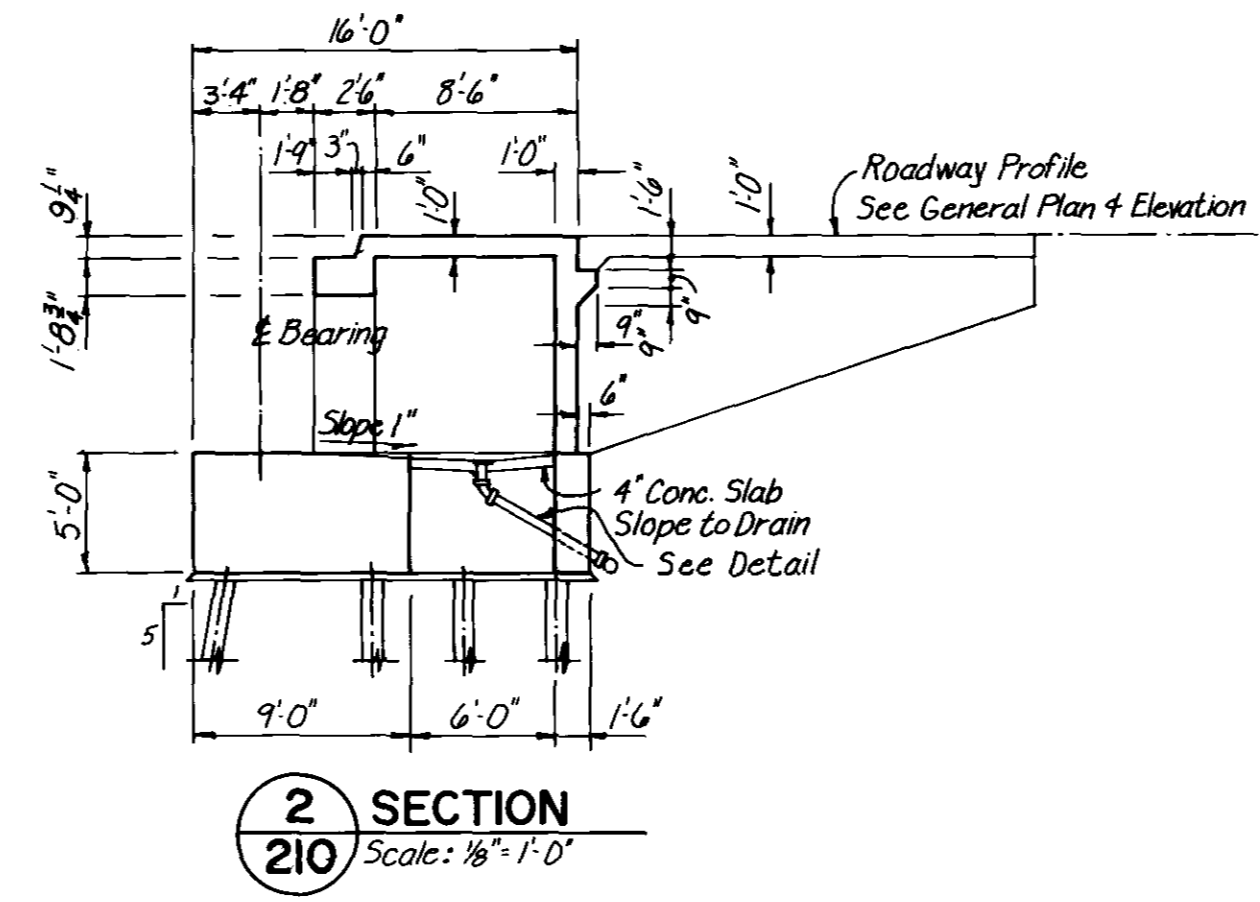

AS - BUILT		
DATE	FB NO.	PAGE
Nov. 14/79		

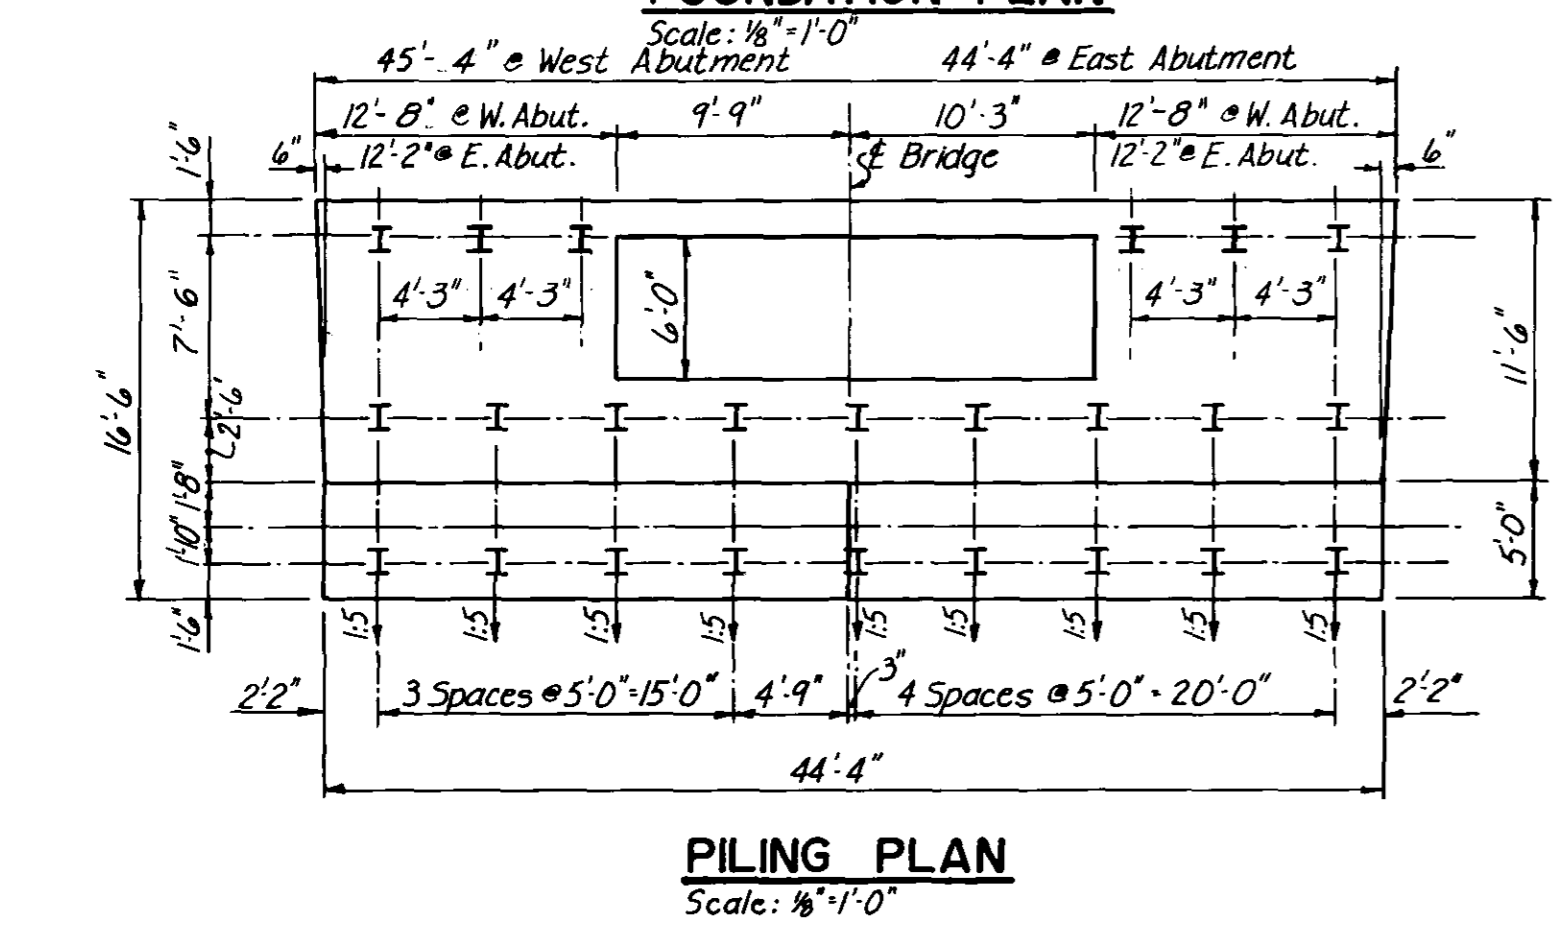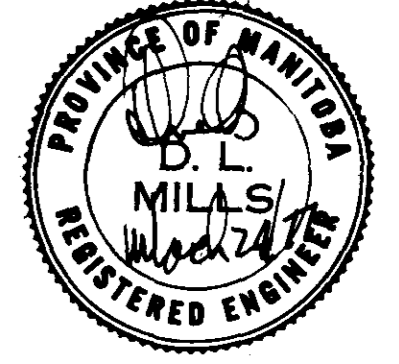

Adjusted Final elevations, as indicated	June 20/78	STK
ISSUED FOR TENDER	4.4.77	
REVISIONS	DATE	BY



THE CITY OF WINNIPEG
WORKS & OPERATIONS DEPARTMENT
STREETS & TRANSPORTATION DIVISION

W.L. WARDROP & ASSOCIATES LTD.
ENGINEERING CONSULTANTS
WINNIPEG - THUNDER BAY - REGINA - BARRIE - EDMONTON

APPROVED BY: *[Signature]* DATE 25 June 77

DRAWN BY: J.K. DATE FEB. 77
PRELIM. CHK. DATE JAN. 77


ROUTE 165

ABUTMENT DETAILS
SOUTH BRIDGE


SCALE:

APPROVED BY: *[Signature]* DATE 26/3/77
MANAGER OF STREETS AND TRAFFIC


DRAWING NO. B-5092-210

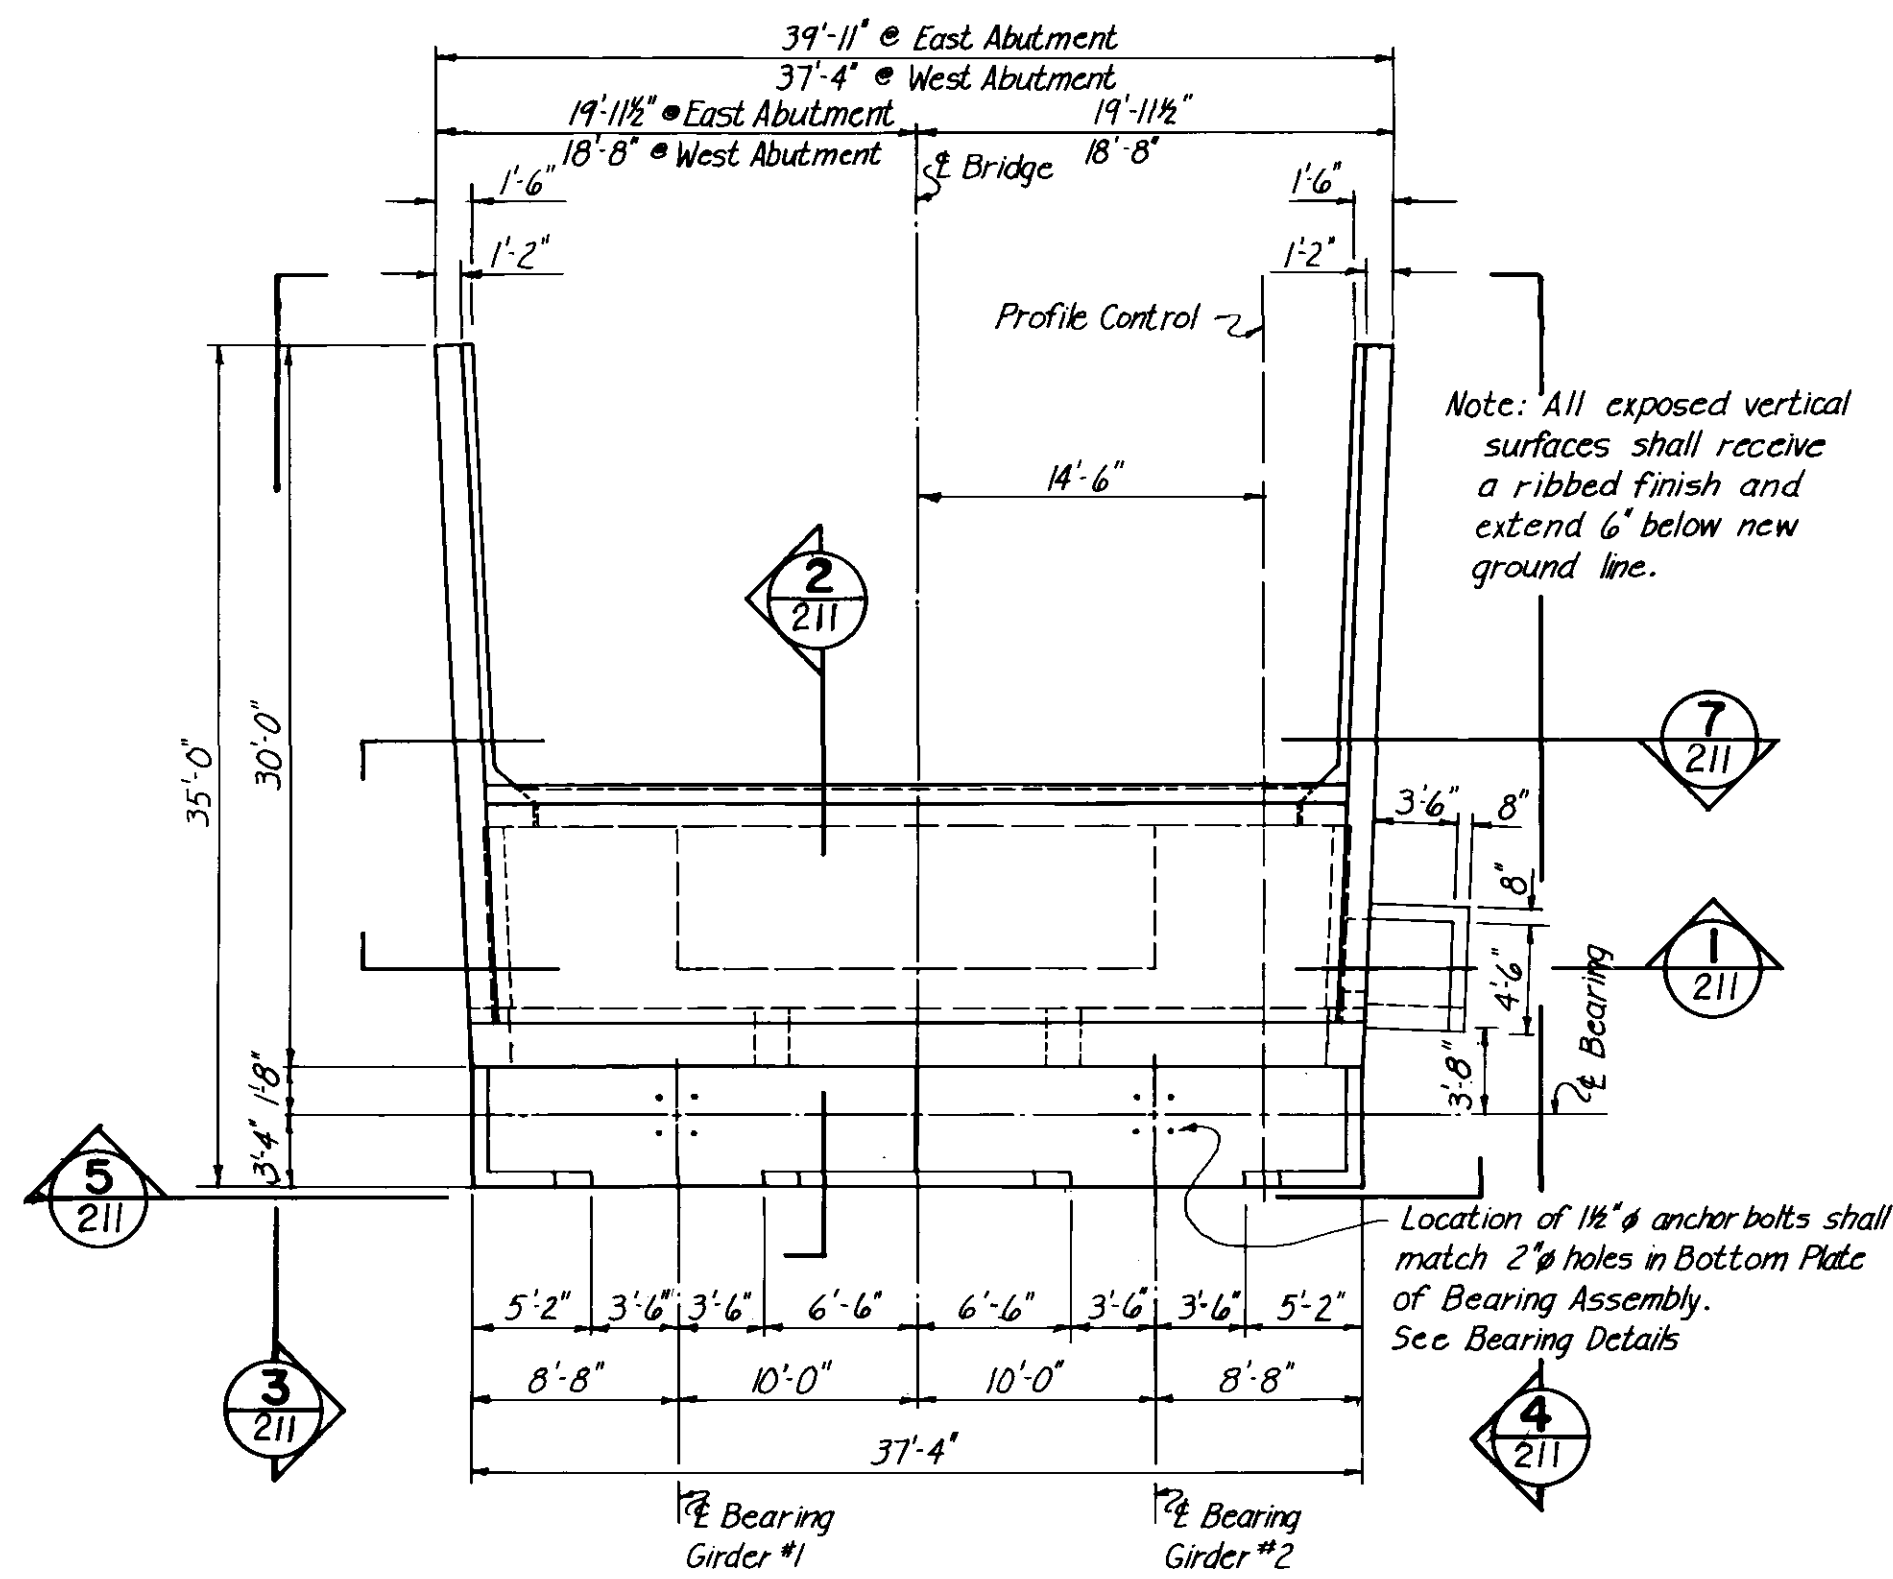


ABUTMENT PLAN
Scale: 1/8" = 1'-0"

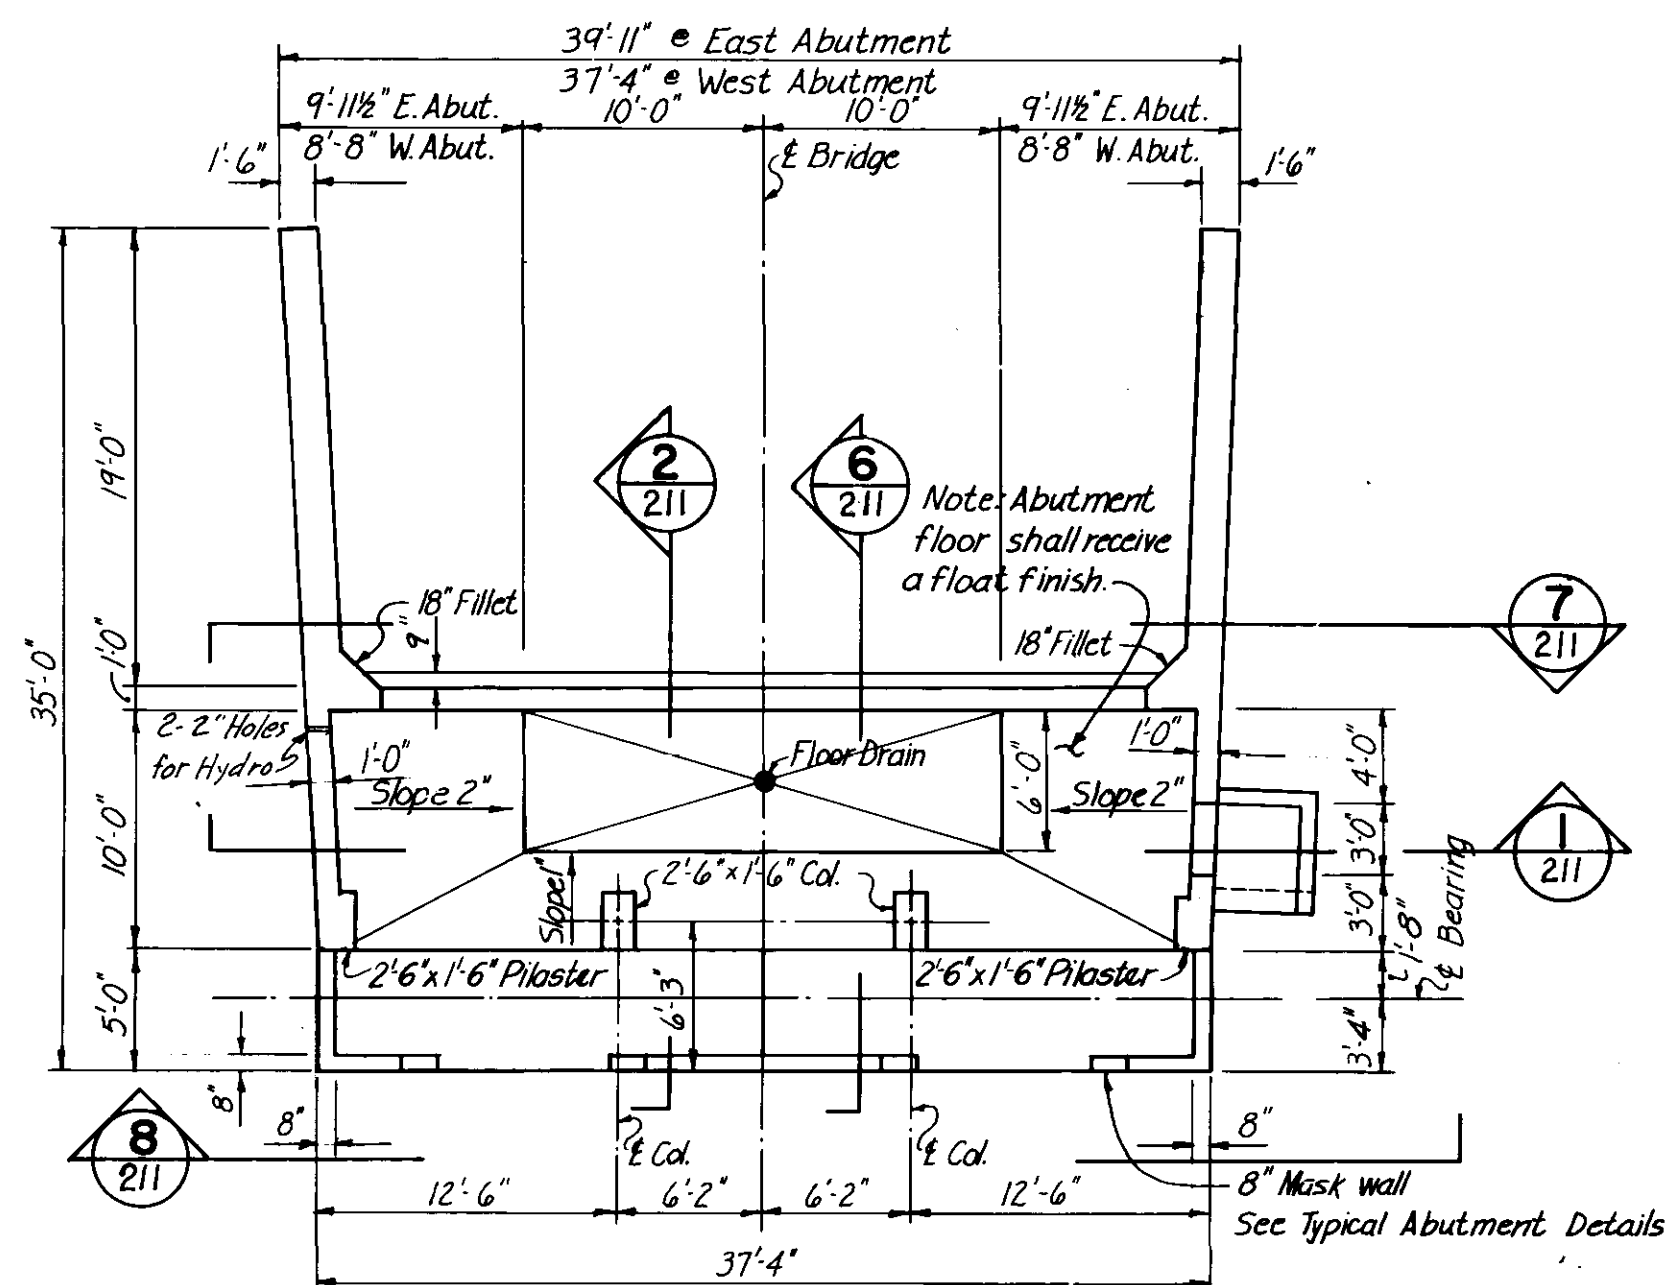


FOUNDATION PLAN
Scale: 1/8" = 1'-0"

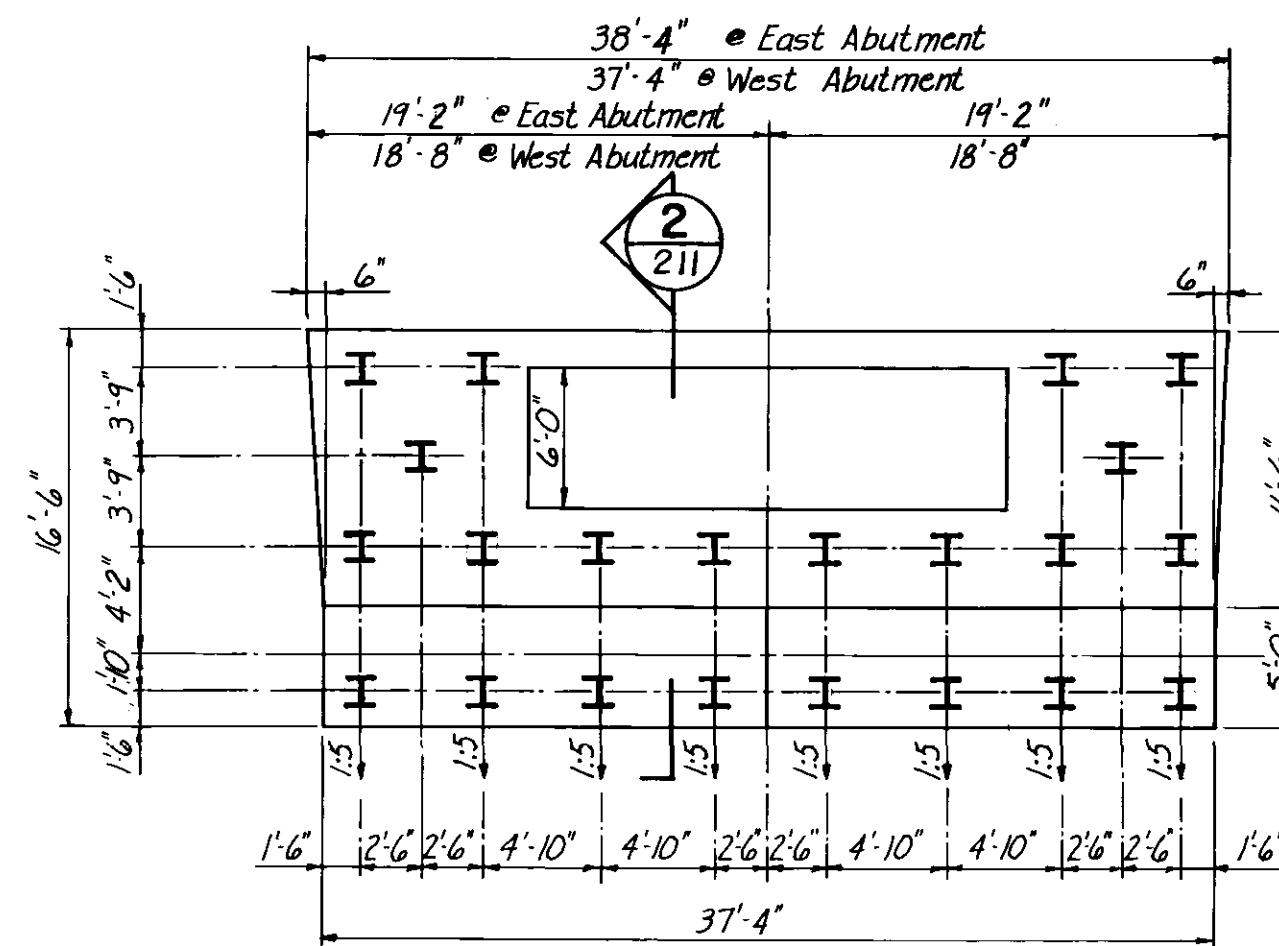


PILING PLAN
Scale: 1/8" = 1'-0"

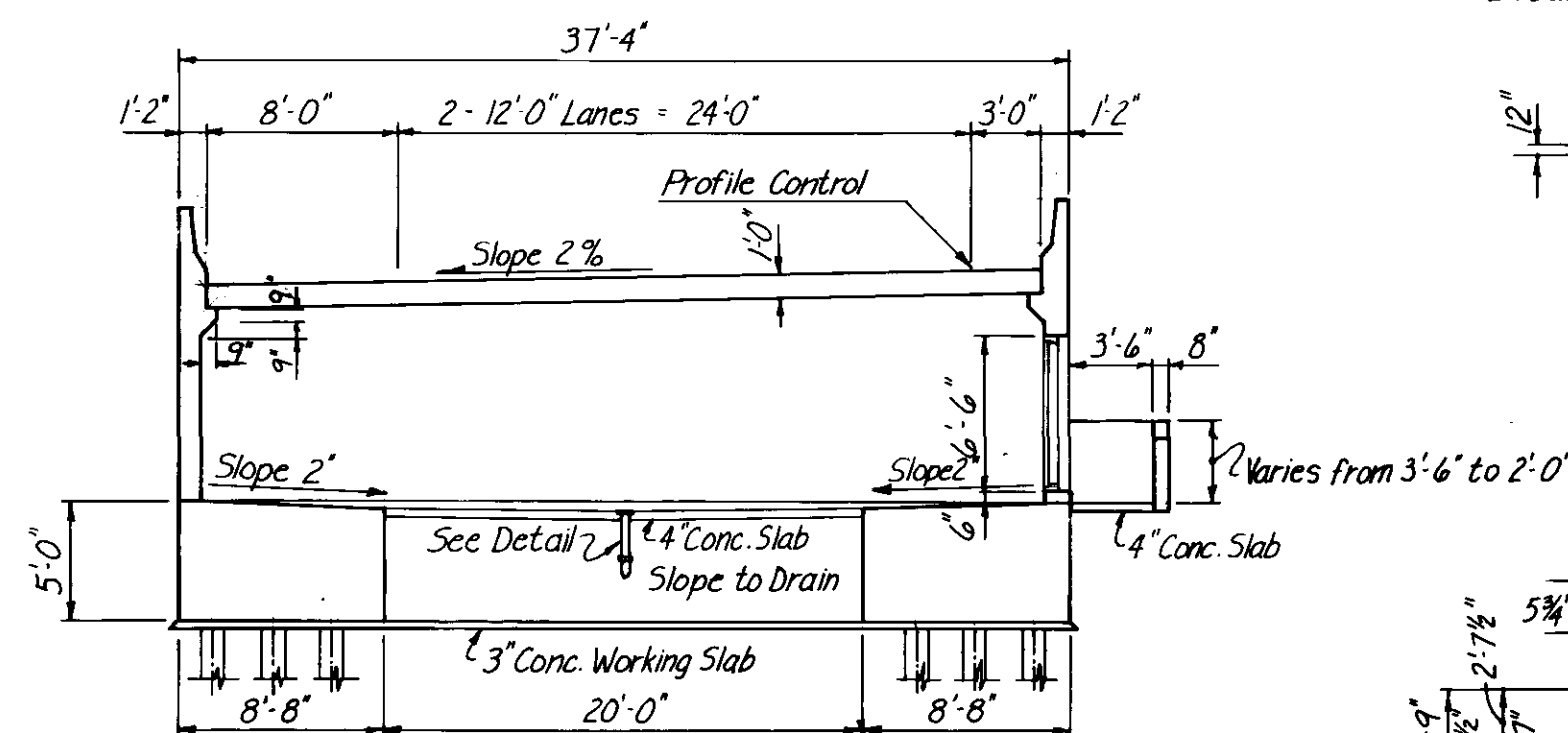

SECTION 1
Scale: 1/8" = 1'-0"

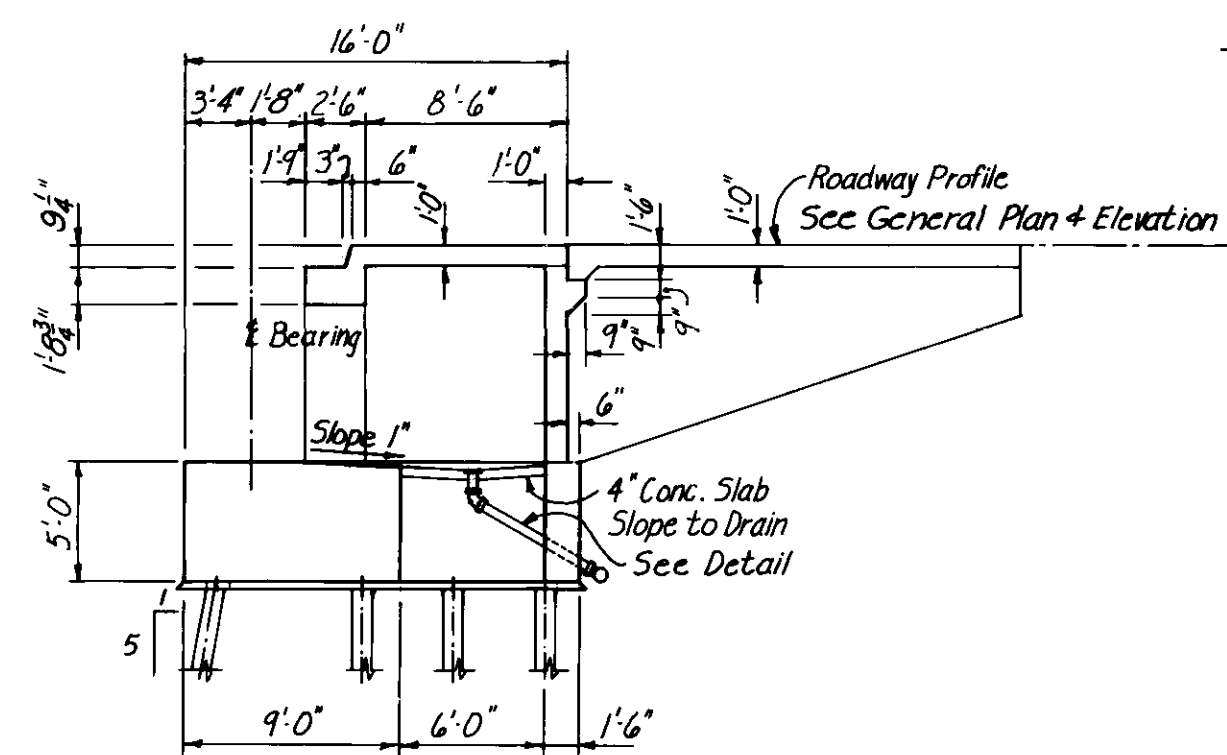


SECTION 2
Scale: 1/8" = 1'-0"

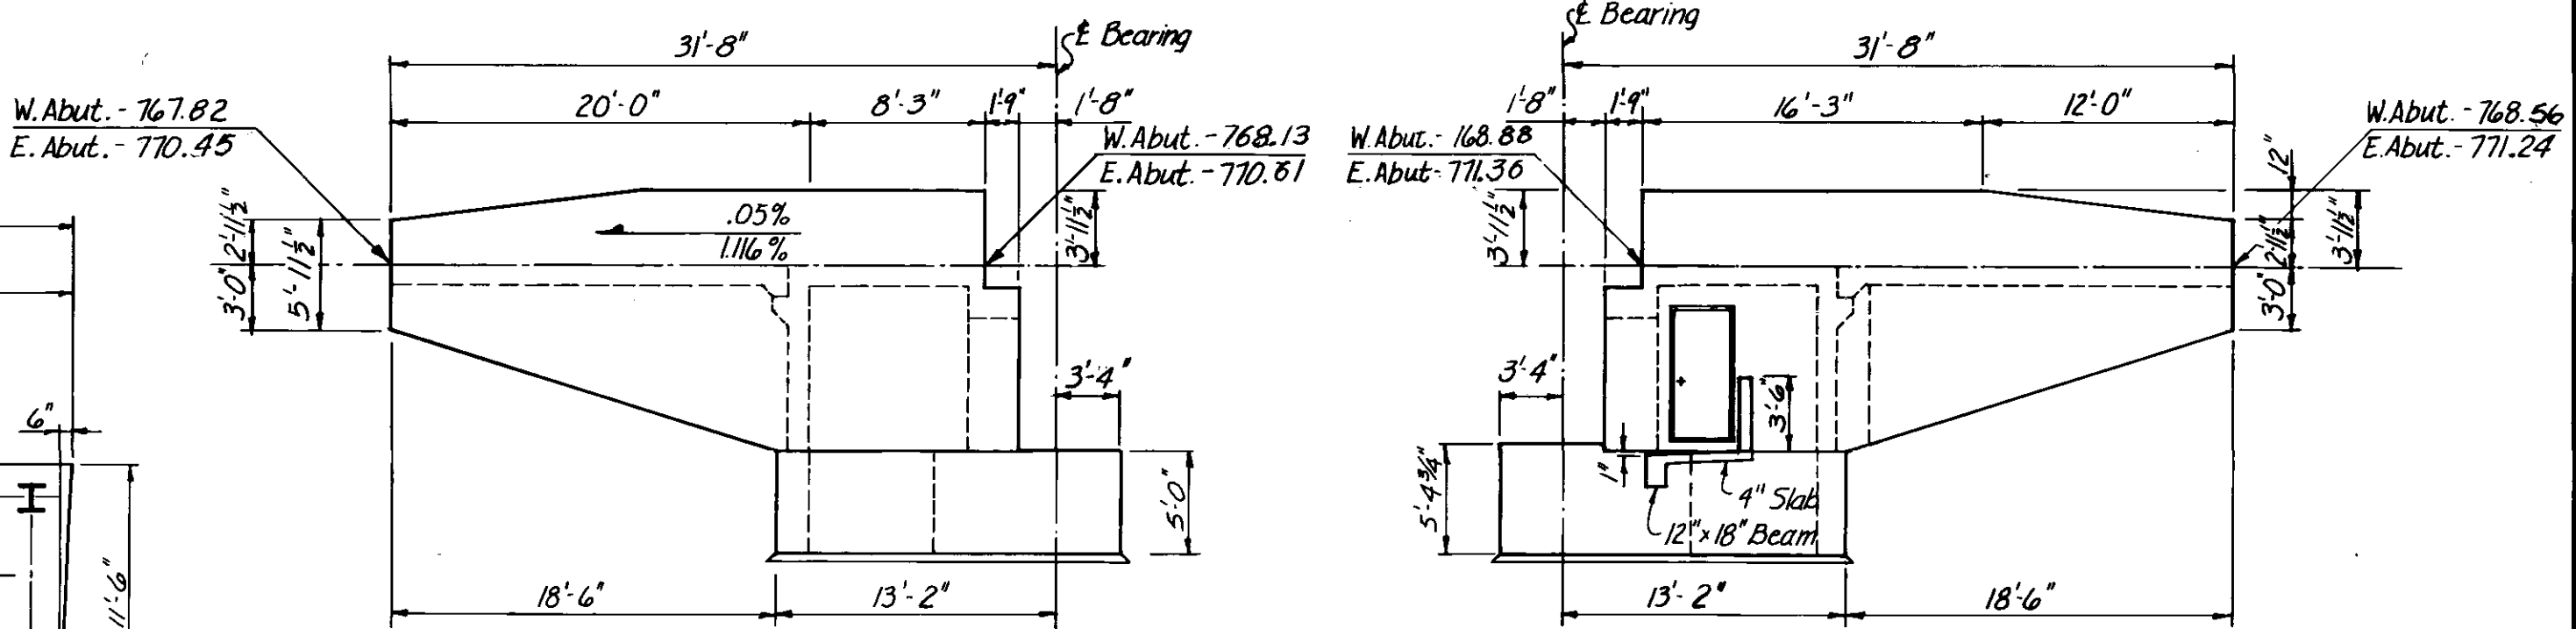


3 ELEVATION (NORTH WALL)
Scale: 1/8" = 1'-0"


4 ELEVATION (SOUTH WALL)
Scale: 1/8" = 1'-0"

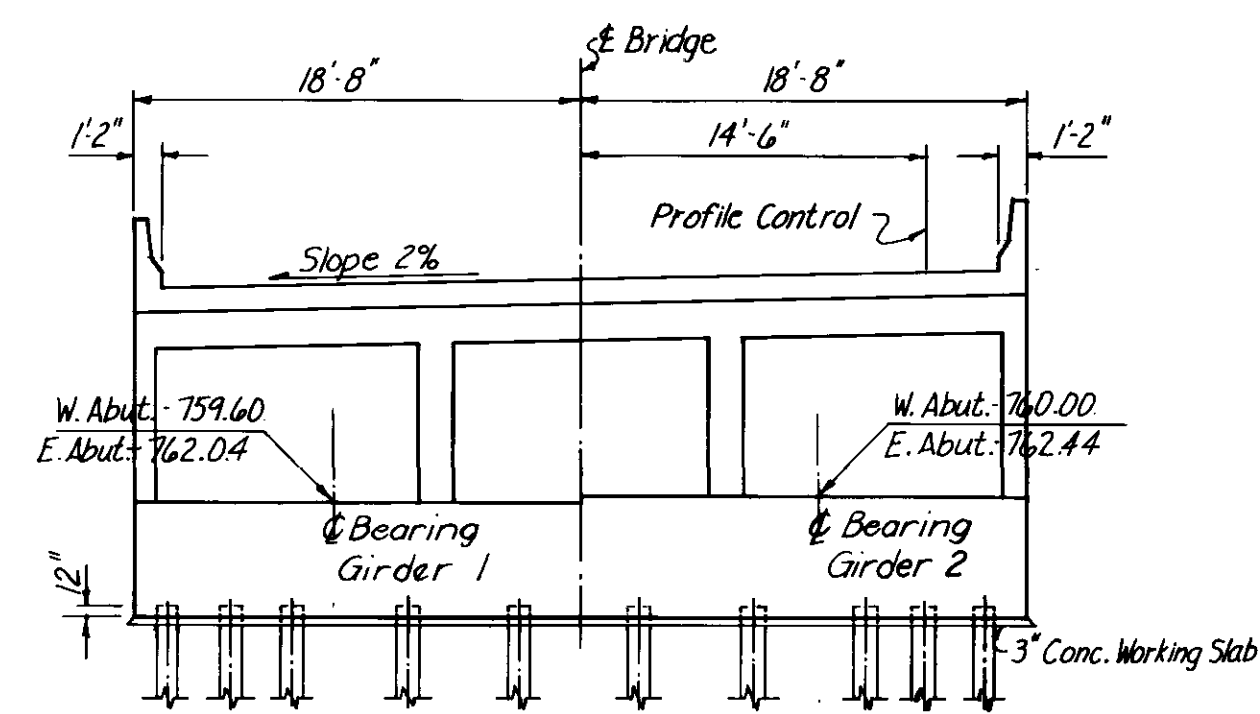


SECTION 5
Scale: 1/8" = 1'-0"

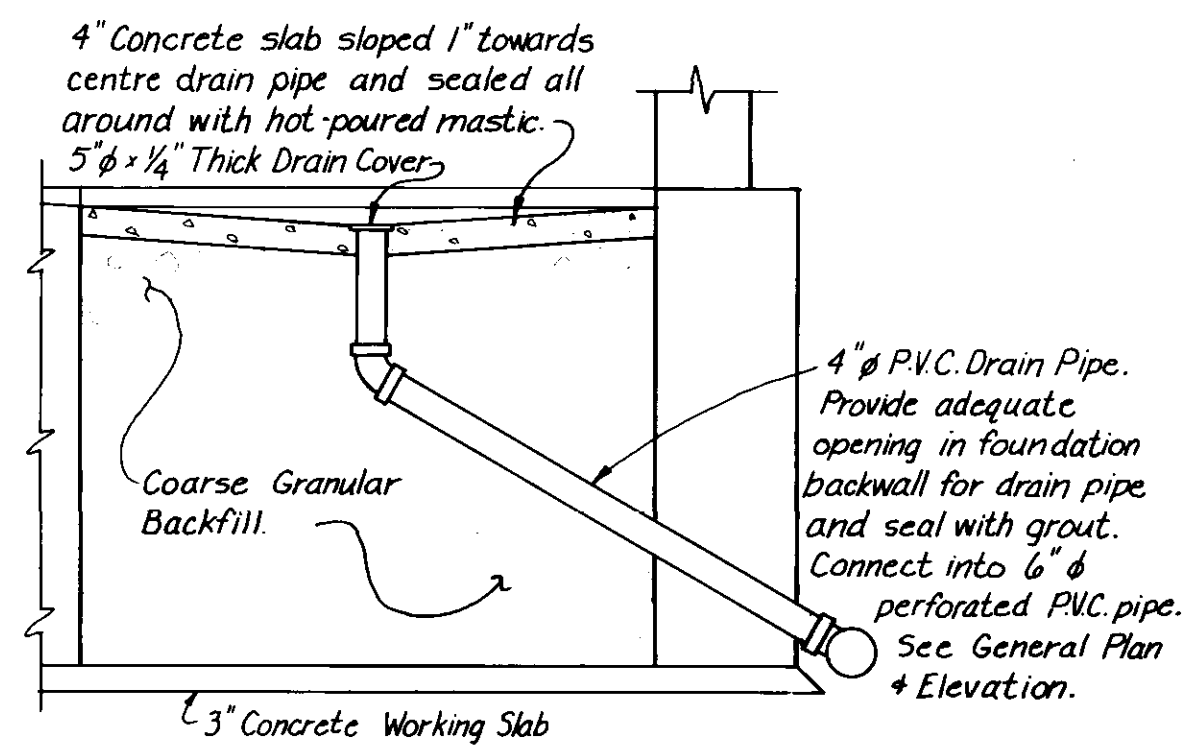

SECTION 6
Scale: 1/8" = 1'-0"

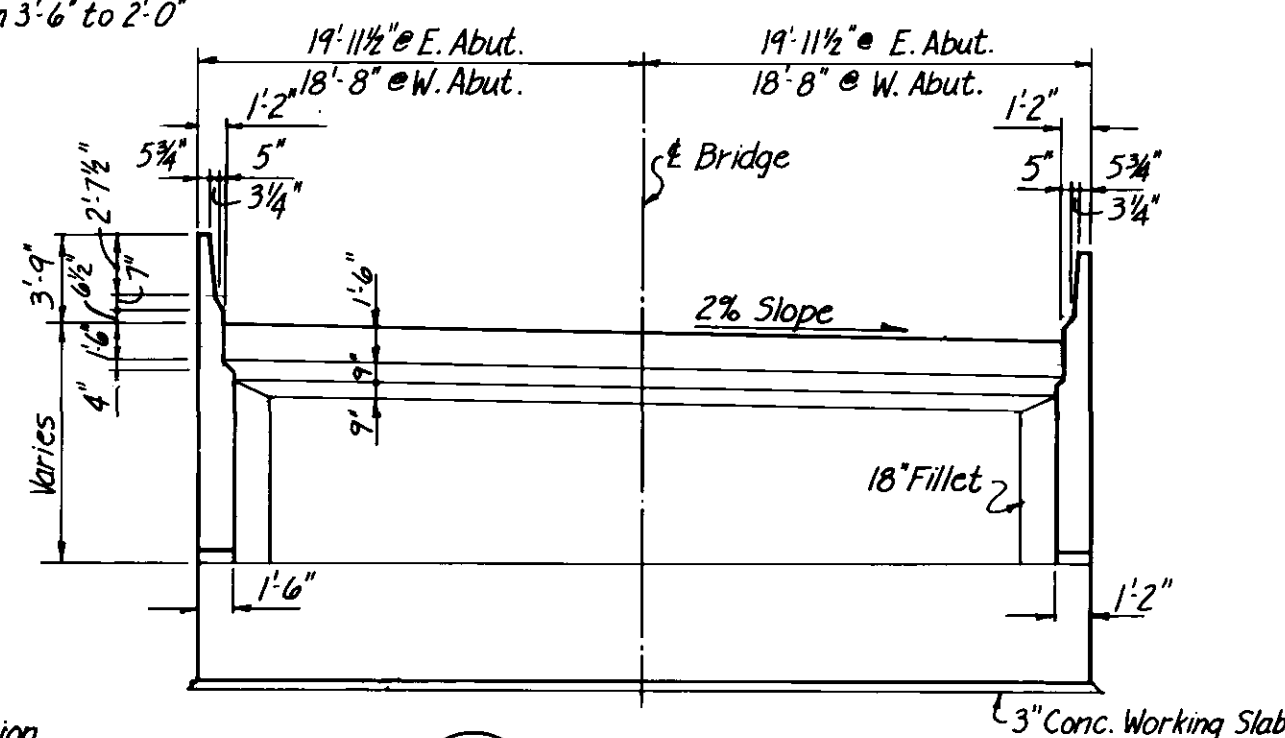

SECTION 7
Scale: 1/8" = 1'-0"

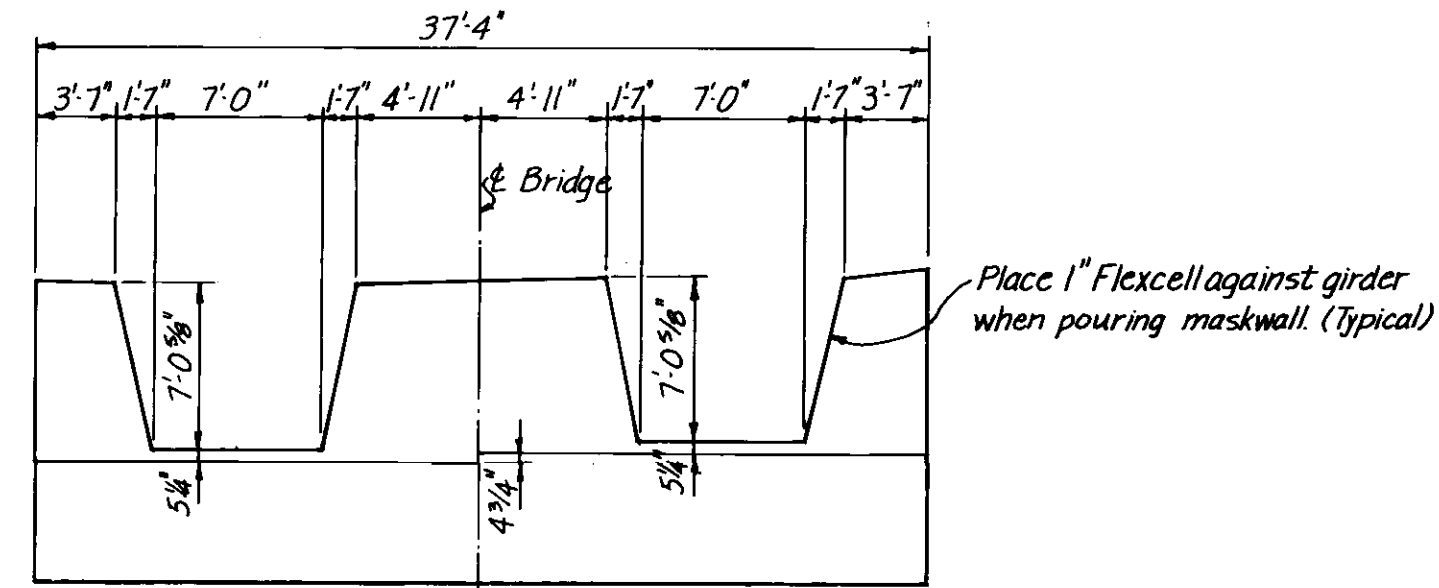

8 ELEVATION-MASKWALL LAYOUT
Scale: 1/8" = 1'-0"

- Notes:
- All piles shall be H-bearing piles HP12x74. All piles shall be placed vertical except where shown thus $\frac{1}{2} \rightarrow$, indicating direction and amount of batter.
 - Door assembly shall consist of the following items:
 - 3'-0" x 6'-6" x 1 3/4" Galvanized Steel Door.
 - 5 3/4" Galvanized Press-steel Frame.
 - Weatherstripping
 - Aluminum Threshold
 - 1 1/2" Pair FBB #1 C5 Butts 4 1/2" x 4" (NRP)
 - 1 only 51PD x PLY/MET x 32D x TMS x 005 Lockset
 - Extreme accuracy and care shall be executed to maintain bearing seat levels at elevations shown. At bearing plate locations, surfaces shall be ground absolutely smooth and flat.
 - Elevations shown are taken at top of concrete.
 - See Drawing no. 204, Note 2
 - Geodetic Bench Mark brass pin located on top of North wingwall, East Abutment.

AS - BUILT		
DATE	FB. NO.	PAGE
Nov. 11/79		



ISSUED FOR TENDER	4-4-77
REVISIONS	DATE BY



THE CITY OF WINNIPEG
WORKS & OPERATIONS DEPARTMENT
STREETS & TRANSPORTATION DIVISION

W. L. WARDROP & ASSOCIATES LTD.
ENGINEERING CONSULTANTS
WINNIPEG - THUNDER BAY - REGINA - BARRIE - EDMONTON

APPROVED BY: *[Signature]* DATE 25/11/77

DRAWN BY: J.T.K. DATE FEB. 77
PRELIM. CHK. DATE Nov. 77

DESIGN BY: B.W.R. DATE NOV. 76
CHECK BY: J.R.E. DATE JAN. 77









ROUTE 165

ABUTMENT DETAILS
NORTH BRIDGE

SCALE:

APPROVED BY: *[Signature]* DATE 25/11/77
MANAGER OF STREETS AND TRAFFIC


DRAWING NO. B-5092-211

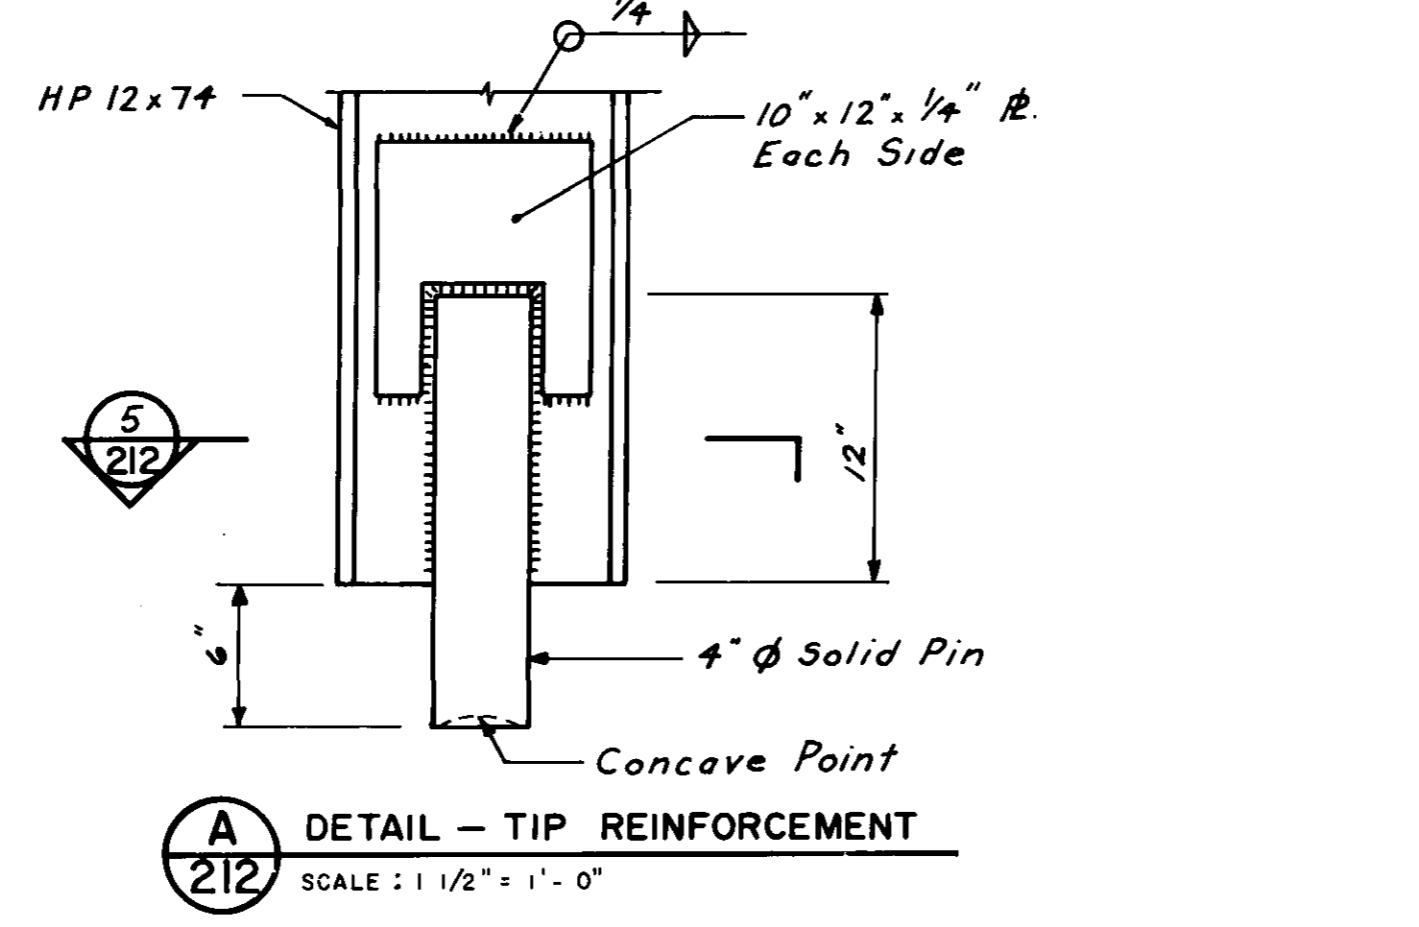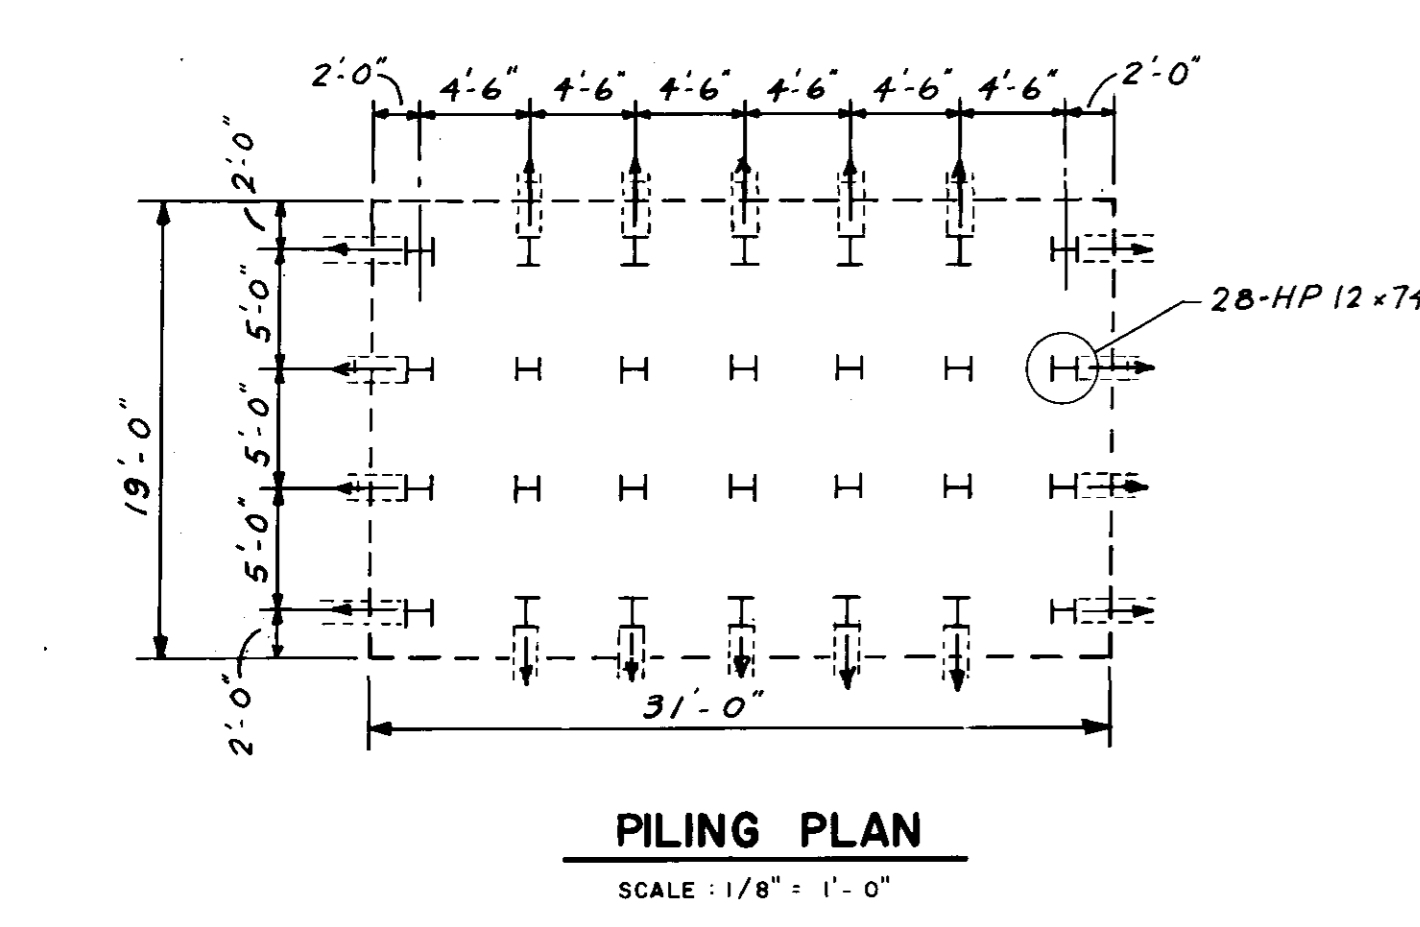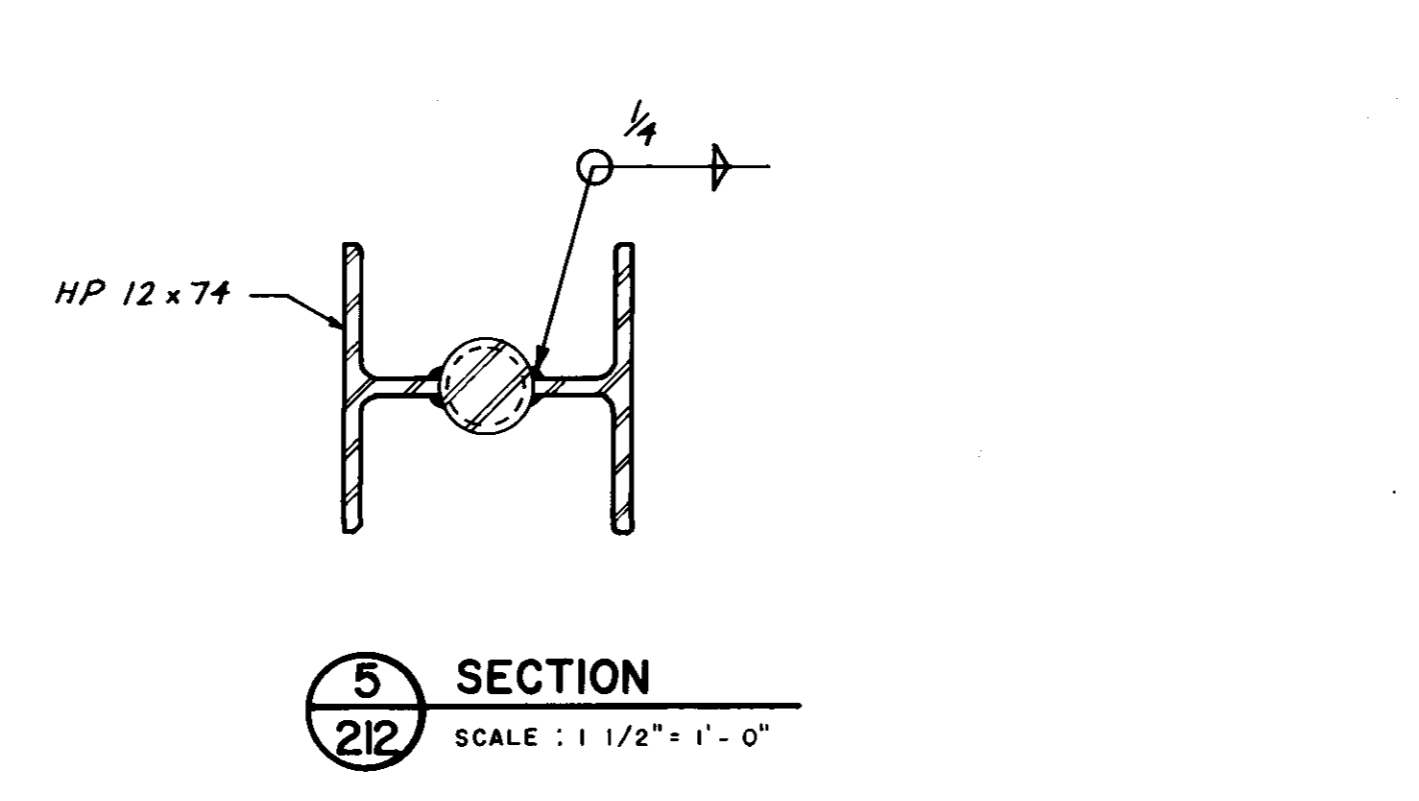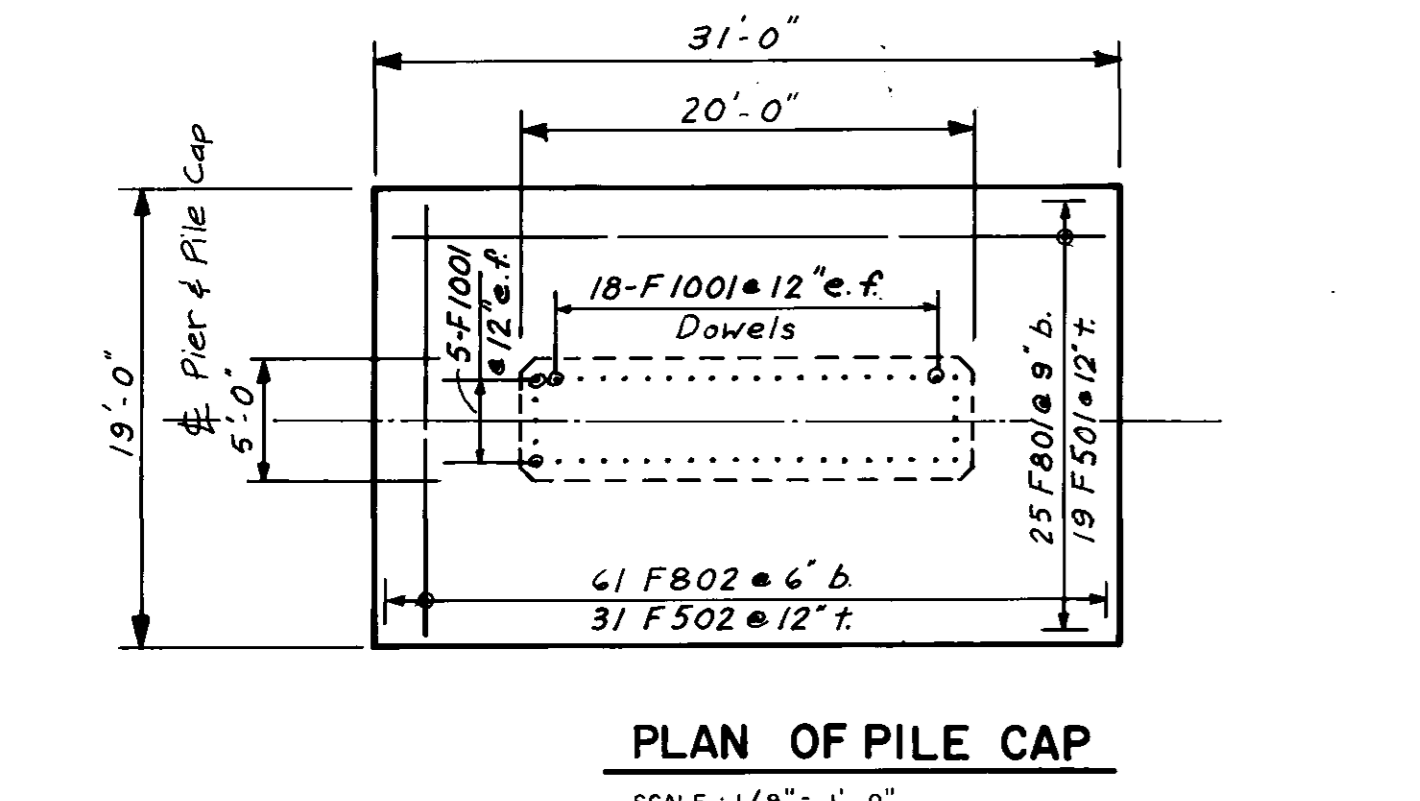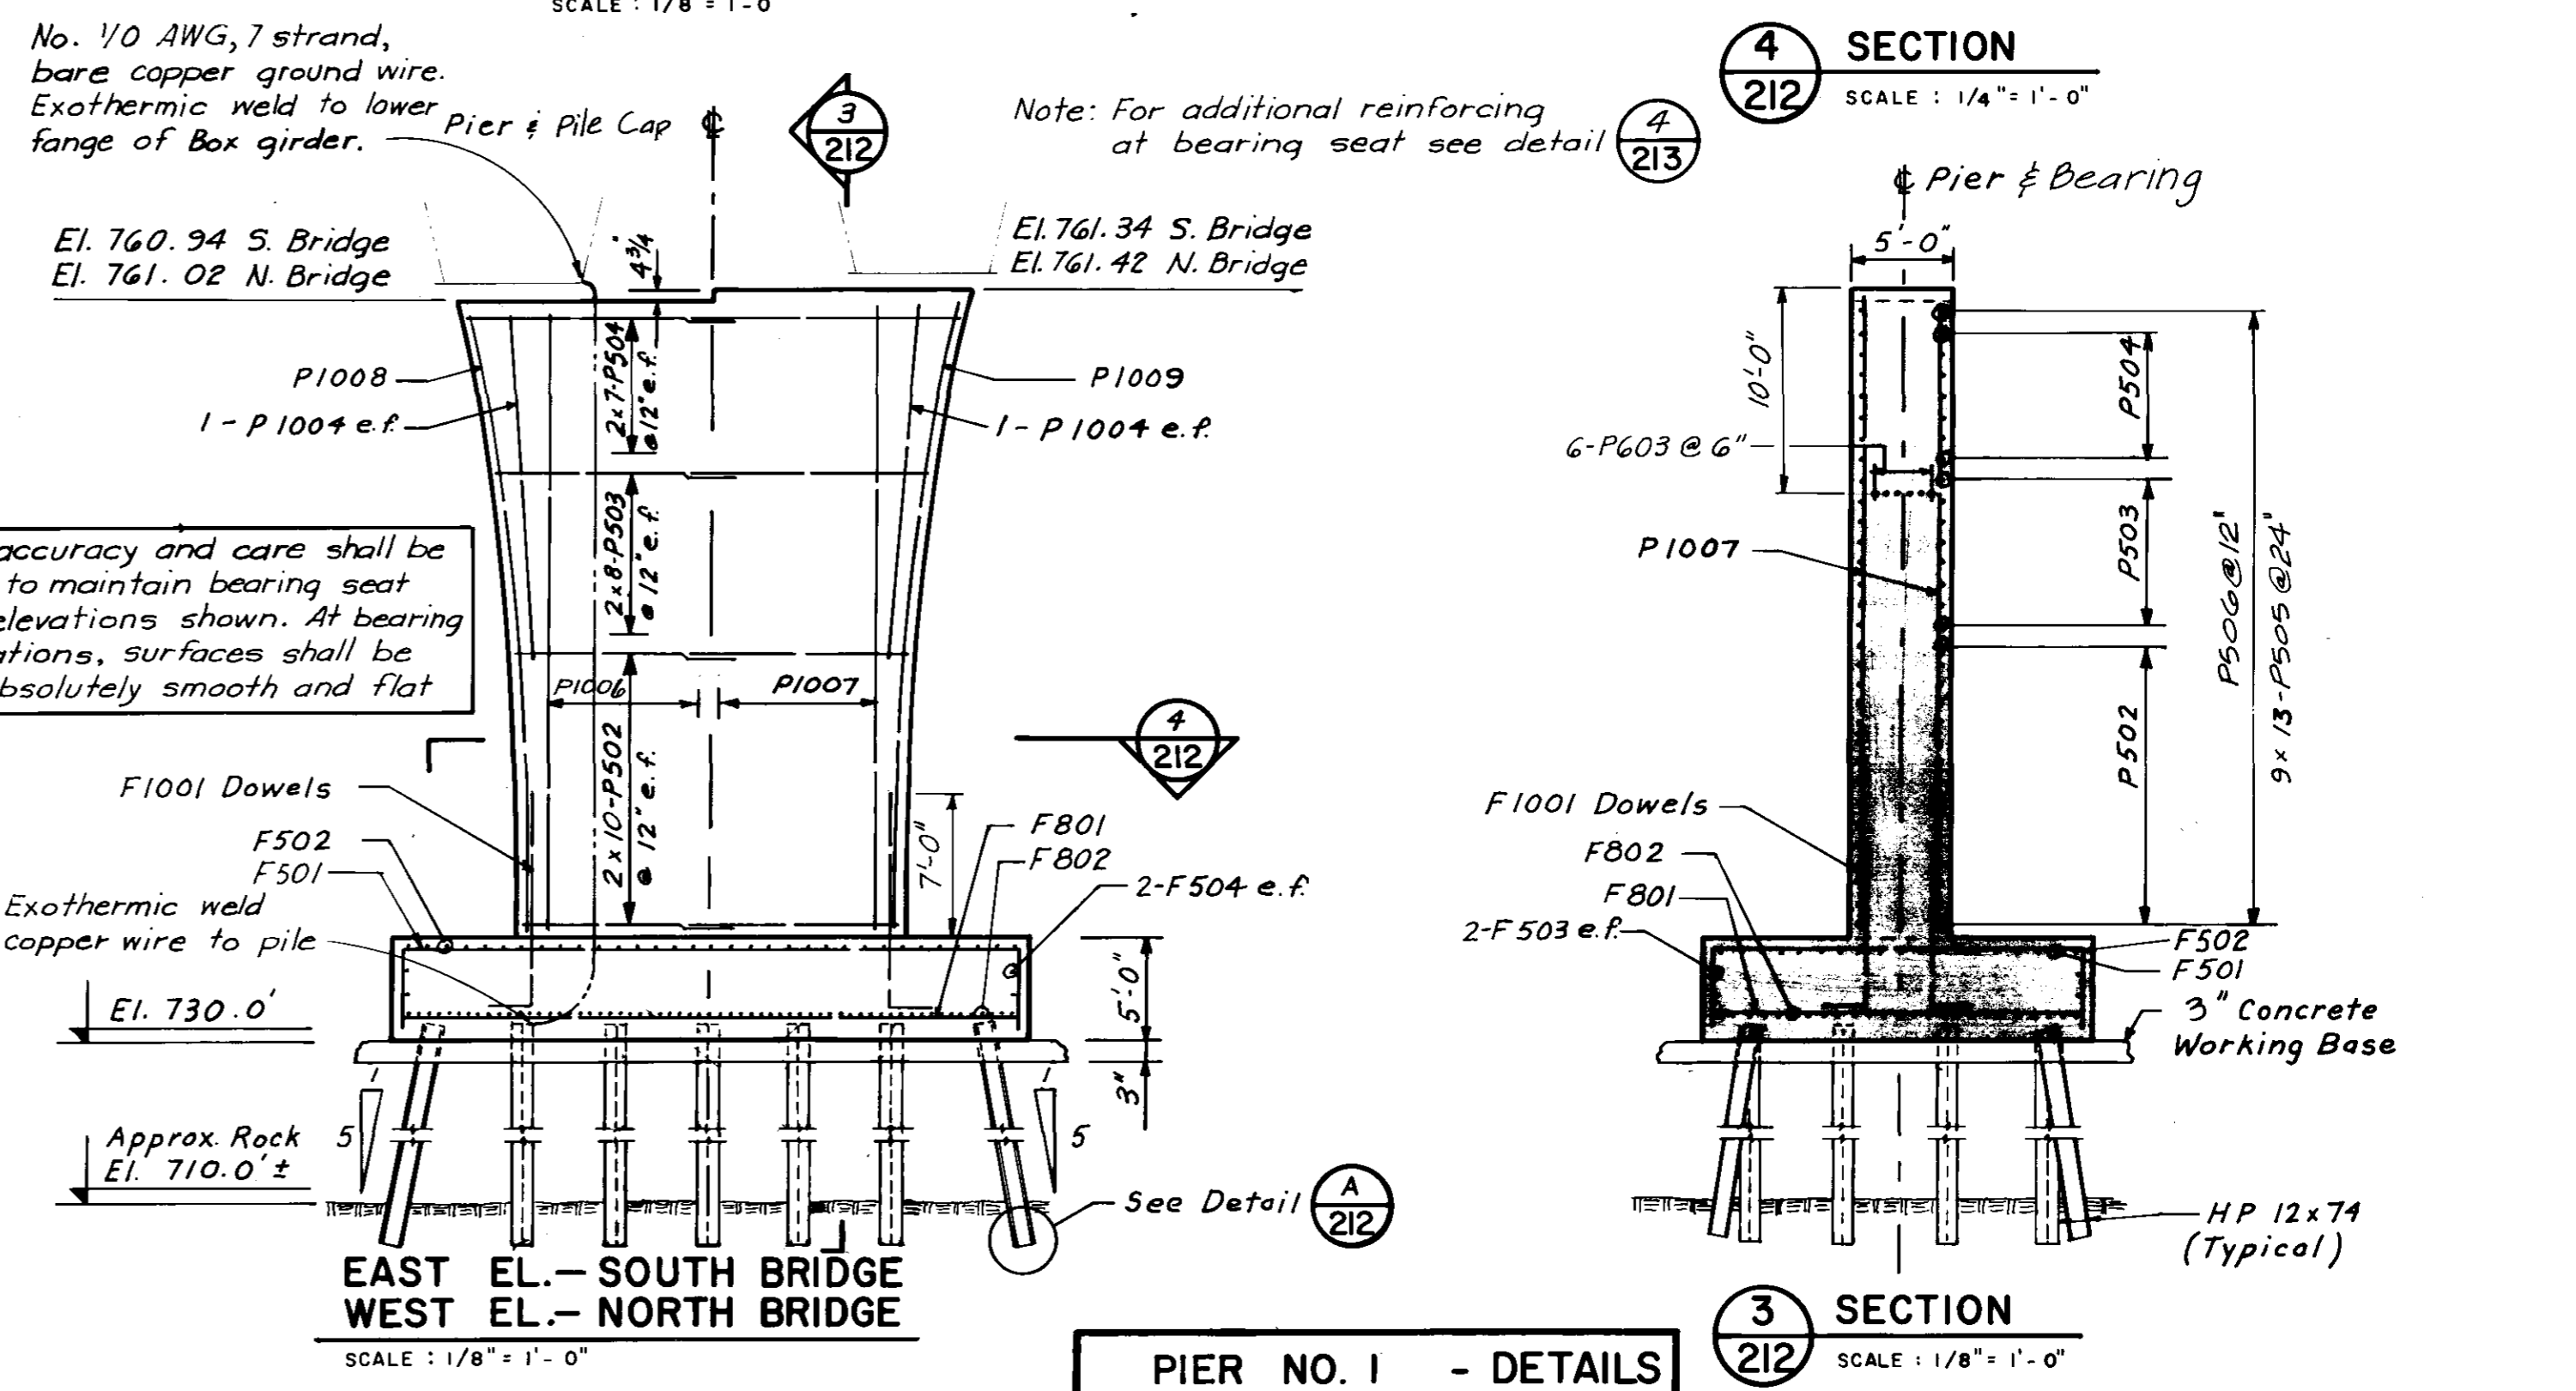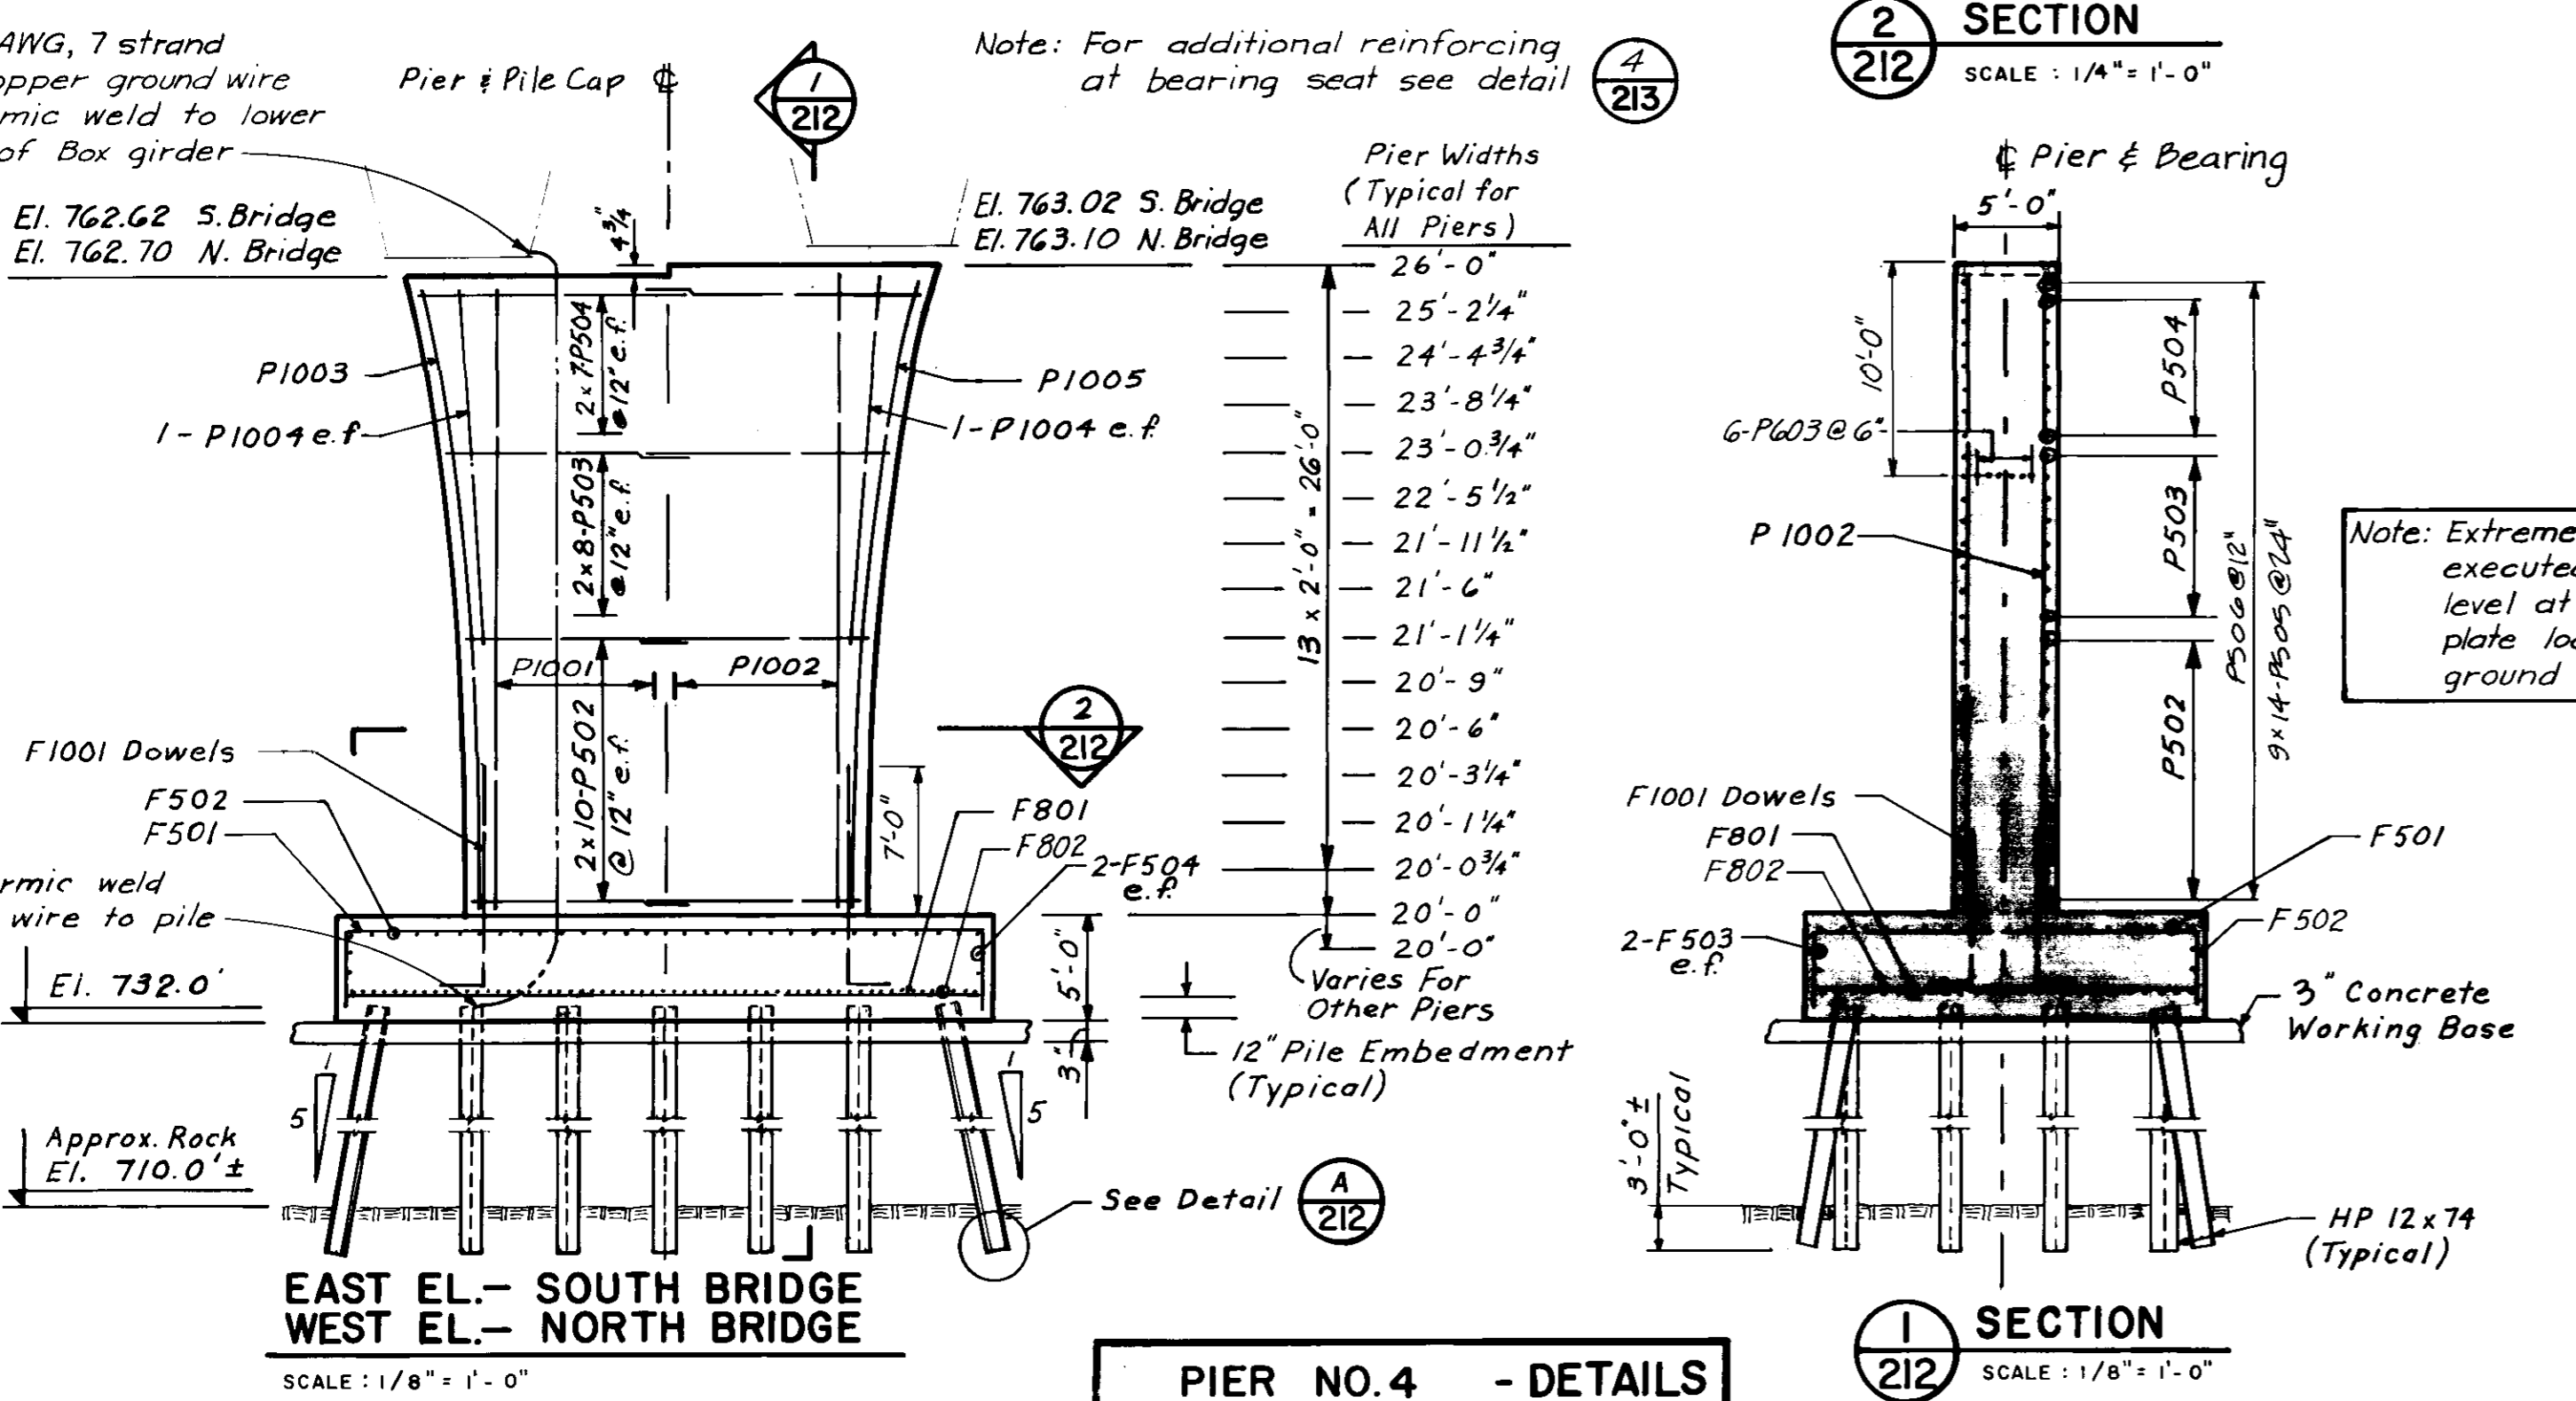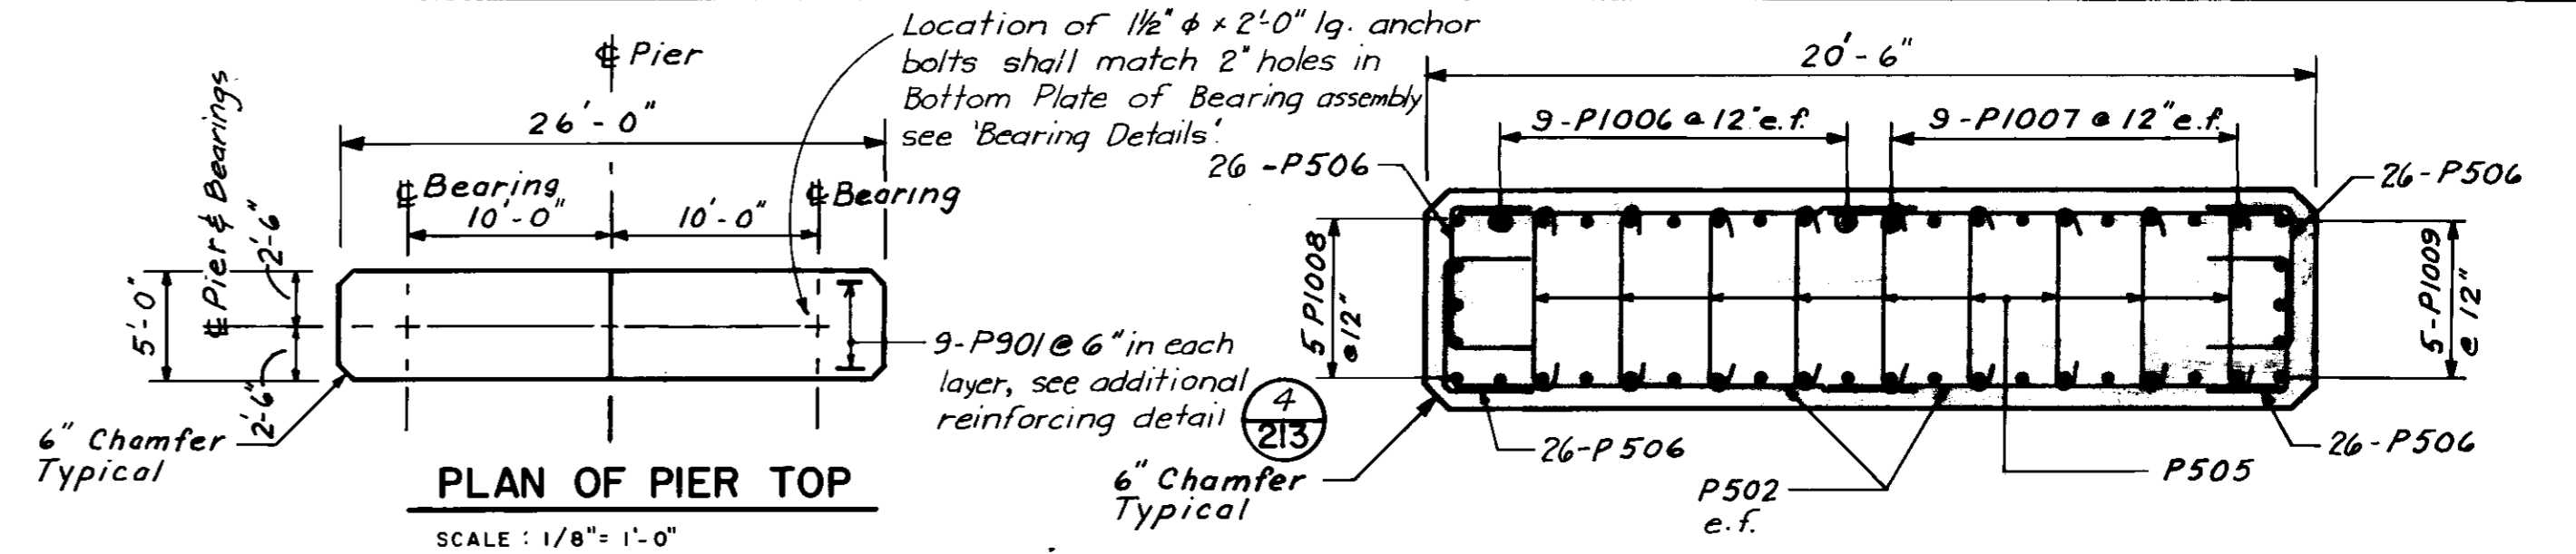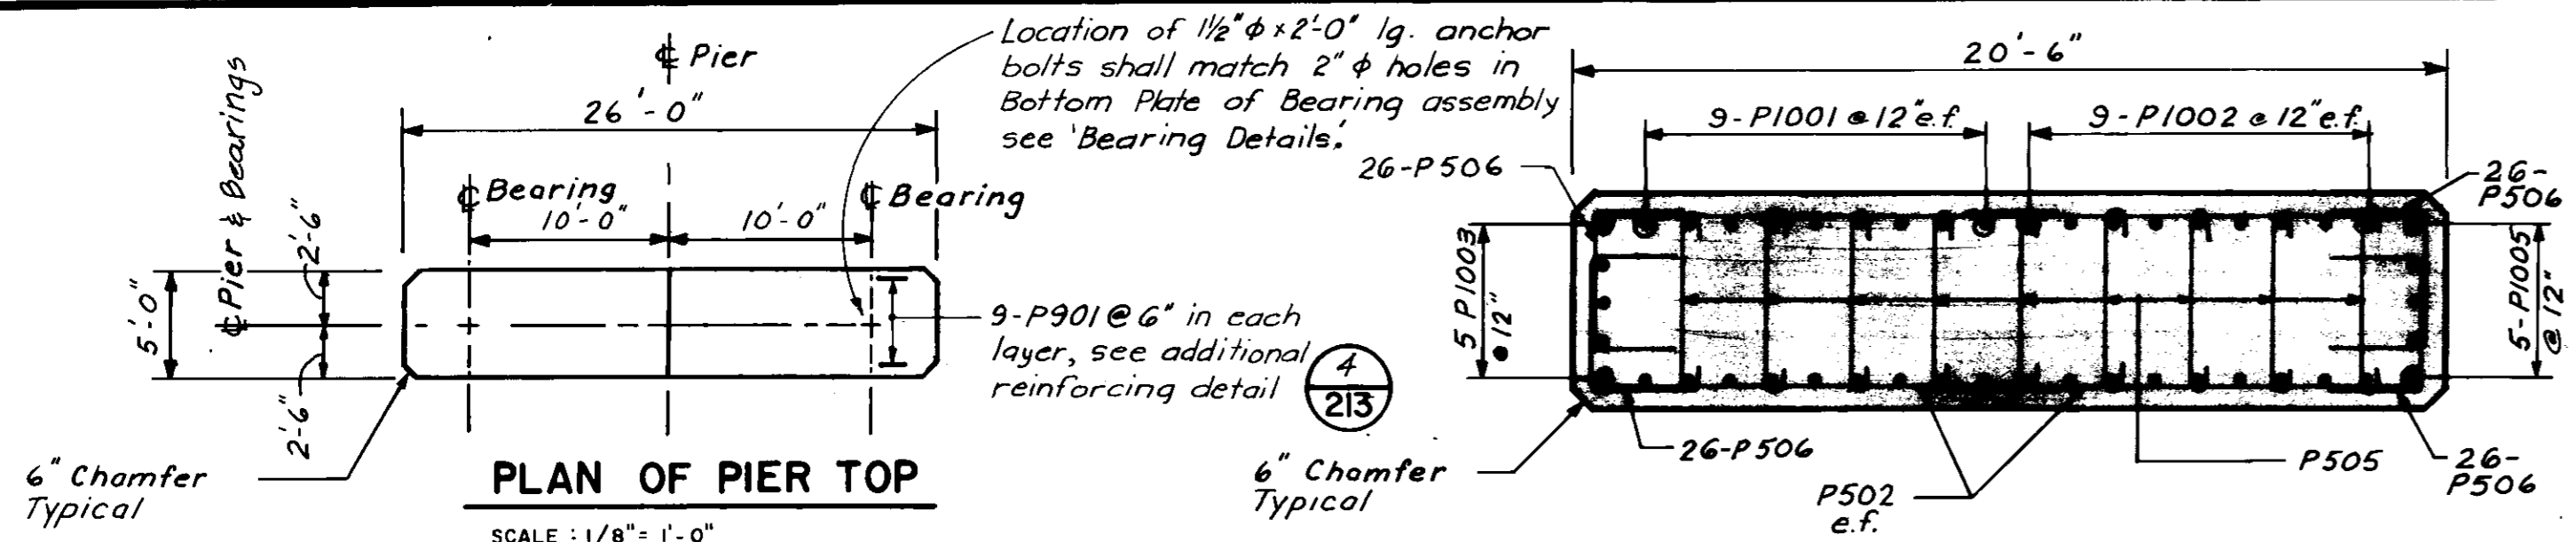

- Notes:
- Concrete seal under pile caps shall be designed by the Contractor to withstand all hydrostatic pressures.
 - Location of any construction joints in piers to be approved by the Engineer.
 - Maximum excavation limits shall not extend more than 2'-6" beyond the footing in any direction. Backfill with granular backfill; see General Section At River Piers for rip-rap details.
 - The clear distance between reinforcing and face of concrete shall be 6".

AS - BUILT		
DATE	FB NO	PAGE
Nov. 14/79		

NO	ISSUED FOR TENDER	4.4.77
	REVISIONS	DATE BY

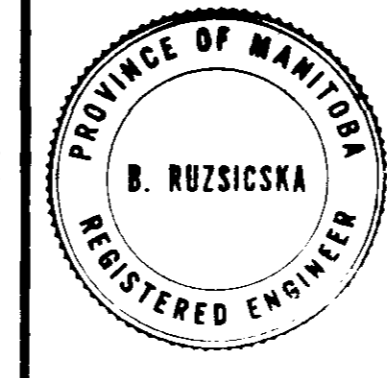

THE CITY OF WINNIPEG
WORKS & OPERATIONS DEPARTMENT
STREETS & TRANSPORTATION DIVISION

W.L. WARDROP & ASSOCIATES LTD.
ENGINEERING CONSULTANTS
WINNIPEG - THUNDER BAY - REGINA - BARRIE - EDMONTON

APPROVED BY: *[Signature]* DATE: 25.11.77

DRAWN BY: J.R.E. DATE: 25.7.76
PRELIM. CHK: B.J.R. DATE: JAN. 77

DESIGN: B.J.R. DATE: 25.7.76
CHECK: *[Signature]* DATE: 25.7.76

ROUTE 165

PIER NO.'S 1 & 4 DETAILS
NORTH & SOUTH BRIDGES




SCALE: AS SHOWN

DRAWING NO. B-5092-212




APPROVED BY: *[Signature]* DATE: 25/3/77
MANAGER OF STREETS AND TRAFFIC

Location of 1 1/2" φ x 2'-0" lg. anchor bolts shall match 2" φ holes in Bottom Plate of Bearing assembly see 'Bearing Details'.

Note: Extreme accuracy and care shall be executed to maintain bearing seat level at elevations shown. At bearing plate locations, surfaces shall be ground absolutely smooth and flat.

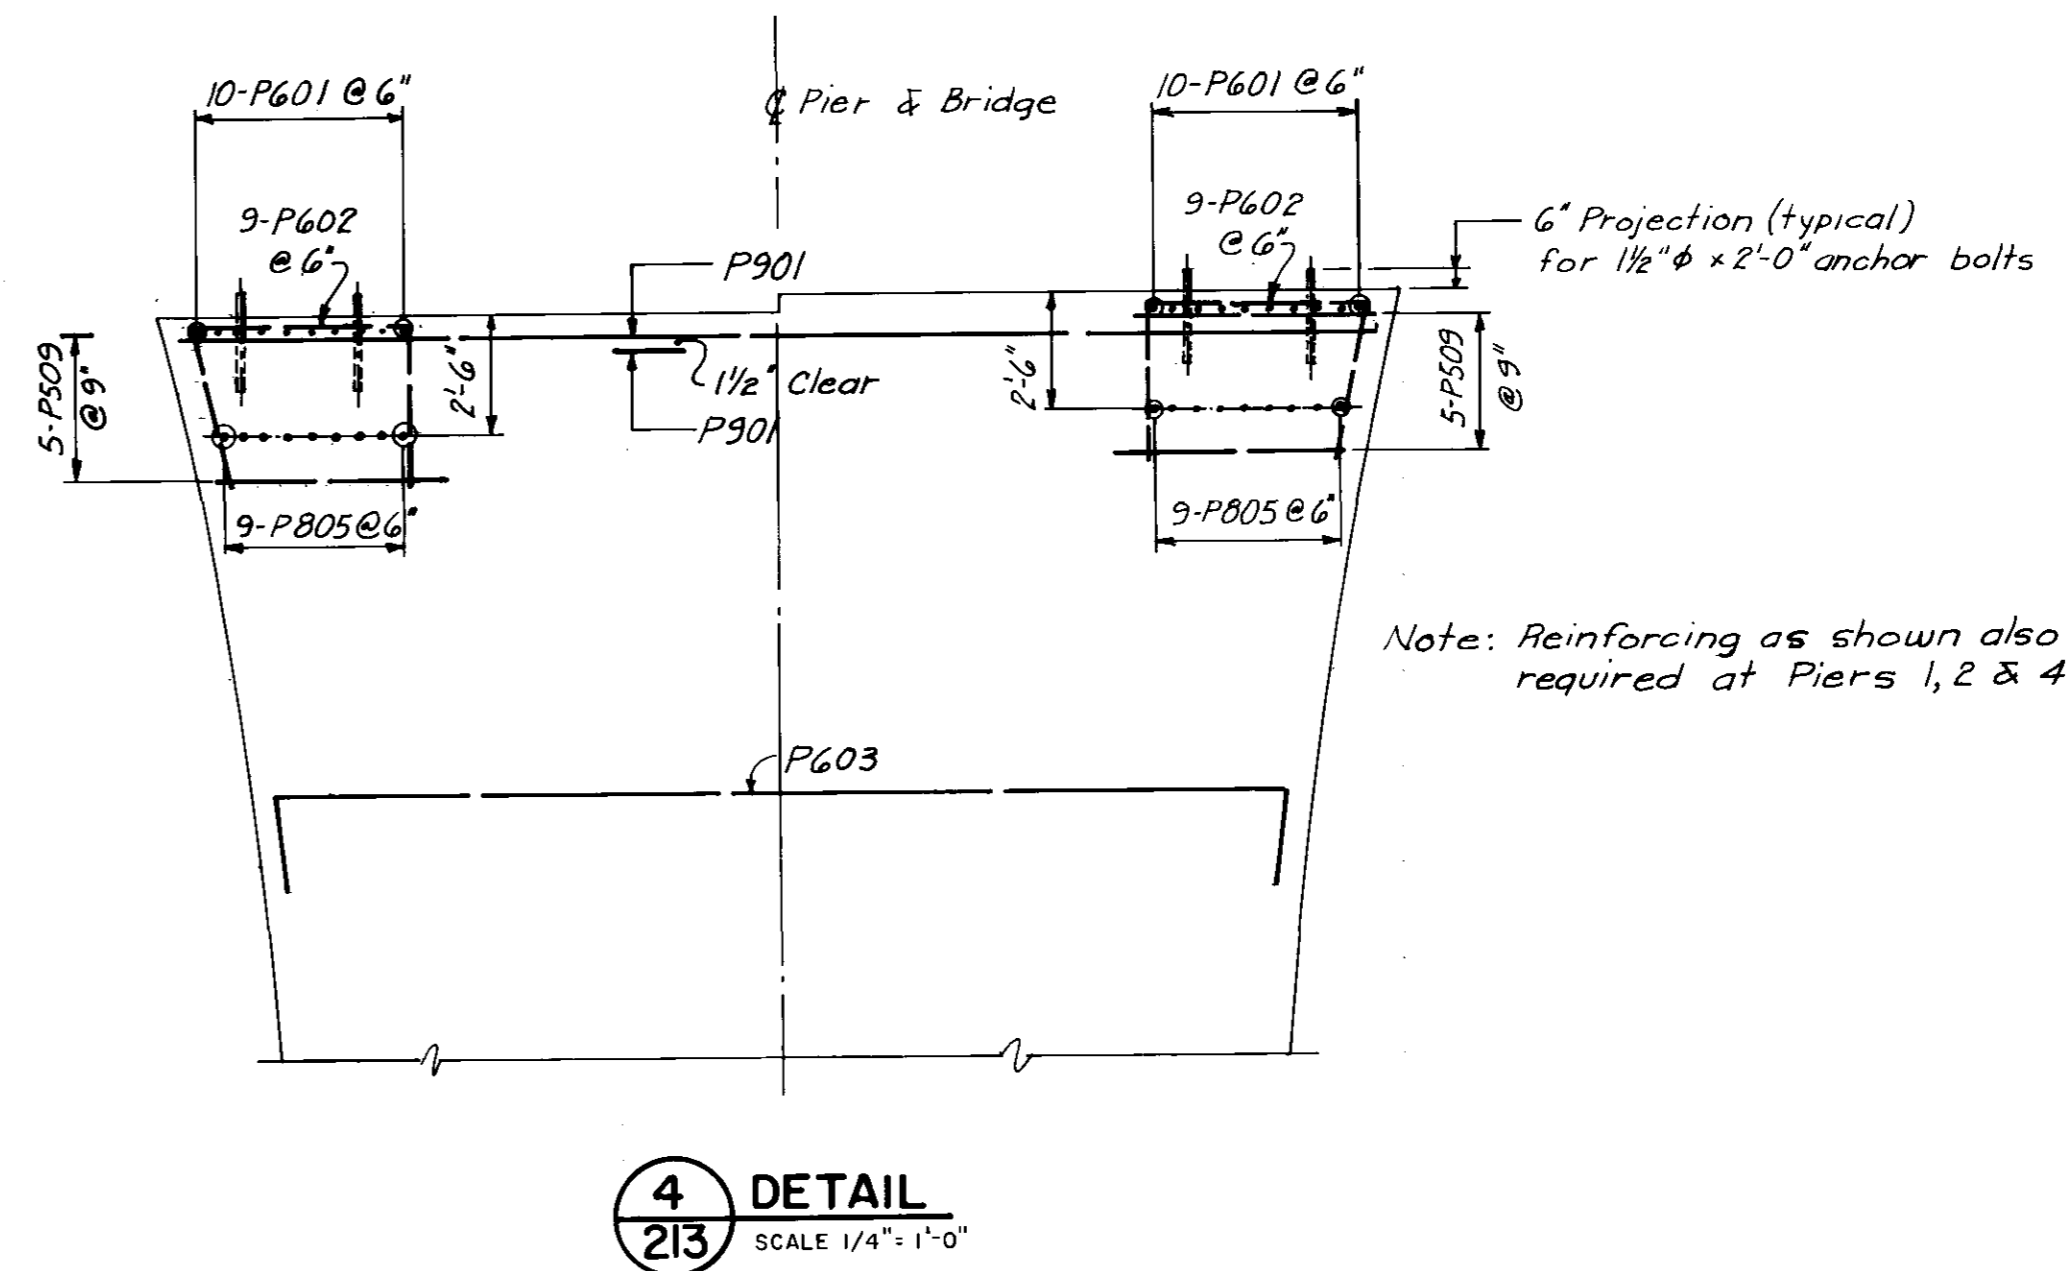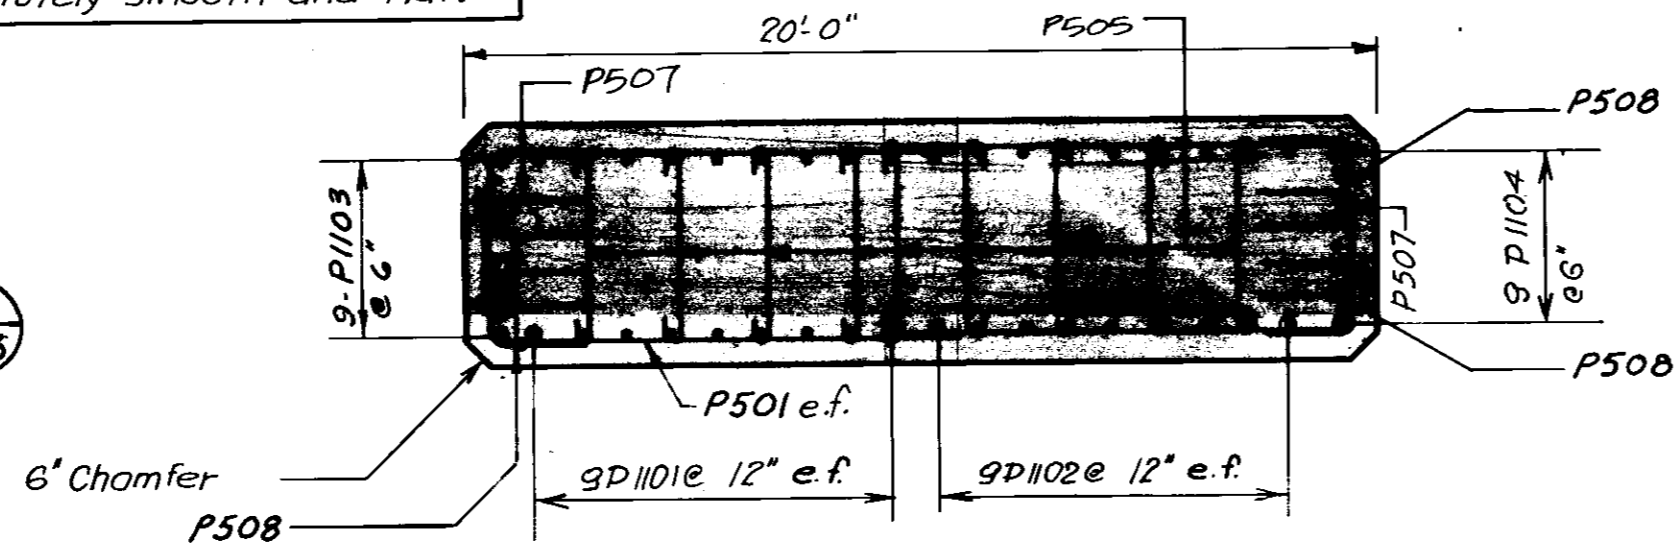
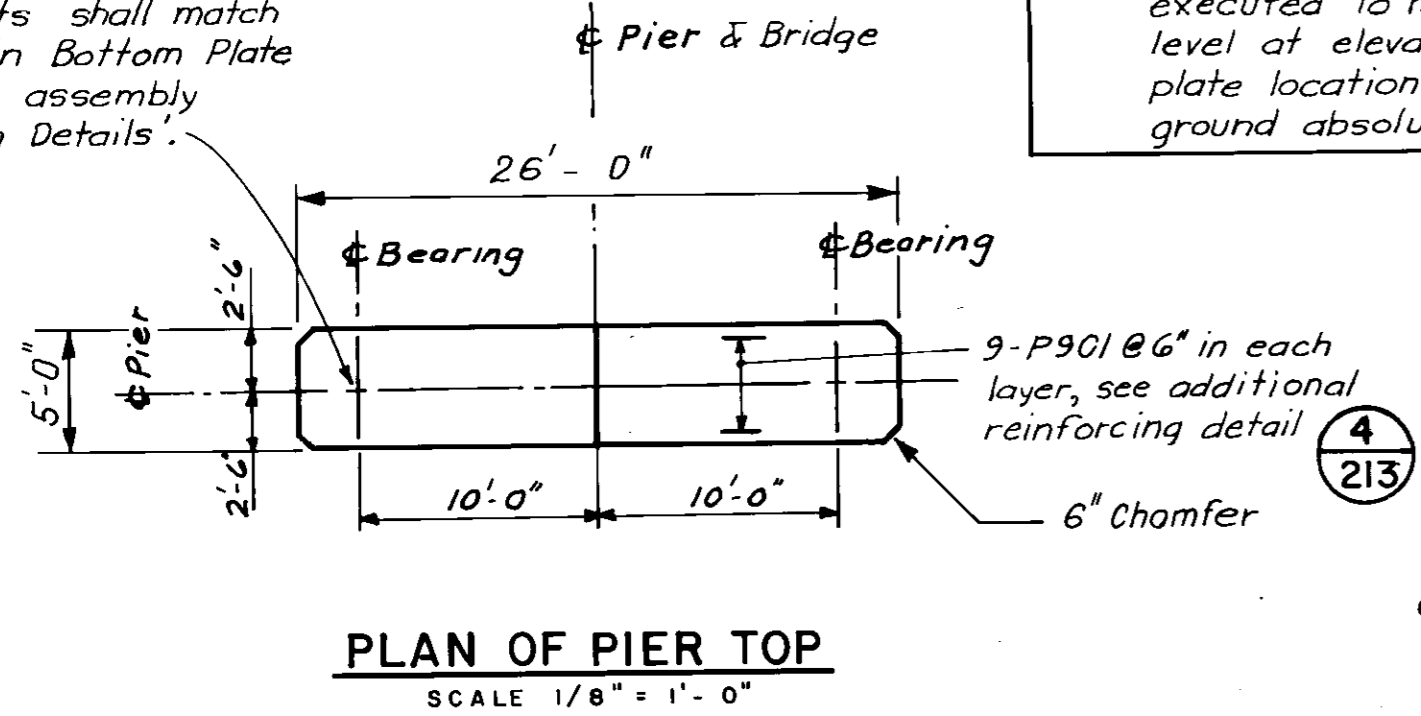


Note: Reinforcing as shown also required at Piers 1, 2 & 4.

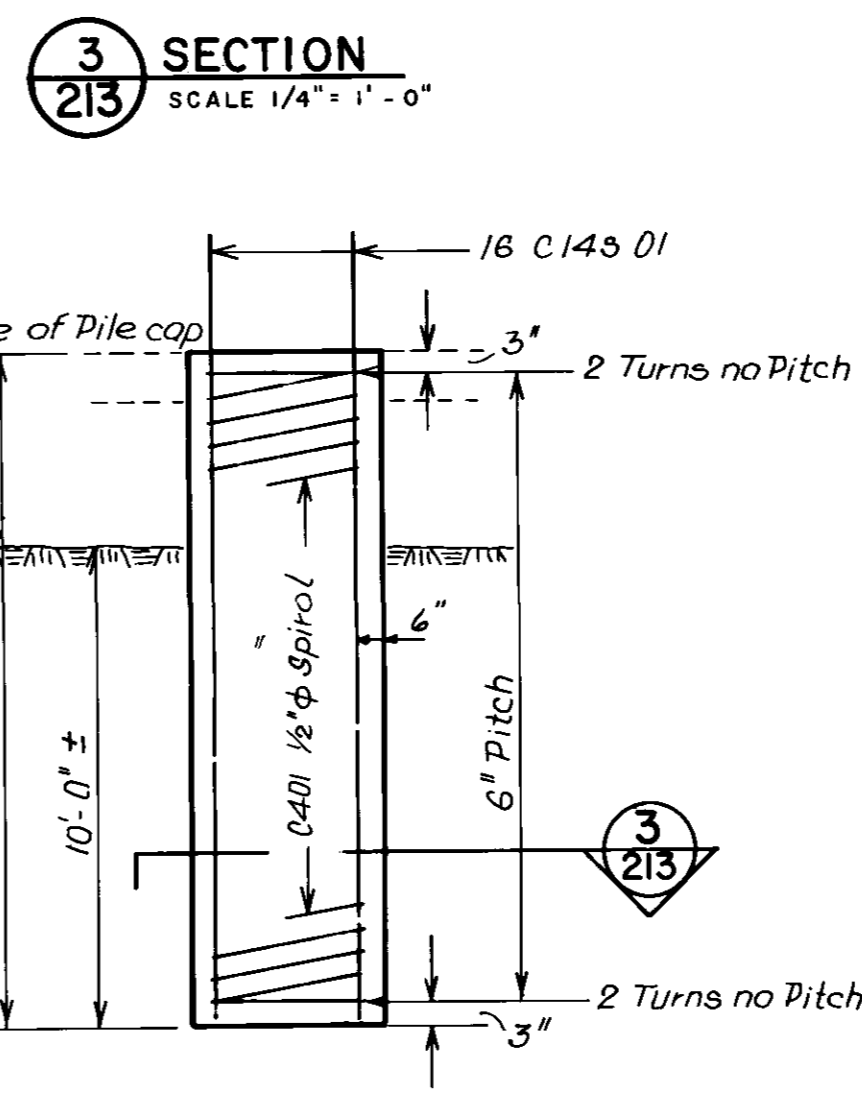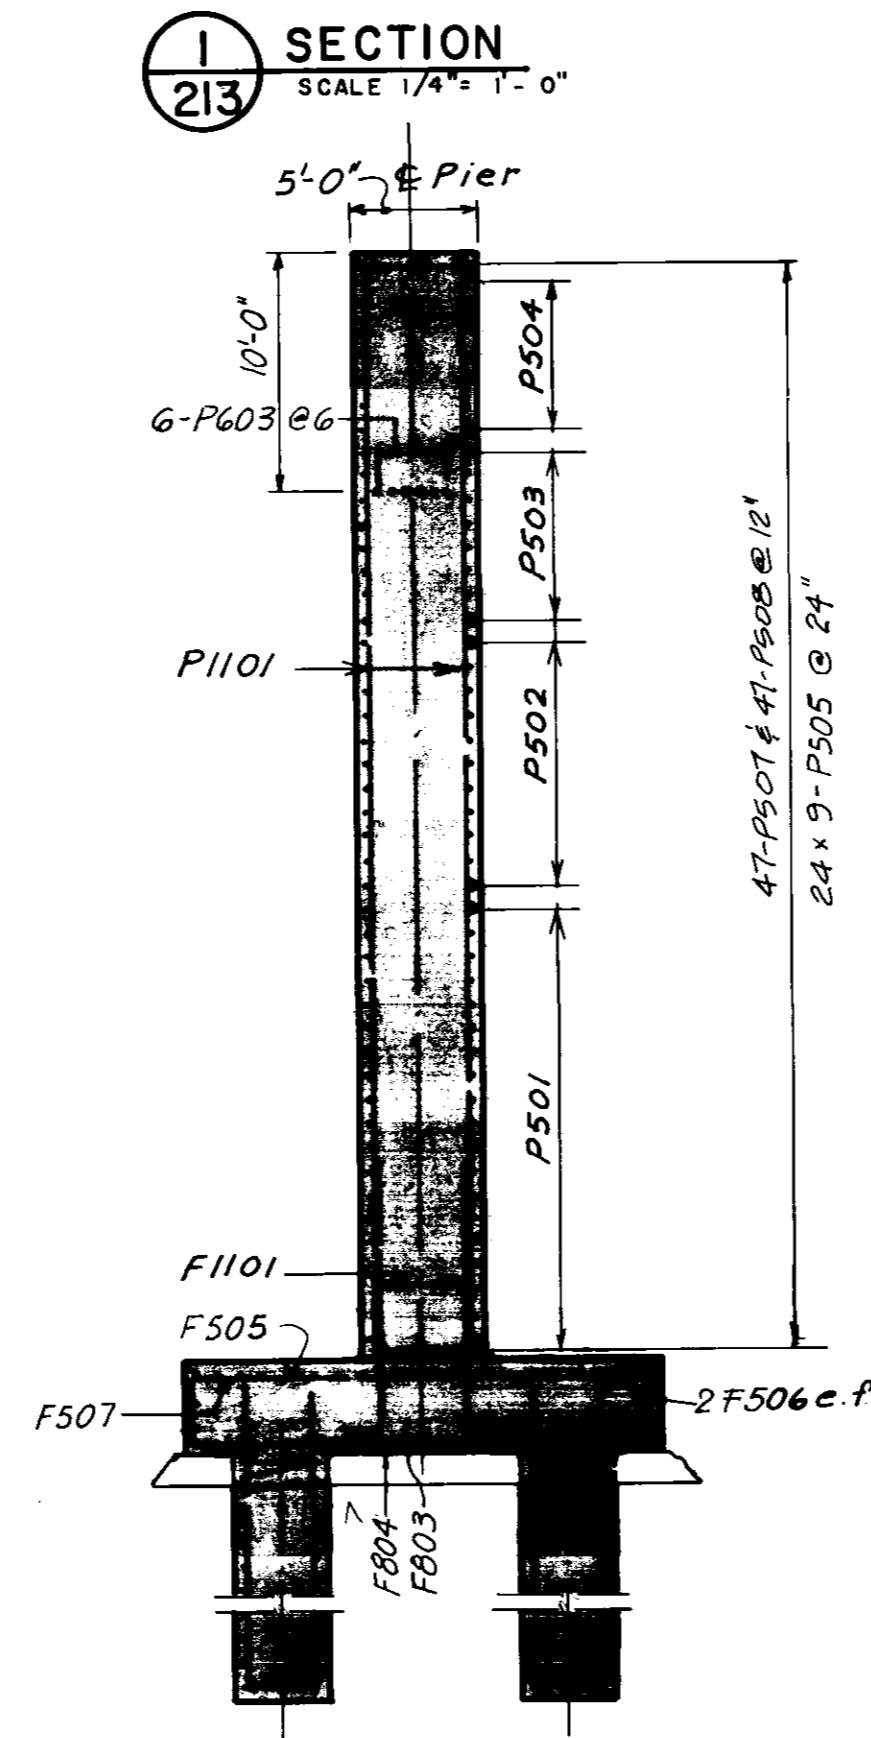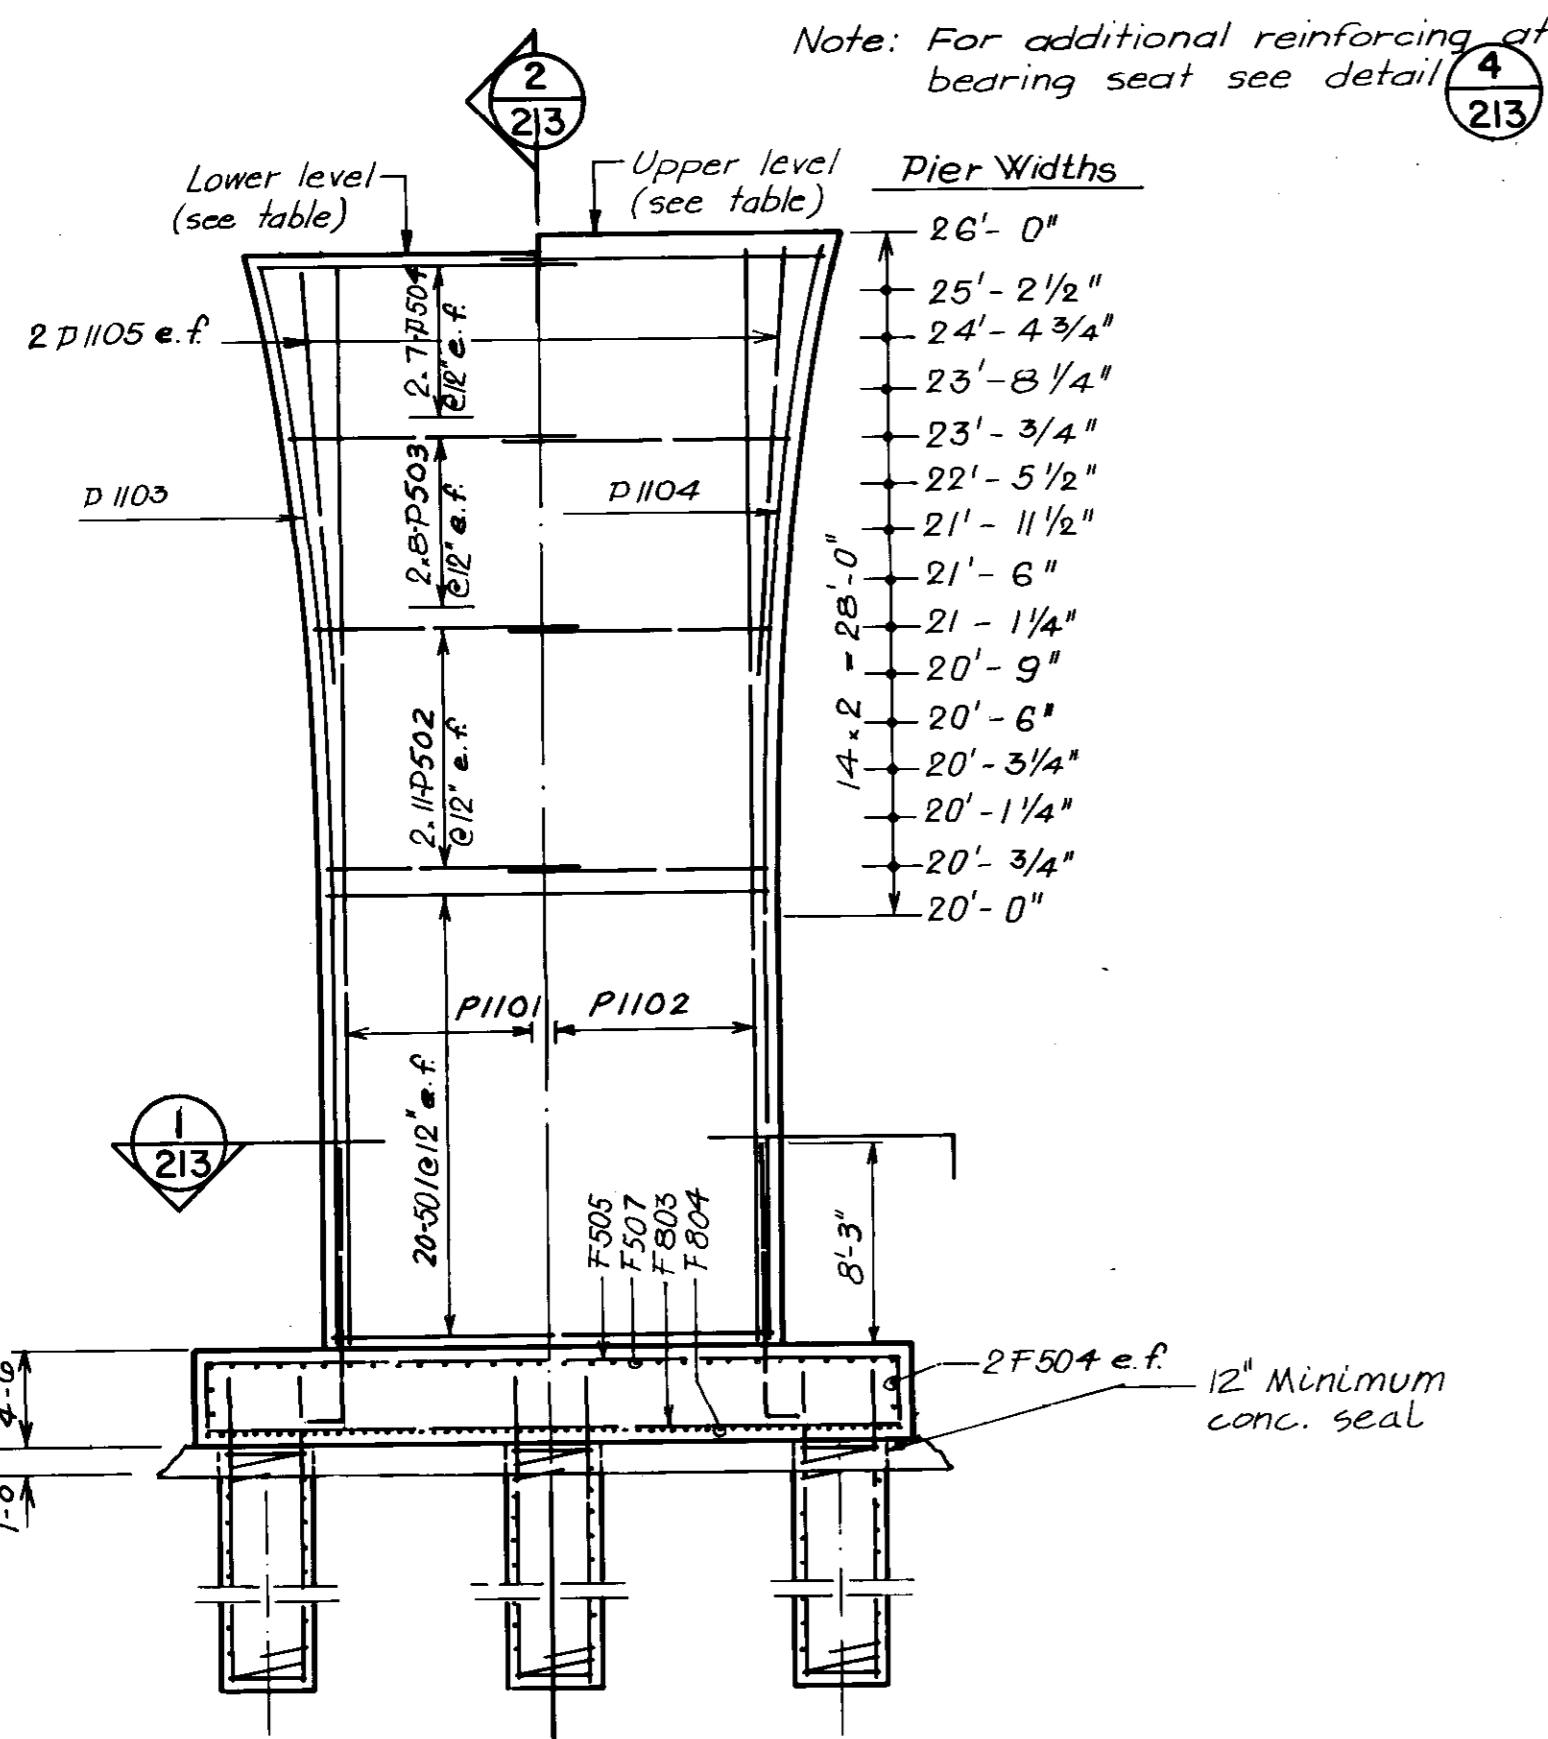

PIER NO.	SOUTH BRIDGE		NORTH BRIDGE	
	UPPER LEVEL	LOWER LEVEL	UPPER LEVEL	LOWER LEVEL
PIER 2	EI. 763.42	EI. 763.02	EI. 763.50	EI. 763.10
PIER 3	EI. 763.95	EI. 763.55	EI. 764.02	EI. 763.62
Shaft Height	Pier 2	46.42'	46.50'	46.10'
	Pier 3	46.95'	46.55'	46.62'


- Notes:
- Concrete seal under pile caps shall be designed by the Contractor to withstand all hydrostatic pressures.
 - Location of any construction joints in piers to be approved by the Engineer.
 - Maximum excavation limits shall not extend more than 2'-6" beyond the footing in any direction. Backfill with granular backfill; see General Section At River Piers for rip-rap details.
 - The clear distance between reinforcing and face of concrete shall be 6".

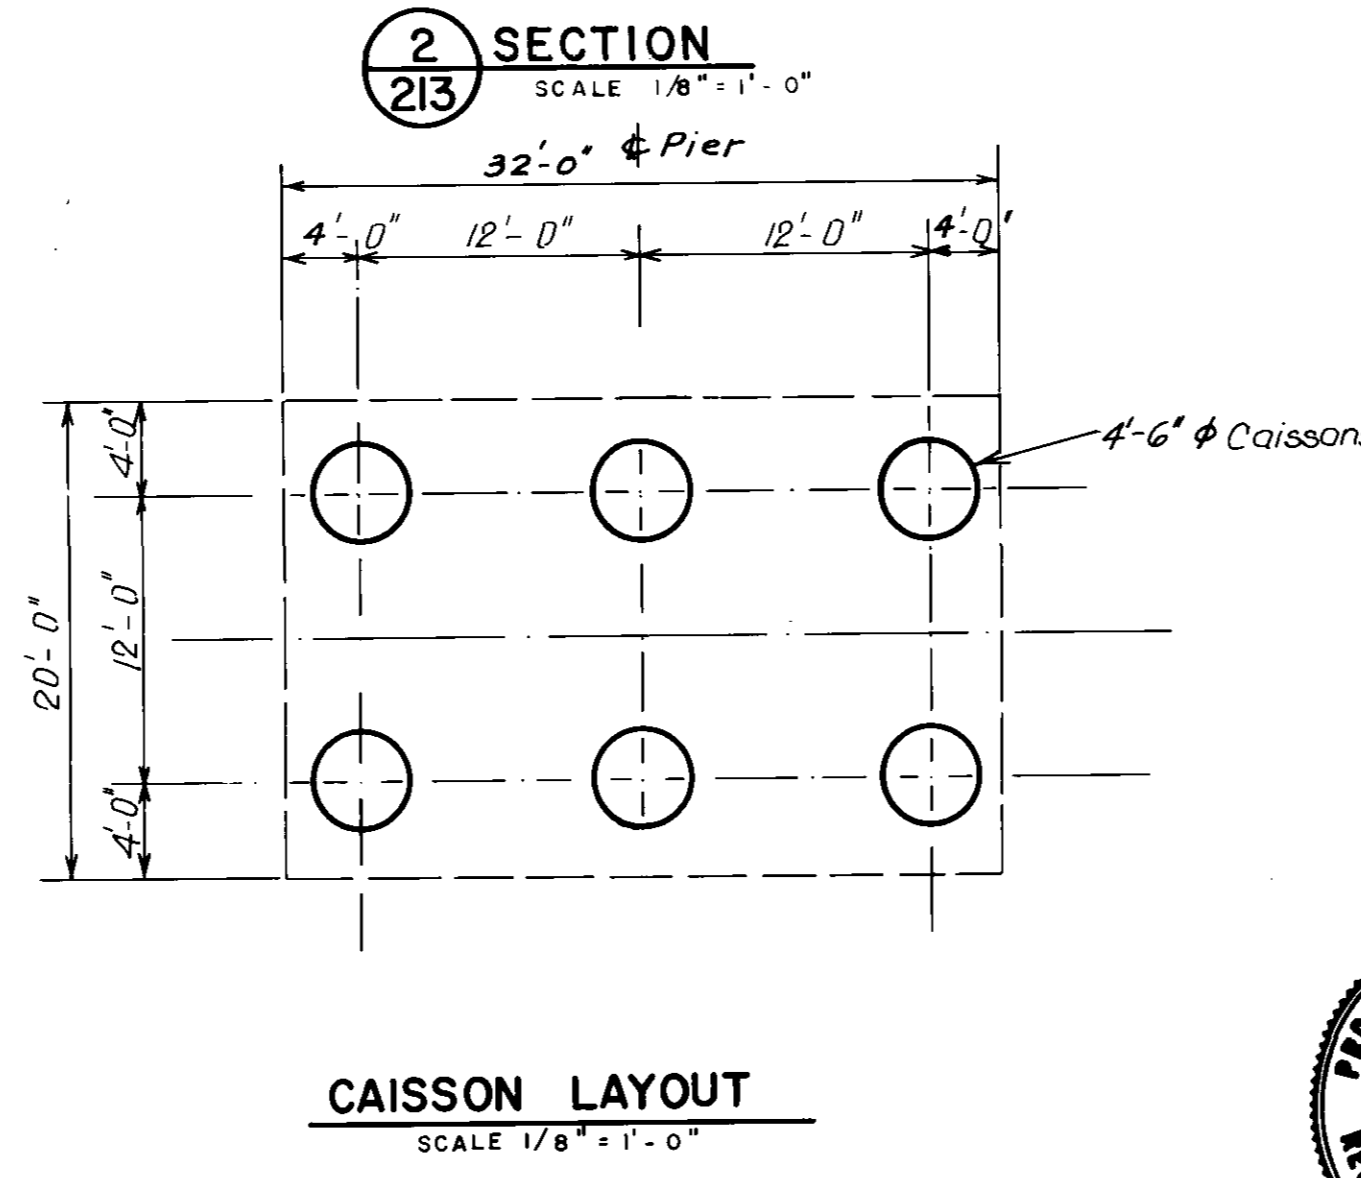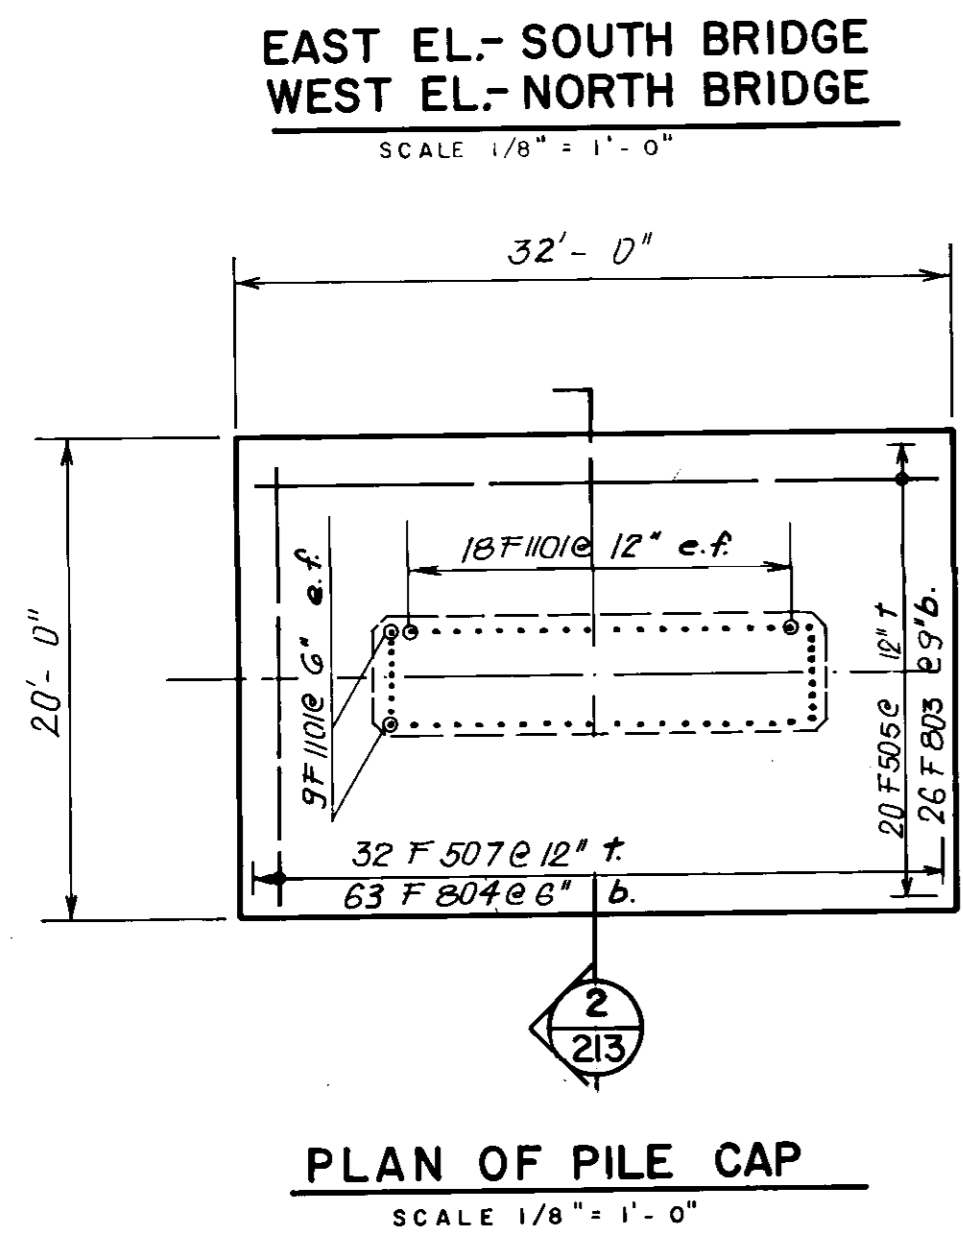

CAISSON ELEVATION. Scale 1/4" = 1'-0".


AS-BUILT
DATE: Nov. 14/77

NO.	REVISIONS	DATE	BY

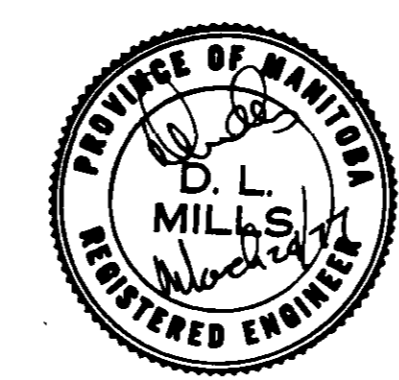


THE CITY OF WINNIPEG
WORKS & OPERATIONS DEPARTMENT
STREETS & TRANSPORTATION DIVISION
W.L. WARDROP & ASSOCIATES LTD.
ENGINEERING CONSULTANTS
WINNIPEG, THUNDER BAY, REGINA, BARRIE, EDMONTON

ROUTE 165
PIER NO.'S 2 & 3 DETAILS
NORTH & SOUTH BRIDGES
SCALE: AS SHOWN
DRAWING NO. B-5092-213
APPROVED BY: *Stewart R. Campbell* 25/3/77
MANAGER OF STREETS AND TRAFFIC

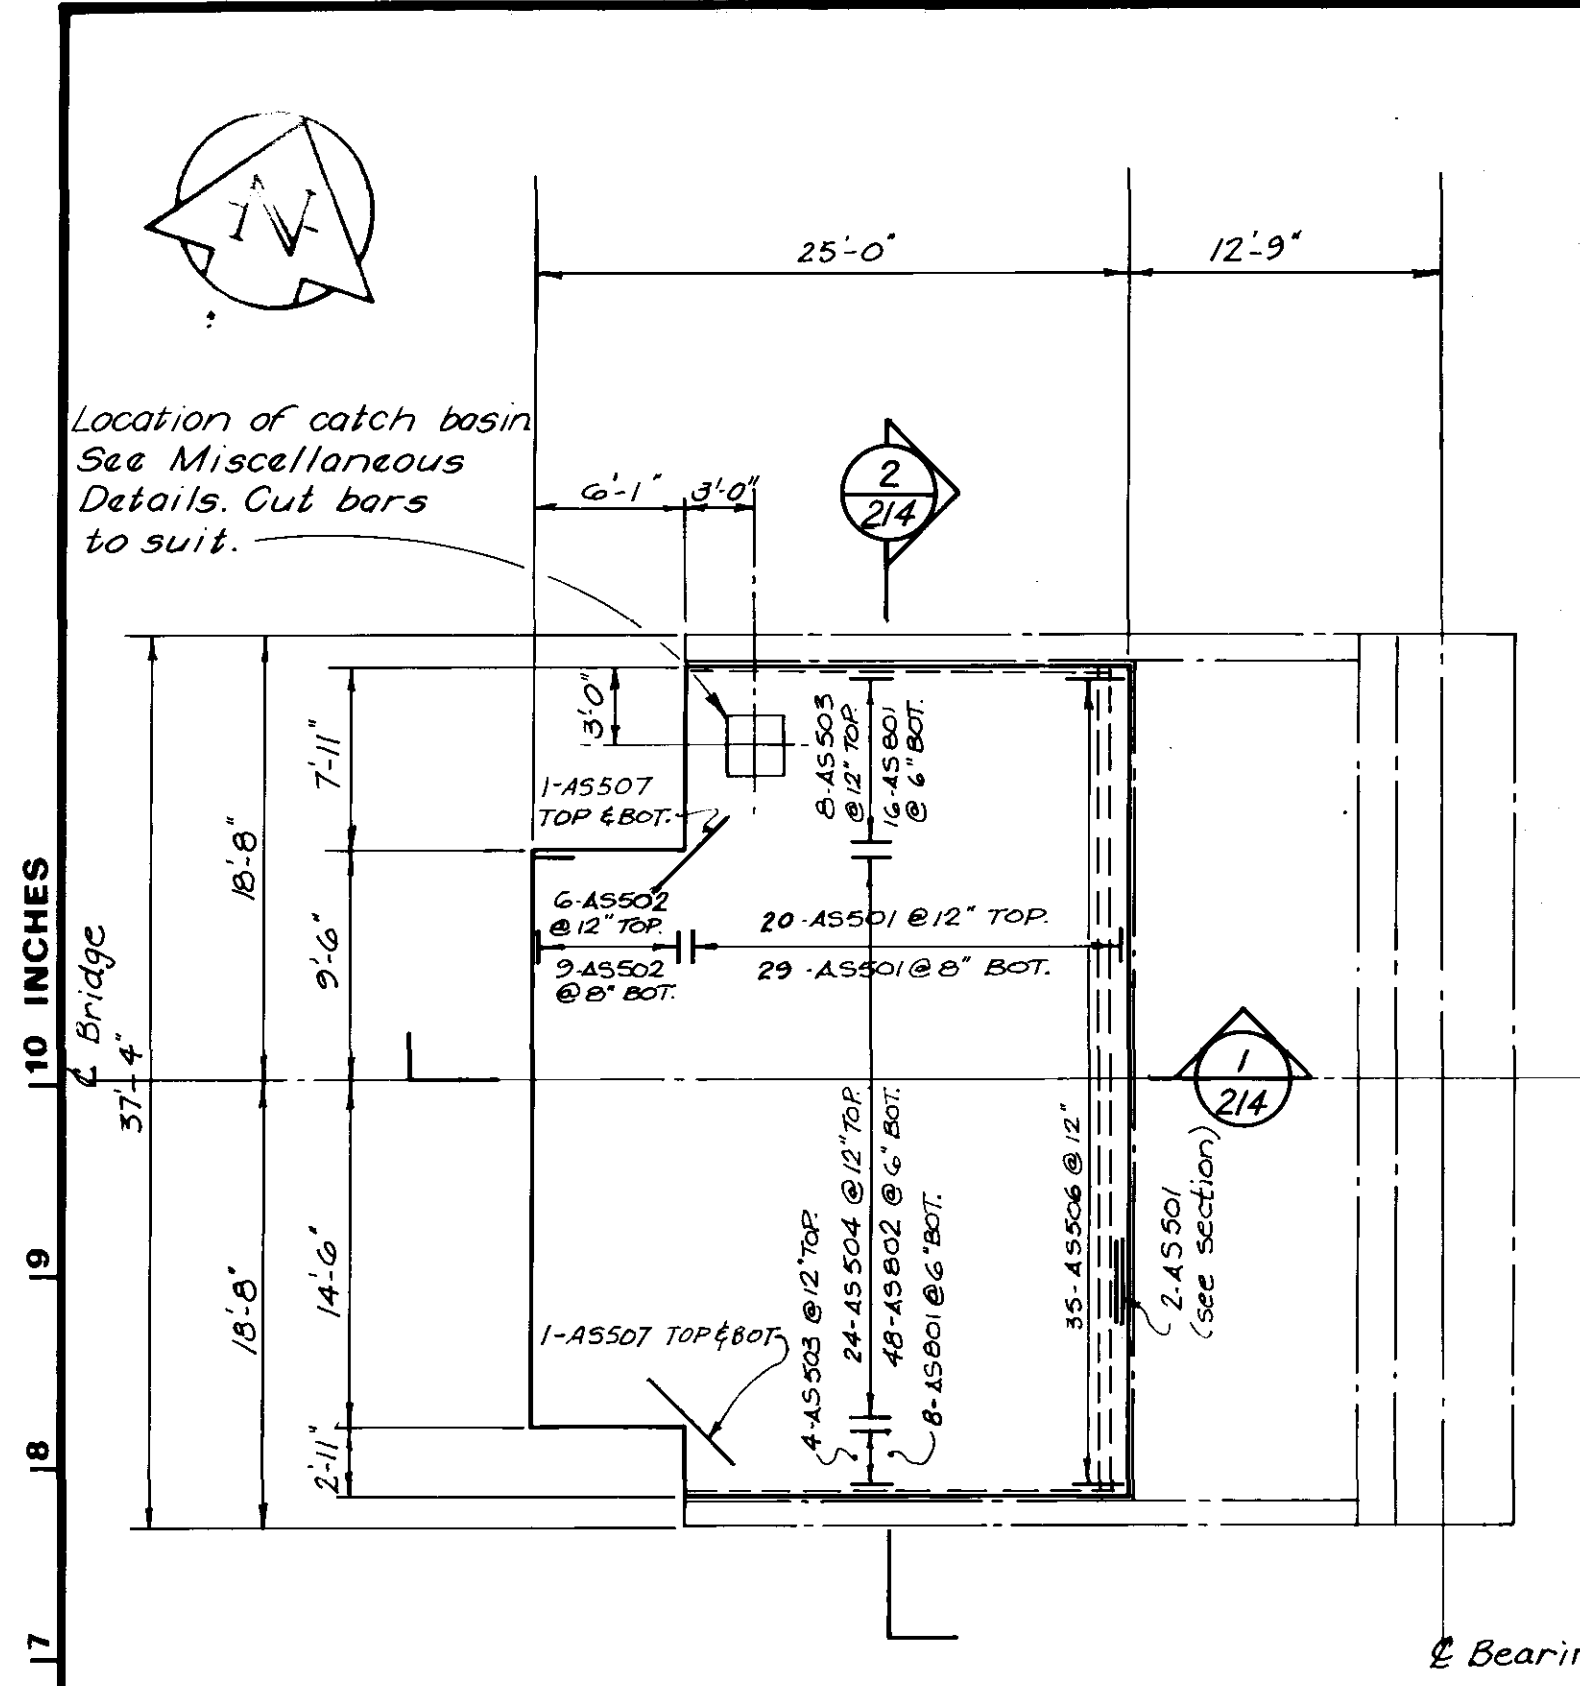


APPROACH SLAB WEST ABUTMENT
Scale 1/8" = 1'-0"

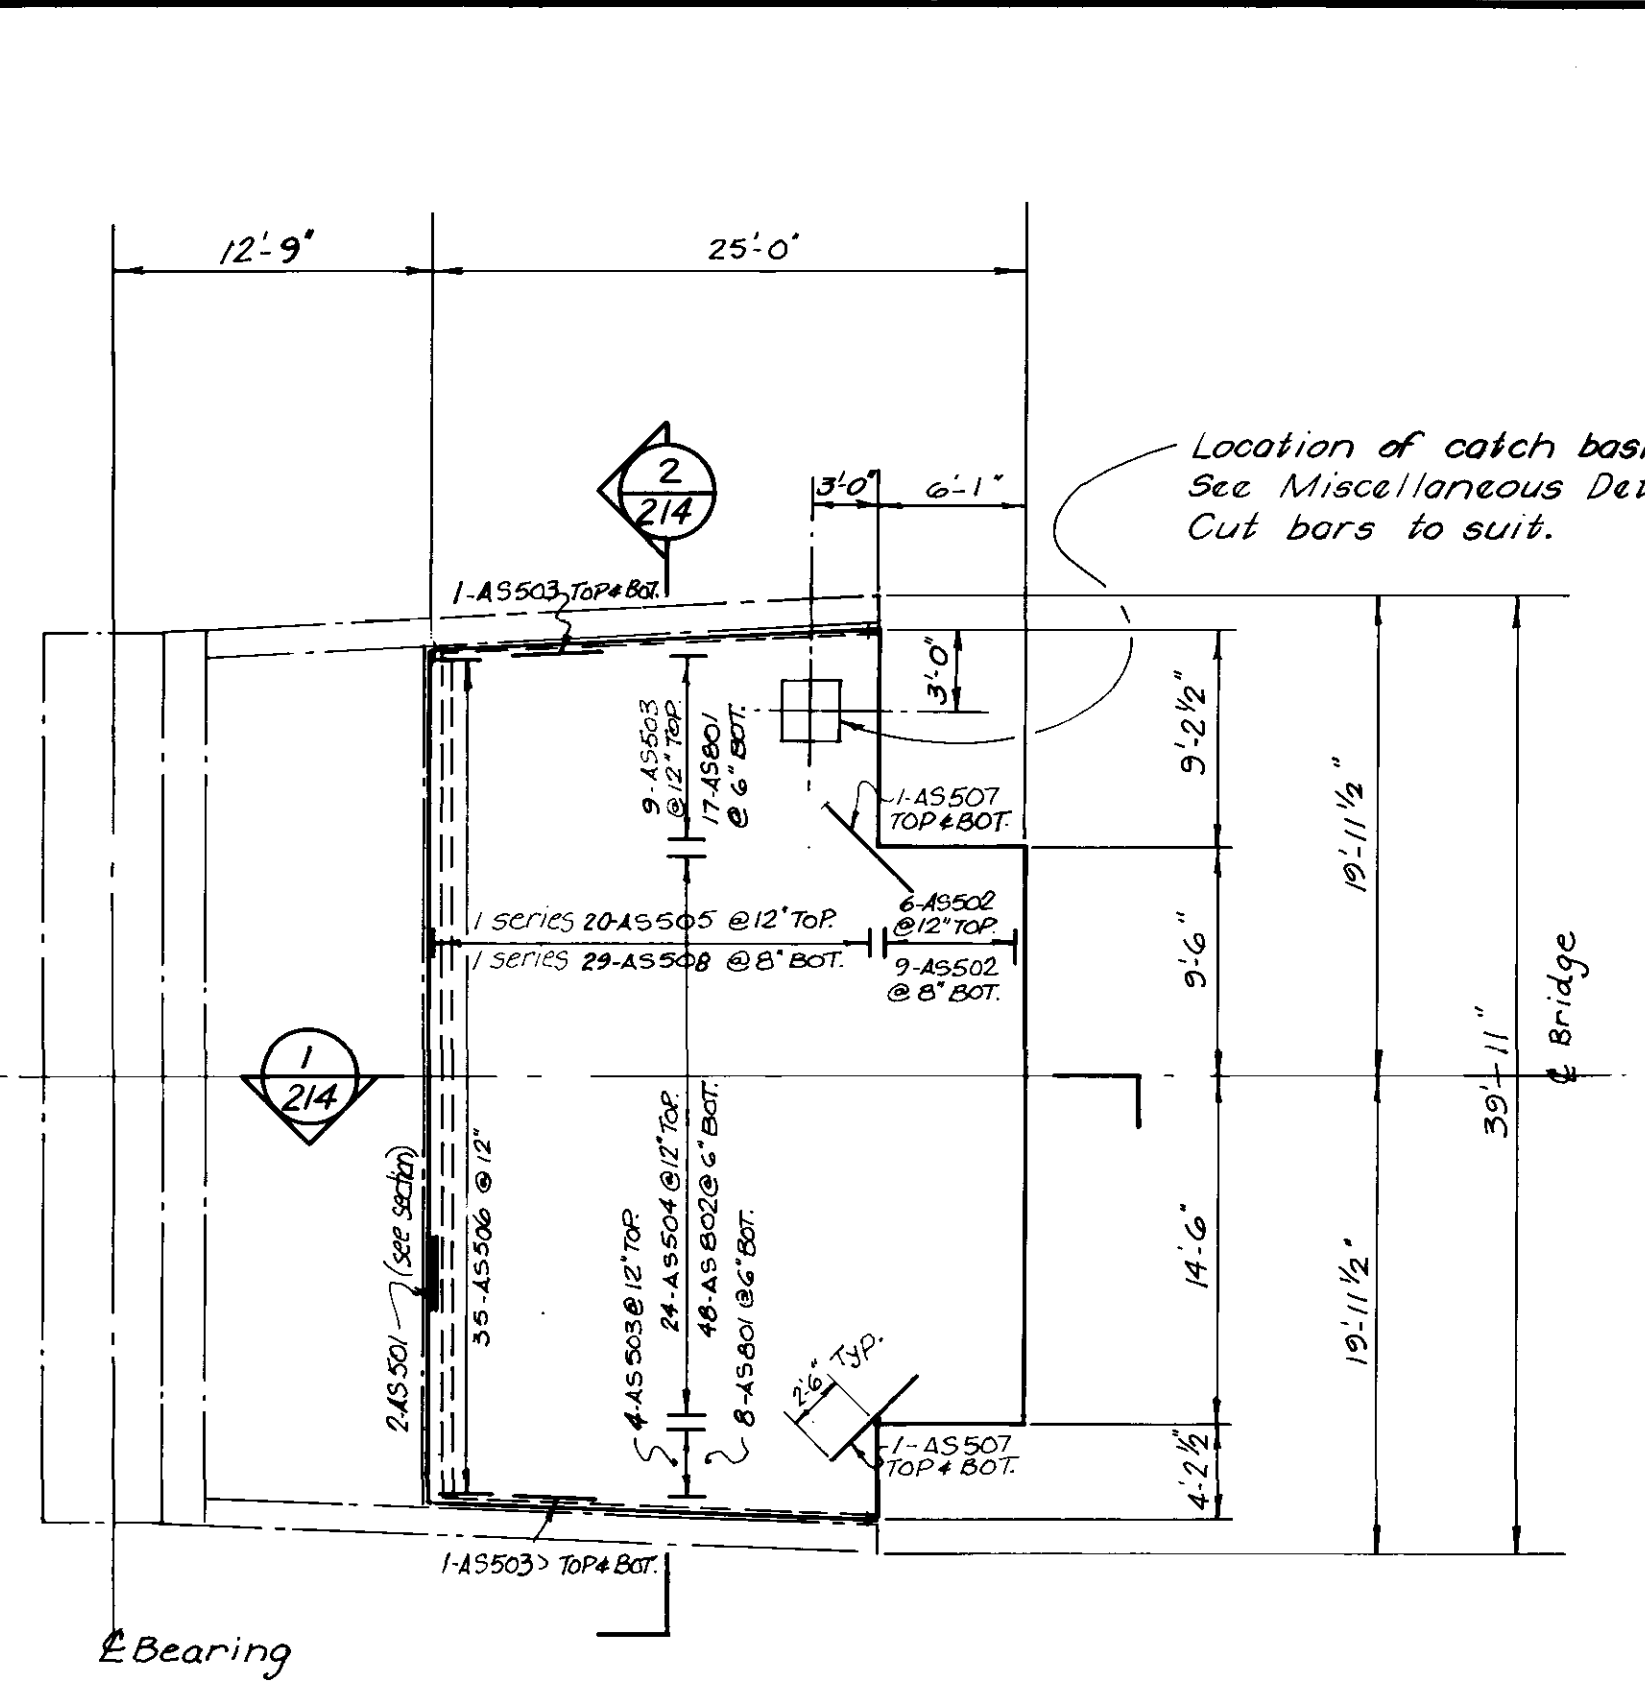


APPROACH SLAB EAST ABUTMENT
Scale 1/8" = 1'-0"

NORTH BRIDGE

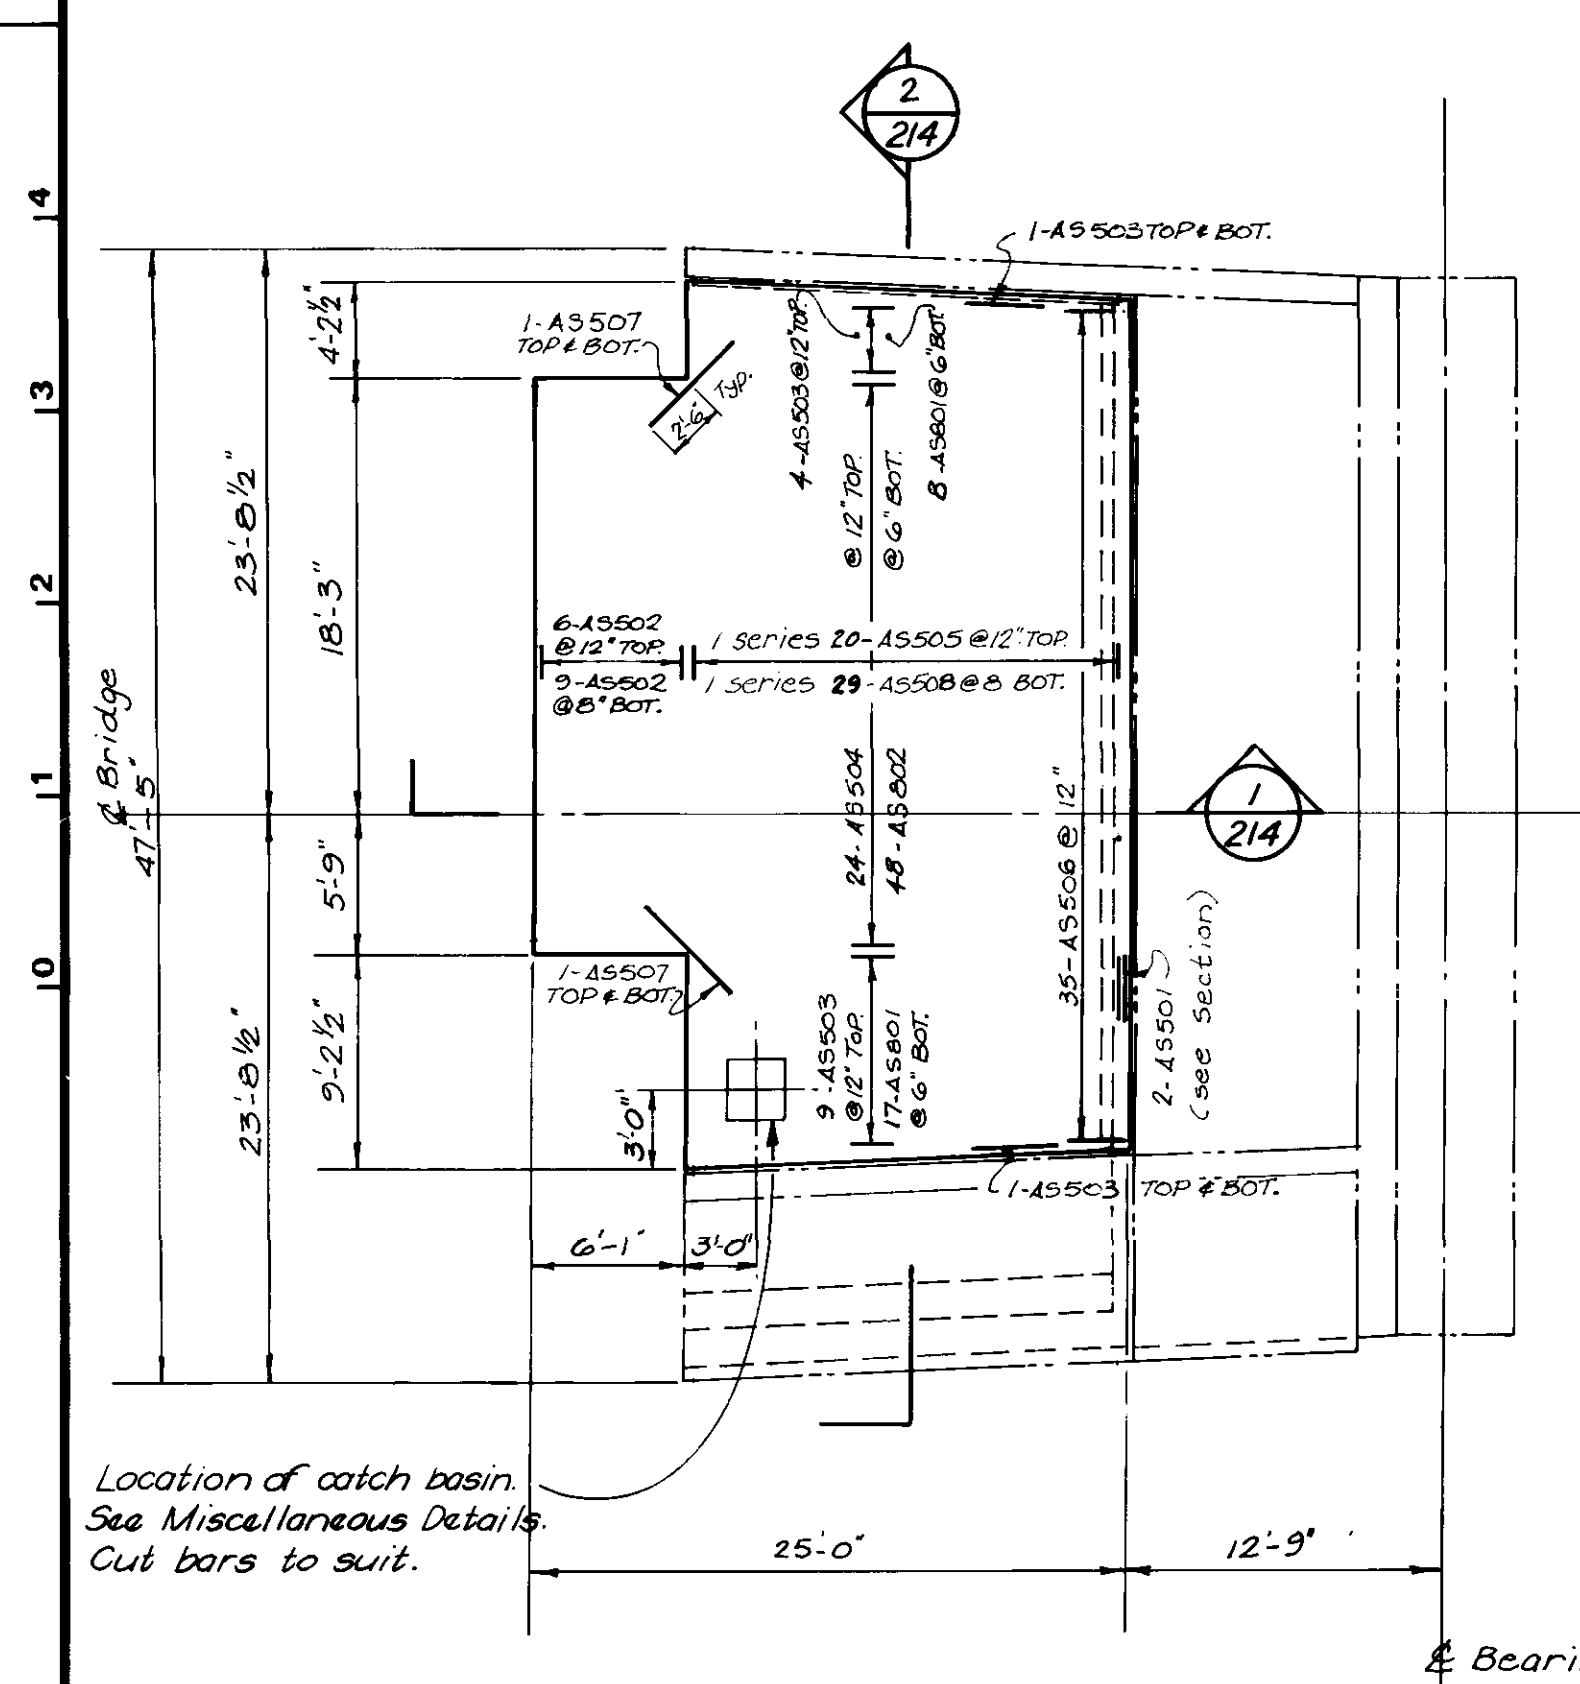


APPROACH SLAB WEST ABUTMENT
Scale 1/8" = 1'-0"

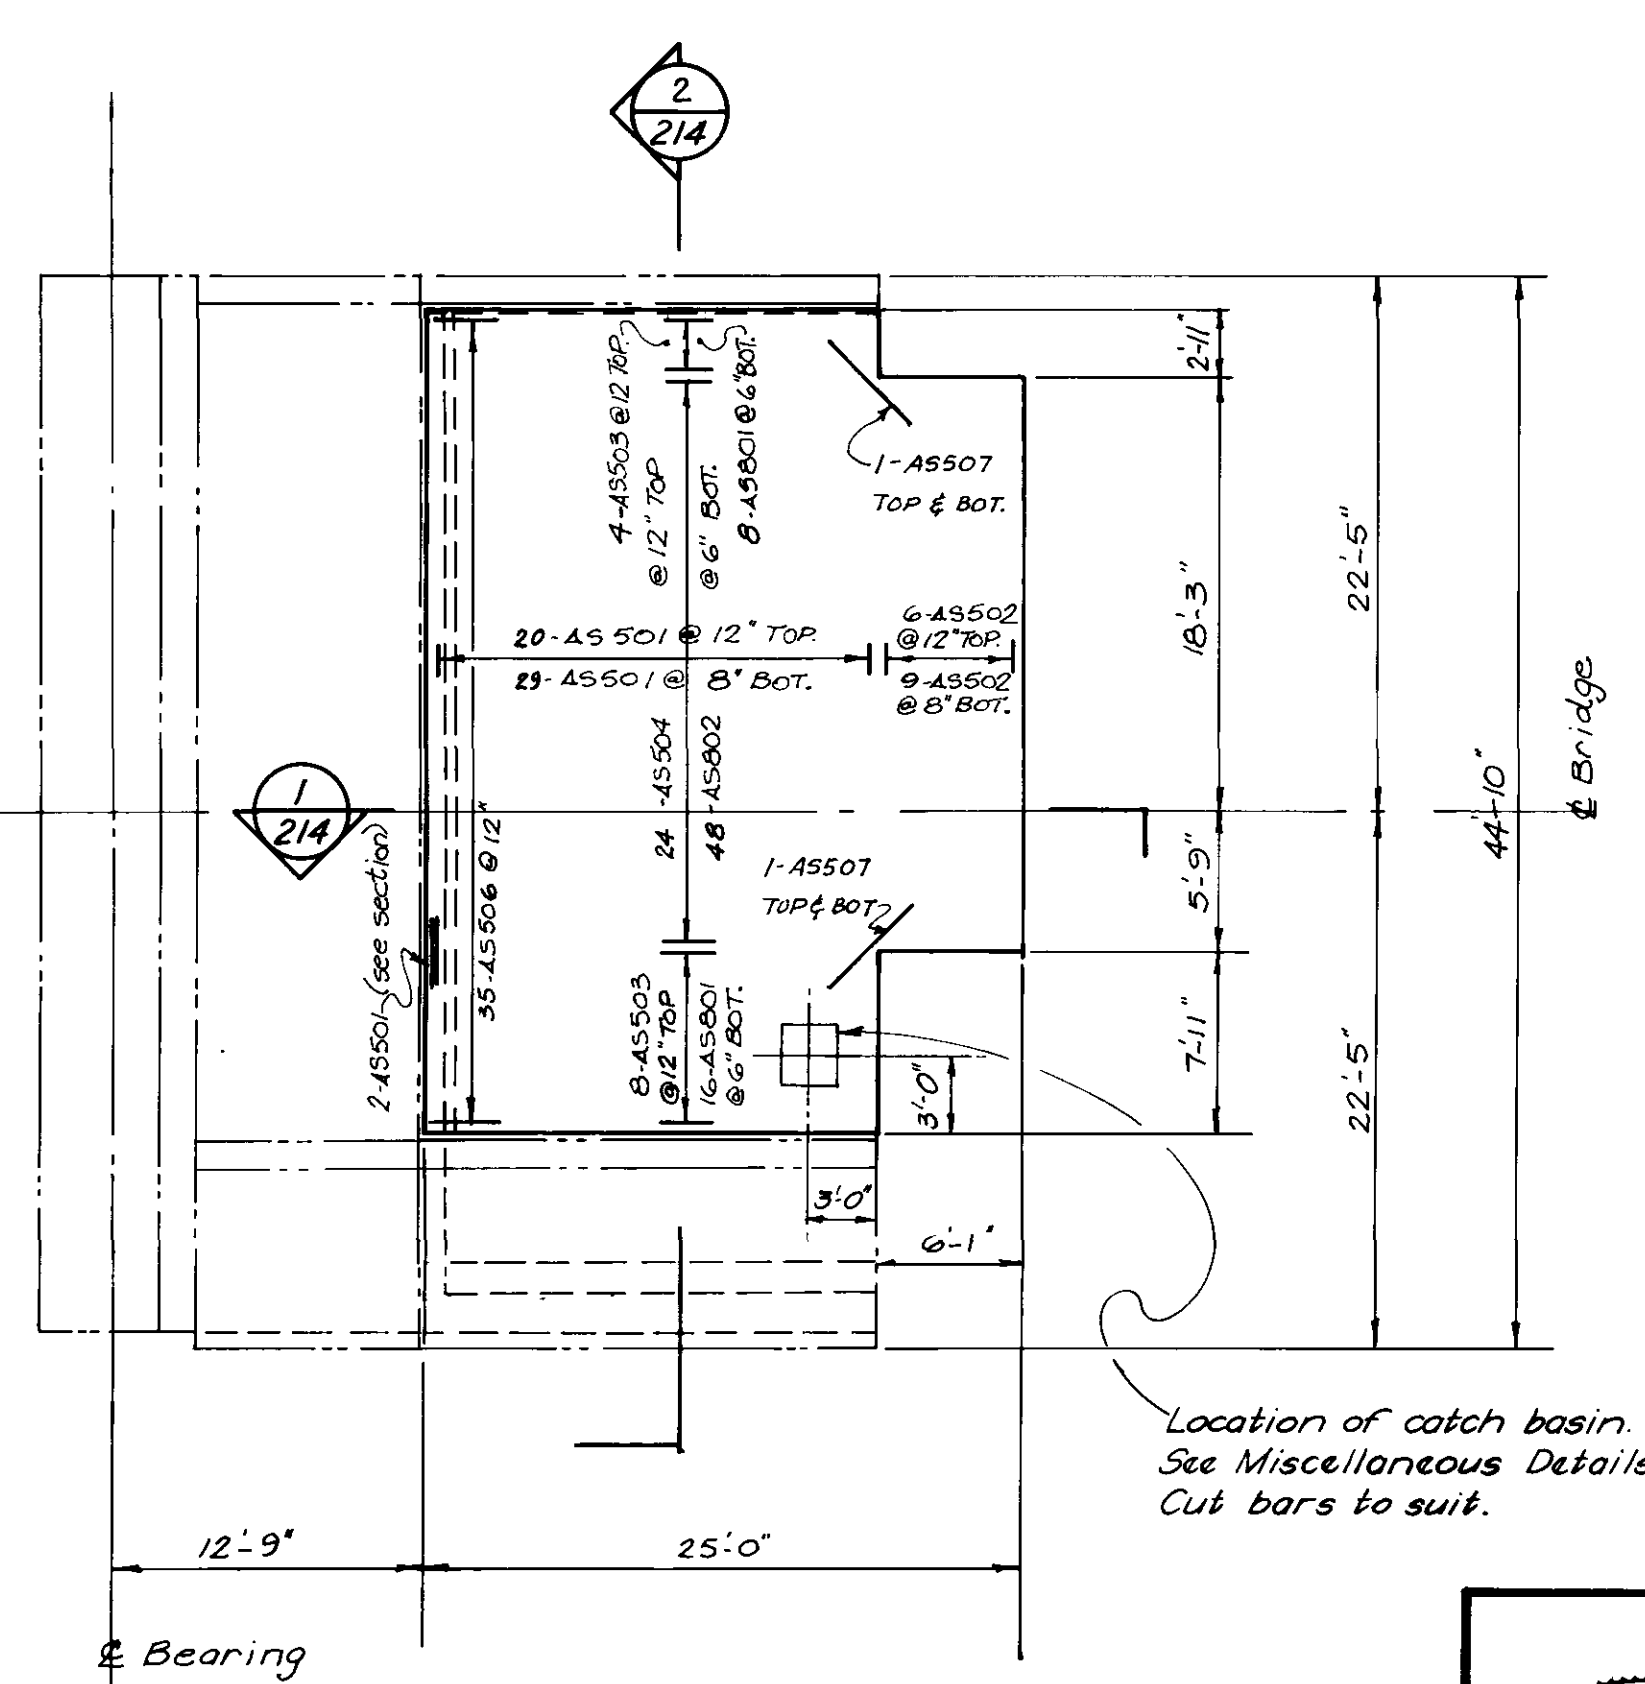


APPROACH SLAB EAST ABUTMENT
Scale 1/8" = 1'-0"


SOUTH BRIDGE

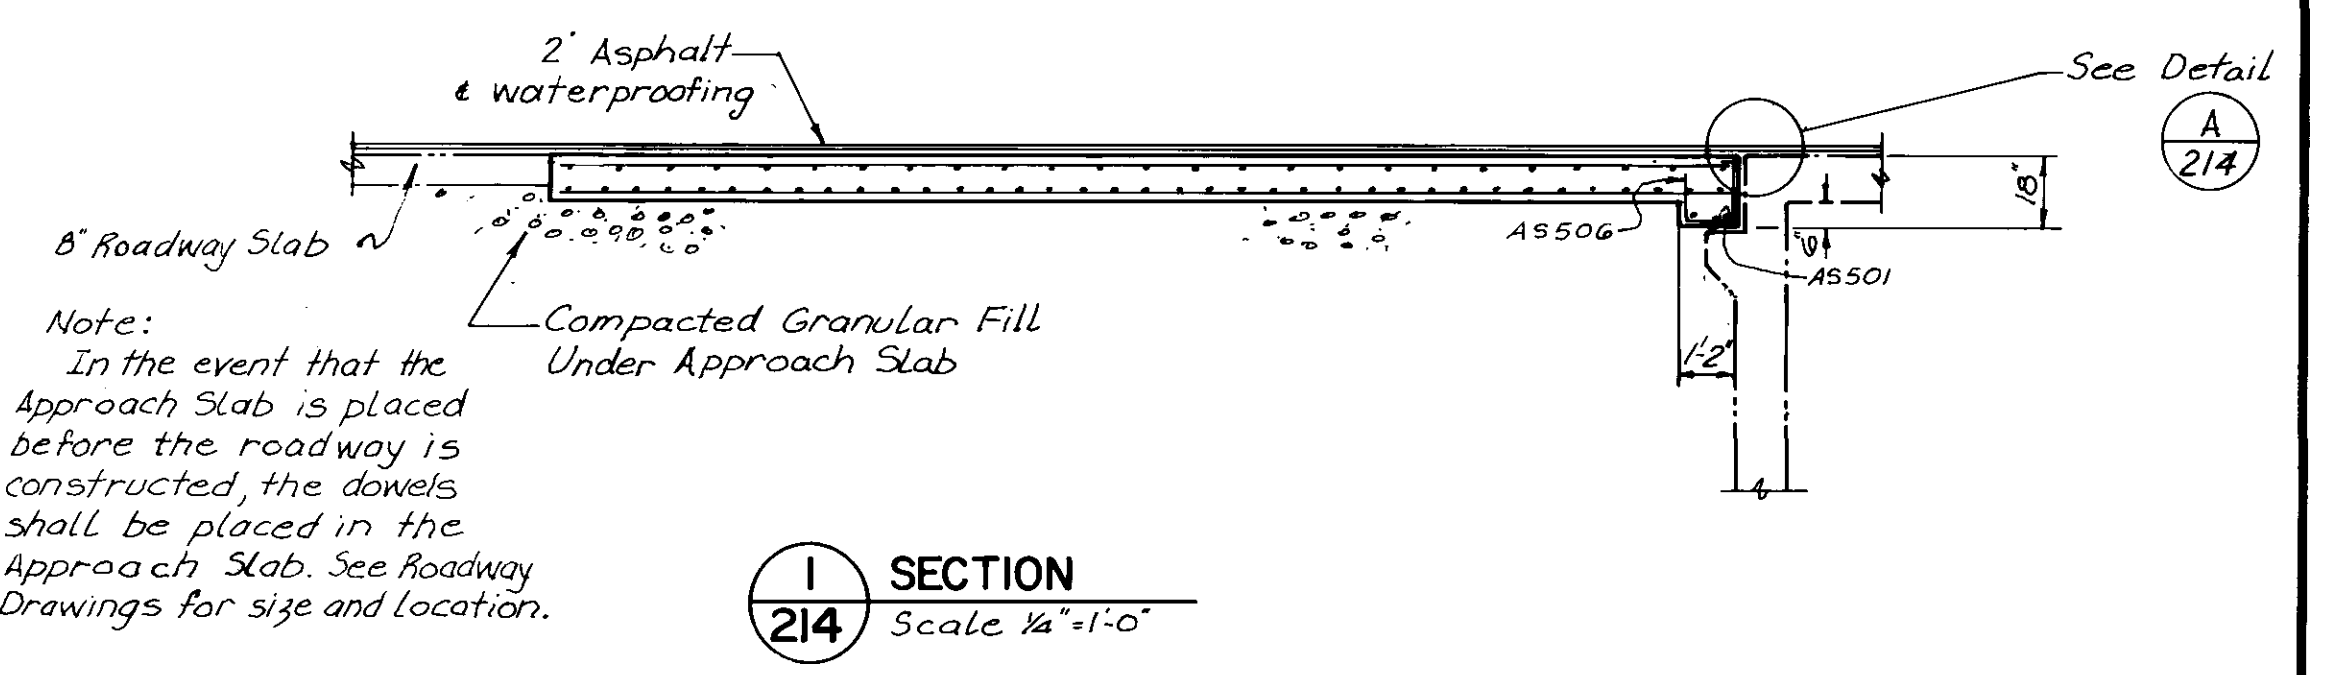


I SECTION
214 Scale 1/4" = 1'-0"

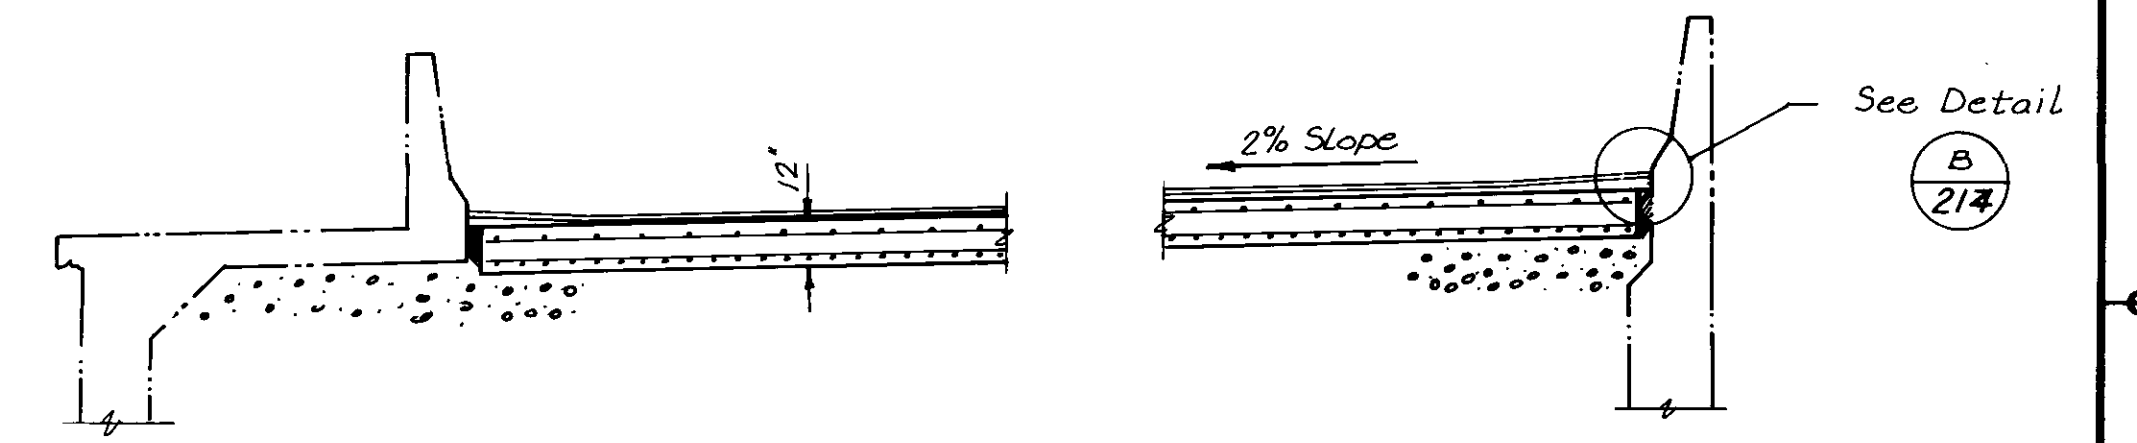

2 SECTION
214 Scale 1/4" = 1'-0"

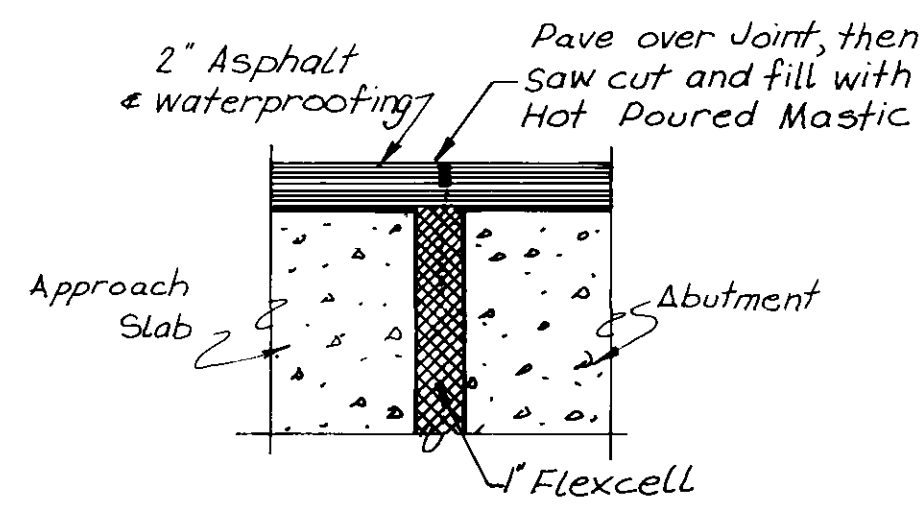


A DETAIL
214 Scale 3" = 1'-0"

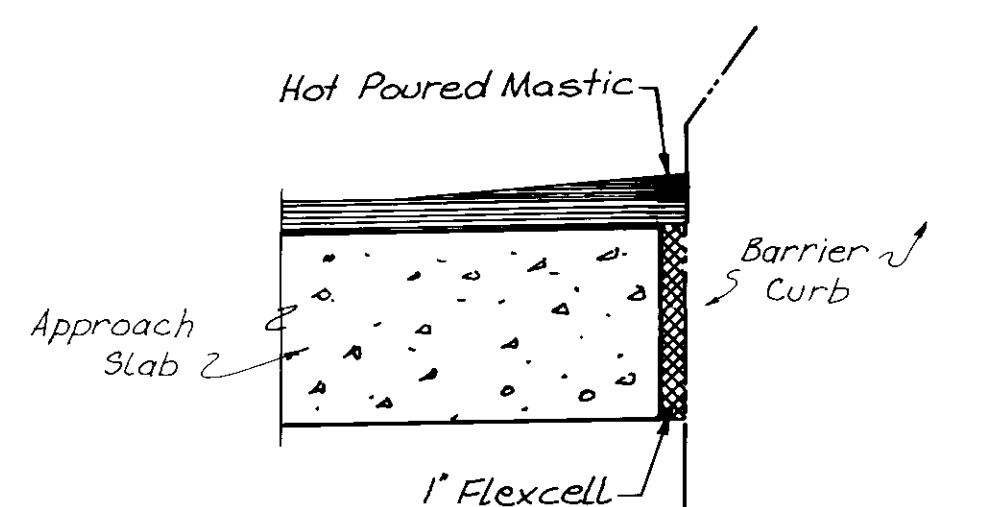


B DETAIL
214 Scale 1 1/2" = 1'-0"

AS - BUILT		
DATE	FB. NO.	PAGE
Nov. 16/77		

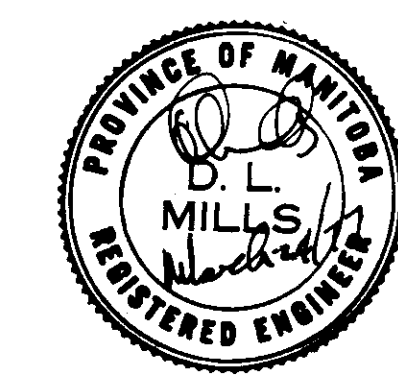


0	ISSUED FOR TENDER	4-4-77
NO	REVISIONS	DATE BY

	THE CITY OF WINNIPEG WORKS & OPERATIONS DEPARTMENT STREETS & TRANSPORTATION DIVISION	ROUTE 165
	W.L. WARDROP & ASSOCIATES LTD. ENGINEERING CONSULTANTS WINNIPEG, THUNDER BAY, REGINA, SASKATOON	APPROACH SLAB DETAILS
APPROVED BY: <i>D.L. Mills</i> DATE 25 MAR 77 DATE MAR 77 DESIGN B.J.R. PRELIM. CHK. STK. MAR 77 CHECK J.R.E.	APPROVED BY: <i>Joseph R. Campbell</i> DATE 25/3/77 MANAGER OF STREETS AND TRAFFIC	DRAWING NO. B-5092-214

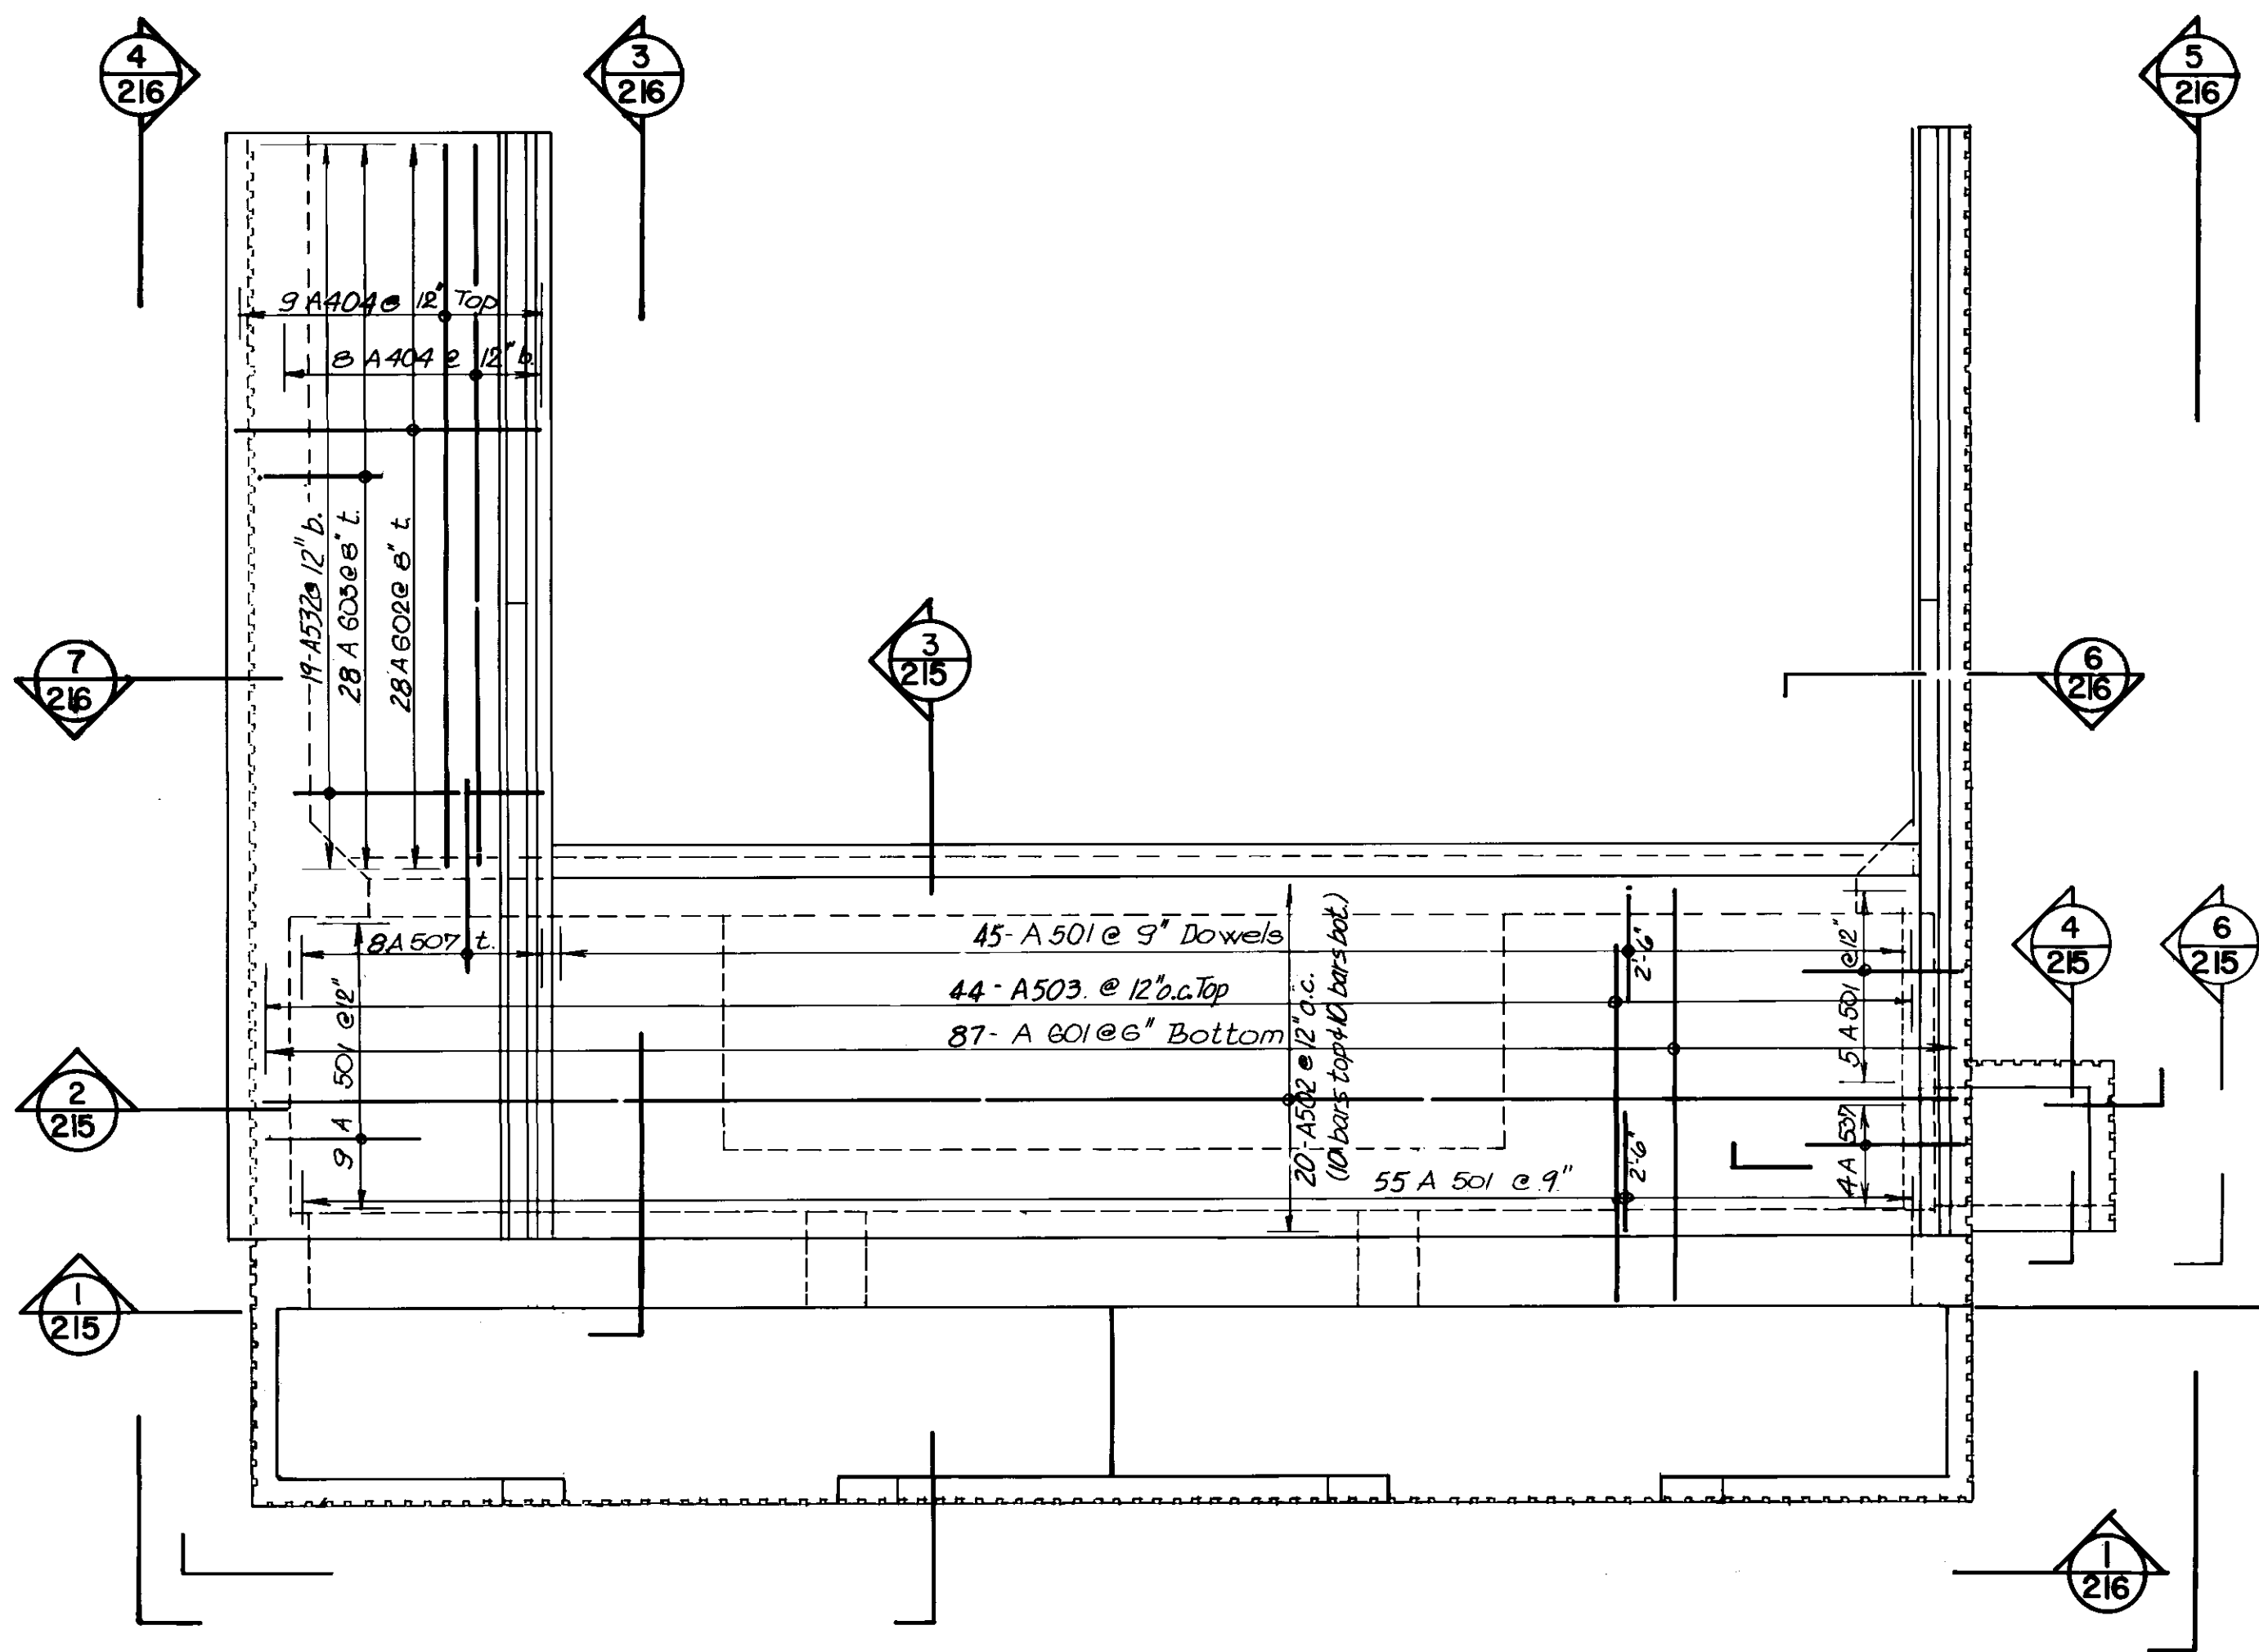


ABUTMENT PLAN
Scale: 1/4" = 1'-0"


35-A540 Stirrs Spaced as shown.
48-A541 Stirrs Spaced as shown

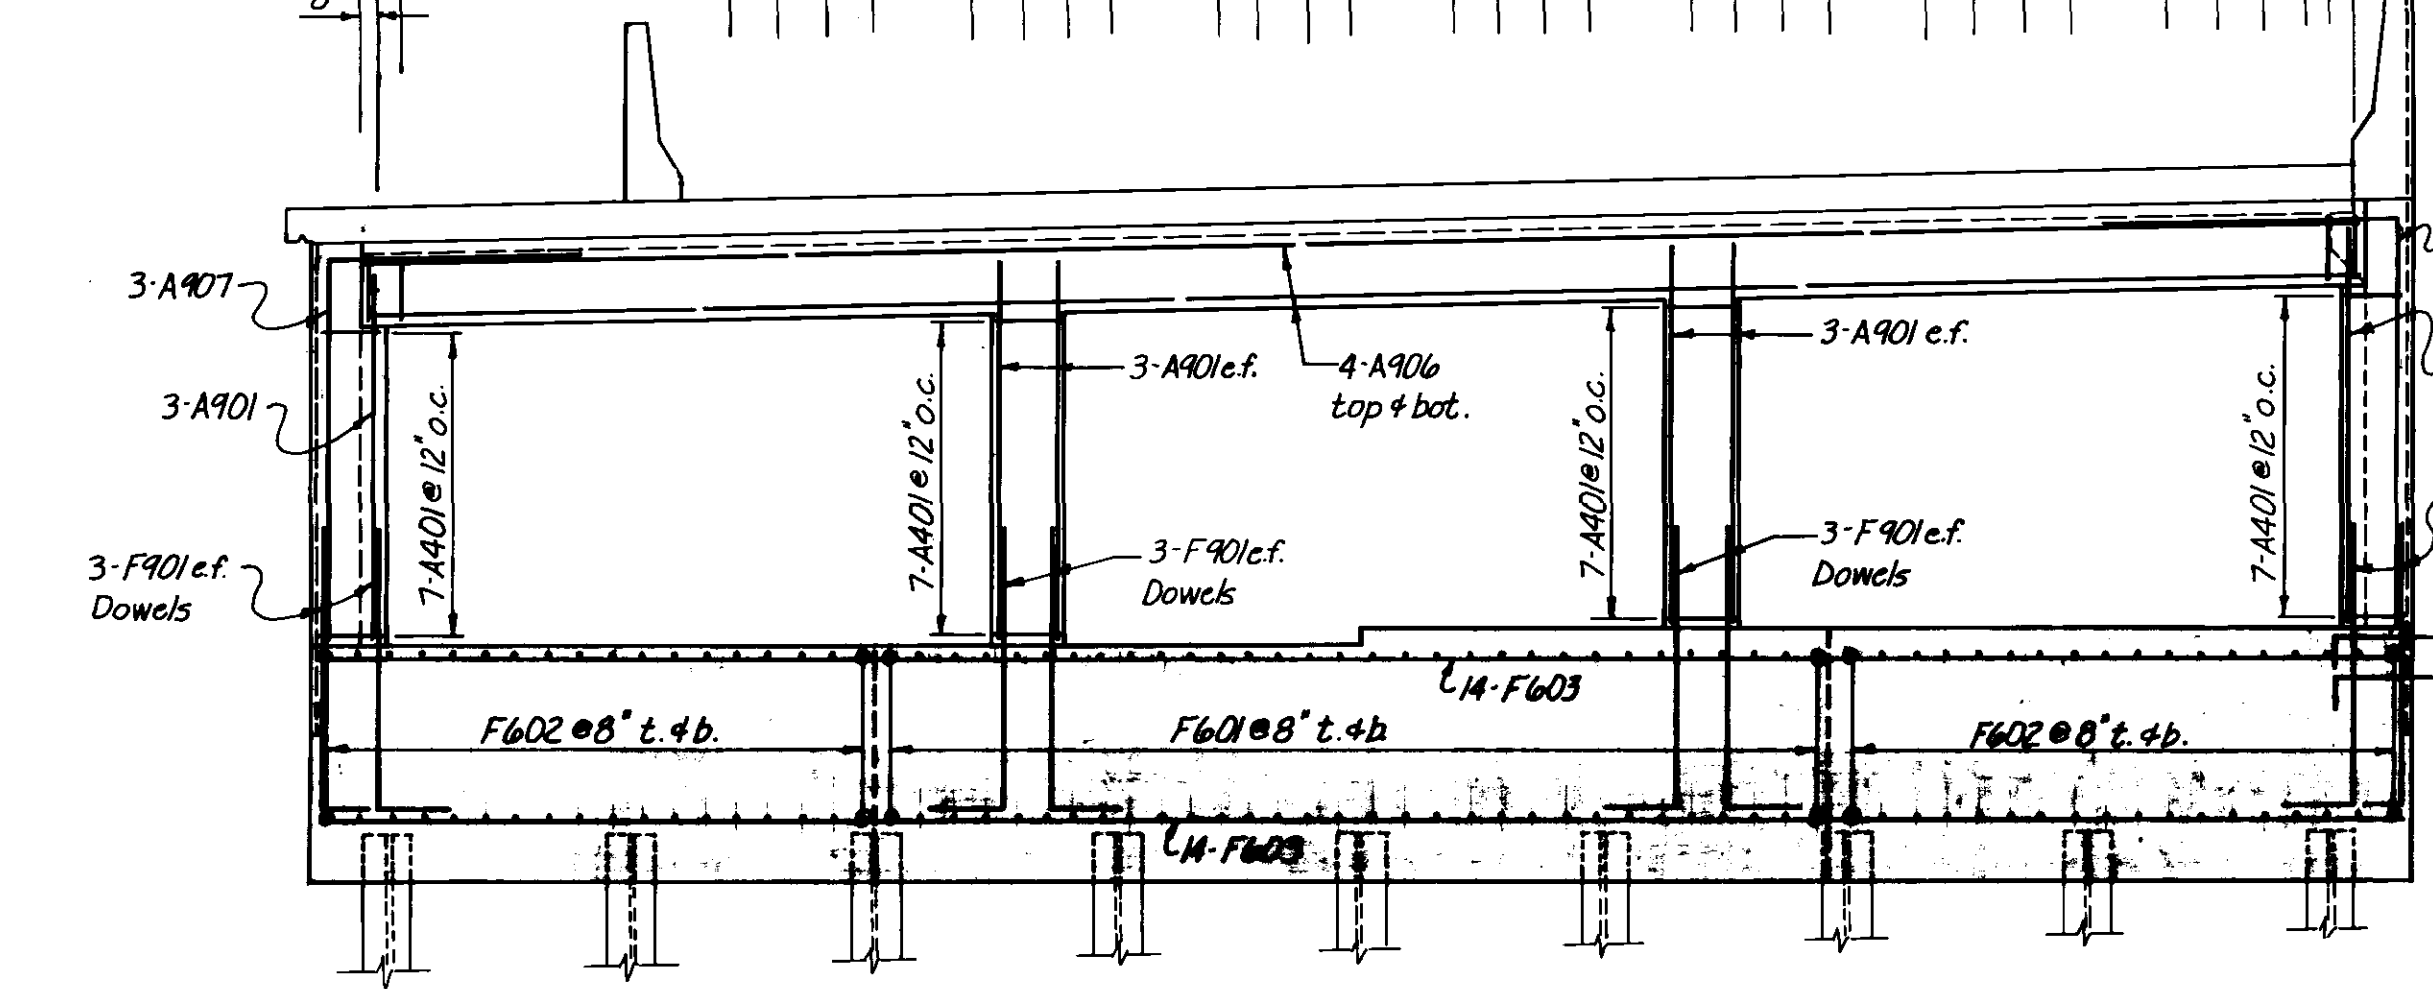


1 SECTION
215 Scale: 1/4" = 1'-0"

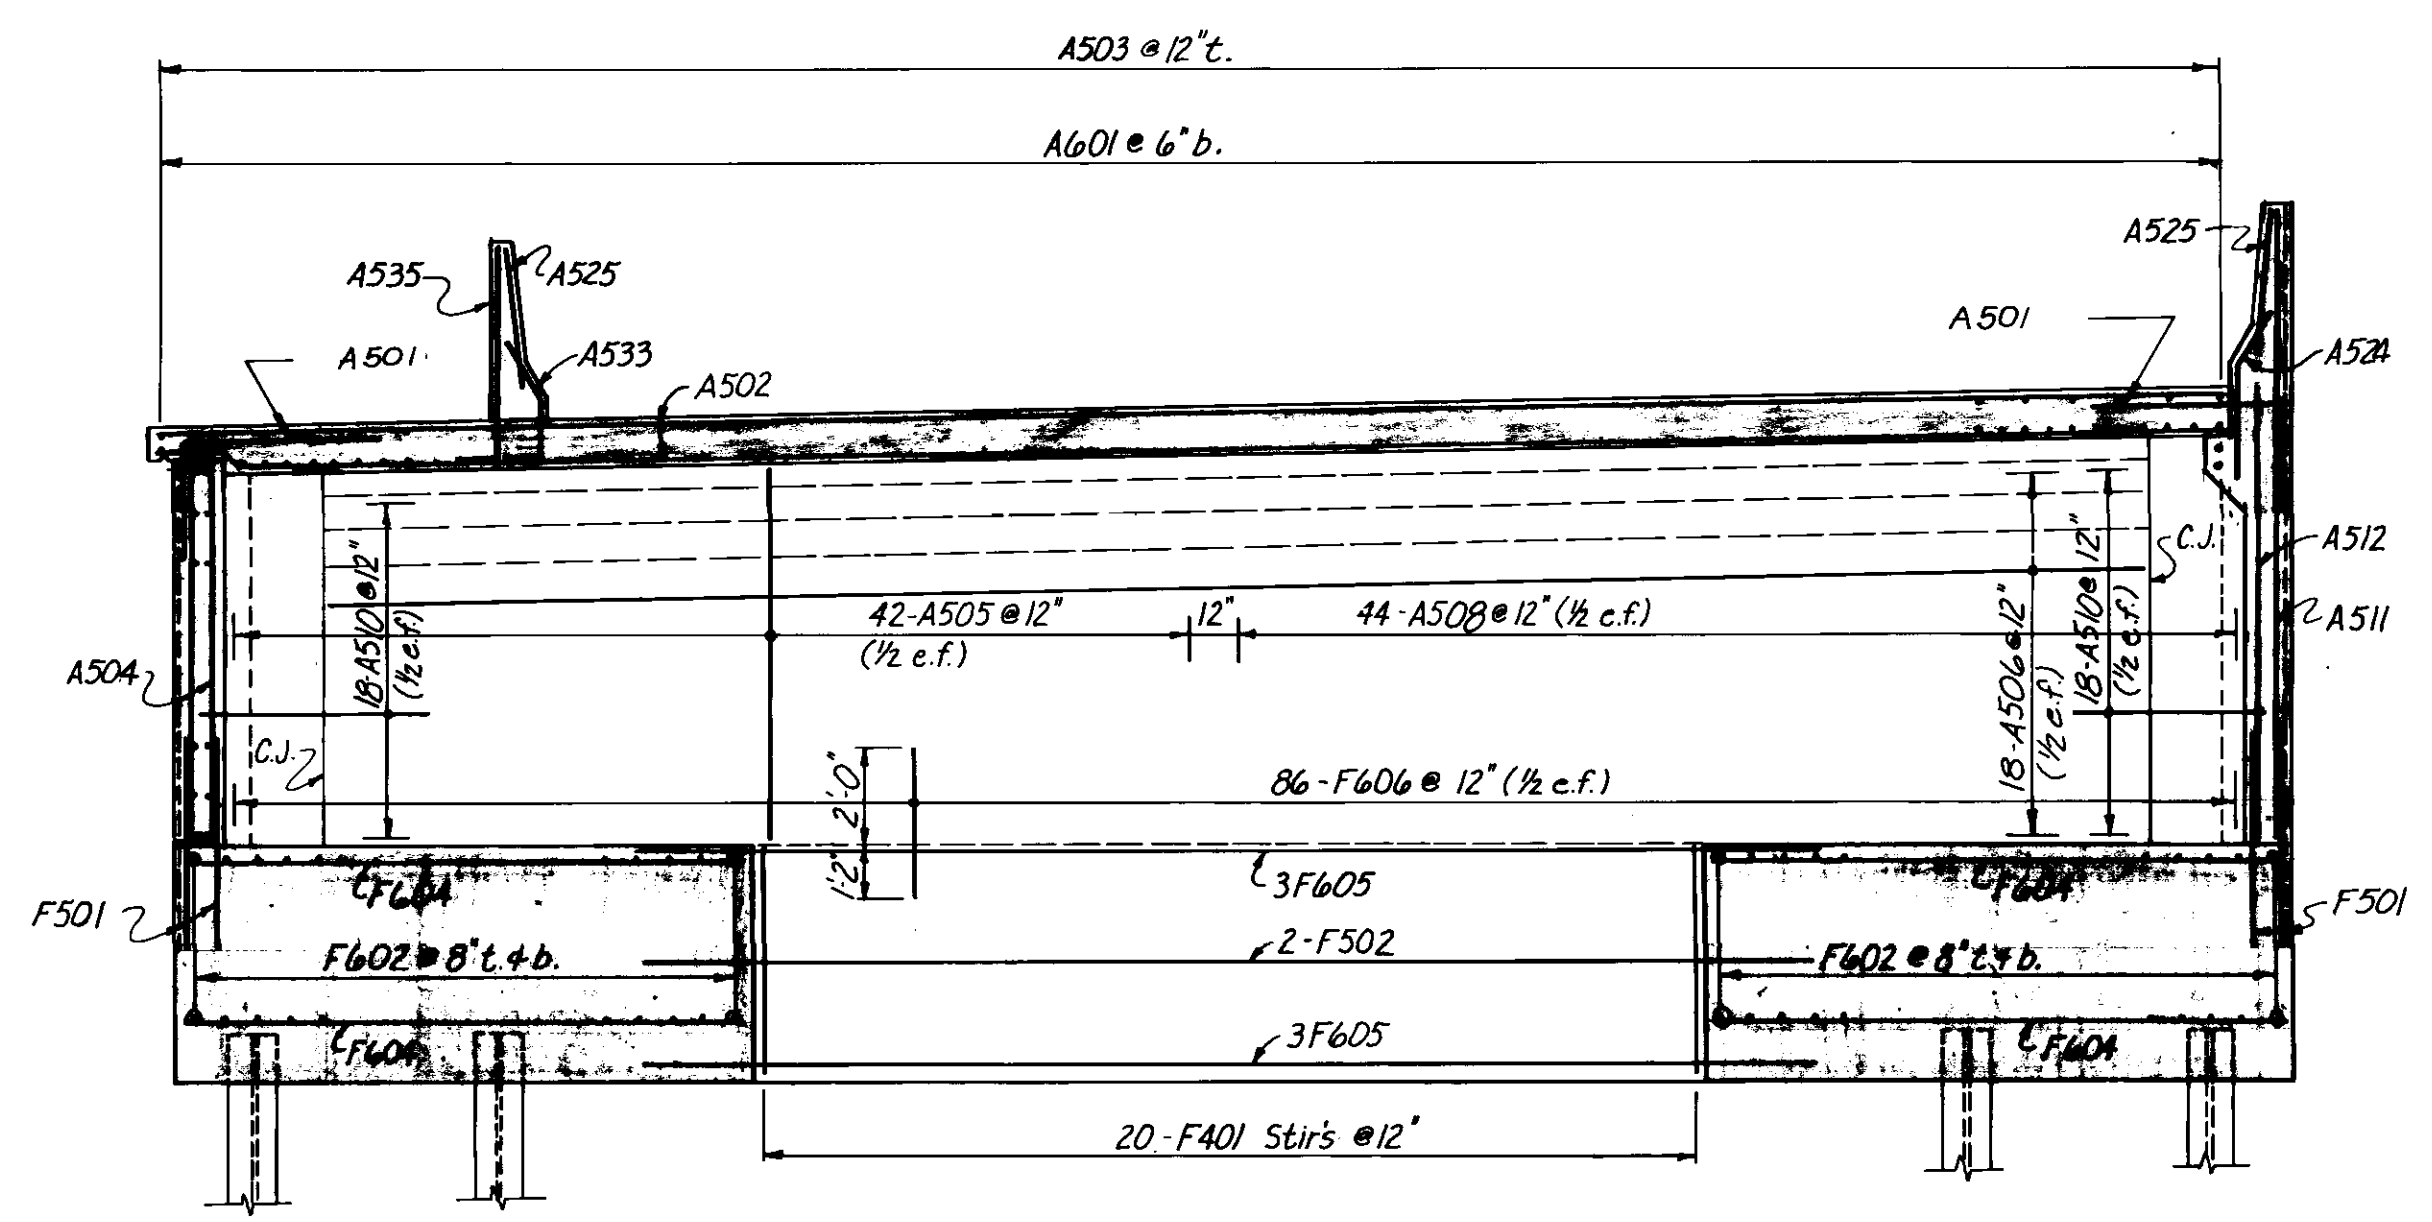


2 SECTION
215 Scale: 1/4" = 1'-0"

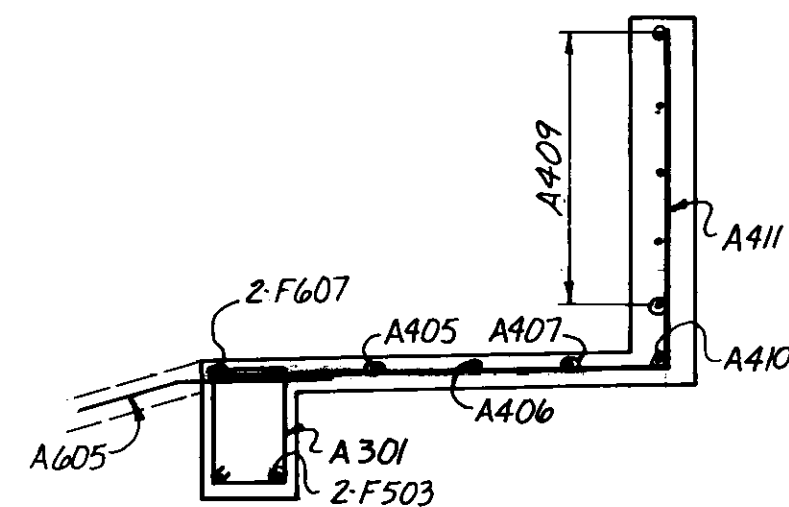


4 SECTION
215 Scale: 1/2" = 1'-0"

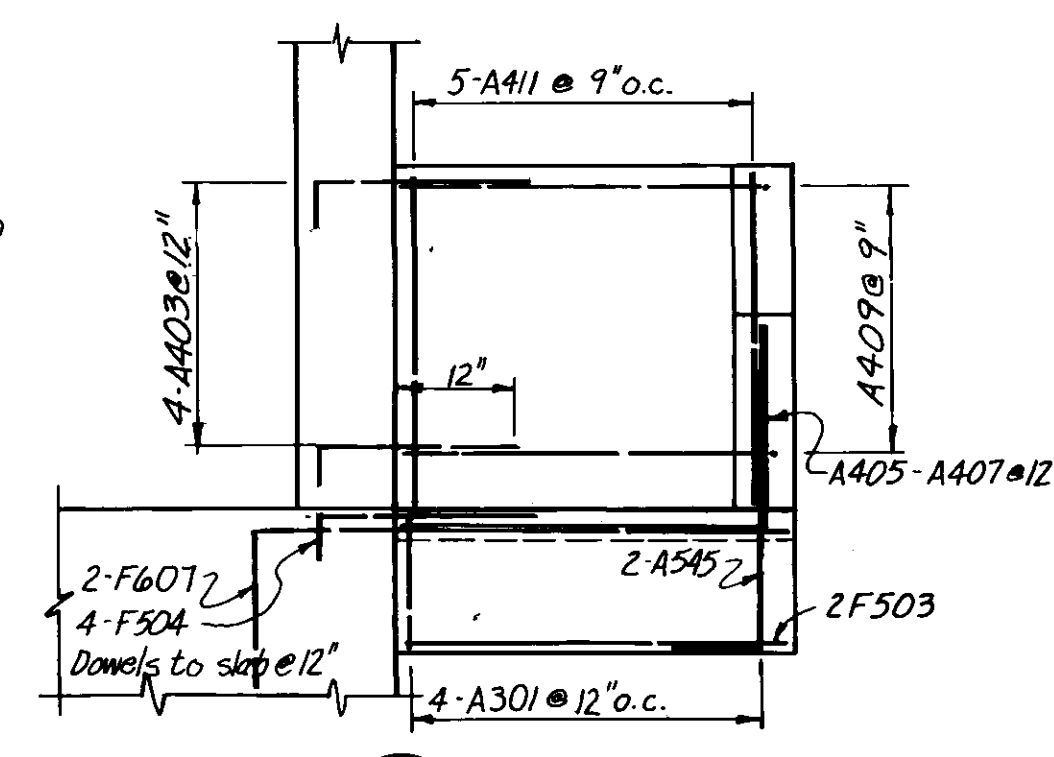

5 SECTION
215 Scale: 1/2" = 1'-0"

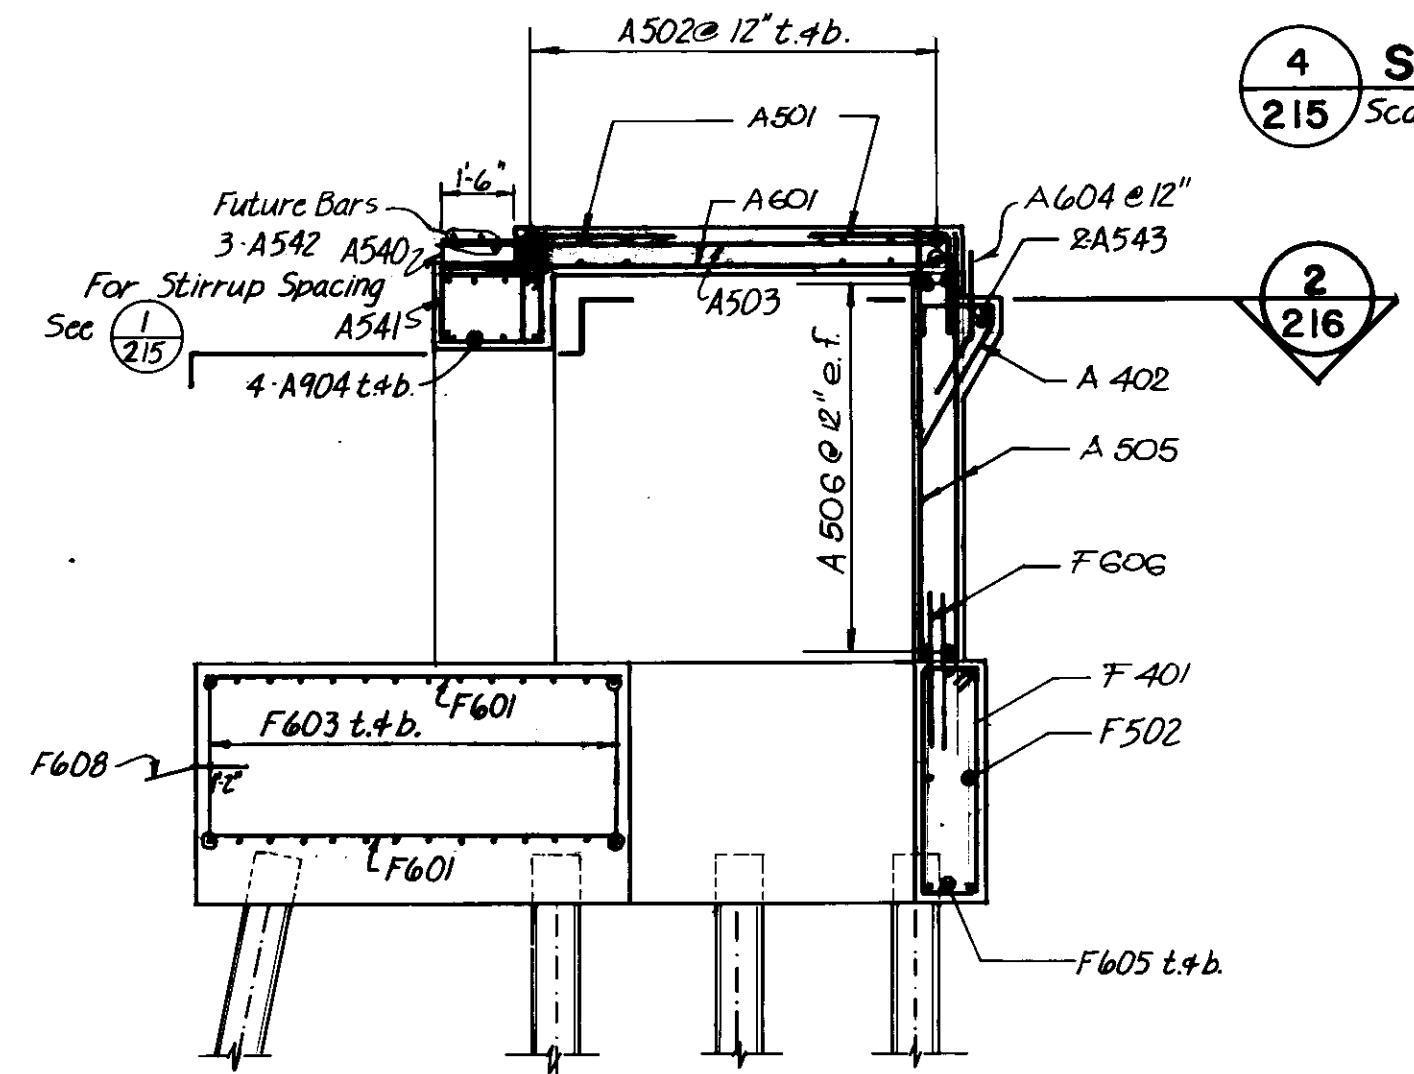


3 SECTION
215 Scale: 1/4" = 1'-0"

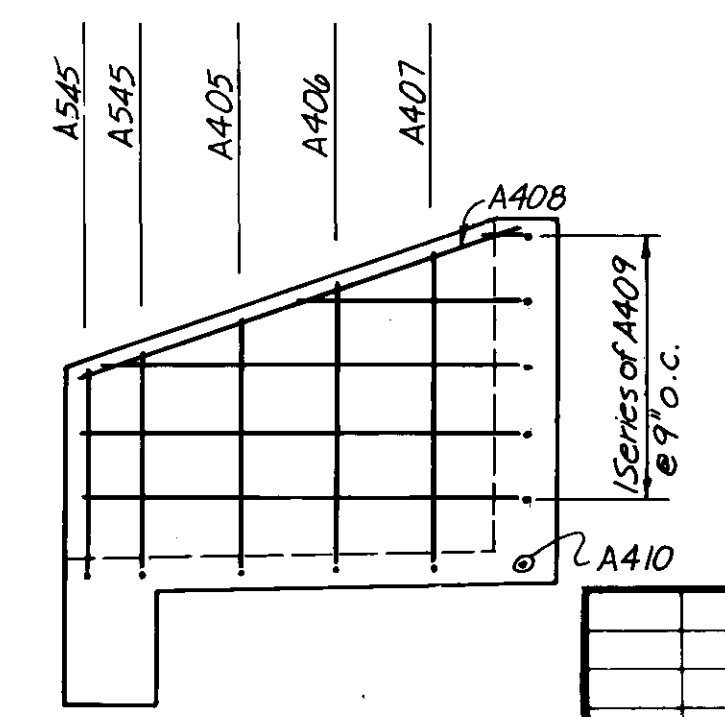

6 ELEVATION
215 Scale: 1/2" = 1'-0"

AS - BUILT		
DATE	FB NO	PAGE
Nov. 14/19		

ISSUED FOR TENDER		
NO	REVISIONS	DATE BY
0		4-4-77

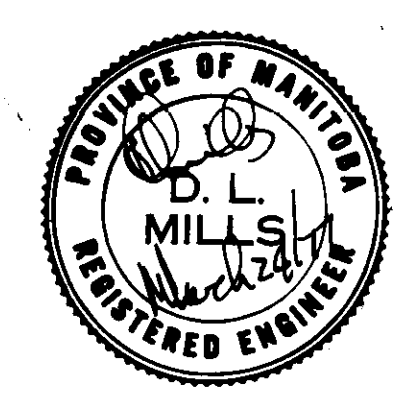

THE CITY OF WINNIPEG
WORKS & OPERATIONS DEPARTMENT
STREETS & TRANSPORTATION DIVISION

W.L. WARDROP & ASSOCIATES LTD.
ENGINEERING CONSULTANTS
WINNIPEG, THUNDER BAY, REGINA, BARRIE, EDMONTON


APPROVED BY: *[Signature]* DATE: 25 March 11
DRAWN BY: SIB DATE: 27 Feb 77
PRELIM. CHK. R.J.R. DATE: 27 Feb 77
DESIGN: B.J.R. DATE: 27 Feb 77
CHECK: J.R.E. DATE: 27 Feb 77

ROUTE 165
ABUTMENT REINFORCING DETAILS
SOUTH BRIDGE


SCALE: AS SHOWN
DRAWING NO. B-5092-215

APPROVED BY: *[Signature]* DATE: 25/2/22
MANAGER OF STREETS AND TRAFFIC


10 INCHES
19
18
17
16
15
14
13
12
11
10

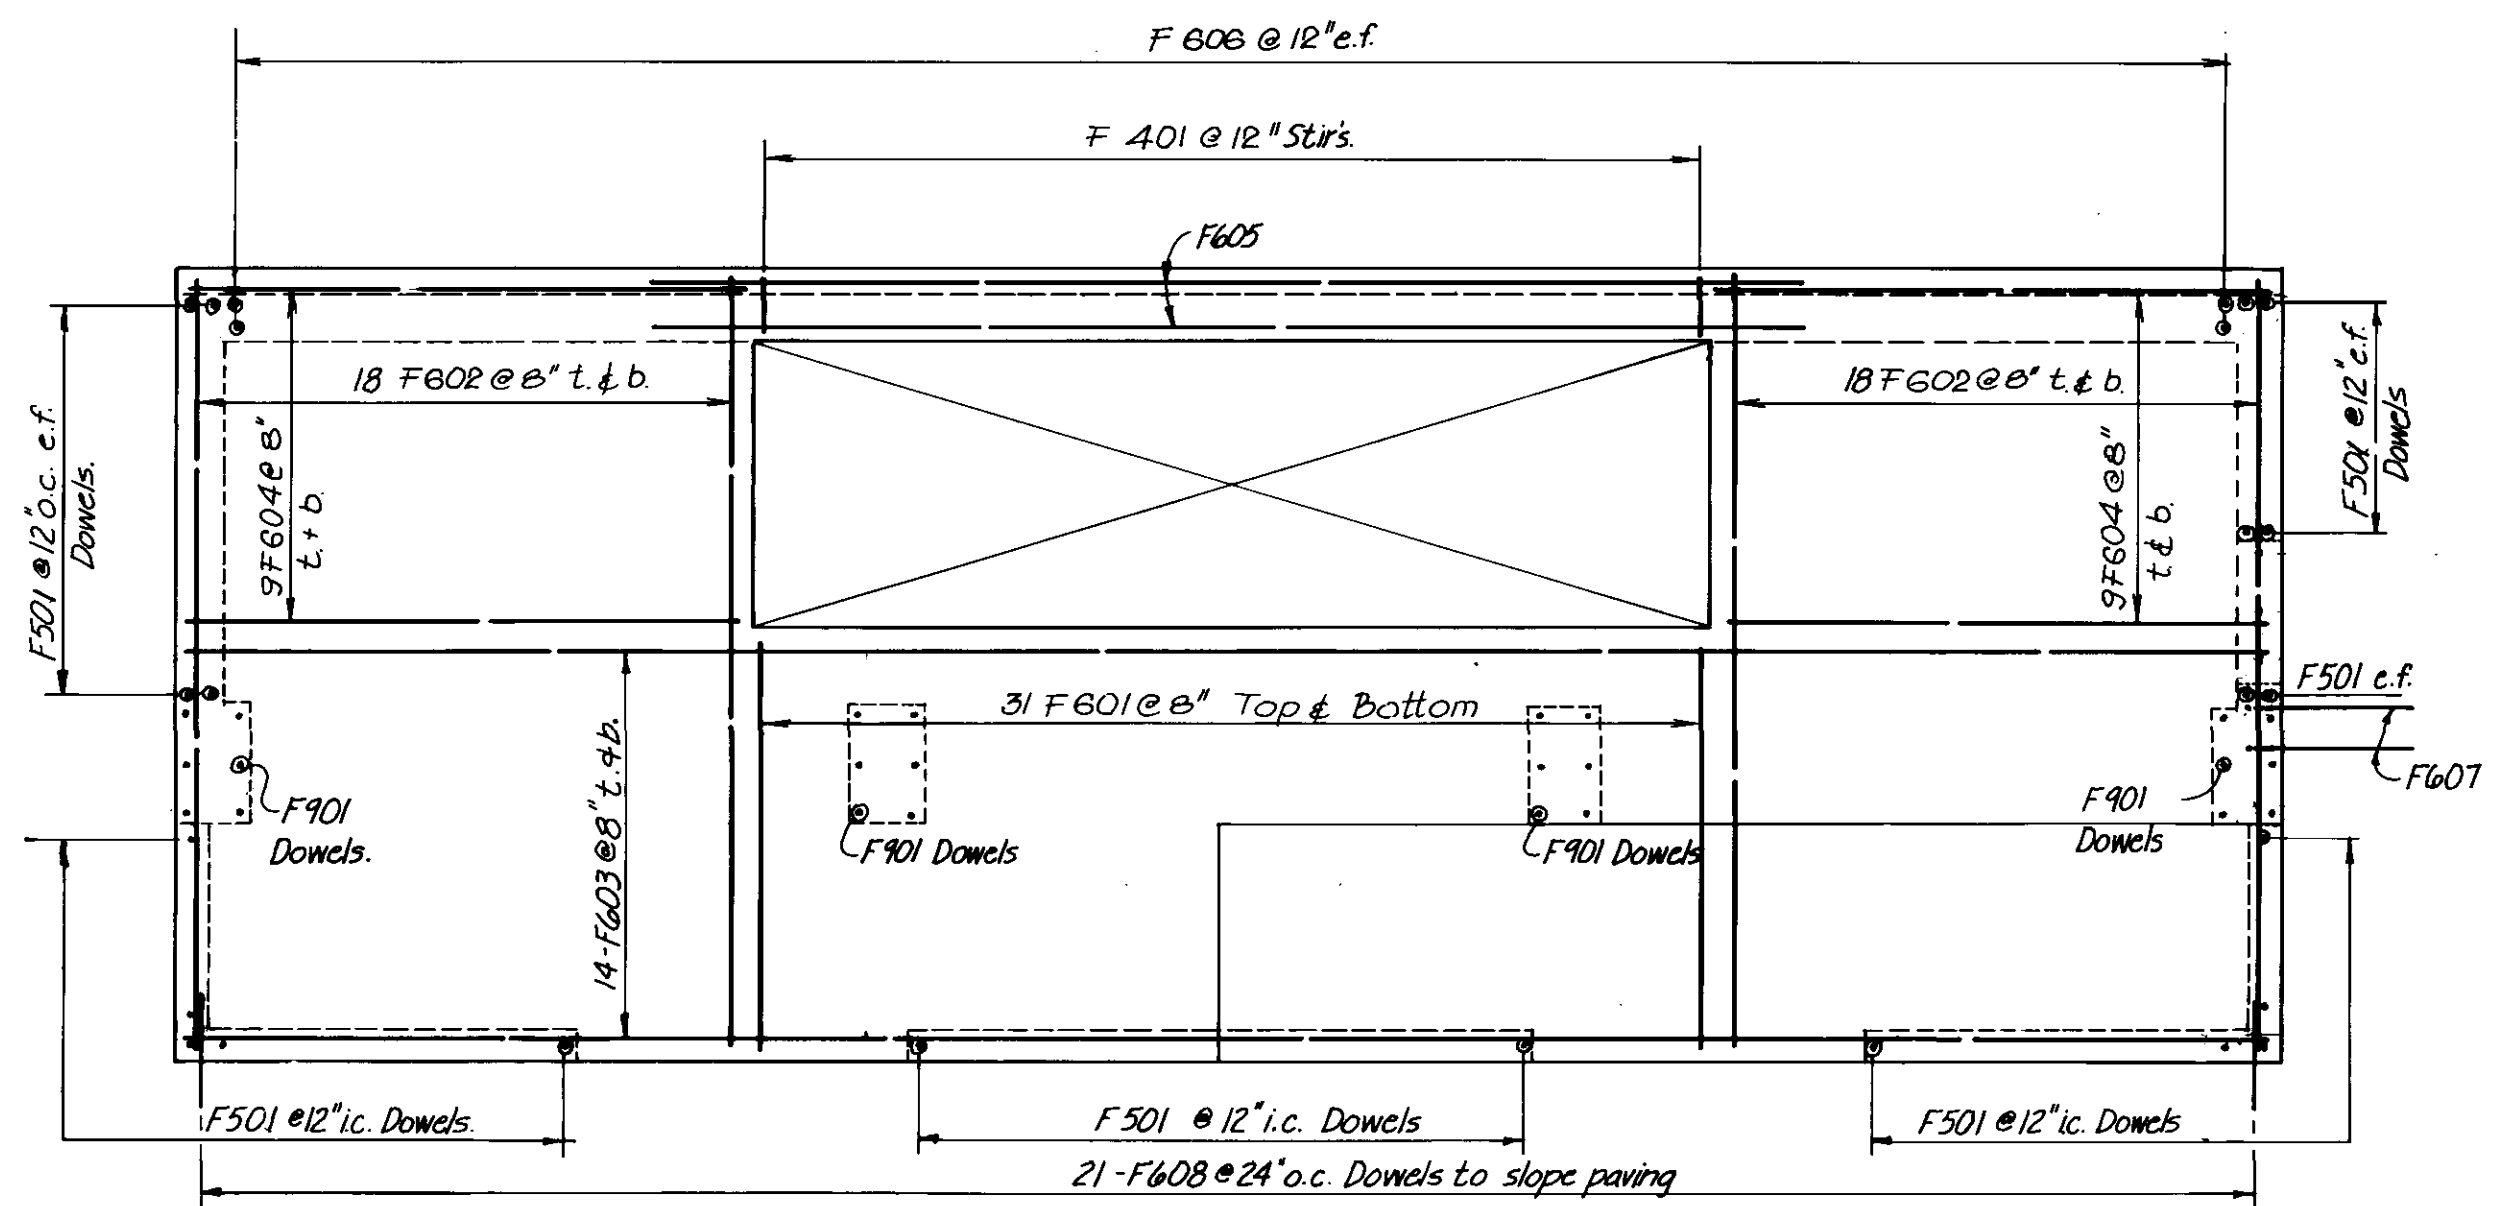


FOOTING PLAN
Scale: 1/4"=1'-0"

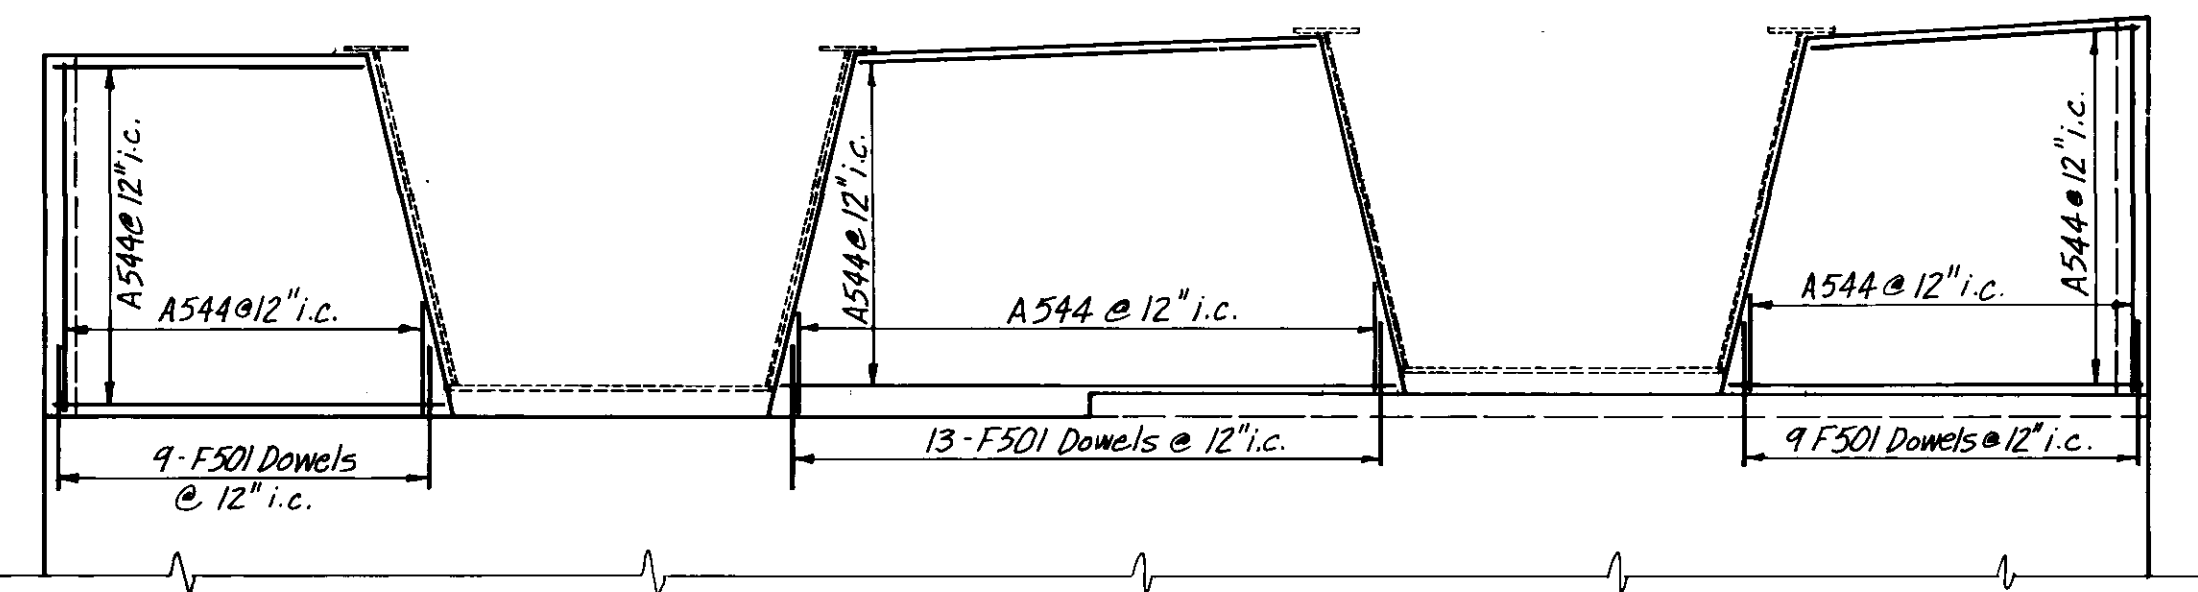


1 ELEVATION
216 Scale: 1/4"=1'-0"

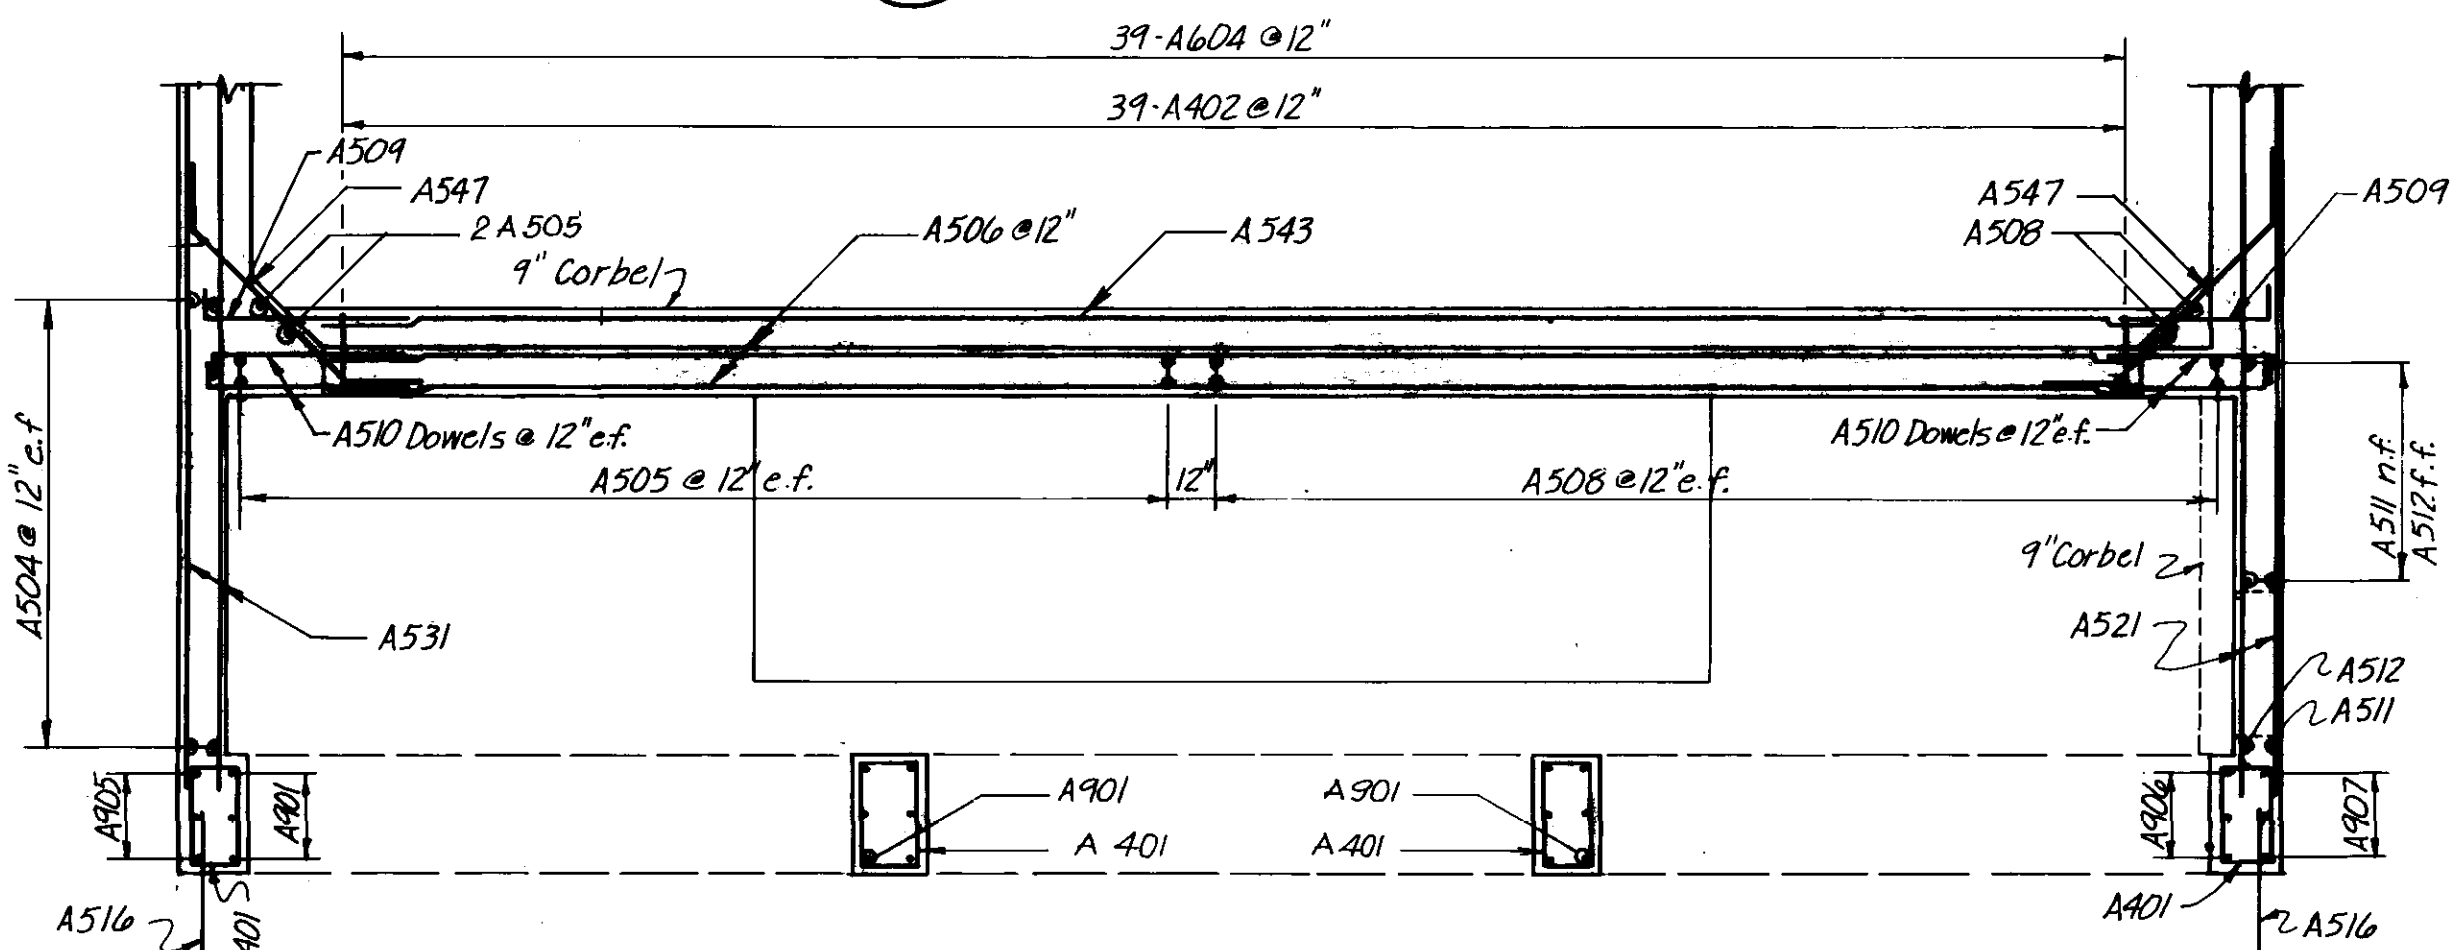


2 SECTION
216 Scale: 1/4"=1'-0"

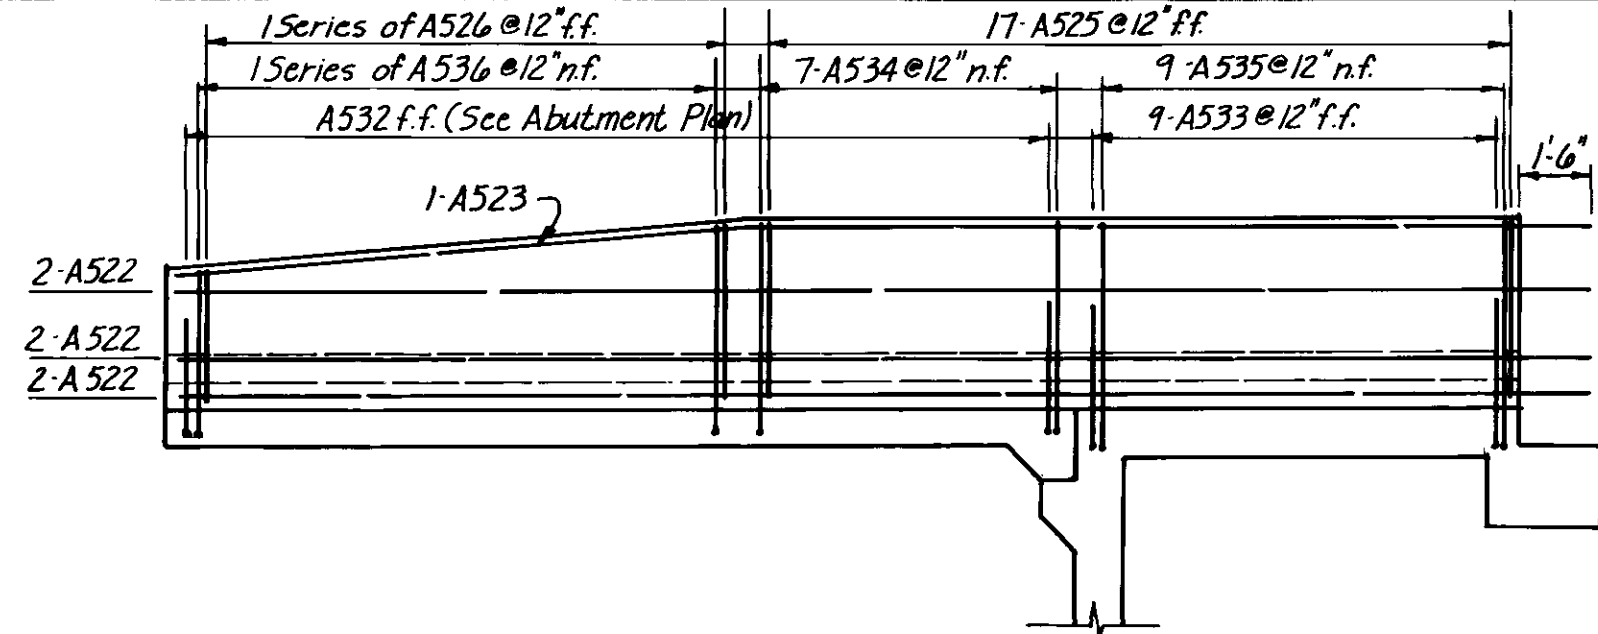


3 SECTION
216 Scale: 1/4"=1'-0"

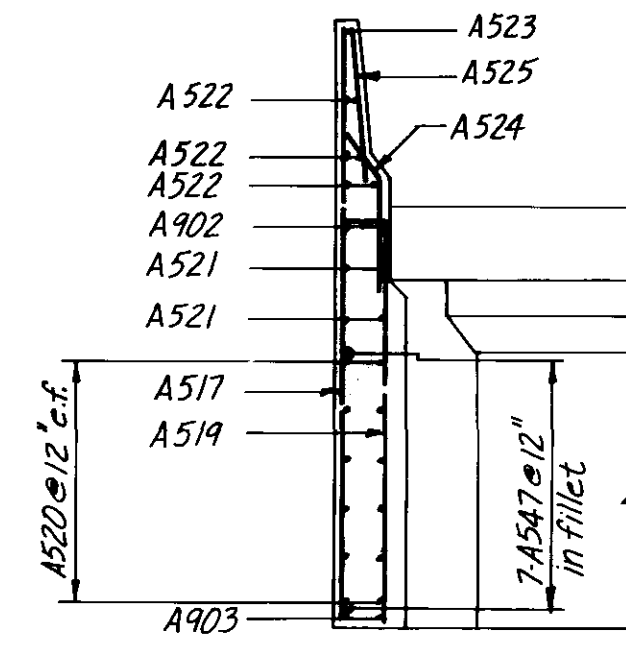


6 SECTION
216 Scale: 1/4"=1'-0"

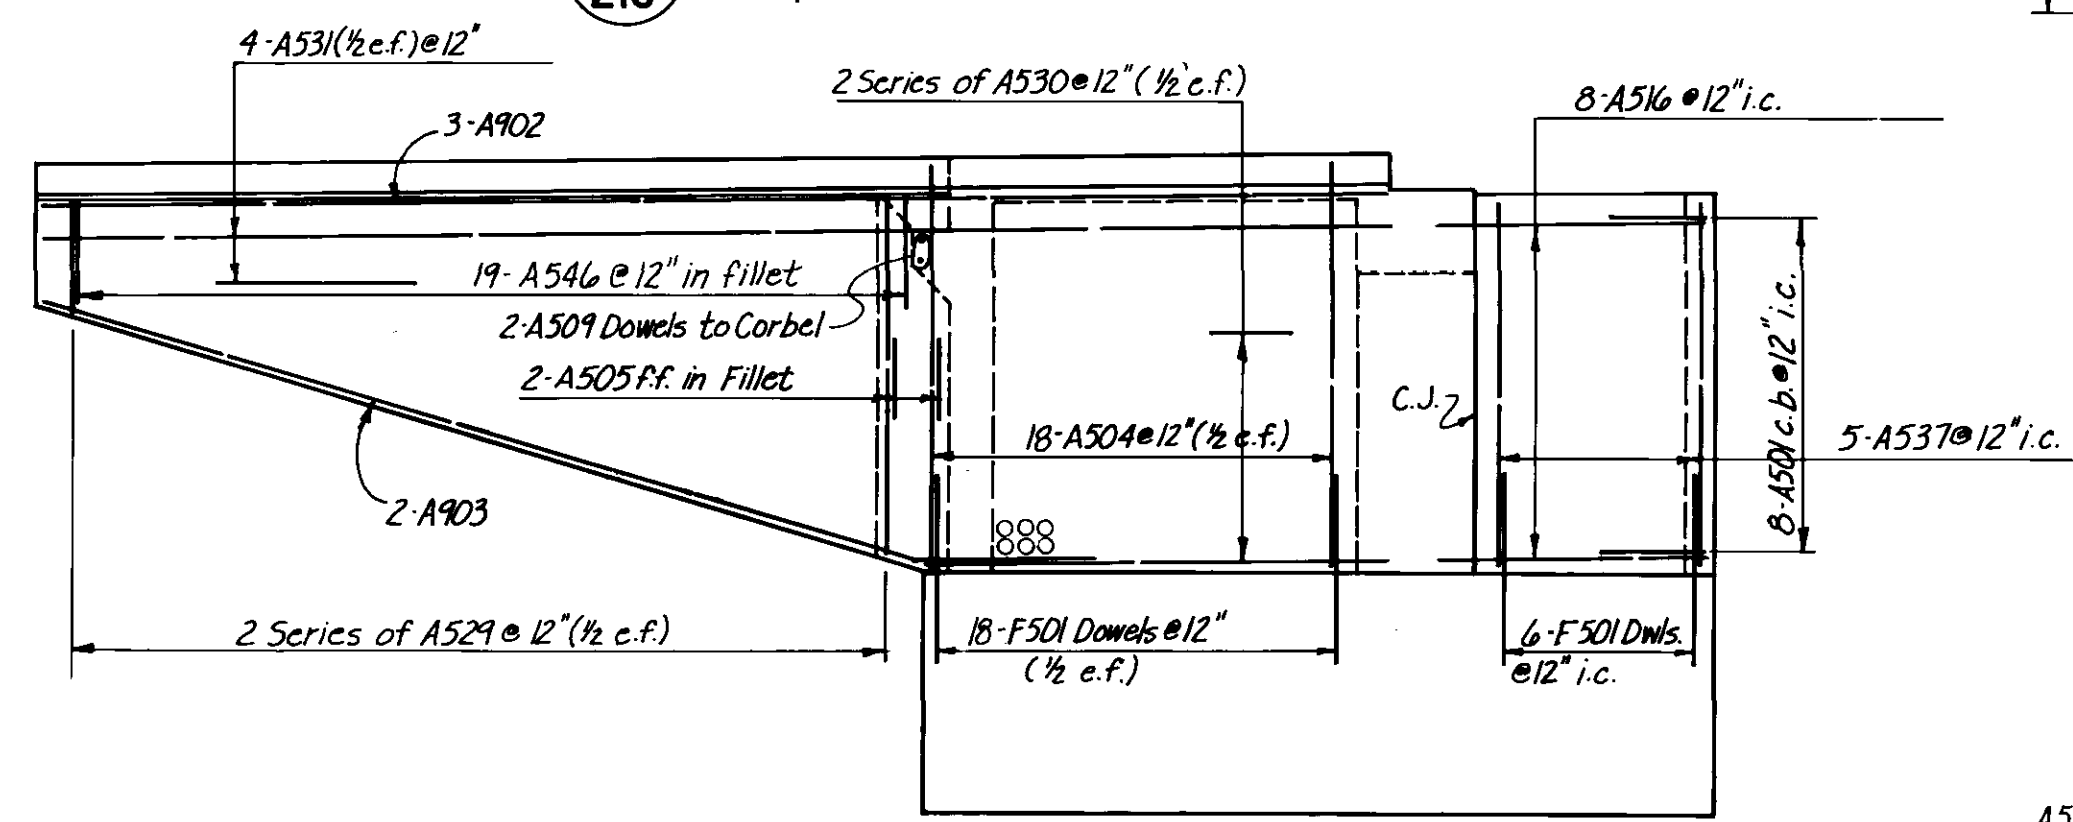


4 ELEVATION
216 Scale: 1/4"=1'-0"

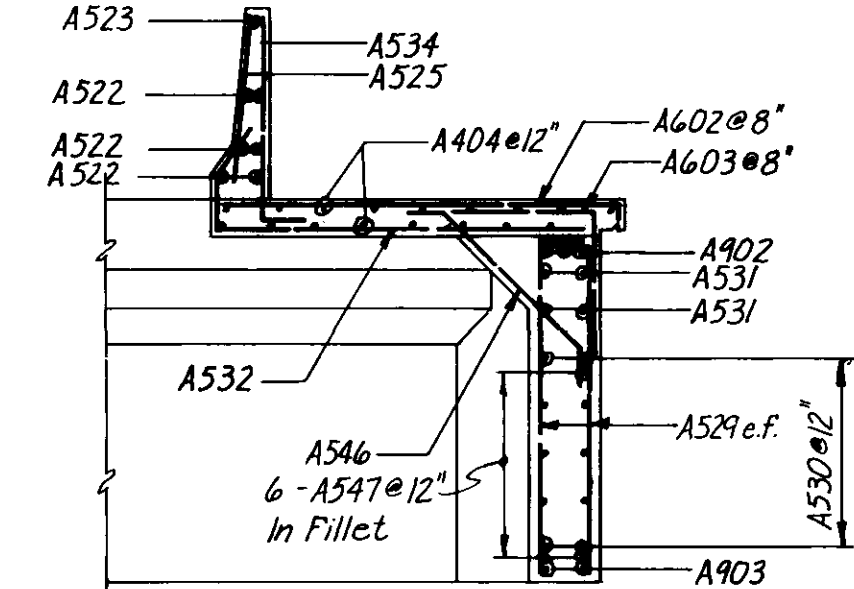

7 SECTION
216 Scale: 1/4"=1'-0"

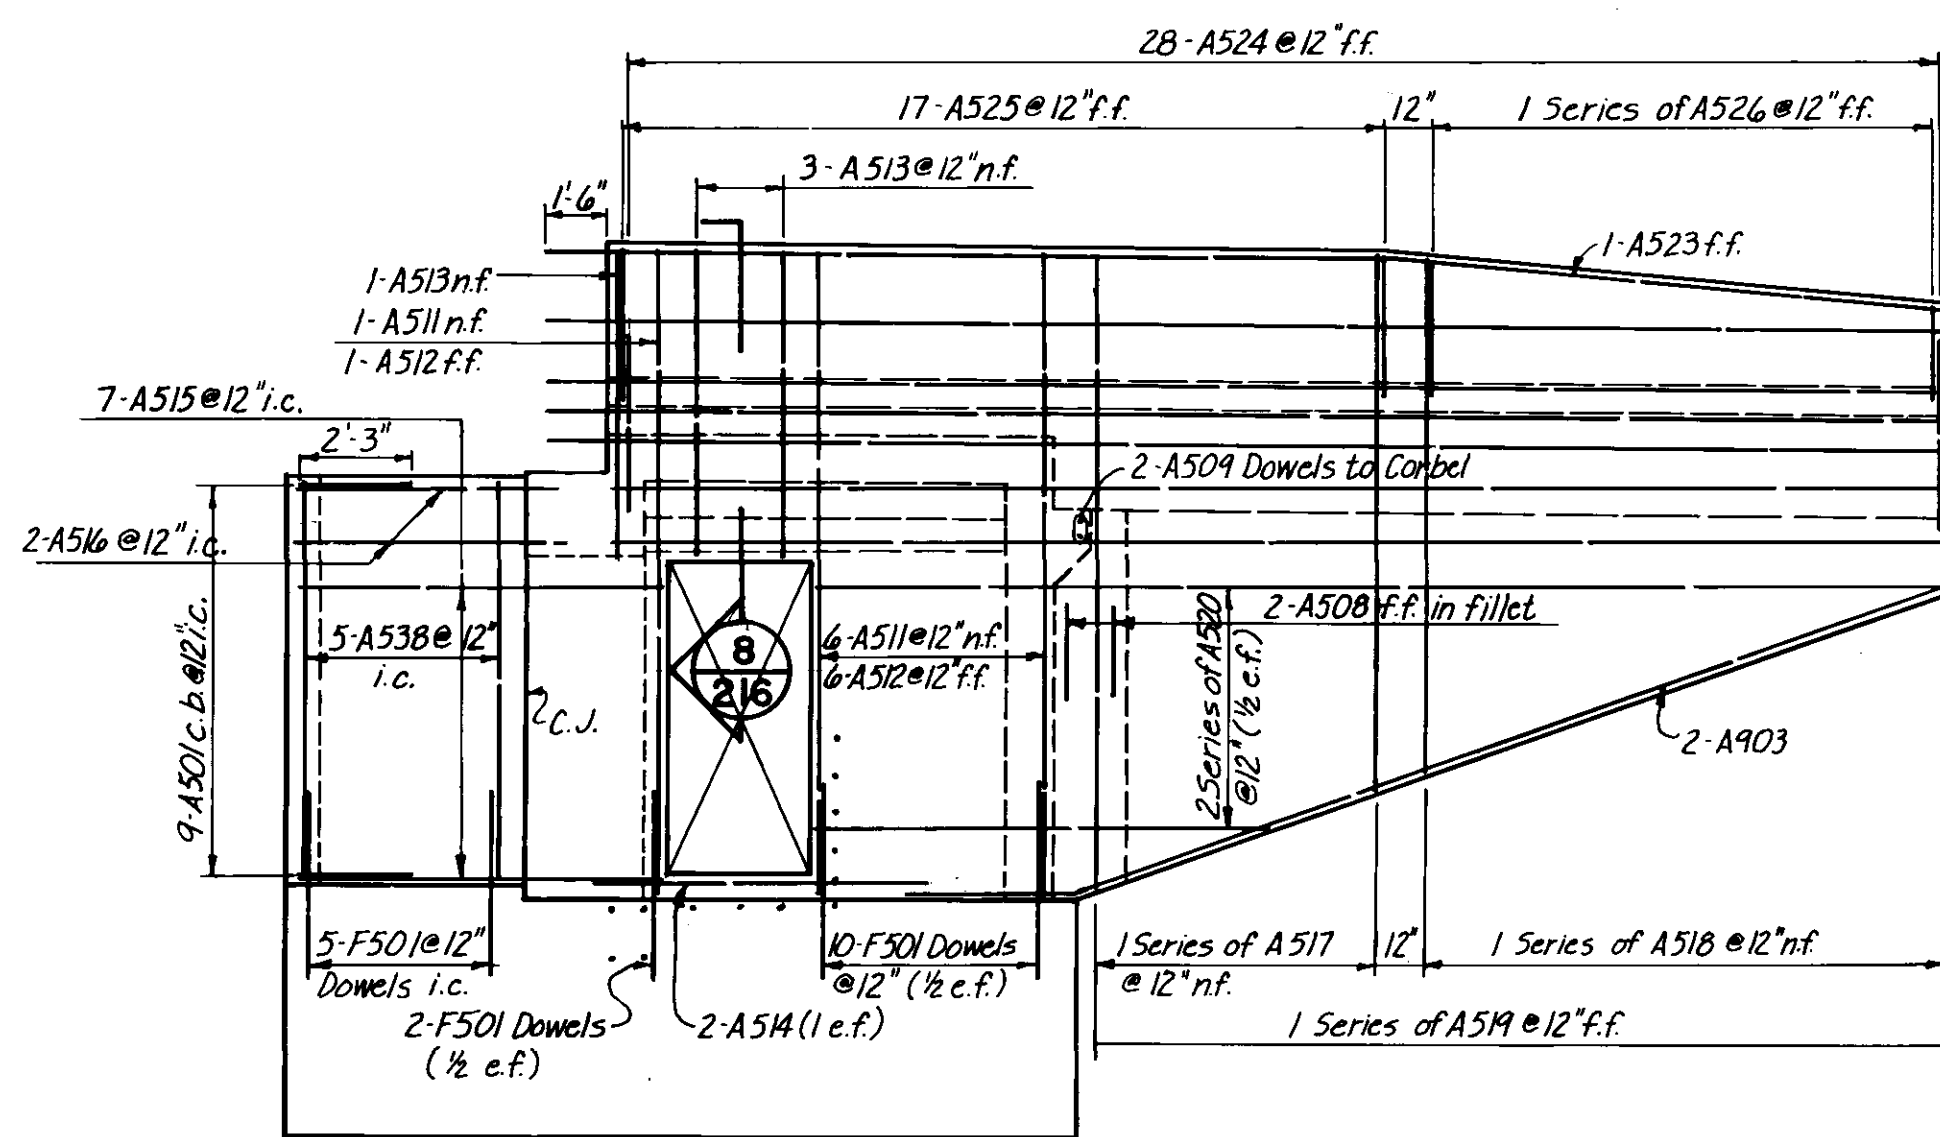


5 ELEVATION
216 Scale: 1/4"=1'-0"

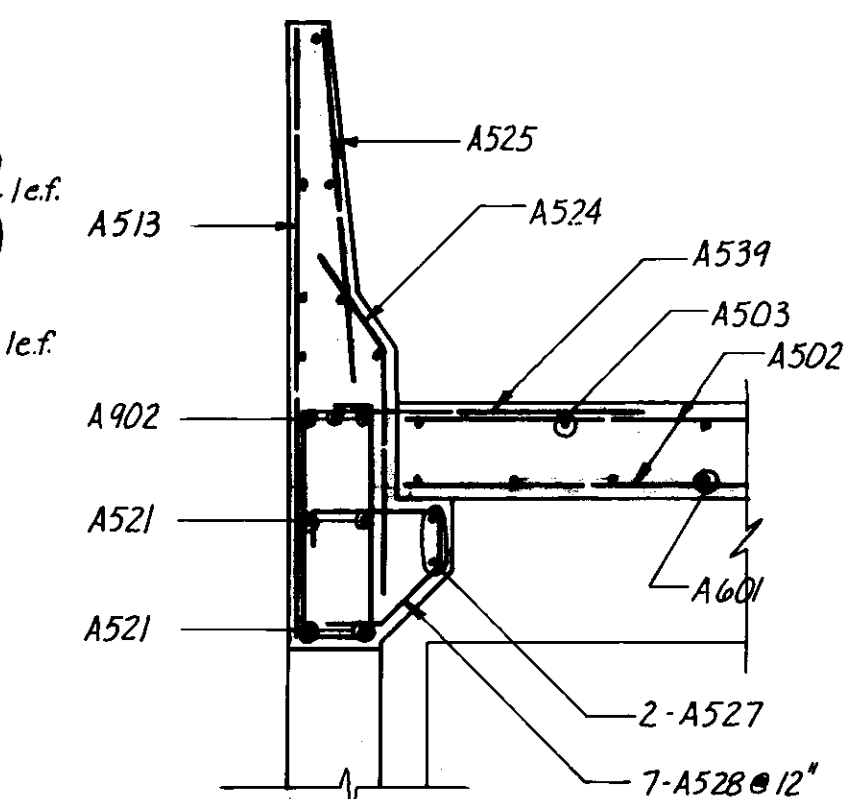

8 SECTION
216 Scale: 1/2"=1'-0"

AS - BUILT
DATE FB NO PAGE
Nov. 14/19

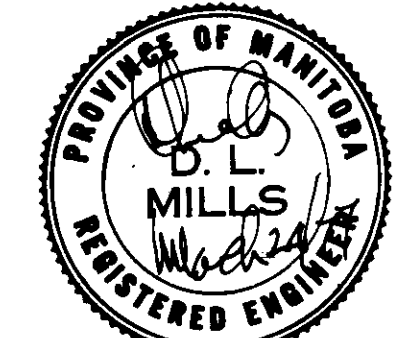

NO	ISSUED FOR TENDER	DATE	BY
0	ISSUED FOR TENDER	4.4.77	
NO	REVISIONS	DATE	BY

THE CITY OF WINNIPEG
WORKS & OPERATIONS DEPARTMENT
STREETS & TRANSPORTATION DIVISION

W.L. WARDROP & ASSOCIATES LTD.
ENGINEERING CONSULTANTS
WINNIPEG - THUNDER BAY - REGINA - BARRIE - EDMONTON

APPROVED BY: *[Signature]* DATE 25.11.17
DRAWN BY: SIB DATE 28.7.77
PRELIM. CHK: B.R. DATE 1.11.77
DESIGN: B.R. DATE 28.7.77
CHECK: B.R. DATE 28.7.77

ROUTE 165

ABUTMENT REINFORCING DETAILS
SOUTH BRIDGE

SCALE: AS SHOWN

DRAWING NO. B-5092-216

APPROVED BY: *[Signature]* DATE 25/12/22
MANAGER OF STREETS AND TRAFFIC

110 INCHES

MARK	NUMBER	LENGTH	WEIGHT	TYPE	DIMENSIONS			
					A	B	C	D
SOUTH BRIDGE ABUTMENTS								
F401	20	12-1	161	103	1-2	4-6		
F501	73	2-7	197	Str				
F502	2	24-0	50	Str				
F503	2	6-2	13	102	5-2	1-0		
F504	4	3-5	14	102	2-7	0-10		
F601	62	8-6	792	Str				
F602	72	16-0	1730	Str				
F603	28	44-0	1850	Str				
F604	36	11-9	635	Str				
F605	6	25-0	225	Str				
F606	86	3-2	409	Str				
F607	2	6-2	19	102	5-2	1-0		
F608	21	2-8	84	106	1-2	1-6	0-4 1/2	
F901	24	8-3	673	102	6-8	1-7		
A301	4	4-8	7	103	0-9	1-3		
A401	28	7-9	145	103	1-3	2-3		
A402	39	4-6	118	111	0-6	1-6	0-6	2-0
A403	4	3-5	9	102	2-7	0-10		
A404	17	19-6	221	Str				
A405	1	6-6	4	102	3-10	2-8		
A406	1	6-10	5	102	3-10	3-0		
A407	1	7-2	5	102	3-10	3-4		
A408	1	4-10	3	Str				
A409	1 series of 5	4-3 to 8-5	21	102	3-9	0-6 to 4-8		
A410	1	3-9	3	Str				
A411	5	8-2	27	102	3-6	4-8		
A501	133	4-9	659	102	2-6	2-3		
A502	20	43-0	897	Str				
A503	44	10-6	482	Str				
A504	18	8-6	160	Str				
A505	44	8-6	390	Str				
A506	18	38-2	717	Str				
A507	8	5-0	42	Str				
A508	46	9-2	440	Str				
A509	4	4-7	19	102	3-7	1-0		
A510	36	5-4	200	102	4-4	1-0		
A511	7	13-5	98	Str				
A512	7	9-2	67	Str				
A513	4	6-4	26	Str				
A514	2	5-6	11	Str				
A515	7	9-3	68	Str				
A516	10	7-0	73	Str				
A517	1 series of 10	10-10 to 13-0	87	Str				
A518	1 series of 12	5-10 to 10-4	101	Str				
A519	1 series of 10	3-9 to 10-1	137	Str				
A520	2 series of 8	9-4 to 23-10	208	Str				
A521	4	28-0	117	Str				
A522	12	29-6	369	Str				
A523	2	29-6	62	106	17-6	12-0	1-2	
A524	28	3-8	107	106	1-2	2-6	0-8	
A525	34	3-8	130	Str				
A526	2 series of 12	2-8 to 3-7	158	Str				
A527	2	7-6	16	Str				
A528	7	3-3	24	111A	0-6	1-5	0-6	0-10
A529	2 series of 10	3-3 to 8-5	219	102	2-3 to 7-6	0-11		
A530	2 series of 10	9-8 to 27-0	229	Str				
A531	4	28-2	118	Str				
A532	19	10-9	213	117	7-8	1-0	1-1	
A533	9	3-4	31	117	1-0	1-3	1-1	
A534	7	5-4	39	102	4-4	1-0		
A535	9	5-7	52	102	4-7	1-0		
A536	1 series of 12	4-3 to 5-3	59	113	3-3 to 4-3	1-0		
A537	5	7-9	40	Str				
A538	5	8-5	44	Str				
A539	4	9-7	40	116	3-6	2-6	0-9	
A540	35	9-4	341	103	2-2	2-2		
A541	48	7-10	392	103	2-2	1-5		
A542	3	39-9	124	Str				
A543	2	39-0	81	Str				
A544	10	40-0	417	Str				(cut in field)

MARK	NUMBER	LENGTH	WEIGHT	TYPE	DIMENSIONS			
					A	B	C	D
A545	2	4-2	9	102	3-4	0-10		
A546	19	6-6	129	113	1-6	3-6		
A547	13	7-6	102	113	1-6	4-6		
A601	87	10-6	1372	Str				
A602	28	8-8	365	102	8-3	0-5		
A603	28	6-0	252	102	3-0	3-0		
A604	39	2-9	161	106	1-3	1-6	1-0	
A605	4	2-8	16	106	1-2	1-6	1-0	
A901	15	7-6	383	Str				
A902	6	27-10	568	Str				
A903	4	24-6	333	106	19-6	5-0	6-4	
A904	8	42-6	1156	Str				
A905	3	11-6	117	102	7-6	4-0		
A906	3	8-1	82	Str				
A907	3	12-1	123	102	8-1	4-0		
TOTAL WEIGHT FOR 1 ABUTMENT 20,209 lbs. (FOR 2 ABUTMENTS 40,418 lbs.)								
NORTH BRIDGE ABUTMENTS								
F401	20	12-1	161	103	1-2	4-6		
F501	66	2-7	178	Str				
F502	2	24-0	50	Str				
F503	2	6-2	13	102	5-2	1-0		
F504	4	3-5	14	102	2-7	0-10		
F601	62	8-6	792	Str				
F602	52	16-0	1250	Str				
F603 & F604	omitted							
F605	6	25-0	225	Str				
F606	72	3-2	342	Str				
F607	2	6-2	19	102	5-2	1-0		
F608	19	2-8	76	106	1-2	1-6	0-4 1/2	
F609	36	8-4	451	Str				
F610	28	37-0	1556	Str				
F901	24	8-3	673	102				
A301	4	4-8	7	103	0-9	1-3		
A401	28	7-9	145	103	1-3	2-3		
A402	48	4-6	144	111	0-6	1-6	0-6	2-0
A403	4	3-5	9	102	2-7	0-10		
A404	omitted							
A405	1	6-6	4	102	3-10	2-8		
A406	1	6-10	5	102	3-10	3-0		
A407	1	7-2	5	102	3-10	3-4		
A408	1	4-10	3	Str				
A409	1 series of 5	4-3 to 8-5	21	102	3-9	0-6 to 4-8		
A410	1	3-9	3	Str				
A411	5	8-2	27	102	3-6	4-8		
A501	122	4-9	604	102	2-6	2-3		
A502	omitted							
A503	36	10-6	394	Str				
A504	omitted							
A505	38	8-6	337	Str				
A506 & A507	omitted							
A508	40	9-2	382	Str				
A509	4	4-7	19	102	3-7	1-0		
A510	36	5-4	200	102	4-4	1-0		
A511	16	13-5	224	Str				
A512	16	9-2	153	Str				
A513	5	6-4	33	Str				
A514	2	5-6	11	Str				
A515	7	9-3	68	Str				
A516	10	7-0	73	Str				
A517	2 series of 15	10-10 to 13-0	174	Str				
A518	2 series of 15	5-10 to 10-4	202	Str				
A519	2 series of 15	3-9 to 10-1	274	Str				
A520	2 series of 10	9-4 to 23-10	208	Str				
A521	8	28-0	234	Str				
A522	12	29-6	369	Str				

MARK	NUMBER	LENGTH	WEIGHT	TYPE	DIMENSIONS			
					A	B	C	D
A523	2	29-6	62	106	17-6	12-0	1-2	
A524	56	3-8	214	106	1-2	2-6	0-8	
A525	34	3-8	130	Str				
A526	2 series of 12	2-8 to 3-7	157	Str				
A527	4	7-6	31	Str				
A528	4	3-3	14	111A	0-6	1-5	0-6	0-10
A529	to A536 omitted							
A537	6	7-9	40	Str				
A538	5	8-5	44	Str				
A539	4	9-7	40	116	3-6	2-6	0-9	
A540	28	9-4	273	103	2-2	2-2		
A541	41	7-10	335	103	2-2	1-5		
A542 & A543	omitted							
A544	10	40-0	417	Str				(cut in field)
A545	2	4-2	9	102	3-4	0-10		
A546	omitted							
A547	13	7-6	102	113	1-6	4-6		
A548	20	34-10	727	Str				
A549	18	31-4	588	Str				
A550	3	34-8	108	Str				
A551	2	31-0	65	Str				
A552	2 series of 6	13-4 to 28-0	258	Str				
A601	71	10-6	1120	Str				
A602 & A603	omitted							
A604	32	2-9	132	106	1-3	1-6	1-0	
A605	4	2-8	16	106	1-2	1-6	1-0	
A901	18	7-6	459	Str				


10 INCHES
9
8
7
6
5
4
3
2
1
0

MARK	NUMBER	LENGTH	WEIGHT	TYPE	DIMENSIONS			
					A	B	C	D
PIER NO. 4								
F501	19	38-0	753	105	30-0	4-0		
F502	31	26-0	841	105	18-0	4-0		
F503	4	30-0	125	Str				
F504	4	18-0	75	Str				
F801	25	30-6	2036	Str				
F802	61	18-6	3013	Str				
F1001	46	12-6	2474	102	11-0	1-6		
P502	40	12-0	501	Str				
P503	32	13-0	434	Str				
P504	28	14-0	409	Str				
P505	117	5-0	610	100	4-0			
P506	104	8-9	949	112	3-3	2-9		
P509	10	17-6	183	103	3-9	4-6		
P601	20	10-4	310	105	3-8	3-4		
P602	18	11-2	302	115	4-6	3-4	0-9	
P603	6	23-5	211	105	21-5	1-0		
P805	18	7-0	336	105	4-0	1-6		
P901	18	25-0	1530	Str				
P1001	18	25-3	1956	Str				
P1002	18	25-9	1994	Str				
P1003	5	25-4	545	Str				
P1004	4	17-0	293	Str				
P1005	5	25-10	556	Str				
TOTAL WEIGHT FOR I PIER 20436 LBS. (40872 LBS. FOR 2 PIERS)								
PIER NO. 1								
F501	19	38-0	753	105	30-0	4-0		
F502	31	26-0	841	105	18-0	4-0		
F503	4	30-0	125	Str				
F504	4	18-0	75	Str				
F801	25	30-6	2036	Str				
F802	61	18-6	3013	Str				
F1001	46	12-6	2474	102	11-0	1-6		
P502	40	12-0	501	Str				
P503	32	13-0	434	Str				
P504	28	14-0	409	Str				
P505	126	5-0	657	100	4-0			
P506	104	8-3	895	112	3-3	2-6		
P509	10	17-6	183	103	3-9	4-6		
P601	20	10-4	310	105	3-8	3-4		
P602	18	11-2	302	115	4-6	3-4	0-9	
P603	6	23-5	211	105	21-5	1-0		
P805	18	7-0	336	105	4-0	1-6		
P901	18	25-0	1530	Str				
TOTAL WEIGHT FOR I PIER 46064 LBS. (184256 LBS. FOR 4 PIERS)								
SLOPE PAVING								
SOUTH BRIDGE								
SP301	51	4-6	86	103	0-8	1-2	0-8	1-2
SP401	3	26-0	52	106	5-9	20-3	5-6	
SP602	4	50-0	300	Str				
TOTAL WEIGHT FOR I SLAB 438 LBS. (876 LBS. FOR 2 SLABS)								
NORTH BRIDGE								
SP301	44	4-6	74		0-8	1-2	0-8	1-2
SP401	3	26-0	52	106	5-9	20-3	5-6	
SP601	4	43-0	258	Str				
TOTAL WEIGHT FOR I SLAB 384 LBS. (768 LBS. FOR 2 SLABS)								

MARK	NUMBER	LENGTH	WEIGHT	TYPE	DIMENSIONS			
					A	B	C	D
P1004	4	17-0	293	Str				
P1006	18	25-9	1994	Str				
P1007	18	26-0	2014	Str				
P1008	5	25-10	538	Str				
P1009	5	26-2	563	Str				
TOTAL WEIGHT FOR I PIER 20487 LBS. (40974 LBS. FOR 2 PIERS)								
PIER NO. 2 (PIER NO. 3 IDENTICAL)								
C401	6	301-0	1206	Spinal				
C14501	96	16-6	12118	Str				
F507	32	27-0	901	105	19-0	4-0		
F504	4	19-0	79	Str				
F505	20	38-0	793	105	31-0	3-6		
F506	4	31-0	130	Str				
F804	63	19-6	3280	Str				
F803	26	31-0	2152	Str				
F1101	54	13-0	3730	102	11-6	1-6		
P501	40	19-0	793	Str				
P502	44	11-6	528	Str				
P503	32	12-6	417	Str				
P504	28	14-0	409	Str				
P505	216	5-0	1126	100	4-0			
P507	94	7-3	711	112	2-3	2-6		
P508	188	6-9	1324	112	1-9	2-6		
P509	10	17-6	183	103	3-9	4-6		
P601	20	10-4	310	105	3-8	3-4		
P602	18	11-2	302	115	4-6	3-4	0-9	
P603	6	23-5	211	105	21-5	1-0		
P805	18	7-0	336	105	4-0	1-6		
P901	18	25-0	1530	Str				
P1101	18	45-6	4351	Str				
P1102	18	46-0	4399	Str				
P1103	9	45-7	2180	Str				
P1104	9	46-1	2204	Str				
P1105	4	17-0	361	Str				
TOTAL WEIGHT FOR I PIER 46064 LBS. (184256 LBS. FOR 4 PIERS)								

MARK	NUMBER	LENGTH	WEIGHT	TYPE	DIMENSIONS				
					A	B	C	D	E
PRECAST BARRIER - TYPE 'A'									
B401	30	6-7	132	107	0-4	2-8 1/2	0-10	2-6	0-6 1/2
B402	30	2-8	54	114	0-10	0-5	1-3 1/2		
B403	7	19-1	89	Str					
TOTAL WEIGHT FOR I BARRIER 275 LBS. (45100 LBS. FOR 164 BARRIERS)									
PRECAST BARRIER - TYPE 'B'									
B401	24	6-7	105	107	0-4	2-8 1/2	0-10	2-6	0-6 1/2
B402	33	2-8	59	114	0-10	0-5	1-3 1/2		
B403	7	19-1	89	Str					
B405	2	6-10	9	107	0-5	2-8 1/2	0-11 1/2	2-6	0-8
B406	2	7-6	10	107	0-9	2-8 1/2	1-3 1/2	2-6	1-0
B407	4	8-2	22	107	1-1	2-8 1/2	1-7 1/2	2-6	1-4
B408	3	5-5	11	104	1-2	0-9	1-4		
B409	3	5-0	10	103	1-1 1/2	1-1 1/2			
TOTAL WEIGHT FOR I BARRIER 315 LBS. (2520 LBS. FOR 8 BARRIERS)									
PRECAST BARRIER - TYPE 'C'									
B401	18	6-7	79	107	0-4	2-8 1/2	0-10	2-6	0-6 1/2
B402	18	2-8	32	114	0-10	0-5	1-3 1/2		
B404	7	11-6	54	Str					
TOTAL WEIGHT FOR I BARRIER 165 LBS. (1320 LBS. FOR 8 BARRIERS)									
PRECAST BARRIER - TYPE 'D'									
B401	18	6-7	79	107	0-4	2-8 1/2	0-10	2-6	0-6 1/2
B402	18	2-8	32	114	0-10	0-5	1-3 1/2		
B404	7	11-6	54	Str					
TOTAL WEIGHT FOR I BARRIER 165 LBS. (1320 LBS. FOR 8 BARRIERS)									
APPROACH SLABS									
WEST ABUTMENT NORTH BRIDGE & EAST ABUTMENT SOUTH BRIDGE									
A5501	51	34-6	1835	Str					
A5502	15	23-8	370	Str					
A5503	12	18-7	233	Str					
A5504	24	24-8	618	Str					
A5506	35	3-6	128	111	0-6	1-0	0-6	1-6	
A5507	4	5-0	21	Str					
A5801	24	18-7	1191	Str					
A5802	48	24-7	3150	Str					
TOTAL WEIGHT FOR I SLAB 7546 LBS. (15092 LBS. FOR 2 SLABS)									
EAST ABUTMENT NORTH BRIDGE & WEST ABUTMENT SOUTH BRIDGE									
A5501	2	34-6	72	Str					
A5502	15	23-8	370	Str					
A5503	17	18-7	329	Str					
A5504	24	24-8	618	Str					
A5505	20	36-4 to 37-1	766	Str					
A5506	35	3-6	128	111	0-6	1-0	0-6	1-6	
A5507	4	5-0	2	Str					
A5508	23	36-4 to 37-1	1110	Str					
A5801	24	18-7	1191	Str					
A5802	48	24-7	3150	Str					
TOTAL WEIGHT FOR I SLAB 7755 LBS. (15510 LBS. FOR 2 SLABS)									

BENDING DIAGRAMS

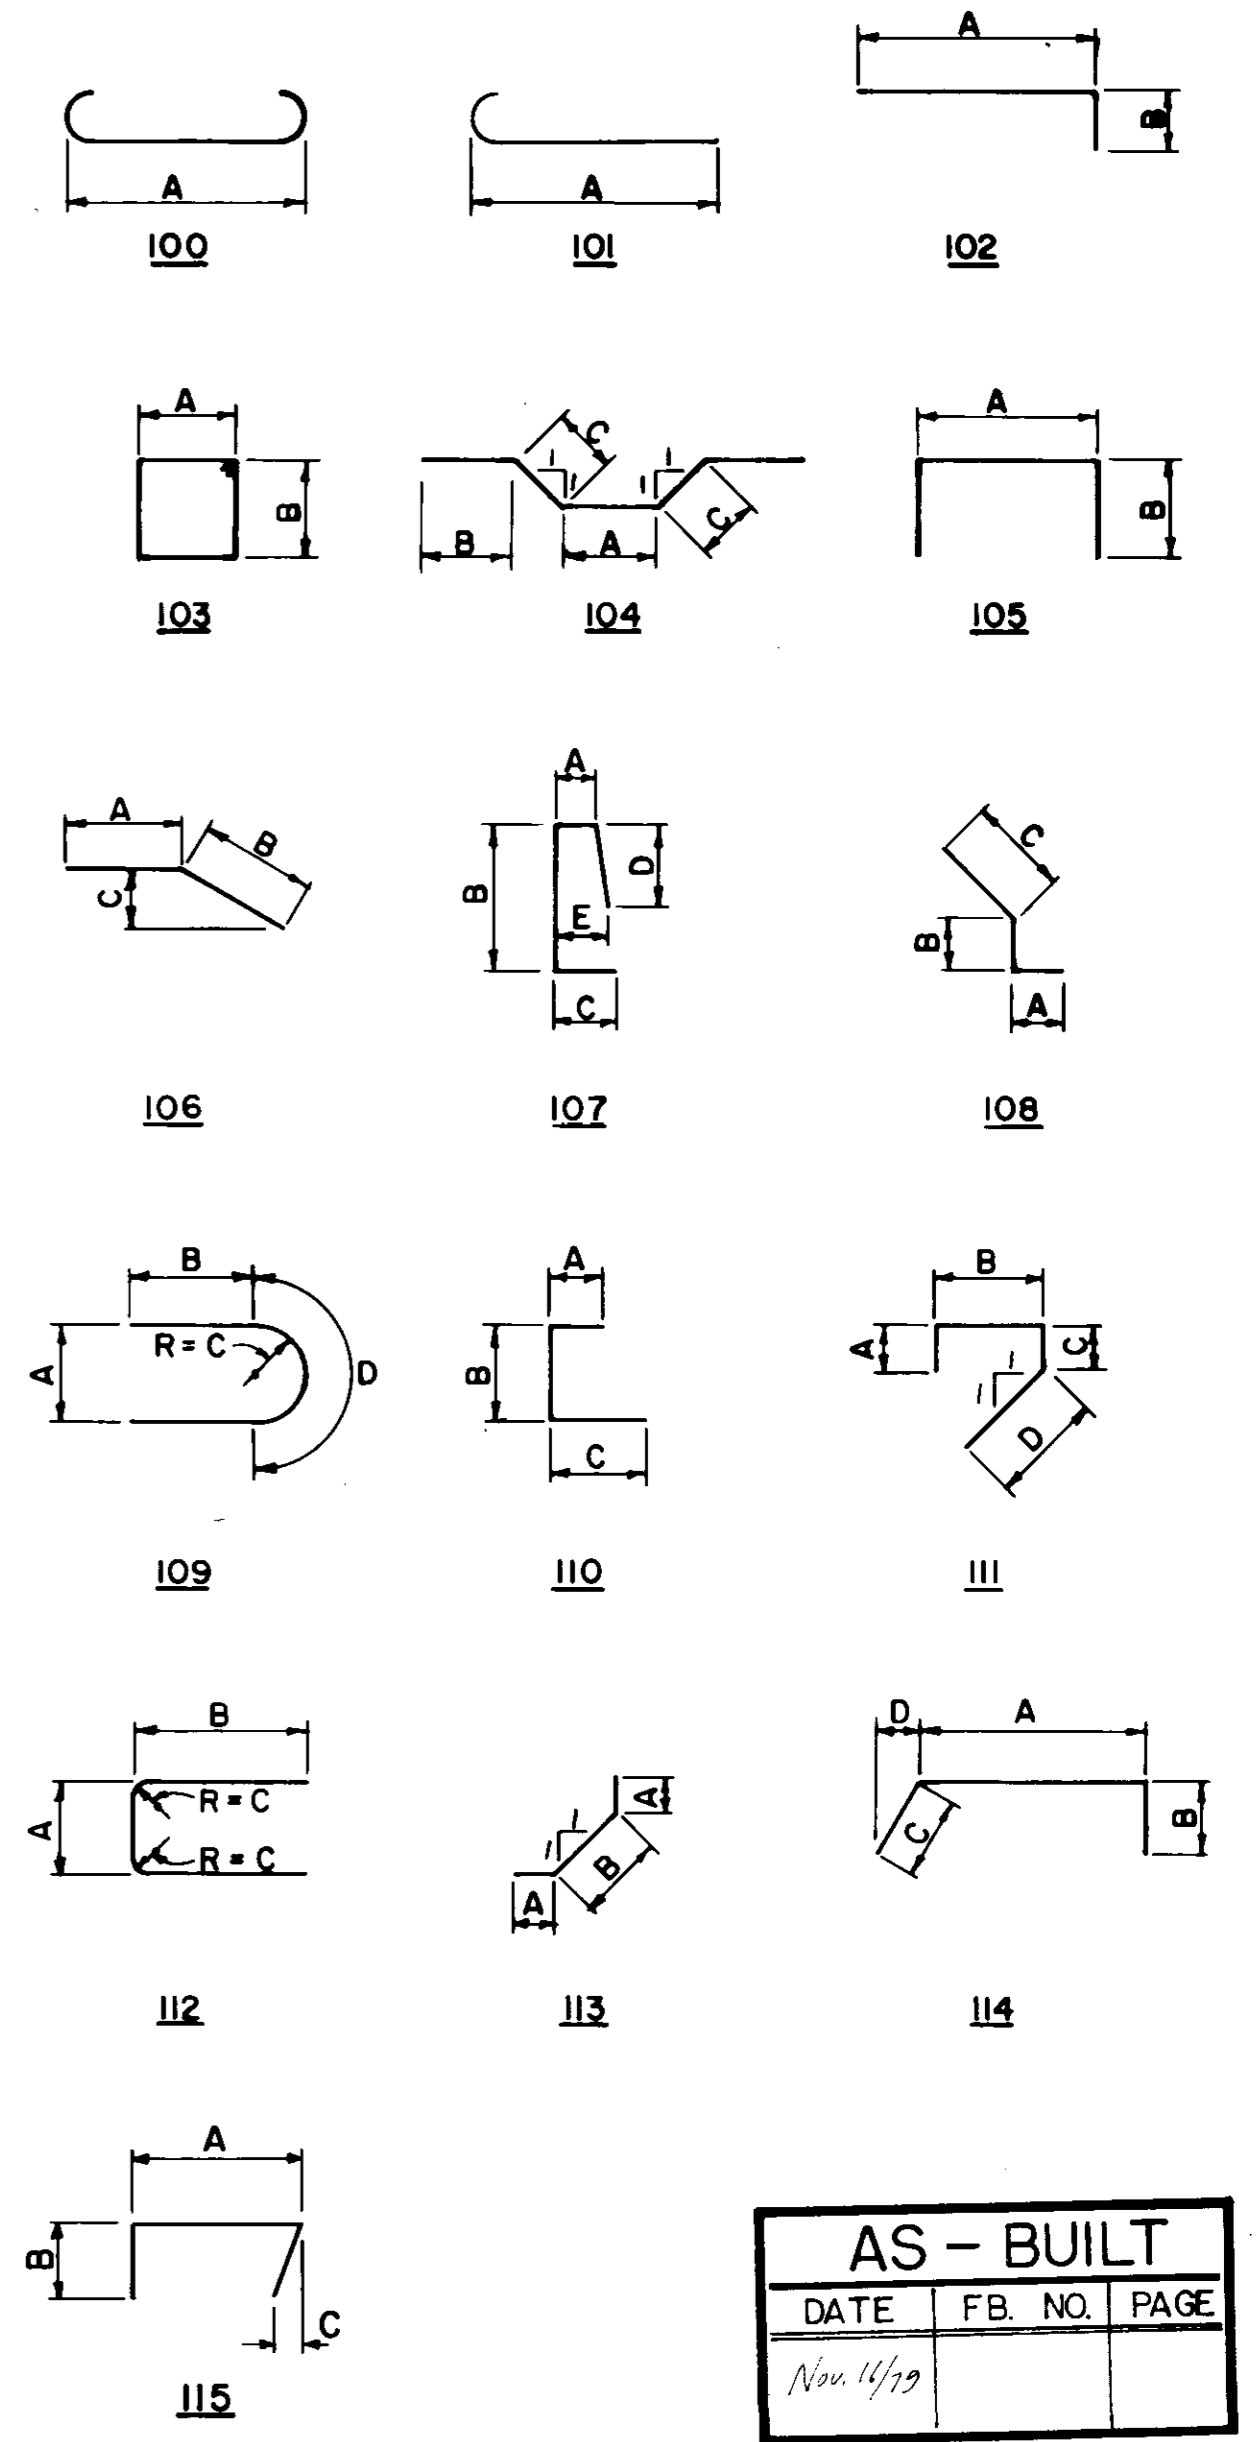

AS - BUILT		
DATE	FB. NO.	PAGE
Nov 14/79		

Notes:
 * Reinforcing shall be grade 40 for #4 bar and grade 60 for #5 bar and larger.
 * Denotes grade 40 bar.

NO.	REVISIONS	DATE	BY

THE CITY OF WINNIPEG
 WORKS & OPERATIONS DEPARTMENT
 STREETS & TRANSPORTATION DIVISION

W.L. WARDROP & ASSOCIATES LTD.
 ENGINEERING CONSULTANTS
 WINNIPEG - THUNDER BAY - REGINA - SASKATOON

APPROVED BY: *D.L. Green* DATE: 25 Nov 77

DRAWN BY: S.I.Z. DATE: 10/17/77
 PRELIM. CHK: P.J.R. DATE: 10/17/77

DESIGN: B.J.R. DATE: NOV 75
 CHECK: J.R.E. DATE: JAN 77


ROUTE 165

REINFORCING LIST NO. 2


APPROVED BY: *Donald R. Campbell* DATE: 25/10/79
 MANAGER OF STREETS AND TRAFFIC

DRAWING NO. **B-5092-220**


10 INCHES
19
18
17
16
15
14
13
12
11
10

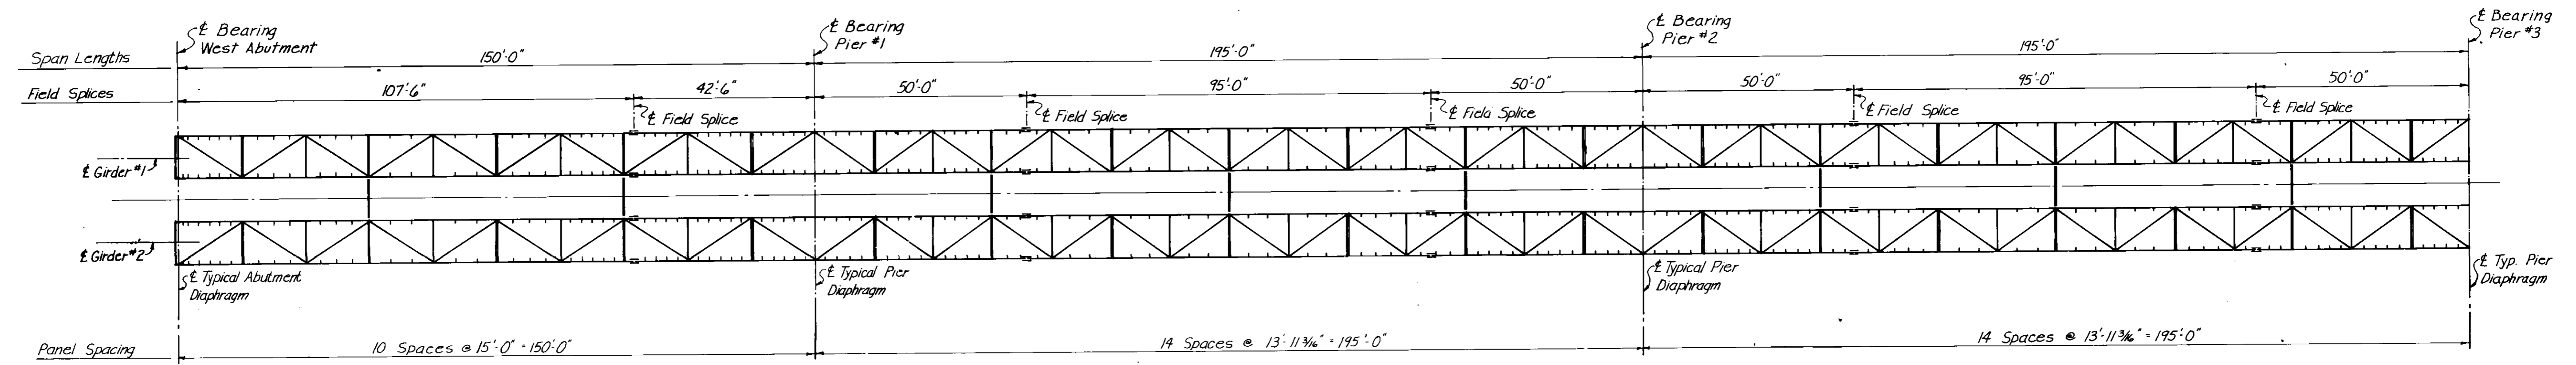


NORTH BRIDGE

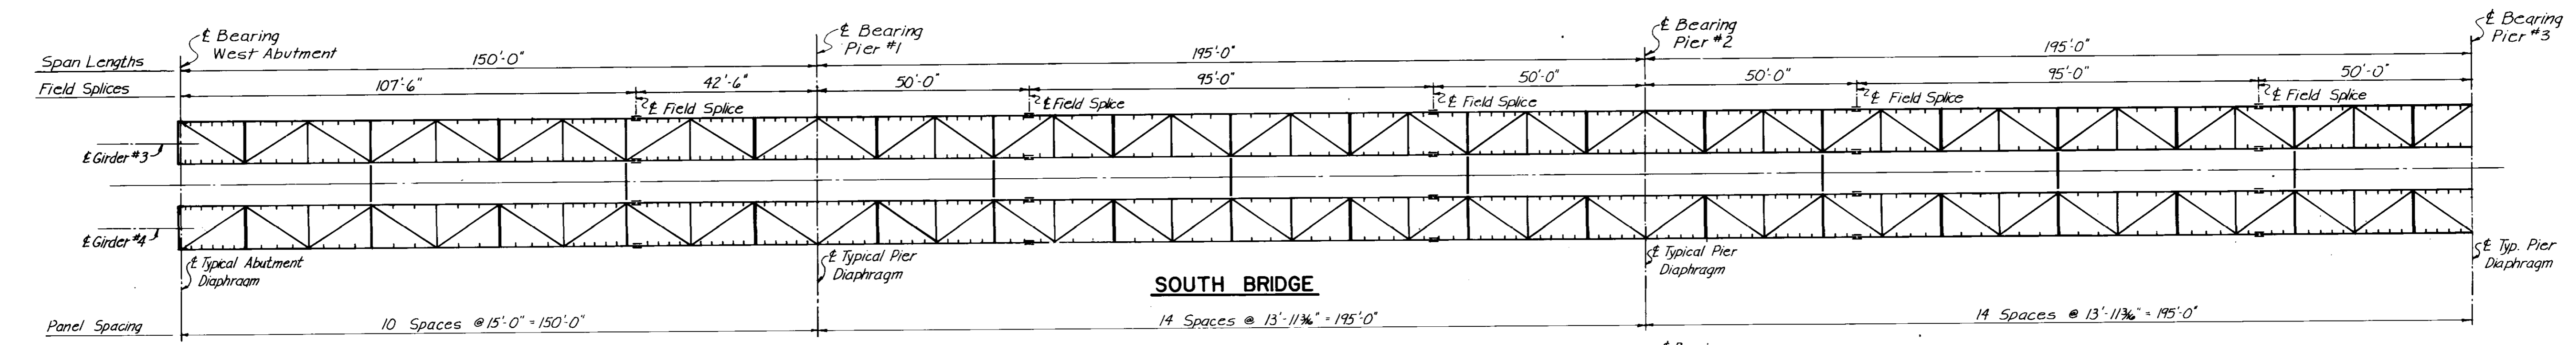

SOUTH BRIDGE

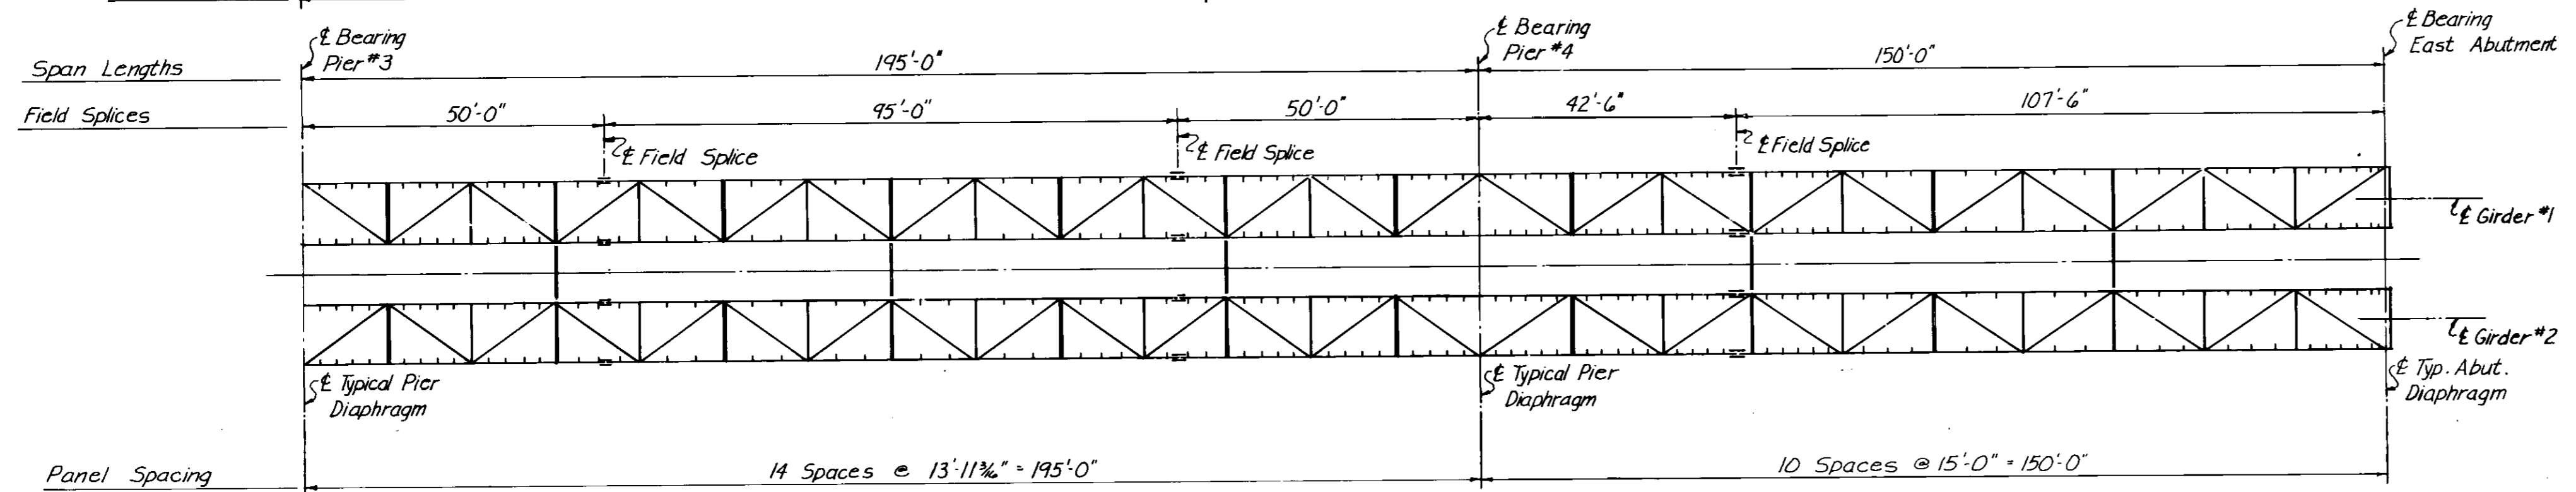

NORTH BRIDGE

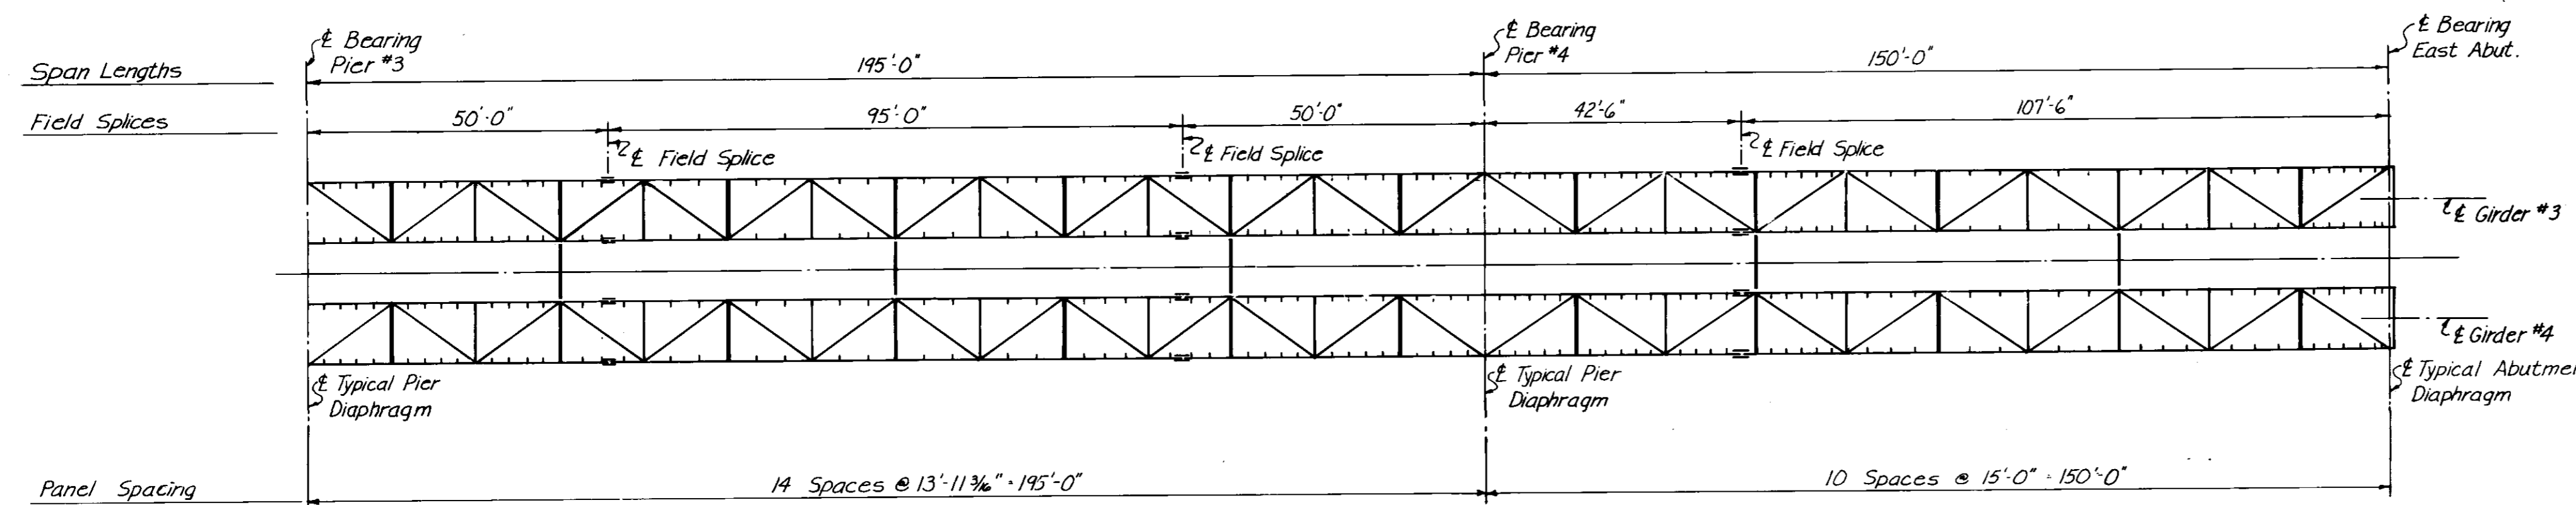

SOUTH BRIDGE

Notes:
1) The location of welds connecting stiffener and gusset plates to flanges shall be as shown on the "Girder Elevation".

AS - BUILT		
DATE	FB NO	PAGE
Nov. 14/77		

	THE CITY OF WINNIPEG WORKS & OPERATIONS DEPARTMENT STREETS & TRANSPORTATION DIVISION	ROUTE 165	SCALE: 1" = 20'-0"
	W.L. WARDROP & ASSOCIATES LTD. ENGINEERING CONSULTANTS WINNIPEG · THUNDER BAY · REGINA · SASKATOON	FRAMING PLAN	DRAWING NO. B-5092-221
	APPROVED BY: <i>[Signature]</i> DATE: 25/11/77 DRAWN BY: J.T.K. NOV. 76 PRELIM. CHK: S.T.K. JAN. 77	DESIGN: S.T.K. NOV. 76 CHECK: D.L.M. JAN. 77	APPROVED BY: <i>[Signature]</i> DATE: 25/11/77 MANAGER OF STREETS AND TRAFFIC

NORTH BRIDGE - NORTH BOX LINE 1. NORTH FLANGE. (CHART 1)

CHAINAGE	1. POINT	2. TOP OF CONC. ELEV.	3. TOP OF FLANGE ELEV.	4. FLANGE THICK.	5. BOT. OF FLANGE ELEV.	6. CHORD ELEV.	7. FIELD CAMBER (5-6) LESS V.C.	CAMBER					13. DESIGN HAUNCH MIN.	14. ACTUAL HAUNCH (2-5)+12	15. EXTRA CAMBER (7-12)	REVISED HAUNCH AND GRADE					21. V.C. CAMBER	22. REVISED HAUNCH IN INCHES	23. SCREED HEIGHT (22-4) IN INCHES	24. FIELD SCREED HEIGHT	
								8. ΔT ΔA+B	9. ΔC ΔA	10. ΔC ΔB	11. ΔS ΔA	12. 1.3ΔT-ΔS				16. REVISED GRADE	17. REVISED HAUNCH (16-5)+12	18. HAUNCH SHIM (17-13)	19. SCREED ELEV. (16+12)	20. HAUNCH CHECK (19-5)					
0+00	0.0	768.11	767.295	.073	767.222	767.222	0	0	0	0	0	0	0.922	0.868	0	768.251	1.029	0.107	768.251	1.029			12 3/8	11 1/2	
+15	.1	.28	.605	.073	67.532	.387	0.143	.091	.055	.022	.014	.104		0.852	0.039	.421	0.993	0.071	.525	0.993			11 13/16	11 1/4	
+30	.2	.45	.875	.073	.802	.556	0.246	.166	.100	.041	.025	.121		0.832	0.055	.591	0.980	0.058	.782	0.980			11 3/4	10 3/8	
+46	.3	.62	68.120	.073	68.047	.723	0.324	.213	.128	.052	.033	.244		0.817	0.080	.761	0.958	0.036	69.005	0.958			11 1/2	10 5/8	
+60	.4	.78	.305	.073	.232	.890	0.342	.227	.135	.057	.035	.260		0.808	0.082	.921	0.949	0.027	.181	0.949			11 3/8	10 1/2	
+75	.5	.95	.450	.073	.377	68.057	0.320	.208	.123	.053	.032	.238		0.811	0.082	69.091	0.952	0.030	.329	0.952			11 7/16	10 9/16	
+90	.6	69.12	.575	.073	.502	.224	0.278	.163	.076	.043	.024	.188		0.806	0.090	.261	0.947	0.025	.449	0.947			11 3/8	10 1/2	
1+05	.7	.29	.640	.073	.567	.391	0.176	.105	.061	.028	.016	.121		0.844	0.054	.431	0.985	0.063	.552	0.985			11 13/16	10 5/16	
+20	.8	.45	.740	.104	.636	.558	0.078	.050	.027	.013	.010	.055		0.869	0.023	.591	1.010	0.088	.646	1.010			12 1/8	10 1/8	
+35	.9	.62	.925	.188	.737	.725	0.012	.013	.007	.003	.003	.014		0.897	-.002	.761	1.038	0.116	.775	1.038			12 1/2	10 1/4	
+50	1.0	.79	69.080	.188	.892	.832	0	0	0	0	0	0		0.898	0	.931	1.039	0.117	.931	1.039			12 1/2	10 1/4	
+65.5	.1	70.01	.335	.188	69.147	69.160	0.047	.032	.014	.011	.007	.035		0.898	0.012	70.151	1.039	0.117	70.186	1.039			12 1/2	10 1/4	
+89	.2	.28	.545	.104	.441	.308	0.133	.099	.049	.031	.019	.110		0.849	0.023	.421	1.090	0.168	.531	1.090			13 1/8	11 3/8	
2+08.5	.3	.44	.875	.073	.802	.516	0.286	.180	.098	.055	.027	.207		0.845	0.079	.581	0.986	0.064	.788	0.986			11 13/16	10 5/16	
+28	.4	.66	70.195	.073	70.122	.724	0.398	.244	.136	.072	.036	.281		0.819	0.117	.901	0.960	0.038	71.082	0.960			11 1/2	10 5/8	
+47.5	.5	.88	.420	.073	.347	.932	0.415	.268	.150	.078	.040	.308		0.841	0.107	71.021	0.982	0.060	.329	0.982			11 3/4	10 3/8	
+67	.6	71.10	.565	.073	.492	70.140	0.352	.243	.135	.071	.037	.279		0.887	0.073	.241	1.028	0.106	.520	1.028			12 5/16	11 3/16	
+86.5	.7	.31	.605	.073	.532	.348	0.184	.176	.097	.053	.026	.203		0.981	-.019	.451	.122	0.200	.654	1.122			13 1/2	12 3/8	
3+06	.8	.52	.725	.104	.621	.556	0.065	.096	.048	.030	.018	.107		1.006	-.042	.642	1.148	0.226	.769	1.148			13 3/4	12 1/2	
+25.5	.9	.70	.985	.188	.797	.764	0.033	.030	.013	.010	.007	.032		0.935	0.001	.858	1.093	0.171	.890	1.093			13 1/8	10 7/8	
+45	2.0	.87	71.160	.188	.972	.972	0	0	0	0	0	0		0.898	0	72.033	1.061	0.139	72.033	1.061	0		12 3/4	10 1/2	
+64.5	.1	72.01	.365	.188	71.177	71.020	0.066	.026	.012	.008	.006	.028		0.861	0.038	.185	1.036	0.114	.213	1.036	.091		12 7/16	10 7/16	
+84	.2	.14	.505	.104	.401	.068	0.171	.087	.045	.026	.016	.097		0.836	0.074	.314	1.010	0.088	.411	1.010	.162		12 1/8	10 7/8	
4+03.5	.3	.24	.740	.073	.667	.116	0.335	.164	.092	.047	.025	.188		0.761	0.147	.422	0.943	0.021	.610	0.943	.216		11 5/16	10 7/16	
+23	.4	.32	.925	.073	.852	.164	0.443	.227	.129	.064	.034	.261		0.729	0.182	.507	0.916	-.006	.768	0.916	.245		11	10 1/8	
+42.5	.5	.59	72.000	.073	.927	.212	0.457	.251	.143	.070	.038	.288		0.751	0.169	.569	0.930	0.008	.857	0.930	.258		11 3/16	10 5/16	
+62	.6	.43	71.985	.073	.912	.260	0.407	.227	.129	.064	.034	.261		0.779	0.146	.610	0.959	0.037	.871	0.959	.245		11 1/2	10 5/8	
+81.5	.7	.45	.885	.073	.812	.308	0.288	.164	.092	.047	.026	.188		0.826	0.100	.627	1.003	0.081	.815	1.003	.216		12 1/16	11 3/16	
5+01	.8	.45	.765	.104	.661	.356	0.138	.087	.045	.026	.016	.097		0.886	0.040	.623	1.059	0.137	.720	1.059	.167		12 11/16	11 7/16	
+20.5	.9	.43	.740	.188	.552	.404	0.057	.026	.012	.008	.006	.028		0.906	0.029	.596	1.072	0.150	.624	1.072	.091		12 7/8	10 5/8	
+40	3.0	.39	.640	.188	.452	71.452	0	0	0	0	0	0		0.938	0	.547	1.095	0.173	.547	1.095	0		13 3/16	10 5/16	
+59.5	.1	.33	.605	.188	.417	.361	0.056	.030	.013	.010	.007	.032		0.945	0.024	.476	1.091	0.169	.508	1.091			13 1/8	10 7/8	
+79	.2	.25	.505	.104	.401	.269	0.132	.096	.048	.030	.018	.107		0.956	0.025	72.391	1.097	0.175	72.498	1.097			13 3/16	11 15/16	
+98.5	.3	.15	.525	.073	.452	.178	0.274	.176	.097	.053	.026	.203		0.901	0.071	.291	1.042	0.120	.494	1.042			12 1/2	11 5/8	
6+18	.4	.06	.505	.073	.432	.086	0.346	.243	.135	.071	.037	.279		0.907	0.067	.201	1.048	0.126	.480	1.048			12 5/8	11 3/4	
+37.5	.5	71.96	.425	.073	.352	70.995	0.357	.268	.150	.078	.040	.308		0.916	0.049	.101	1.057	0.135	.409	1.057			12 5/8	11 3/4	
+57	.6	.86	.290	.073	.217	.903	0.314	.244	.136	.072	.036	.281		0.924	0.033	.001	1.065	0.143	.282	1.065			12 15/16	11 15/16	

NORTH BRIDGE - NORTH BOX LINE 1. NORTH FLANGE (CHART 1)

CHAINAGE	1. POINT	2. TOP OF CONC. ELEV.	3. TOP OF FLANGE ELEV.	4. FLANGE THICK.	5. BOT. OF FLANGE ELEV.	6. CHORD ELEV.	7. FIELD CAMBER (5-6) Less V.C.	CAMBER					13. DESIGN HAUNCH MIN.	14. ACTUAL HAUNCH (2-5)+12	15. EXTRA CAMBER (7-12)	REVISED HAUNCH AND GRADE					21. V.C. CAMBER	22. REVISED HAUNCH IN INCHES	23. SCREED HEIGHT (22-4) IN INCHES	24. FIELD SCREED HEIGHT (IN INCHES)
								8. ΔT Q A+B	9. ΔC Q A	10. ΔC Q B	11. ΔS Q A	12. 1.3ΔT-ΔS				16. REVISED GRADE	17. REVISED HAUNCH (16-5)+12	18. HAUNCH SHIM (17-.3)	19. SCREED ELEV. (16+12)	20. HAUNCH CHECK (19-5)				
6+74.5	3.7	771.76	771.09	.073	771.017	770.812	0.205	.180	.058	.055	.027	.207	0.922	0.950	-0.002	771.901	1.001	0.167	772.108	1.071		13 1/8	12 1/4	
+96	.8	.67	70.80	.104	70.796	.720	0.076	.099	.049	.031	.019	.110		0.984	-.034	.811	1.125	0.203	71.921	1.125		13 1/2	12 1/4	
7+15.5	.9	.57	.830	.188	.642	.629	0.013	.032	.014	.011	.007	.035		0.963	-.022	.711	1.104	0.182	.746	1.104		13 1/4	11	
+35	4.0	.47	.725	.188	.537	.537	0	0	0	0	0	0		0.933	0	.611	1.074	0.152	.611	1.074		12 7/8	10 5/8	
+50	.1	.40	.695	.188	.507	.461	0.046	.013	.007	.003	.003	.014		0.907	0.032	.541	1.048	0.126	.555	1.048		12 9/16	10 5/16	
+65	.2	.32	.615	.104	.511	.384	0.127	.050	.027	.013	.010	.055		0.864	0.072	.461	1.005	0.083	.516	1.005		12 1/16	10 13/16	
+80	.3	.25	.630	.073	.557	.308	0.249	.105	.061	.028	.016	.121		0.814	0.128	.391	0.955	0.033	.512	0.955		11 1/2	10 5/8	
+95	.4	.17	.645	.073	.572	.231	0.341	.163	.096	.043	.024	.188		0.786	0.153	.311	0.927	0.005	.499	0.927		11 1/8	10 1/4	
8+10	.5	.10	.605	.073	.532	.155	0.377	.208	.123	.053	.032	.238		0.806	0.139	.241	0.947	0.025	.479	0.947		11 3/8	10 1/2	
+25	.6	.02	.550	.073	.477	.078	0.399	.227	.135	.057	.035	.260		0.803	0.139	.161	0.944	0.022	.421	0.944		11 5/16	10 7/16	
+40	.7	70.95	.440	.073	.367	.002	0.365	.213	.128	.052	.033	.244		0.827	0.121	.091	0.968	0.046	.335	0.968		11 5/8	10 3/4	
+55	.8	.87	.275	.073	.202	69.925	0.277	.166	.100	.041	.025	.191		0.859	0.086	.011	1.000	0.078	.202	1.000		12	11 1/8	
+70	.9	.80	.090	.073	.017	.849	.168	.091	.055	.022	.014	.104		0.887	0.064	70.941	1.028	0.106	.045	1.028		12 3/8	11 1/2	
+85	5.0	.72	69.845	.073	69.772	.772	0	0	0	0	0	0		0.948	0	.861	1.089	0.167	70.861	1.089		13 1/16	12 3/16	

NORTH BRIDGE - NORTH BOX LINE 1 SOUTH FLANGE (CHART 2)

CHAINAGE	1. POINT	2. TOP OF CONC. ELEV.	3. TOP OF FLANGE ELEV.	4. FLANGE THICK.	5. BOT. OF FLANGE ELEV.	6. CHORD ELEV.	7. FIELD CAMBER (5-6) <small>LESS V.C.</small>	CAMBER					13. DESIGN HAUNCH MIN.	14. ACTUAL HAUNCH (2-5)+12	15. EXTRA CAMBER (7-12)	REVISED HAUNCH AND GRADE					21. V.C. CAMBER	22. REVISED HAUNCH IN INCHES	23. SCREED HEIGHT (22-4) IN INCHES	24. FIELD SCREED HEIGHT IN INCHES
								8. ΔT R A+B	9. ΔC R A	10. ΔC R B	11. ΔS R A	12. 1.3ΔT-ΔS				16. REVISED GRADE (13-14)+2	17. REVISED HAUNCH (16-5)+12	18. HAUNCH SHIM (17-13)	19. SCREED ELEV. (16+12)	20. HAUNCH CHECK (19-5)				
0+00	0.0	768.31	767.355	.073	767.282	767.282	0	0	0	0	0	0	1.120		0	768.451	1.169	0.049	768.451	1.169		14	13 1/8	
+15	.1	.48	.605	.073	.532	.447	0.085	.091	.055	.022	.014	.104		1.052	-.019	.621	1.193	0.073	.725	1.193		14 5/16	13 1/16	
+30	.2	.65	.890	.073	.817	.611	0.206	.166	.100	.041	.025	.191		1.024	.015	.791	1.165	0.045	.982	1.165		14	13 1/8	
+45	.3	.82	68.130	.073	68.057	.776	0.281	.213	.128	.052	.033	.244		1.007	.037	.961	1.148	0.028	69.205	1.148		13 3/4	12 7/8	
+60	.4	.98	.305	.073	.232	.940	0.292	.227	.135	.057	.035	.260		1.008	.032	69.121	1.149	0.029	.381	1.149		13 3/4	12 7/8	
+75	.5	69.15	.465	.073	.392	68.105	0.287	.208	.123	.053	.032	.238		0.996	.049	.291	1.137	0.017	.529	1.137		13 5/8	12 3/4	
+90	.6	.32	.580	.073	.507	.269	0.238	.163	.096	.043	.024	.188		1.001	.051	.461	1.142	0.022	.649	1.142		13 1/16	12 3/16	
1+05	.7	.49	.655	.073	.582	.435	0.147	.105	.061	.028	.016	.121		1.029	.026	.631	1.170	0.050	.752	1.170		14 1/16	13 3/16	
+20	.8	.65	.750	.104	.646	.598	0.048	.050	.027	.013	.010	.055		1.059	-.007	.791	1.200	0.080	.846	1.200		14 7/16	13 3/16	
+35	.9	.82	.955	.188	.767	.763	0.004	.013	.007	.003	.003	.014		1.067	-.010	.961	1.208	0.088	.975	1.208		14 1/2	12 1/4	
+50	1.0	.99	69.115	.188	.927	.927	0	0	0	0	0	0		1.063	0	70.131	1.204	0.084	70.131	1.204		14 7/16	12 3/16	
+65.5	.1	70.21	.355	.188	69.167	69.134	0.033	.032	.014	.011	.007	.035		1.078	-.002	.331	1.199	0.079	.366	1.199		14 3/8	12 1/8	
+80	.2	.43	.580	.104	.476	.341	0.135	.099	.049	.031	.019	.110		1.064	0.025	.571	1.205	0.085	.681	1.205		14 1/2	13 1/4	
2+08.5	.3	.64	.895	.073	.822	.548	0.274	.180	.098	.055	.027	.207		1.025	0.067	.781	1.166	0.046	.988	1.166		14	13 1/8	
+28	.4	.86	70.205	.073	70.132	.755	0.377	.244	.136	.072	.036	.281		1.009	0.096	71.001	1.150	0.030	71.282	1.150		13 3/16	12 15/16	
+47.5	.5	71.08	.425	.073	.352	.962	0.390	.268	.150	.078	.040	.308		1.036	0.082	.221	1.177	0.057	.529	1.177		14 1/8	13 1/4	
+67	.6	.30	.560	.073	.487	70.169	0.318	.243	.135	.071	.037	.279		1.092	0.037	.441	1.233	0.113	.720	1.233		14 3/16	13 5/16	
+86.5	.7	.51	.610	.073	.537	.376	0.161	.176	.097	.053	.026	.203		1.176	-.042	.651	1.317	0.197	.854	1.317		15 13/16	14 15/16	
3+06	.8	.72	.735	.104	.631	.583	0.048	.096	.048	.030	.018	.107		1.196	-.059	.862	1.338	0.218	.969	1.338		16 1/16	14 13/16	
+25.5	.9	.90	.990	.188	.802	.790	0.012	.030	.013	.010	.007	.032		1.130	-.020	72.058	1.288	0.168	72.090	1.288		15 1/2	13 1/4	
+45	2.0	72.07	71.185	.188	.997	.997	0	0	0	0	0	0		1.073	0	.237	1.236	0.118	.233	1.236	0	14 13/16	12 7/16	
+64.5	.1	.21	.385	.188	71.197	71.046	0.060	.026	.012	.008	.006	.028		1.041	0.179	.385	1.216	0.096	.413	1.216	-.091	14 5/8	12 3/8	
+84	.2	.34	.510	.104	.406	.095	0.149	.087	.045	.026	.016	.097		1.031	0.408	.514	1.205	0.085	.611	1.205	.162	14 1/2	13 1/4	
4+03.5	.3	.44	.735	.073	.662	.144	0.302	.164	.092	.047	.025	.188		0.966	0.706	.622	1.148	0.028	.810	1.148	-.216	13 13/16	12 15/16	
+23	.4	.52	.915	.073	.842	.193	0.404	.227	.129	.064	.034	.261		0.939	0.910	.707	1.126	0.006	.968	1.126	.245	13 1/2	12 3/8	
+42.5	.5	.59	72.010	.073	.937	.242	0.437	.251	.143	.070	.038	.288		0.941	0.983	.769	1.120	0 0	73.057	1.120	.258	13 7/16	12 9/16	
+62	.6	.63	71.995	.073	.922	.291	0.386	.227	.129	.064	.034	.261		0.969	0.892	.810	1.149	0.029	.071	1.149	.245	13 13/16	12 15/16	
+81.5	.7	.65	.915	.073	.842	.340	0.286	.164	.092	.047	.025	.188		0.996	0.690	.827	1.173	0.053	.015	1.173	-.216	14 1/16	13 3/16	
5+01	.8	.65	.805	.104	.701	.389	0.145	.087	.045	.026	.016	.097		1.046	0.409	.823	1.219	0.099	72.920	1.219	.167	14 5/8	13 3/8	
+20.5	.9	.63	.765	.188	.577	.438	0.048	.026	.012	.008	.006	.028		1.081	0.167	.796	1.247	0.127	.824	1.247	.091	15	12 3/4	
+40	3.0	.59	.675	.188	.487	71.487	0	0	0	0	0	0		1.103	0	.747	1.260	0.140	.747	1.260	0	15 1/8	12 7/8	
+59.5	.1	.53	.640	.188	.452	.394	0.058	.030	.013	.010	.007	.032		1.110	0.026	.676	1.256	0.136	.708	1.256		15 1/16	12 13/16	
+79	.2	.45	.555	.104	.451	.300	0.151	.096	.048	.030	.018	.107		1.106	0.044	.591	1.247	0.127	.698	1.247		15	13 3/4	
+98.5	.3	.35	.560	.073	.487	.207	0.280	.176	.097	.053	.026	.203		1.066	0.077	.491	1.207	0.087	.694	1.207		14 1/2	13 5/8	
6+18	.4	.26	.530	.073	.457	.113	0.344	.243	.135	.071	.037	.279		1.082	0.065	.401	1.223	0.103	.680	1.223		14 11/16	13 13/16	
+37.5	.5	.16	.450	.073	.377	.020	0.357	.268	.150	.078	.040	.308		1.091	0.049	.301	1.232	0.112	.609	1.232		14 13/16	13 5/16	
+57	.6	.06	.30	.073	.227	70.926	0.301	.244	.136	.072	.036	.281		1.114	0.020	.201	1.255	.135	.482	1.255		15 1/16	14 3/16	

NORTH BRIDGE - NORTH BOX LINE 1 SOUTH FLANGE (CHART 2)

CHAINAGE	1. POINT	2. TOP OF CONC. ELEV.	3. TOP OF FLANGE ELEV.	4. FLANGE THICK.	5. BOT. OF FLANGE ELEV.	6. CHORD ELEV.	7. FIELD CAMBER (5-6) less V.C.	CAMBER					13. DESIGN HAUNCH MIN.	14. ACTUAL HAUNCH (2-5)+12	15. EXTRA CAMBER (7-12)	REVISED HAUNCH AND GRADE					21. V.C. CAMBER	22. REVISED HAUNCH IN INCHES	23. SCREED HEIGHT (22-4) IN INCHES	24. FIELD SCREED HEIGHT IN INCHES
								8. ΔT P A+B	9. ΔC P A	10. ΔC P B	11. (8-7)+12 P A	12. 1.3ΔT-ΔS				16. REVISED GRADE (13-12)+12	17. REVISED HAUNCH (16-5)+12	18. HAUNCH SHIM (17-13)	19. SCREED ELEV. (16+12)	20. HAUNCH CHECK (19-5)				
6+76.5	3.7	771.96	771.12	.073	771.047	70.833	0.214	.180	.058	.055	.027	.207	1.120	1.120	0.007	772.101	1.261	0.141	772.308	1.261		15 1/8	14 1/4	1
+96	.8	.87	70.910	.104	70.806	.739	0.067	.099	.043	.031	.019	.110		1.174	-0.043	.011	1.315	0.195	.121	1.315		15 13/16	14 9/16	
7+15.5	.9	.77	.840	.188	.652	.646	0.006	.032	.014	.011	.007	.035		1.153	-.029	71.911	1.294	0.174	71.946	1.294		15 1/2	13 1/4	
+35	4.0	.67	.740	.188	.552	.552	0	0	0	0	0	0		1.118	0	.811	1.259	0.139	.811	1.259		15 1/8	12 7/8	
+50	.1	.60	.705	.188	.517	.481	0.036	.013	.007	.003	.003	.014		1.097	0.022	.741	1.238	0.118	.755	1.238		14 7/8	12 3/8	
+65	.2	.52	.620	.104	.516	.410	0.106	.050	.027	.013	.010	.055		1.059	0.051	.661	1.200	0.080	.716	1.200		14 7/16	13 3/16	
+80	.3	.45	.625	.073	.552	.337	0.213	.105	.061	.028	.016	.121		1.019	0.092	.591	1.160	0.040	.712	1.160		13 15/16	13 1/16	
+95	.4	.37	.630	.073	.557	.268	0.289	.163	.096	.043	.024	.188		1.001	0.101	.511	1.142	0.022	.699	1.142		13 11/16	12 13/16	
8+10	.5	.30	.605	.073	.532	.197	0.335	.208	.123	.053	.032	.238		1.006	0.097	.441	1.147	0.027	.677	1.147		13 3/4	12 7/8	
+25	.6	.22	.525	.073	.462	.126	0.336	.227	.135	.057	.035	.260		1.018	0.076	.361	1.159	0.039	.621	1.159		13 15/16	13 1/16	
+40	.7	.15	.435	.073	.362	.055	0.307	.213	.128	.052	.033	.244		1.032	0.063	.291	1.173	0.053	.535	1.173		14 1/8	13 1/4	
+55	.8	.07	.275	.073	.202	69.984	0.218	.166	.100	.041	.025	.191		1.059	0.027	.411	1.400	0.280	.602	1.400		16 13/16	15 15/16	
+70	.9	.00	.085	.073	.012	.913	0.099	.091	.055	.022	.014	.104		1.092	-.005	.141	1.233	0.113	.245	1.233		14 13/16	13 15/16	
+85	5.0	70.92	69.915	.073	69.842	.842	0	0	0	0	0	0		1.328	0	.061	1.219	0.099	.061	1.219		14 5/8	13 3/4	

NORTH BRIDGE - SOUTH BOX LINE 2 NORTH FLANGE (CHART 3)

CHAINAGE	1. POINT	2. TOP OF CONC. ELEV.	3. TOP OF FLANGE ELEV.	4. FLANGE THICK.	5. BOT. OF FLANGE ELEV.	6. CHORD ELEV.	7. FIELD CAMBER (5-6) LESS V.C.	CAMBER 1					13. DESIGN HAUNCH MIN.	14. ACTUAL HAUNCH (2-5)+12	15. EXTRA CAMBER (7-12)	REVISED HAUNCH AND GRADE					21. V.C. CAMBER	22. REVISED HAUNCH IN INCHES	23. SCREED HEIGHT (22-4) IN INCHES	24. FIELD SCREED HEIGHT IN INCHES
								8. ΔT Δ A+B	9. ΔC Δ A	10. ΔC Δ B	11. ΔS Δ A	12. 1.2ΔT-ΔS				16. REVISED GRADE (3-4)+12	17. REVISED HAUNCH (16-5)+12	18. HAUNCH SHIM (17-13)	19. SCREED ELEV. (16+12)	20. HAUNCH CHECK (19-5)				
0+00	0.0	768.51	767.745	.073	767.672	767.472	0	0	0	0	0	0.522	1.088	0	768.651	0.979	0.057	768.651	0.979			11 3/4	10 7/8	
+15	.1	.68	68.000	.073	.927	.838	0.089	.091	.055	.022	.014	.104	0.857	-.015	.821	0.998	0.076	.925	0.998			12	11 1/8	
+30	.2	.85	.265	.073	68.192	68.003	0.189	.166	.100	.041	.025	.191	0.847	-.002	.991	0.990	0.068	69.182	0.990			11 7/8	11	
+46	.3	69.02	.490	.073	.417	.169	0.248	.213	.128	.052	.033	.244	0.847	-.004	69.161	0.988	0.066	.405	0.988			11 7/8	11	
+60	.4	.18	.675	.073	.602	.334	0.268	.227	.135	.057	.035	.260	0.838	0.008	.321	0.979	0.057	.581	0.979			11 3/4	10 7/8	
+75	.5	.35	.825	.073	.752	.490	0.262	.208	.123	.053	.032	.238	0.836	0.024	.491	0.977	0.055	.729	0.977			11 3/4	10 7/8	
+90	.6	.52	.940	.073	.867	.665	0.202	.163	.096	.043	.024	.188	0.841	0.019	.661	0.982	0.060	.849	0.982			11 3/4	10 7/8	
1+05	.7	.69	69.020	.073	.947	.831	0.116	.105	.061	.028	.016	.121	0.864	-.005	.831	1.005	0.083	.952	1.005			12 1/16	11 3/16	
+20	.8	.85	.135	.104	69.031	.996	0.035	.050	.027	.013	.010	.055	0.874	-.020	.991	1.015	0.093	70.046	1.015			12 3/16	10 15/16	
+35	.9	70.02	.345	.188	.157	67.162	-.005	.013	.007	.003	.003	.014	0.877	-.019	70.161	1.018	0.096	.175	1.018			12 1/4	10	
+50	1.0	.19	.515	.188	.327	.327	0	0	0	0	0	0	0.863	0	.331	1.004	0.082	.331	1.004			12 1/16	9 13/16	
+65.5	.1	.41	.760	.188	.572	.533	0.039	.032	.014	.011	.007	.035	0.873	0.004	.551	1.014	0.092	.586	1.014			12 3/16	9 15/16	
+89	.2	.63	.970	.104	.866	.732	0.127	.099	.049	.031	.019	.110	0.874	0.017	.771	1.015	0.093	.881	1.015			12 3/16	10 15/16	
2+08.5	.3	.84	70.300	.073	70.227	.945	0.282	.180	.098	.055	.027	.207	0.820	0.075	.981	0.961	0.039	71.188	0.961			11 1/2	10 9/8	
+28	.4	71.06	.615	.073	.542	70.151	0.391	.244	.136	.072	.036	.281	0.799	0.110	71.201	0.940	0.018	.482	0.940			11 5/16	10 7/16	
+47.5	.5	.28	.835	.073	.762	.357	0.405	.268	.150	.078	.040	.308	0.826	0.097	.421	0.967	0.045	.729	0.967			11 5/8	10 3/4	
+67	.6	.50	.970	.073	.897	.563	0.334	.243	.135	.071	.037	.279	0.882	0.055	.641	1.023	0.101	.920	1.023			12 5/16	11 7/16	
+86.5	.7	.71	71.015	.073	.942	.769	0.173	.176	.097	.053	.026	.203	0.971	-.030	.851	1.112	0.190	72.054	1.112			13 3/8	12 1/2	
3+06	.8	.92	.140	.104	71.036	.975	0.061	.096	.048	.030	.018	.107	0.991	-.046	72.062	1.133	0.211	.169	1.133			13 5/8	12 3/8	
+25.5	.9	72.10	.395	.188	.207	71.181	0.026	.030	.013	.010	.007	.032	0.925	-.004	.258	1.083	0.161	.290	1.083			13	11 3/4	
+45	2.0	.27	.575	.188	.387	.387	0	0	0	0	0	0	0.883	0	.433	1.046	0.129	.433	1.046	0		12 9/16	10 5/16	
+64.5	.1	.41	.780	.188	.592	.436	0.065	.026	.012	.008	.006	.028	0.846	0.037	.585	1.021	0.099	.613	1.021	.091		12 1/4	10	
+84	.2	.54	.915	.104	.811	.484	0.165	.087	.045	.026	.016	.097	0.826	0.068	.714	1.000	0.078	.811	1.000	.162		12	10 3/4	
4+03.5	.3	.64	72.115	.073	72.042	.532	0.294	.164	.092	.047	.025	.188	0.786	0.106	.822	0.968	0.046	73.010	0.968	.216		11 5/8	10 3/4	
+23	.4	.72	.310	.073	.237	.581	0.411	.227	.129	.064	.034	.261	0.744	0.150	.907	0.931	0.009	.168	0.931	.245		11 3/16	10 3/16	
+42.5	.5	.79	.395	.073	.322	.630	0.434	.251	.143	.070	.038	.288	0.756	0.146	.969	0.935	0.013	.257	0.935	.258		11 1/4	10 3/8	
+62	.6	.83	.380	.073	.307	.678	0.384	.227	.129	.064	.034	.261	0.784	0.123	73.010	0.964	0.042	.271	0.964	.245		11 1/2	10 5/8	
+81.5	.7	.85	.270	.073	.197	.727	0.254	.164	.092	.047	.025	.188	0.841	0.066	.027	1.018	0.096	.215	1.018	.216		12 1/4	11 3/8	
5+01	.8	.85	.170	.104	.066	.775	0.124	.087	.045	.026	.016	.097	0.881	0.027	.023	1.054	0.132	.120	1.054	.167		12 5/8	11 3/8	
+20.5	.9	.83	.145	.188	71.957	.824	0.042	.026	.012	.008	.006	.028	0.901	0.014	72.998	1.067	0.145	.024	1.067	.091		12 13/16	10 9/16	
+40	3.0	.79	.060	.188	.872	71.872	0	0	0	0	0	0	0.918	0	.947	1.075	0.153	72.947	1.075	0		12 15/16	10 11/16	
+59.5	.1	.73	.035	.188	.847	.784	0.063	.030	.013	.010	.007	.032	0.915	0.031	.876	1.061	0.139	.908	1.061			12 3/4	10 1/2	
+79	.2	.65	71.960	.104	.856	.697	0.159	.096	.048	.030	.018	.107	0.901	0.052	.791	1.042	0.120	.898	1.042			12 1/2	11 1/4	
+98.5	.3	.55	.975	.073	.902	.610	0.292	.176	.097	.053	.026	.203	0.851	0.089	.691	0.992	0.070	.894	0.992			11 5/16	11 1/16	
6+18	.4	.46	.960	.073	.887	.522	0.365	.243	.135	.071	.037	.279	0.852	0.086	.601	0.993	0.071	.880	0.993			11 5/16	11 1/16	
+37.5	.5	.36	.875	.073	.802	.435	0.367	.268	.150	.078	.040	.308	0.866	0.059	.501	1.007	0.085	.809	1.007			12 1/8	11 1/4	
+57	.6	.26	.730	.073	.657	.347	0.310	.244	.136	.072	.036	.281	0.884	0.029	.401	1.025	0.103	.682	1.025			12 5/16	11 7/16	

NORTH BRIDGE - SOUTH BOX LINE 2 NORTH FLANGE (CHART 3)

CHAINAGE	1. POINT	2. TOP OF CONC. ELEV.	3. TOP OF FLANGE ELEV.	4. FLANGE THICK.	5. BOT. OF FLANGE ELEV.	6. CHORD ELEV.	7. FIELD CAMBER (5-6) Less VC	CAMBER					13. DESIGN HAUNCH MIN	14. ACTUAL HAUNCH (1-5)+12	15. EXTRA CAMBER (7-12)	REVISED HAUNCH AND GRADE					21. VC CAMBER	22. REVISED HAUNCH IN INCHES	23. SCREED HEIGHT (22-4) IN INCHES	24. FIELD SCREED HEIGHT IN INCHES
								8. ΔT P A+B	9. ΔC P A	10. ΔC P B	11. ΔS P A	12. 1.3ΔT-ΔS				16. REVISED GRADE 13-A+12	17. REVISED HAUNCH (16-5)+12	18. HAUNCH SHIM (17-13)	19. SCREED ELEV. (16+12)	20. HAUNCH CHECK (19-5)				
6+76.5	3.7	772.16	771.915	.073	771.442	71.260	0.182	.180	.098	.055	.027	.207	0.922	0.925	-0.025	772.301	1.066	0.144	772.508	1.066		12 13/16	11 15/16	
+96	.8	.07	.315	.104	.211	.172	0.039	.099	.049	.031	.019	.110		0.969	-0.071	.211	1.110	0.188	.321	1.110		13 5/16	12 1/16	
7+15.5	.9	71.97	.225	.188	.037	.085	-.048	.032	.014	.011	.007	.035		0.933	-.083	.111	1.109	0.187	.146	1.109		13 3/8	11 1/8	
+35	4.0	.87	.115	.188	70.997	70.997	0	0	0	0	0	0		0.873	0	.011	1.014	0.092	.011	1.014		12 3/16	9 15/16	
+50	.1	.80	.085	.188	.897	.920	-.023	.013	.007	.003	.003	.014		0.917	-.037	71.941	1.058	0.136	71.955	1.058		12 11/16	10 7/16	
+65	.2	.72	.005	.104	.901	.842	.059	.050	.027	.013	.010	.055		0.874	0.004	.841	1.015	0.023	.916	1.015		12 3/16	10 15/16	
+80	.3	.65	.010	.073	.937	.765	.172	.105	.061	.028	.016	.121		0.834	0.051	.791	0.975	0.053	.912	0.975		11 1/16	10 13/16	
+95	.4	.57	.015	.073	.942	.687	.255	.163	.096	.043	.024	.188		0.816	0.067	.711	0.957	0.035	.899	0.957		11 1/2	10 3/8	
8+10	.5	.50	70.990	.073	.917	.610	.307	.208	.123	.053	.032	.238		0.821	0.069	.641	0.962	0.040	.879	0.962		11 9/16	10 11/16	
+25	.6	.42	.920	.073	.847	.532	.315	.227	.135	.057	.035	.260		0.853	0.055	.561	0.974	0.052	.821	0.974		11 1/16	10 13/16	
+40	.7	.35	.805	.073	.732	.455	.277	.213	.128	.052	.033	.244		0.862	0.033	.491	1.003	0.081	.735	1.003		12 1/16	11 3/16	
+55	.8	.27	.645	.073	.572	.377	.195	.166	.100	.041	.025	.191		0.889	0.004	.611	1.230	0.308	.802	1.230		14 3/4	13 3/8	
+70	.9	.20	.450	.073	.377	.300	.077	.091	.055	.022	.014	.104		0.927	-.027	.341	1.068	0.146	.445	1.068		12 13/16	11 15/16	
+85	5.0	.12	.295	.073	.222	.222	0	0	0	0	0	0		1.148	0	.261	1.039	0.117	71.261	1.039		12 1/2	11 3/8	

NORTH BRIDGE - SOUTH BOX LINE 2 SOUTH FLANGE. (CHART 4)

CHAINAGE	1. POINT	2. TOP OF CONC. ELEV.	3. TOP OF FLANGE ELEV.	4. FLANGE THICK.	5. BOT. OF FLANGE ELEV.	6. CHORD ELEV.	7. FIELD CAMBER (5-6) Less 1/4	CAMBER					13. DESIGN HAUNCH MIN.	14. ACTUAL HAUNCH (2-5)+12	15. EXTRA CAMBER (7-12)	REVISED HAUNCH AND GRADE					21. V.C. CAMBER	22. REVISED HAUNCH IN INCHES	23. SCREED HEIGHT (22-4) IN INCHES	24. FIELD SCREED HEIGHT IN INCHES
								8. ΔT P A+B	9. ΔC P A	10. ΔC P B	11. ΔS P A	12. 1.2ΔT-ΔS				16. REVISED GRADE 13-A*+2	17. REVISED HAUNCH (16-5)+12	18. HAUNCH SHIM (17-13)	19. SCREED ELEV. (16+12)	20. HAUNCH CHECK (19-5)				
0+00	0.0	768.71	767.705	.073	767.632	767.632	0	0	0	0	0	0	1.120	1.078	0	768.851	1.219	0.099	768.851	1.219		14 5/8	13 3/4	
+15	.1	.88	.965	.073	.892	.802	.090	.091	.055	.022	.014	.104		1.092	-.014	69.021	1.233	0.113	69.125	1.233		14 13/16	13 15/16	
+30	.2	69.05	68.250	.073	68.177	.971	.206	.166	.100	.041	.025	.191		1.064	-.015	.191	1.205	0.082	.382	1.205		14 1/2	13 5/8	
+46	.3	.22	.485	.073	.412	68.141	.271	.213	.128	.052	.033	.244		1.052	.027	.361	1.193	0.073	.605	1.193		14 5/16	13 7/16	
+60	.4	.38	.685	.073	.612	.310	.302	.227	.135	.057	.035	.260		1.028	.042	.521	1.169	0.049	.781	1.169		14	13 1/8	
+75	.5	.55	.825	.073	.752	.490	.272	.208	.123	.053	.032	.238		1.036	.034	.691	1.177	0.057	.929	1.177		14 1/8	13 1/4	
+90	.6	.72	.940	.073	.867	.650	.217	.163	.096	.043	.024	.188		1.041	.029	.861	1.182	0.062	70.049	1.182		14 3/16	13 5/16	
1+05	.7	.89	69.015	.073	.942	.819	.123	.105	.061	.028	.016	.121		1.069	.002	70.031	1.210	0.090	.152	1.210		14 1/2	13 5/8	
+20	.8	70.05	.135	.104	69.031	.989	.042	.050	.027	.013	.010	-.055		1.074	-.013	.191	1.215	0.095	.246	1.215		14 5/8	13 3/8	
+35	.9	.22	.355	.188	.167	69.158	.009	.013	.007	.003	.003	.014		1.067	-.005	.361	1.208	0.088	.375	1.208		14 1/2	12 1/4	
+50	1.0	.39	.515	.188	.327	.327	0	0	0	0	0	0		1.063	0	.531	1.204	0.084	.531	1.204		14 7/16	12 3/16	
+65.5	.1	.61	.790	.188	.602	.533	.069	.032	.014	.011	.007	.035		1.043	.034	.751	1.184	0.064	.786	1.184		14 3/16	11 5/16	
+89	.2	.83	70.015	.104	.911	.738	.173	.099	.049	.031	.019	.110		1.029	.063	.971	1.170	0.050	71.081	1.170		14 1/8	13 1/16	
2+08.5	.3	71.04	.320	.073	70.247	.944	.303	.180	.098	.055	.027	.207		1.000	.096	71.181	1.141	0.021	.388	1.141		13 1/16	12 3/16	
+28	.4	.26	.635	.073	.562	70.149	.413	.244	.136	.072	.036	.281		*0.979	.132	.401	1.120	0	.682	1.120		13 7/16	12 3/16	
+47.5	.5	.48	.865	.073	.792	.355	.437	.268	.150	.078	.040	.308		0.996	.129	.621	1.137	0.017	.929	1.137		13 5/8	12 3/4	
+67	.6	.70	71.005	.073	.932	.560	.372	.243	.135	.071	.037	.279		1.047	.093	.841	1.188	0.068	72.120	1.188		14 1/4	13 3/8	
+84.5	.7	.91	.065	.073	.992	.766	.226	.176	.097	.053	.026	.203		1.121	.023	72.051	1.262	0.142	.254	1.262		15 1/8	14 1/4	
3+06	.8	72.12	.165	.104	71.061	.971	.090	.096	.048	.030	.018	.107		1.166	-.017	.262	1.308	0.188	.369	1.308		15 1/16	14 7/16	
+25.5	.9	.30	.385	.188	.197	71.177	.020	.030	.013	.010	.007	.032		1.135	-.012	.458	1.293	0.173	.490	1.293		15 1/2	13 1/4	
+45	2.0	.47	.570	.188	.382	.382	0	0	0	0	0	0		1.088	0	.633	1.251	0.131	.633	1.251	0	15	12 3/4	
+64.5	.1	.61	.775	.188	.587	.430	.066	.026	.012	.008	.006	.028		1.051	.038	.785	1.226	0.106	.813	1.226	.091	14 3/4	12 1/2	
+84	.2	.74	.935	.104	.831	.477	.192	.087	.045	.026	.016	.097		1.006	.095	.914	1.180	0.060	73.011	1.180	.162	14 1/8	12 7/8	
4+03.5	.3	.84	72.155	.073	72.082	.525	.341	.164	.092	.047	.025	.188		0.946	.153	73.022	1.128	0.008	.210	1.128	.216	13 1/2	12 5/8	
+23	.4	.92	.323	.073	.250	.572	.433	.227	.129	.064	.034	.261		0.931	.172	.107	1.118	-.002	.368	1.118	.245	13 7/16	12 3/16	
+42.5	.5	.99	.410	.073	.337	.620	.459	.251	.143	.070	.038	.288		0.941	.171	.169	1.120	0	.457	1.120	.258	13 7/16	12 3/16	
+62	.6	73.03	.390	.073	.317	.667	.405	.227	.129	.064	.034	.261		0.974	.144	.210	1.154	0.034	.471	1.154	.245	13 7/8	13	
+81.5	.7	.05	.280	.073	.207	.715	.276	.164	.092	.047	.025	.188		1.031	.088	.227	1.208	0.088	.415	1.208	.216	14 1/2	13 5/8	
5+01	.8	.05	.160	.104	.056	.762	.127	.087	.045	.026	.016	.097		1.091	.030	.223	1.264	0.144	.320	1.264	.167	15 3/16	13 15/16	
+20.5	.9	.03	.130	.188	71.942	.810	.041	.026	.012	.008	.006	.028		1.116	.013	.196	1.282	0.162	.224	1.282	.091	15 3/8	13 1/8	
+40	3.0	72.99	.045	.188	.857	.857	0	0	0	0	0	0		1.133	0	.147	1.290	0.170	.147	1.290	0	15 1/2	13 1/4	
+59.5	.1	.93	.025	.188	.837	.766	0.071	.030	.013	.010	.007	.032		1.125	0.029	.076	1.271	0.151	.108	1.271		15 1/4	13	
+79	.2	.85	71.960	.104	.856	.674	.182	.096	.048	.030	.018	.107		1.101	.075	72.991	1.242	0.122	.098	1.242		14 15/16	13 1/16	
+98.5	.3	.75	.985	.073	.912	.583	.329	.176	.097	.053	.026	.203		1.041	.126	.891	1.182	0.062	.094	1.182		14 3/16	13 5/16	
6+18	.4	.66	.970	.073	.897	.491	.406	.243	.135	.071	.037	.279		1.042	.127	.801	1.183	0.063	.080	1.183		14 3/16	13 5/16	
+37.5	.5	.56	.895	.073	.822	.400	.422	.268	.150	.078	.040	.308		1.046	.114	.701	1.187	0.067	.009	1.187		14 1/4	13 3/8	
+57	.6	.46	.745	.073	.672	.308	.364	.244	.136	.072	.036	.281		1.069	.083	.601	1.210	0.090	72.882	1.210		14 1/2	13 3/4	

NORTH BRIDGE - SOUTH BOX LINE 2 SOUTH FLANGE. (CHART 4)

CHAINAGE	1. POINT	2. TOP OF CONC. ELEV.	3. TOP OF FLANGE ELEV.	4. FLANGE THICK.	5. BOT. OF FLANGE ELEV.	6. CHORD ELEV.	7. FIELD CAMBER (5-6)	CAMBER					13. DESIGN HAUNCH	14. ACTUAL HAUNCH (2-5)+12	15. EXTRA CAMBER (7-12)	REVISED HAUNCH AND GRADE					21. V.C. CAMBER	22. REVISED HAUNCH IN INCHES	SCREED HEIGHT (22-4) IN INCHES	FIELD SCREED HEIGHT IN INCHES
								8. ΔT Q A+B	9. ΔC Q A	10. ΔC Q B	11. (8-7) ΔS Q A	12. 1.3ΔT-ΔS				16. REVISED GRADE 13-14+2	17. REVISED HAUNCH (16-5)+12	18. HAUNCH SHIM (17-13)	19. SCREED ELEV. (16+12)	20. HAUNCH CHECK (19-5)				
6+76.5	3.7	772.36	771.530	.073	771.457	71.217	0.290	.180	.098	.055	.027	.207	1.120	1.110	0.033	772.501	1.251	0.131	772.708	1.251		15	13 7/8	
+96	.8	.27	.345	.104	.241	.125	.116	.099	.049	.031	.019	.110		1.139	.006	.411	1.280	0.160	.521	1.280		15 3/8	14 1/8	
7+15.5	.9	.17	.245	.188	.057	.834	.023	.032	.014	.011	.007	.035		1.148	-.012	.311	1.287	0.169	.346	1.289		15 1/2	13 1/4	
+35	4.0	.07	.130	.188	70.942	70.942	6	0	0	0	0	0		1.128	0	.211	1.269	0.149	.211	1.269		15 1/4	13	
+50	.1	.00	.090	.188	.902	.867	0.035	.013	.007	.003	.003	.014		1.112	0.021	.141	1.253	0.133	.155	1.253		15 1/16	12 13/16	
+65	.2	71.92	.015	.104	.911	.791	0.120	.050	.027	.013	.010	.055		1.064	0.065	.061	1.205	0.085	.116	1.205		14 1/2	13 1/4	
+80	.3	.85	.030	.073	.957	.716	0.241	.105	.061	.028	.016	.121		1.014	0.121	71.991	1.155	0.035	.112	1.155		13 7/8	13	
+95	.4	.77	.030	.073	.957	.640	0.317	.163	.096	.043	.024	.188		1.001	0.129	.911	1.142	0.022	.099	1.142		13 11/16	12 13/16	
8+10	.5	.70	70.990	.073	.917	.565	0.352	.208	.123	.053	.032	.238		1.021	0.114	.841	1.162	0.042	.079	1.162		13 15/16	13 1/16	
+25	.6	.62	.915	.073	.842	.489	0.353	.227	.135	.057	.035	.260		1.038	0.093	.761	1.179	0.059	.021	1.179		14 1/8	13 1/4	
+40	.7	.55	.805	.073	.732	.414	0.318	.213	.128	.052	.033	.244		1.062	0.074	.631	1.203	0.083	71.935	1.203		14 7/16	13 3/16	
+55	.8	.67	.655	.073	.582	.338	0.244	.166	.100	.041	.025	.191		1.277	0.053	.811	1.420	0.300	72.002	1.420		17 1/16	16 3/16	
+70	.9	.40	.490	.073	.417	.263	0.154	.091	.055	.022	.014	.104		1.087	0.050	.541	1.228	0.108	71.645	1.228		14 3/4	13 7/8	
+85	5.0	.32	.260	.073	70.187	70.187	0	0	0	0	0	0		1.133	0	.461	1.274	0.154	.461	1.274		15 5/16	14 7/16	

SOUTH BRIDGE - NORTH BOX LINE 3 NORTH FLANGE (CHART 5)

CHAINAGE	1. POINT	2. TOP OF CONC. ELEV.	3. TOP OF FLANGE ELEV.	4. FLANGE THICK.	5. BOT. OF FLANGE ELEV.	6. CHORD ELEV.	7. FIELD CAMBER (5-6) LESS V.C.	CAMBER					13. DESIGN HAUNCH	14. ACTUAL HAUNCH (1-5)+12	15. EXTRA CAMBER (7-12)	REVISED HAUNCH AND GRADE					21. V.C. CAMBER	22. REVISED HAUNCH IN INCHES	23. SCREED HEIGHT (22-4) IN INCHES	24. FIELD SCREED HEIGHT IN INCHES
								8. ΔT P A+B	9. ΔC P A	10. ΔC P B	11. ΔS P A	12. 1.3ΔT-ΔS				16. REVISED GRADE	17. REVISED HAUNCH (16-5)+12	18. HAUNCH SHIM (17-13)	19. SCREED ELEV. (16+12)	20. HAUNCH CHECK (19-5)				
0+00	0.0	768.634	767.625	.073	767.552	767.552	0	0	0	0	0	1.120	1.082	0	768.729	1.177	0.057	768.729	1.177			14 1/8	13 1/4	
+15	.1	.804	.900	.073	.827	.718	0.109	.091	.055	.022	.014	.104	1.081	0.005	.903	1.180	0.060	69.007	1.180			14 3/16	13 5/16	
+30	.2	.974	68.140	.073	68.067	.884	0.183	.166	.100	.041	.025	.191	1.098	-0.008	69.077	1.201	0.081	.268	1.201			14 7/16	13 9/16	
+46	.3	69.144	.360	.073	.287	68.050	0.237	.213	.128	.052	.033	.244	1.101	-0.007	.251	1.208	0.088	.495	1.208			14 1/2	13 5/8	
+60	.4	.304	.540	.073	.467	.216	0.251	.227	.135	.057	.035	.260	1.097	-0.009	.425	1.218	0.098	.685	1.218			14 5/8	13 3/4	
+75	.5	.474	.680	.073	.607	.382	0.225	.208	.123	.053	.032	.238	1.105	-0.013	.599	1.230	0.110	.837	1.230			14 3/4	13 7/8	
+90	.6	.644	.795	.073	.722	.548	0.174	.163	.076	.043	.024	.198	1.110	-0.014	.773	1.239	0.119	.961	1.239			14 7/8	14	
1+05	.7	.814	.875	.073	.802	.714	0.088	.105	.061	.028	.016	.121	1.133	-0.033	.947	1.266	0.146	70.068	1.266			15 3/16	14 5/16	
+20	.8	.974	69.000	.104	.896	.880	0.016	.030	.027	.013	.010	.055	1.133	-0.039	70.121	1.280	0.160	.176	1.280			15 3/8	14 1/8	
+35	.9	70.144	.235	.188	69.047	69.046	0.001	.013	.007	.003	.003	.014	1.111	-0.013	.295	1.262	0.142	.309	1.262			15 1/8	12 7/8	
+50	1.0	.314	.400	.188	.212	.212	0	0	0	0	0	0	1.102	0	.469	1.257	0.137	.469	1.257			15 1/16	12 3/16	
+65.5	.1	.534	.670	.188	.482	.422	0.060	.032	.014	.011	.007	.035	1.087	0.025	.695	1.248	0.128	.730	1.248			15	12 3/4	
+89	.2	.754	.905	.104	.801	.632	0.169	.099	.049	.031	.019	.110	1.063	0.059	.921	1.230	0.110	71.031	1.230			14 3/4	13 1/2	
2+08.5	.3	.964	70.240	.073	70.167	.842	0.325	.180	.098	.055	.027	.207	1.004	0.118	71.148	1.188	0.068	.355	1.188			14 1/4	13 3/8	
+28	.4	71.184	.540	.073	.467	70.052	0.415	.244	.136	.072	.036	.281	0.998	0.134	.374	1.188	0.068	.655	1.188			14 1/4	13 3/8	
+47.5	.5	.404	.775	.073	.702	.262	0.440	.268	.150	.078	.040	.308	1.010	0.132	.600	1.206	0.086	.908	1.206			14 1/2	13 5/8	
+67	.6	.624	.920	.073	.847	.472	0.375	.243	.135	.071	.037	.279	1.056	0.096	.826	1.258	0.138	72.105	1.258			15 1/8	14 1/4	
+86.5	.7	.834	.990	.073	.917	.682	0.235	.176	.097	.053	.026	.203	1.120	0.032	72.056	1.342	0.222	.259	1.342	0		16 1/8	15 1/4	
3+06	.8	72.044	71.090	.104	.986	.892	0.091	.096	.048	.030	.018	.107	1.165	-0.016	.261	1.382	0.262	.368	1.382	.003		16 9/16	15 5/16	
+25.5	.9	.224	.330	.188	71.142	71.102	0.034	.030	.013	.010	.007	.032	1.114	0.002	.444	1.334	0.214	.476	1.334	.006		16	13 3/4	
+45	2.0	.394	.500	.188	.312	.312	-0.009	0	0	0	0	0	1.082	-0.009	.605	1.293	0.173	.605	1.293	.009		15 1/2	13 1/4	
+64.5	.1	.534	.695	.188	.507	.351	0.065	.026	.012	.008	.006	.028	1.055	0.037	.744	1.265	0.145	.772	1.265	.091		15 3/16	12 15/16	
+84	.2	.664	.830	.104	.726	.389	0.175	.087	.045	.026	.016	.097	1.035	0.078	.861	1.232	0.112	.958	1.232	.162		14 13/16	13 9/16	
4+03.5	.3	.764	72.030	.073	.957	.428	0.313	.164	.092	.047	.025	.188	0.995	0.125	.966	1.197	0.077	73.154	1.197	.216		14 3/8	13 1/2	
+23	.4	.844	.230	.073	72.157	.466	0.446	.227	.129	.064	.024	.261	0.948	0.185	73.028	1.132	0.012	.289	1.132	.245		13 5/8	12 3/4	
+42.5	.5	.914	.320	.073	.247	.505	0.484	.251	.143	.070	.038	.288	0.955	0.196	.078	1.119	-0.001	.366	1.119	.258		13 7/16	12 9/16	
+62	.6	.954	.290	.073	.217	.543	0.429	.227	.129	.064	.034	.261	0.998	0.168	.106	1.150	0.030	.367	1.150	.245		13 13/16	12 15/16	
+81.5	.7	.974	.185	.073	.112	.582	0.366	.164	.092	.047	.025	.188	1.050	0.178	.113	1.189	0.069	.301	1.189	.216		14 5/16	13 7/16	
5+01	.8	.974	.060	.104	71.956	.620	0.169	.087	.045	.026	.016	.097	1.115	0.072	.097	1.238	0.118	.194	1.238	.167		14 7/8	13 5/8	
+20.5	.9	.954	.005	.188	.817	.659	0.067	.026	.012	.008	.006	.028	1.165	0.039	.058	1.269	0.149	.086	1.269	.091		15 1/4	13	
+40	3.0	.914	71.885	.188	.697	.697	-0.009	0	0	0	0	0	1.217	-0.009	72.998	1.301	0.181	72.998	1.301	.009		15 5/8	13 3/8	
+59.5	.1	.854	.830	.188	.642	.607	0.030	.030	.013	.010	.007	.032	1.244	-0.002	.912	1.302	0.182	.944	1.302	.005		15 5/8	13 3/8	
+79	.2	.774	.750	.104	.646	.516	0.130	.096	.048	.030	.018	.107	1.235	0.023	.816	1.277	0.157	.923	1.277	0		15 5/16	14 1/16	
+98.5	.3	.674	.780	.073	.707	.426	0.281	.176	.097	.053	.026	.203	1.170	0.078	.716	1.212	0.092	.919	1.212			14 9/16	13 11/16	
6+18	.4	.584	.795	.073	.722	.335	0.387	.243	.135	.071	.037	.279	1.141	0.108	.626	1.183	0.063	.905	1.183			14 3/16	13 5/16	
+37.5	.5	.484	.730	.073	.657	.245	0.412	.268	.150	.078	.040	.308	1.135	0.104	.526	1.177	0.057	.834	1.177			14 1/8	13 1/4	
+57	.6	.384	.590	.073	.517	.154	0.363	.244	.136	.072	.036	.281	1.148	0.082	.426	1.190	0.070	.707	1.190			14 5/16	13 7/16	

SOUTH BRIDGE - NORTH BOX : LINE 3 NORTH FLANGE (CHART 5)

CHAINAGE	1. POINT	2. TOP OF CONC. ELEV.	3. TOP OF FLANGE ELEV.	4. FLANGE THICK.	5. BOT. OF FLANGE ELEV.	6. CHORD ELEV.	7. FIELD CAMBER (5-6)	CAMBER					13. DESIGN HAUNCH	14. ACTUAL HAUNCH (1-5)+12	15. EXTRA CAMBER (7-12)	REVISED HAUNCH AND GRADE					21. V.C. CAMBER	22. REVISED HAUNCH IN INCHES	23. SCREED HEIGHT (22-4) IN INCHES	24. FIELD SCREED HEIGHT IN INCHES	
								8. ΔT R A+B	9. ΔC R A	10. ΔC R B	11. ΔS R A	12. 1.3ΔT-ΔS				16. REVISED GRADE (12-12)+12	17. REVISED HAUNCH (16-5)+12	18. HAUNCH SHIM (17-13)	19. SCREED ELEV. (16+12)	20. HAUNCH CHECK (19-5)					
6+76.5	3.7	72.284	71.375	.073	71.302	71.064	0.238	.180	.098	.055	.027	.207	1.120	1.189	0.031	72.326	1.231	0.111	72.533	1.231		14 3/4	13 7/8		
+96	.8	.194	.170	.104	.066	70.973	0.093	.099	.049	.031	.019	.110		1.238	-0.017	.226	1.270	0.150	.336	1.270		15 1/4	14		
7+15.5	.9	.094	.090	.188	70.902	.883	0.019	.032	.014	.011	.007	.035		1.227	-0.016	.136	1.269	0.149	.171	1.269		15 1/4	13		
+35	4.0	71.994	70.980	.188	.792	.792	0	0	0	0	0	0		1.202	0	.036	1.244	0.124	.036	1.244		14 15/16	12 1/16		
+50	.1	.924	.940	.188	.752	.717	0.035	.013	.007	.003	.003	.014		1.186	0.021	71.966	1.228	0.108	71.980	1.228		14 3/4	12 1/2		
+65	.2	.844	.860	.104	.756	.641	0.115	.050	.027	.013	.010	.055		1.143	0.060	.886	1.185	0.065	.941	1.185		14 1/4	13		
+80	.3	.774	.860	.073	.787	.566	0.221	.105	.061	.028	.016	.121		1.108	0.100	.816	1.150	0.030	.937	1.150		13 13/16	12 15/16		
+95	.4	.694	.875	.073	.802	.490	0.312	.163	.096	.043	.024	.188		1.080	0.124	.736	1.122	0.002	.924	1.122		13 7/16	12 9/16		
8+10	.5	.624	.840	.073	.767	.415	0.352	.208	.123	.053	.032	.238		1.095	0.114	.666	1.137	0.017	.904	1.137		13 5/8	12 3/4		
+25	.6	.544	.785	.073	.712	.339	0.373	.227	.135	.057	.035	.260		1.092	0.113	.586	1.134	0.014	.846	1.134		13 5/8	12 3/4		
+40	.7	.474	.670	.073	.597	.264	0.333	.213	.128	.052	.033	.244		1.121	0.089	.516	1.163	0.043	.760	1.163		13 5/16	13 1/16		
+55	.8	.394	.510	.073	.437	.188	0.249	.166	.100	.041	.025	.191		1.148	0.058	.436	1.190	0.070	.627	1.190		14 1/4	13 3/8		
+70	.9	.324	.330	.073	.257	.113	0.144	.091	.055	.022	.014	.104		1.171	0.040	.366	1.213	0.093	.470	1.213		14 9/16	13 1/16		
+85	5.0	71.244	70.110	.073	70.037	70.037	0	0	0	0	0	0		1.207	0	.286	1.249	0.129	.286	1.249		15	14 1/8		

SOUTH BRIDGE - NORTH BOX LINE 3 SOUTH FLANGE (CHART 6)

CHAINAGE	1. POINT	2. TOP OF CONC. ELEV.	3. TOP OF FLANGE ELEV.	4. FLANGE THICK.	5. BOT. OF FLANGE ELEV.	6. CHORD ELEV.	7. FIELD CAMBER (5-6) LESS V.C.	CAMBER					13. DESIGN HAUNCH	14. ACTUAL HAUNCH (1-5)-12	15. EXTRA CAMBER (7-12)	REVISED HAUNCH AND GRADE					21. V.C. CAMBER	22. REVISED HAUNCH IN INCHES	23. SCREED HEIGHT (22-4) IN INCHES	24. FIELD SCREED HEIGHT IN INCHES	
								8. ΔT ΔA+B	9. ΔC ΔA	10. ΔC ΔB	11. ΔS ΔA	12. ΔT-ΔS				16. REVISED GRADE (1-5)+12	17. REVISED HAUNCH (16-5)+12	18. HAUNCH SHIM (17-13)	19. SCREED ELEV. (16+12)	20. HAUNCH CHECK (19-5)					
0+00	0.0	768.434	767.680	.073	767.607	767.607	0	0	0	0	0	0	0.922	0.827	0	768.529	0.922	0.000	768.529	0.922			11 1/16	10 3/16	
+15	.1	.604	.915	.073	.842	.767	0.075	.091	.055	.022	.014	.104		0.866	-0.029	.703	0.965	0.043	.807	0.965			11 9/16	10 11/16	
+30	.2	.774	68.175	.073	68.102	.926	0.176	.166	.100	.041	.025	.121		0.863	-0.015	.877	0.966	0.044	69.068	0.966			11 5/8	10 3/4	
+46	.3	.944	.395	.073	.322	68.086	0.236	.213	.128	.052	.033	.244		0.866	-0.008	69.051	0.973	0.051	.295	0.973			11 11/16	10 13/16	
+60	.4	69.104	.580	.073	.507	.245	0.262	.227	.135	.057	.035	.260		0.857	0.002	.225	0.978	0.056	.485	0.978			11 3/4	10 7/8	
+75	.5	.274	.720	.073	.647	.405	0.242	.208	.123	.053	.032	.238		0.865	0.004	.399	0.990	0.068	.637	0.990			11 7/8	11	
+90	.6	.444	.845	.073	.772	.564	0.208	.163	.096	.043	.024	.198		0.860	0.020	.573	0.989	0.067	.761	0.989			11 7/8	11	
1+05	.7	.614	.930	.073	.857	.724	0.133	.105	.061	.028	.016	.121		0.878	0.012	.747	1.011	0.089	.868	1.011			12 1/8	11 1/4	
+20	.8	.774	69.030	.104	.926	.883	0.043	.050	.027	.013	.010	.055		0.903	-0.012	.921	1.050	0.128	.976	1.050			12 5/8	11 3/8	
+35	.9	.944	.230	.188	69.042	69.043	-0.001	.013	.007	.003	.003	.014		0.916	-0.015	70.095	1.067	0.145	70.109	1.067			12 13/16	10 9/16	
+50	1.0	70.114	.390	.188	.202	.202	0	0	0	0	0	0		0.912	0	.269	1.067	0.145	.269	1.067			12 13/16	10 9/16	
+65.5	.1	.334	.690	.188	.502	.413	0.089	.032	.014	.011	.007	.035		0.867	0.054	.495	1.028	0.106	.530	1.028			12 5/16	10 1/16	
+89	.2	.554	.940	.104	.836	.624	0.212	.099	.049	.031	.019	.110		0.828	0.102	.721	0.995	0.073	.831	0.995			11 15/16	10 1/16	
2+08.5	.3	.764	70.280	.073	70.207	.835	0.372	.180	.098	.055	.027	.207		0.764	0.165	.948	0.948	0.026	71.155	0.948			11 3/8	10 1/2	
+28	.4	.984	.580	.073	.507	70.046	0.461	.244	.136	.072	.036	.281		0.758	0.180	71.174	0.948	0.026	.455	0.948			11 3/8	10 1/2	
+47.5	.5	71.204	.810	.073	.737	.257	0.480	.268	.150	.078	.040	.308		0.775	0.172	.400	0.971	0.049	.708	0.971			11 1/16	11 13/16	
+67	.6	.424	.960	.073	.887	.468	0.419	.243	.135	.071	.037	.279		0.816	0.140	.626	1.018	0.096	.905	1.018			12 1/4	11 5/8	
+86.5	.7	.634	71.020	.073	.947	.679	0.268	.176	.097	.053	.026	.203		0.890	0.065	.856	1.112	0.190	72.059	1.112	0		13 3/8	12 1/2	
3+06	.8	.844	.115	.104	71.011	.890	0.118	.096	.048	.030	.018	.107		0.940	0.011	72.061	1.157	0.235	.168	1.157	.003		13 7/8	12 5/8	
+25.5	.9	72.024	.325	.188	.137	71.101	0.030	.030	.013	.010	.007	.032		0.919	-0.002	.244	1.139	0.217	.276	1.139	.006		13 1/16	11 7/16	
+45	2.0	.194	.500	.188	.312	.312	-0.009	0	0	0	0	0		0.882	-0.009	.405	1.093	0.171	.405	1.093	.009		13 1/8	10 7/8	
+64.5	.1	.334	.710	.188	.522	.352	0.079	.026	.012	.008	.006	.028		0.840	0.051	.544	1.050	0.128	.572	1.050	.091		12 5/8	10 3/8	
+84	.2	.464	.820	.104	.716	.392	0.162	.087	.045	.026	.016	.097		0.845	0.065	.661	1.042	0.120	.758	1.042	.162		12 1/2	11 1/4	
4+03.5	.3	.564	72.020	.073	.947	.432	0.299	.164	.092	.047	.025	.188		0.805	0.111	.766	1.007	0.085	.954	1.007	.216		12 1/16	11 3/16	
+23	.4	.644	.220	.073	72.147	.472	0.430	.227	.129	.064	.024	.261		0.758	0.169	.828	0.942	0.020	73.089	0.942	.245		11 5/16	10 7/16	
+42.5	.5	.714	.300	.073	.227	.512	0.457	.251	.143	.070	.038	.288		0.775	0.169	.878	0.939	0.017	.166	0.939	.258		11 1/4	10 5/8	
+62	.6	.754	.305	.073	.232	.552	0.435	.227	.129	.064	.034	.261		0.783	0.174	.906	0.935	0.013	.167	0.935	.245		11 1/4	10 5/8	
+81.5	.7	.774	.210	.073	.137	.592	0.329	.164	.092	.047	.025	.188		0.825	0.141	.913	0.964	0.042	.101	0.964	.216		11 9/16	10 11/16	
5+01	.8	.774	.065	.104	71.961	.632	0.162	.087	.045	.026	.016	.097		0.910	0.065	.897	1.033	0.111	72.994	1.033	.167		12 3/8	11 1/8	
+20.5	.9	.754	.005	.188	.817	.672	0.054	.026	.012	.008	.006	.028		0.965	0.026	.858	1.069	0.147	.886	1.069	.091		12 13/16	10 7/16	
+40	3.0	.714	71.900	.188	.712	71.712	-0.009	0	0	0	0	0		1.002	-0.009	.798	1.086	0.164	.798	1.086	.009		13 1/16	10 13/16	
+59.5	.1	.654	.850	.188	.662	.623	0.034	.030	.013	.010	.007	.032		1.024	0.002	.712	1.082	0.160	.744	1.082	.005		13	10 3/4	
+79	.2	.574	.760	.104	.656	.533	0.123	.096	.048	.030	.018	.107		1.025	0.016	.616	1.067	0.145	.723	1.067	0		12 13/16	11 7/16	
+98.5	.3	.474	.780	.073	.707	.444	0.263	.176	.097	.053	.026	.203		0.970	0.060	.516	1.012	0.090	.719	1.012			12 1/8	11 1/4	
6+18	.4	.384	.790	.073	.717	.354	0.363	.243	.135	.071	.037	.279		0.946	0.084	.426	0.988	0.066	.705	0.988			11 7/8	11	
+37.5	.5	.284	.735	.073	.662	.265	0.397	.268	.150	.078	.040	.308		0.930	0.089	.326	0.972	0.050	.634	0.972			11 11/16	10 13/16	
+57	.6	.184	.595	.073	.522	.175	0.347	.244	.136	.072	.036	.281		0.943	0.066	.226	0.985	0.063	.507	0.985			11 13/16	10 15/16	

SOUTH BRIDGE - NORTH BOX LINE 3 SOUTH FLANGE (CHART 6)

CHAINAGE	1. POINT	2. TOP OF CONC. ELEV.	3. TOP OF FLANGE ELEV.	4. FLANGE THICK.	5. BOT. OF FLANGE ELEV.	6. CHORD ELEV.	7. FIELD CAMBER (5-6)	CAMBER					13. DESIGN HAUNCH	14. ACTUAL HAUNCH (1-5)+12	15. EXTRA CAMBER (7-12)	REVISED HAUNCH AND GRADE					21. V.C. CAMBER	22. REVISED HAUNCH IN INCHES	23. SCREED HEIGHT (22-4) IN INCHES	24. FIELD SCREED HEIGHT IN INCHES
								8. ΔT ΔA+B	9. ΔC ΔA	10. ΔC ΔB	11. ΔS ΔA	12. 1.3ΔT-ΔS				16. REVISED GRADE (13-14)+12	17. REVISED HAUNCH (16-5)+12	18. HAUNCH SHIM (17-13)	19. SCREED ELEV. (16+12)	20. HAUNCH CHECK (19-5)				
6+76.5	3.7	72.084	71.380	.073	71.307	71.086	0.221	.180	.028	.055	.027	.207	0.922	0.984	0.014	72.126	1.026	0.104	72.333	1.026		12.5/16	11 7/16	
+96	.8	71.994	.190	.104	.086	70.996	0.090	.099	.049	.031	.019	.110		1.018	-0.020	.026	1.050	0.128	.136	1.050		12 5/8	11 1/8	
7+15.5	.9	.894	.120	.188	.932	.907	0.025	.032	.014	.011	.007	.035		0.997	-0.010	71.936	1.039	0.117	71.971	1.039		12 1/2	10 1/4	
+35	4.0	.794	.005	.188	.817	70.817	0	0	0	0	0	0		0.977	0	.836	1.019	0.097	.836	1.019		12 1/4	10	
+50	.1	.724	70.960	.188	.772	.748	0.024	.013	.007	.003	.003	.014		0.966	0.010	.766	1.008	0.086	.780	1.008		12 1/8	9 7/8	
+65	.2	.644	.870	.104	.766	.678	0.088	.050	.027	.013	.010	.055		0.933	0.033	.686	0.975	0.053	.741	0.975		11 1/16	10 7/16	
+80	.3	.574	.870	.073	.797	.609	0.188	.105	.061	.028	.016	.121		0.898	0.067	.616	0.940	0.018	.737	0.940		11 5/16	10 7/16	
+95	.4	.494	.875	.073	.802	.539	0.263	.163	.096	.043	.024	.188		0.880	0.075	.536	0.922	0.000	.724	0.922		11 1/16	10 3/16	
8+10	.5	.424	.850	.073	.777	.470	0.307	.208	.123	.053	.032	.238		0.885	0.069	.466	0.927	0.005	.704	0.927		11 1/8	10 1/4	
+25	.6	.344	.780	.073	.707	.400	0.307	.227	.135	.057	.035	.260		0.897	0.047	.386	0.939	0.017	.646	0.939		11 1/4	10 3/8	
+40	.7	.274	.685	.073	.612	.331	0.281	.213	.128	.052	.033	.244		0.906	0.037	.316	0.948	0.026	.560	0.948		11 3/8	10 1/2	
+55	.8	.194	.530	.073	.457	.261	0.196	.166	.100	.041	.025	.191		0.928	0.005	.236	0.970	0.048	.427	0.970		11 5/8	10 3/8	
+70	.9	.124	.355	.073	.282	.192	0.090	.091	.055	.022	.014	.104		0.946	-0.014	.166	0.988	0.066	.270	0.988		11 7/8	11	
+85	5.0	71.044	70.195	.073	.122	70.122	0	0	0	0	0	0		0.922	0	71.086	0.964	0.042	71.086	0.964		11 9/16	10 11/16	

SOUTH BRIDGE - SOUTH BOX LINE 4 NORTH FLANGE (CHART 7)

CHAINAGE	1. POINT	2. TOP OF CONC. ELEV.	3. TOP OF FLANGE ELEV.	4. FLANGE THICK.	5. BOT. OF FLANGE ELEV.	6. CHORD ELEV.	7. FIELD CAMBER (5-6) LESS V.C.	CAMBER					13. DESIGN HAUNCH	14. ACTUAL HAUNCH (1-5)+12	15. EXTRA CAMBER (7-12)	REVISED HAUNCH AND GRADE					21. V.C. CAMBER	22. REVISED HAUNCH IN INCHES	23. SCREED HEIGHT (22-4) IN INCHES	24. FIELD SCREED HEIGHT IN INCHES
								8. ΔT Δ A+B	9. ΔC Δ A	10. ΔC Δ B	11. ΔS Δ A	12. ΔT-ΔS				16. REVISED GRADE (3-4)+12	17. REVISED HAUNCH (16-5)+12	18. HAUNCH SHIM (17-13)	19. SCREED ELEV. (16+12)	20. HAUNCH CHECK (19-5)				
0+00	0.0	768.234	767.265	.073	767.192	767.192	0	0	0	0	0	0	1.120	1.042	0	768.329	1.137	0.017	768.329	1.137		13 5/8	12 3/4	
+15	.1	.404	.520	.073	.447	.355	0.092	.091	.055	.022	.014	.104		1.061	-0.012	.503	1.160	0.040	.607	1.160		13 5/16	13 1/16	
+30	.2	.574	.780	.073	.707	.518	0.189	.166	.100	.041	.025	.191		1.058	-0.002	.677	1.161	0.041	.868	1.161		13 5/16	13 1/16	
+46	.3	.744	68.000	.073	.927	.681	0.246	.213	.128	.052	.033	.244		1.061	0.002	.851	1.168	0.048	69.095	1.168		14	13 1/8	
+60	.4	.904	.185	.073	68.112	.844	0.268	.227	.135	.057	.035	.260		1.052	0.008	69.025	1.173	0.053	.285	1.173		14 1/16	13 3/16	
+75	.5	69.074	.340	.073	.267	68.007	0.260	.208	.123	.053	.032	.238		1.045	0.022	.199	1.170	0.050	.437	1.170		14 1/16	13 3/16	
+90	.6	.244	.455	.073	.382	.170	0.212	.163	.076	.043	.024	.198		1.050	0.024	.373	1.179	0.059	.561	1.179		14 1/8	13 1/4	
1+05	.7	.414	.525	.073	.452	.333	0.119	.105	.061	.028	.016	.121		1.083	-0.002	.547	1.216	0.096	.668	1.216		14 5/8	13 3/4	
+20	.8	.574	.625	.104	.521	.496	0.025	.050	.027	.013	.010	.055		1.108	-0.030	.721	1.255	0.135	.776	1.255		15 1/16	13 13/16	
+35	.9	.744	.835	.188	.647	.659	-0.012	.013	.007	.003	.003	.014		1.111	-0.026	.895	1.262	0.142	.909	1.262		15 1/8	12 7/8	
+50	1.0	.914	69.010	.188	.822	.822	0	0	0	0	0	0		1.092	0	70.069	1.247	0.127	70.069	1.247		15	12 3/4	
+65.5	.1	70.134	.300	.188	69.112	69.031	0.081	.032	.014	.011	.007	.035		1.057	0.046	.295	1.218	0.098	.330	1.218		14 5/8	12 3/8	
+89	.2	.354	.555	.104	.451	.240	0.211	.099	.049	.031	.019	.110		1.013	0.101	.521	1.180	0.060	.631	1.180		14 3/16	12 5/16	
2+08.5	.3	.564	.905	.073	.832	.449	0.383	.180	.098	.055	.027	.207		0.939	0.176	.748	1.123	0.003	.955	1.123		13 1/2	12 5/8	
+28	.4	.784	70.200	.073	70.127	.658	0.469	.244	.136	.072	.036	.281		0.938	0.188	.974	1.128	0.008	71.255	1.128		13 9/16	12 1/16	
+47.5	.5	71.004	70.410	.073	.337	.867	0.470	.268	.150	.078	.040	.308		0.975	0.162	71.200	1.171	0.051	.508	1.171		14 1/16	13 3/16	
+67	.6	.224	.545	.073	.472	70.076	0.396	.243	.135	.071	.037	.279		1.031	0.117	.426	1.233	0.113	.705	1.233		14 13/16	13 5/16	
+86.5	.7	.434	.600	.073	.527	.285	0.242	.176	.097	.053	.026	.203		1.110	0.039	.656	1.332	0.212	.859	1.332	0	16	15 1/8	
3+06	.8	.644	.695	.104	.591	.494	0.094	.096	.048	.030	.018	.107		1.160	-0.013	.861	1.377	0.257	.968	1.377	.003	16 9/16	15 5/16	
+25.5	.9	.824	.935	.188	.747	.703	0.038	.030	.013	.010	.007	.032		1.109	0.006	72.044	1.329	0.209	72.076	1.329	.006	15 5/16	13 1/16	
+45	2.0	.994	71.100	.188	.912	.912	-0.009	0	0	0	0	0		1.082	-0.009	.205	1.293	0.173	.205	1.293	.009	15 1/2	13 1/4	
+64.5	.1	72.134	.300	.188	71.112	.953	0.068	.026	.012	.008	.006	.028		1.050	0.040	.344	1.260	0.140	.372	1.260	.091	15 1/8	12 7/8	
+84	.2	.264	.445	.104	.341	.994	0.185	.087	.045	.026	.016	.097		1.020	0.080	.461	1.217	0.097	.558	1.217	.162	14 5/8	13 3/8	
4+03.5	.3	.364	.640	.073	.567	71.035	0.316	.164	.092	.047	.025	.188		0.985	0.128	.566	1.187	0.067	.754	1.187	.216	14 1/4	13 3/8	
+23	.4	.444	.820	.073	.747	.076	0.426	.227	.129	.064	.034	.261		0.958	0.165	.628	1.142	0.022	.889	1.142	.245	13 11/16	12 13/16	
+42.5	.5	.514	.890	.073	.817	.117	0.442	.251	.143	.070	.038	.288		0.985	0.154	.678	1.149	0.029	.966	1.149	.258	13 13/16	12 5/16	
+62	.6	.554	.850	.073	.777	.158	0.374	.227	.129	.064	.034	.261		1.038	0.113	.706	1.190	0.070	.967	1.190	.245	14 5/16	13 7/16	
+81.5	.7	.574	.735	.073	.662	.199	0.247	.164	.092	.047	.025	.188		1.100	0.059	.713	1.239	0.119	.901	1.239	.216	14 7/8	14	
5+01	.8	.574	.630	.104	.526	.240	0.119	.087	.045	.026	.016	.097		1.145	0.022	.697	1.268	0.148	.794	1.268	.167	15 1/4	14	
+20.5	.9	.554	.595	.188	.407	.281	0.035	.026	.012	.008	.006	.028		1.175	0.007	.658	1.279	0.159	.686	1.279	.091	15 3/8	13 1/8	
+40	3.0	.514	.510	.188	.322	.322	-0.009	0	0	0	0	0		1.192	-0.009	.598	1.276	0.156	.598	1.276	.009	15 5/16	13 1/16	
+59.5	.1	.454	.465	.188	.277	.232	0.040	.030	.013	.010	.007	.032		1.209	0.008	.512	1.267	0.147	.544	1.267	.005	15 3/16	12 5/16	
+79	.2	.374	.375	.104	.271	.141	0.130	.096	.048	.030	.018	.107		1.210	0.023	.416	1.252	0.132	.523	1.252	0	15	13 3/4	
+98.5	.3	.274	.400	.073	.327	.051	0.276	.176	.097	.053	.026	.203		1.150	0.073	.316	1.192	0.072	.519	1.192		14 5/16	13 7/16	
6+18	.4	.184	.410	.073	.337	70.960	0.377	.243	.135	.071	.037	.279		1.126	0.098	.226	1.168	0.048	.505	1.168		14	13 1/8	
+37.5	.5	.084	.360	.073	.287	.870	0.417	.268	.150	.078	.040	.308		1.105	0.109	.126	1.147	0.027	.434	1.147		13 3/4	12 7/8	
+57	.6	71.984	.210	.073	.137	.779	0.358	.244	.136	.072	.036	.281		1.128	0.077	.026	1.170	0.050	.307	1.170		14 1/16	13 3/16	

SOUTH BRIDGE - SOUTH BOX LINE 4 NORTH FLANGE (CHART 7)


CHAINAGE	1. POINT	2. TOP OF CONC. ELEV.	3. TOP OF FLANGE ELEV.	4. FLANGE THICK.	5. BOT. OF FLANGE ELEV.	6. CHORD ELEV.	7. FIELD CAMBER (5-6)	CAMBER					13. DESIGN HAUNCH	14. ACTUAL HAUNCH (1-5)+12	15. EXTRA CAMBER (7-12)	REVISED HAUNCH AND GRADE					21. V.C. CAMBER	22. REVISED HAUNCH IN INCHES	SCREED HEIGHT (22-4) IN INCHES	FIELD SCREED HEIGHT IN INCHES
								8. ΔT P A+B	9. ΔC P A	10. ΔC P B	11. ΔS P A	12. 1.3ΔT-ΔS				16. REVISED GRADE (1-5)+12	17. REVISED HAUNCH (16-5)+12	18. HAUNCH SHIM (17-13)	19. SCREED ELEV. (16+12)	20. HAUNCH CHECK (19-5)				
6+74.5	3.7	71.884	71.000	.073	70.927	70.689	0.238	.180	.028	.055	.027	.207	1.120	1.164	0.031	771.926	1.206	0.086	772.133	1.206		14 1/2	13 5/8	
+96	.8	.794	70.815	.104	.711	.598	0.113	.099	.049	.031	.019	.110		1.193	0.003	.826	1.225	0.105	71.936	1.225		14 1/16	13 7/16	
7+15.5	.9	.694	.730	.188	.542	.508	0.034	.032	.014	.011	.007	.035		1.187	-0.001	.736	1.229	0.109	.771	1.229		14 3/4	12 1/2	
+35	4.0	.594	.605	.188	.417	.417	0	0	0	0	0	0		1.177	0	.636	1.219	0.099	.636	1.219		14 5/8	12 3/8	
+50	.1	.524	.540	.188	.352	.347	0.005	.013	.007	.003	.003	.014		1.186	-0.009	.566	1.228	0.108	.580	1.228		14 3/4	12 1/2	
+65	.2	.444	.430	.104	.326	.276	0.050	.050	.027	.013	.010	.055		1.173	-0.005	.486	1.215	0.095	.541	1.215		14 9/16	13 5/16	
+80	.3	.374	.410	.073	.337	.206	0.131	.105	.061	.028	.016	.121		1.158	0.010	.416	1.200	0.080	.537	1.200		14 7/16	13 3/16	
+95	.4	.294	.455	.073	.382	.135	0.274	.163	.096	.043	.024	.188		1.100	0.086	.336	1.142	0.022	.524	1.142		13 11/16	12 13/16	
8+10	.5	.224	.440	.073	.367	.065	0.302	.208	.123	.053	.032	.238		1.095	0.064	.266	1.137	0.017	.504	1.137		13 5/8	12 3/4	
+25	.6	.144	.390	.073	.317	69.994	0.323	.227	.135	.057	.035	.260		1.087	0.063	.186	1.129	0.009	.446	1.129		13 9/16	12 11/16	
+40	.7	.074	.290	.073	.217	.924	0.293	.213	.128	.052	.033	.244		1.101	0.049	.116	1.143	0.023	.360	1.143		13 3/4	12 7/8	
+55	.8	70.994	.140	.073	.067	.853	0.214	.166	.100	.041	.025	.191		1.118	0.023	.036	1.160	0.040	.227	1.160		13 15/16	13 1/16	
+70	.9	.924	69.960	.073	69.887	.783	0.104	.091	.055	.022	.014	.104		1.141	0	70.966	1.183	0.063	.070	1.183		14 3/16	13 5/16	
+85	5.0	70.844	70.785	.073	69.712	69.712	0	0	0	0	0	0		1.132	0	70.886	1.174	0.054	70.886	1.174		14 1/16	13 3/16	

SOUTH BRIDGE - SOUTH BOX LINE 4 SOUTH FLANGE (CHART B)

CHAINAGE	1. POINT	2. TOP OF CONC. ELEV.	3. TOP OF FLANGE ELEV.	4. FLANGE THICK.	5. BOT. OF FLANGE ELEV.	6. CHORD ELEV.	7. FIELD CAMBER (5-6)	CAMBER					13. DESIGN HAUNCH	14. ACTUAL HAUNCH (1-5)+12	15. EXTRA CAMBER (7-12)	REVISED HAUNCH AND GRADE					21. V.C. CAMBER	22. REVISED HAUNCH IN INCHES	23. SCREED HEIGHT (22-4) IN INCHES	24. FIELD SCREED HEIGHT IN INCHES
								8. ΔT R Δ+B	9. ΔC R A	10. ΔC R B	11. ΔS R A	12. 1.3ΔT-ΔS				16. REVISED GRADE 12-22+2	17. REVISED HAUNCH (16-5)+12	18. HAUNCH SHIM (17-13)	19. SCREED ELEV. (16+12)	20. HAUNCH CHECK (19-5)				
6+76.5	3.7	71.684	71.010	.073	70.937	70.656	0.281	.180	.098	.055	.027	.207	0.922	0.954	0.074	71.726	0.996	0.074	71.933	0.996		12	11 1/8	
+96	.8	.594	70.805	.104	.701	.566	0.135	.099	.049	.031	.019	.110		1.003	0.026	.626	1.035	0.113	.736	1.035		12 7/16	11 3/16	
7+15.5	.9	.494	.715	.188	.527	.477	0.050	.032	.014	.011	.007	.035		1.002	0.016	.536	1.044	0.122	.571	1.044		12 1/2	10 1/4	
+35	4.0	.394	.575	.188	.387	.387	0	0	0	0	0	0		1.007	0	.436	1.049	0.127	.436	1.049		12 3/16	10 5/16	
+50	.1	.324	.520	.188	.332	.320	0.012	.013	.007	.003	.003	.014		1.006	-0.002	.366	1.048	0.126	.380	1.048		12 9/16	10 5/16	
+65	.2	.244	.415	.104	.311	.253	0.058	.050	.027	.013	.010	.055		0.988	0.009	.286	1.030	0.108	.341	1.030		12 3/8	11 1/8	
+80	.3	.174	.400	.073	.327	.186	0.141	.105	.061	.028	.016	.121		0.968	0.020	.216	1.010	0.088	.337	1.010		12 1/8	11 1/4	
+95	.4	.094	.435	.073	.362	.199	0.163	.163	.096	.043	.024	.188		0.920	-0.025	.136	0.962	0.040	.324	0.962		11 9/16	10 1/16	
8+10	.5	.024	.430	.073	.357	.052	0.305	.208	.123	.053	.032	.238		0.905	0.067	.066	0.947	0.025	.304	0.947		11 3/8	10 1/2	
+25	.6	70.944	.375	.073	.302	69.985	0.317	.227	.135	.057	.035	.260		0.902	0.057	70.986	0.944	0.022	.246	0.944		11 5/16	10 7/16	
+40	.7	.874	.270	.073	.197	.918	0.279	.213	.128	.052	.033	.244		0.921	0.035	.916	0.963	0.041	.160	0.963		11 9/16	10 1/16	
+55	.8	.794	.120	.073	.047	.851	0.196	.166	.100	.041	.025	.191		0.938	0.005	.836	0.980	0.058	.027	0.980		11 3/4	10 3/8	
+70	.9	.724	.950	.073	69.877	.784	0.093	.091	.055	.022	.014	.104		0.951	-0.011	.766	0.993	0.071	70.870	0.993		11 15/16	11 1/16	
+85	5.0	70.644	69.790	.073	.717	.717	0	0	0	0	0	0		0.927	0	.686	0.969	0.047	.686	0.969		11 5/8	10 3/4	


SOUTH BRIDGE - SOUTH BOX LINE 4 SOUTH FLANGE (CHART 8)

CHAINAGE	1. POINT	2. TOP OF CONC. ELEV.	3. TOP OF FLANGE ELEV.	4. FLANGE THICK.	5. BOT. OF FLANGE ELEV.	6. CHORD ELEV.	7. FIELD CAMBER (5-6) LESS V.C.	CAMBER					13. DESIGN HAUNCH	14. ACTUAL HAUNCH (1-5)+12	15. EXTRA CAMBER (7-12)	REVISED HAUNCH AND GRADE					21. V.C. CAMBER	22. REVISED HAUNCH IN INCHES	23. SCREED HEIGHT (22-4) IN INCHES	24. FIELD SCREED HEIGHT IN INCHES	
								8. ΔT ΔA+B	9. ΔC ΔA	10. ΔC ΔB	11. ΔS ΔA	12. 1/2ΔT-ΔS				16. REVISED GRADE	17. REVISED HAUNCH (16-5)+12	18. HAUNCH SHIM (17-13)	19. SCREED ELEV. (16+12)	20. HAUNCH CHECK (19-5)					
0+00	0.0	768.034	767.250	.073	767.177	767.177	0	0	0	0	0	0	0.922	0.857	0	768.129	0.952	0.030	768.129	0.952			11 7/16	10 9/16	
+15	.1	.204	.505	.073	.432	.340	0.092	.091	.055	.022	.014	.104		0.876	-0.012	.303	0.975	0.053	.407	0.975			11 11/16	10 13/16	
+30	.2	.374	.750	.073	.677	.502	0.175	.166	.100	.041	.025	.191		0.888	-0.016	.477	0.991	0.069	.668	0.991			11 7/8	11	
+46	.3	.544	.975	.073	.902	.665	0.237	.213	.128	.052	.033	.244		0.886	-0.007	.651	0.993	0.071	.895	0.993			11 15/16	11 1/16	
+60	.4	.704	68.160	.073	68.087	.827	0.260	.227	.135	.057	.035	.260		0.877	0	.825	0.998	0.076	69.085	0.998			12	11 1/8	
+75	.5	.874	.300	.073	.227	.990	0.237	.208	.123	.053	.032	.238		0.885	-0.001	.999	1.010	0.088	.237	1.010			12 1/8	11 1/4	
+90	.6	69.044	.415	.073	.342	68.152	0.190	.163	.096	.043	.024	.188		0.890	0.002	69.173	1.019	0.097	.361	1.019			12 1/4	11 3/8	
1+05	.7	.214	.485	.073	.412	.315	0.097	.105	.061	.028	.016	.121		0.923	-0.024	.347	1.056	0.134	.468	1.056			12 1/16	11 13/16	
+20	.8	.374	.600	.104	.496	.477	0.019	.030	.027	.013	.010	.055		0.933	-0.036	.521	1.080	0.158	.576	1.080			13	11 3/4	
+35	.9	.544	.810	.188	.622	.640	-0.018	.013	.007	.003	.003	.014		0.936	-0.032	.695	1.087	0.165	.709	1.087			13 1/16	10 13/16	
+50	1.0	.714	.990	.188	.802	.802	0	0	0	0	0	0		0.912	0	.869	1.067	0.145	.869	1.067			12 13/16	10 7/16	
+65.5	.1	.934	69.270	.188	69.082	69.001	0.081	.032	.014	.011	.007	.035		0.887	0.046	70.095	1.048	0.126	70.130	1.048			12 9/16	10 5/16	
+89	.2	70.154	.500	.104	.396	.217	0.179	.099	.049	.031	.019	.110		0.868	0.069	.321	1.035	0.113	.431	1.035			12 7/16	11 3/16	
2+08.5	.3	.364	.830	.073	.757	.425	0.332	.180	.098	.055	.027	.207		0.814	0.125	.548	0.998	0.078	.755	0.998			12	11 1/8	
+28	.4	.584	70.145	.073	70.072	.632	0.438	.244	.136	.072	.036	.281		0.793	0.157	.774	0.983	0.061	71.055	0.983			11 13/16	10 17/16	
+47.5	.5	.804	.370	.073	.297	.840	0.457	.268	.150	.078	.040	.308		0.815	0.149	71.000	1.011	0.089	.308	1.011			12 1/8	11 1/4	
+67	.6	71.024	.500	.073	.427	70.047	0.380	.243	.135	.071	.037	.279		0.876	0.101	.226	1.078	0.156	.505	1.078			12 15/16	12 1/16	
+84.5	.7	.234	.545	.073	.472	.255	0.217	.176	.097	.053	.026	.203		0.965	0.014	.456	1.187	0.265	.659	1.187	0		14 1/4	13 3/8	
3+06	.8	.444	.655	.104	.551	.462	0.086	.096	.048	.030	.018	.107		1.000	-0.021	.661	1.217	0.295	.768	1.217	.003		14 5/8	13 3/8	
+25.5	.9	.624	.890	.188	.702	.670	0.026	.030	.013	.010	.007	.032		0.954	-0.006	.844	1.174	0.252	.876	1.174	.006		14 1/8	11 7/8	
+45	2.0	.794	71.065	.188	.877	.877	-0.009	0	0	0	0	0		0.917	-0.009	72.005	1.128	0.206	72.005	1.128	.009		13 3/16	11 5/16	
+64.5	.1	.934	.255	.188	71.067	.918	0.058	.024	.012	.008	.006	.028		0.895	0.030	.144	1.105	0.183	.172	1.105	.091		13 1/2	11	
+84	.2	72.064	.400	.104	.296	.958	0.176	.087	.045	.026	.016	.097		0.865	0.079	.261	1.062	0.140	.358	1.062	.162		12 3/4	11 1/2	
4+03.5	.3	.164	.595	.073	.522	.999	0.307	.164	.092	.047	.025	.188		0.830	0.119	.366	1.032	0.110	.554	1.032	.216		12 3/8	11 1/2	
+23	.4	.244	.760	.073	.687	71.039	0.403	.227	.129	.064	.024	.261		0.818	0.142	.428	1.002	0.080	.689	1.002	.245		12	11 1/8	
+42.5	.5	.314	.850	.073	.777	.080	0.439	.251	.143	.070	.038	.288		0.825	0.151	.478	0.989	0.067	.766	0.989	.258		11 7/8	11	
+62	.6	.354	.815	.073	.742	.120	0.377	.227	.127	.064	.034	.261		0.873	0.116	.506	1.025	0.103	.767	1.025	.245		12 5/16	11 7/16	
+81.5	.7	.374	.710	.073	.637	.161	0.260	.164	.092	.047	.025	.188		0.925	0.072	.513	1.064	0.142	.701	1.064	.216		12 3/4	11 7/8	
5+01	.8	.374	.590	.104	.486	.201	0.118	.087	.045	.026	.016	.097		0.985	0.021	.497	1.108	0.186	.594	1.108	.167		13 5/16	12 1/16	
+20.5	.9	.354	.555	.188	.367	.242	0.034	.026	.012	.008	.006	.028		1.015	0.006	.458	1.119	0.197	.486	1.119	.091		13 7/16	11 3/16	
+40	3.0	.314	.470	.188	.282	.282	-0.009	0	0	0	0	0		1.032	-0.009	.398	1.116	0.194	.398	1.116	.009		13 3/8	11 1/8	
+59.5	.1	.254	.435	.188	.247	.193	0.049	.030	.013	.010	.007	.032		1.039	0.017	.312	1.097	0.175	.344	1.097	.005		13 3/16	10 13/16	
+79	.2	.174	.360	.104	.256	.103	0.153	.096	.048	.030	.018	.107		1.025	0.046	.216	1.067	0.145	.323	1.067	0		12 13/16	11 7/16	
+98.5	.3	.074	.390	.073	.317	.014	0.303	.176	.097	.053	.026	.203		0.960	0.100	.116	1.002	0.080	.319	1.002			12	11 1/2	
6+18	.4	71.984	.400	.073	.327	70.924	0.403	.243	.135	.071	.037	.279		0.936	0.124	.026	0.978	0.056	.305	0.978			11 5/8	10 3/4	
+37.5	.5	.884	.330	.073	.257	.835	0.422	.248	.150	.078	.040	.308		0.935	0.114	71.926	0.977	0.055	.234	0.977			11 3/4	10 1/8	
+57	.6	.784	.210	.073	.137	.745	0.392	.244	.136	.072	.036	.281		0.928	0.111	.826	0.970	0.048	.107	0.970			11 5/8	10 3/4	

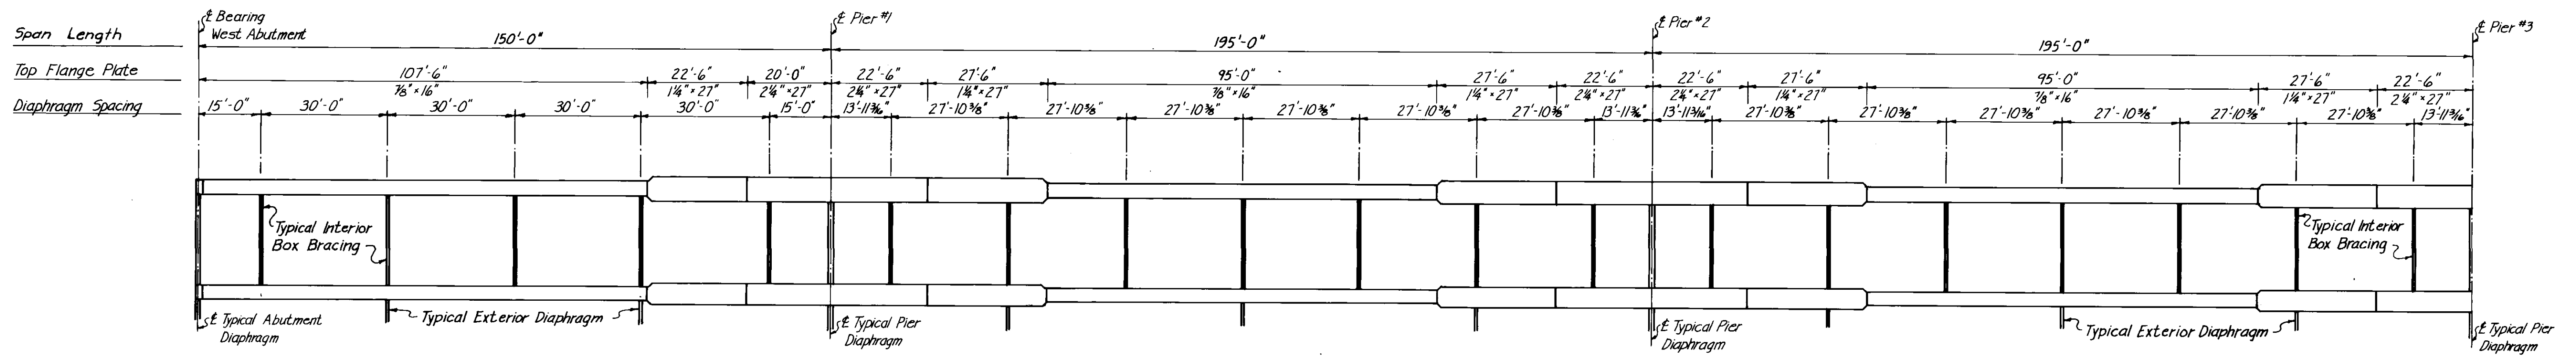


TOP FLANGE - PLAN VIEW

Scale: Horiz. 1"=20'
Vert. 1/8"=1'-0"

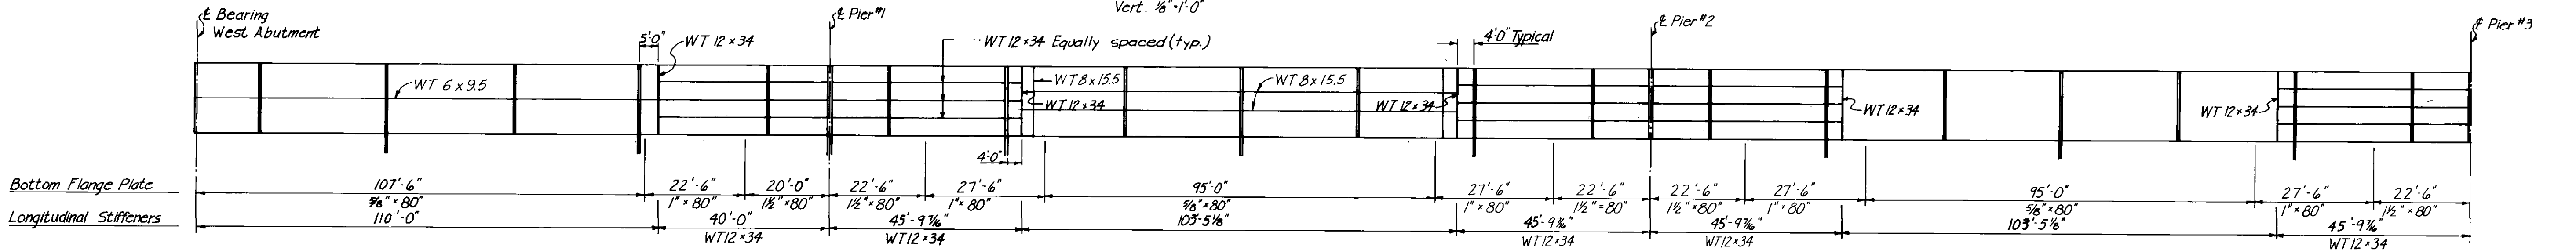

BOTTOM FLANGE - PLAN VIEW

Scale: Horiz. 1"=20'
Vert. 1/8"=1'-0"

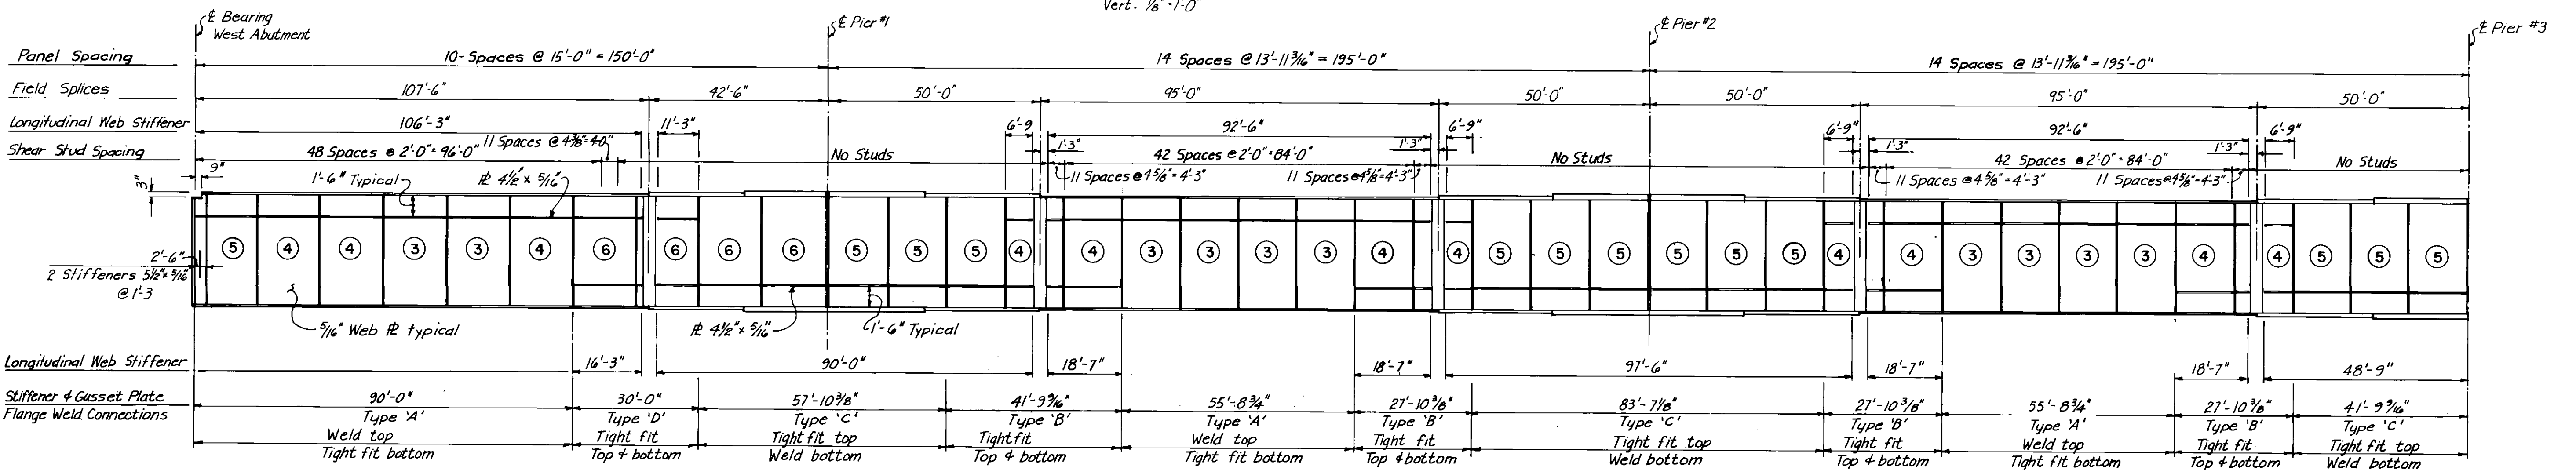

GIRDER ELEVATION

Scale: Horiz. 1"=20'
Vert. 3/8"=1'-0"

AS - BUILT		
DATE	FB NO.	PAGE
Nov 14/79		


SOUTH BRIDGE DECK ELEVATIONS AND DEAD LOAD DEFLECTIONS (FOR DECK ELEVATIONS SEE ELEVATION CHARTS 1-8)

LOCATION	W. ABUT.	.1	.2	.3	.4	.5	.6	.7	SPLICE	.8	.9	PIER 1	.1	.2	SPLICE	.3	.4	.5	.6	.7	SPLICE	.8	.9	PIER 2	.1	.2	SPLICE	.3	.4	.5	.6	.7	SPLICE	.8	.9	PIER 3	
DECK ELEVATION GIRDER 3	FLANGE 'A'	768.67	768.84	769.01	769.18	769.34	769.51	769.68	769.85	769.87	770.01	770.18	770.35	770.57	770.79	770.91	771.00	771.22	771.44	771.66	771.87	771.96	772.08	772.26	772.43	772.57	772.70	772.76	772.80	772.88	772.95	772.99	773.01	773.01	773.01	772.99	772.95
	FLANGE 'B'	768.47	768.64	768.81	768.98	769.14	769.31	769.48	769.65	769.67	769.81	770.15	770.37	770.59	770.71	770.80	771.02	771.24	771.46	771.67	771.87	771.96	772.06	772.23	772.37	772.50	772.56	772.60	772.68	772.75	772.79	772.81	772.81	772.81	772.79	772.75	772.75
GIRDER 3	Δ T	.000	.091	.166	.213	.227	.208	.163	.105	.096	.050	.013	.000	.032	.099	.134	.180	.244	.268	.243	.176	.141	.096	.030	.000	.026	.087	.121	.164	.227	.251	.227	.164	.121	.087	.026	.000
	Δ C	.000	.055	.100	.128	.135	.123	.096	.061	.054	.027	.007	.000	.014	.049	.077	.098	.136	.150	.135	.097	.077	.048	.013	.000	.012	.045	.072	.092	.129	.143	.129	.092	.072	.045	.012	.000
DECK ELEVATION GIRDER 4	FLANGE 'C'	768.27	768.44	768.61	768.78	768.94	769.11	769.28	769.45	769.47	769.61	769.78	769.95	770.17	770.39	770.51	770.60	770.82	771.04	771.26	771.47	771.56	771.68	771.86	772.03	772.17	772.30	772.36	772.40	772.48	772.55	772.59	772.61	772.61	772.59	772.55	
	FLANGE 'D'	768.07	768.24	768.41	768.58	768.74	768.91	769.08	769.25	769.27	769.41	769.58	769.75	769.97	770.19	770.31	770.40	770.62	770.84	771.06	771.27	771.36	771.48	771.66	771.83	771.97	772.10	772.16	772.20	772.28	772.35	772.39	772.41	772.41	772.39	772.35	
GIRDER 4	Δ T	.000	.091	.166	.213	.227	.208	.163	.105	.096	.050	.013	.000	.032	.099	.134	.180	.244	.268	.243	.176	.141	.096	.030	.000	.026	.087	.121	.164	.227	.251	.227	.164	.121	.087	.026	.001
	Δ C	.000	.055	.100	.128	.135	.123	.096	.061	.054	.027	.007	.000	.014	.049	.077	.098	.136	.150	.135	.097	.077	.048	.013	.000	.012	.045	.072	.092	.129	.143	.129	.092	.072	.045	.012	.000

- Notes:
- Dead load deflections are shown in decimals of a foot.
ΔT denotes total deflection due to concrete, structural steel, & utilities.
ΔC denotes deflection due to concrete only.
 - ⑥ Number of equal stiffener spaces per panel.
 - The location of welds connecting stiffener and gusset plates to flanges shall be as shown on the 'Girder Elevation'.
 - Camber to be 1.3 x ΔT.

- North Bridge
a) Deck elevation = South Bridge
Deck elevation + 0.075 feet
b) ΔT & ΔC = South Bridge
Deck ΔT & ΔC

NO.	REVISIONS	DATE
1	ISSUED FOR TENDER	4-4-77
2		
3		

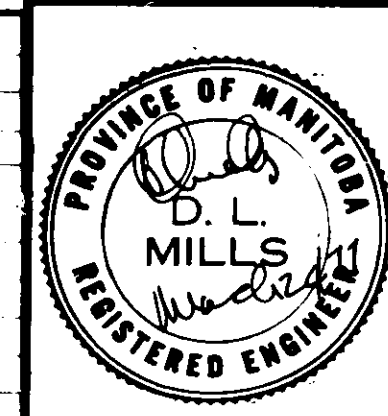

THE CITY OF WINNIPEG
WORKS & OPERATIONS DEPARTMENT
STREETS & TRANSPORTATION DIVISION

W.L. WARDROP & ASSOCIATES LTD.
ENGINEERING CONSULTANTS
WINNIPEG - THUNDER BAY - REGINA - SASKATOON - EDMONTON

APPROVED BY: *[Signature]* DATE: 25 Nov 77

DATE: NOV 76
DESIGN: S.T.K.
PRELIM. CHK: S.T.K. JAN 77
CHECK: D.H.M. JAN 77




ROUTE 165

TYPICAL GIRDER DETAILS

SCALE: AS SHOWN

APPROVED BY: *[Signature]* DATE: 25 Nov 77
MANAGER OF STREETS AND TRAFFIC

DRAWING NO. B-5092-222

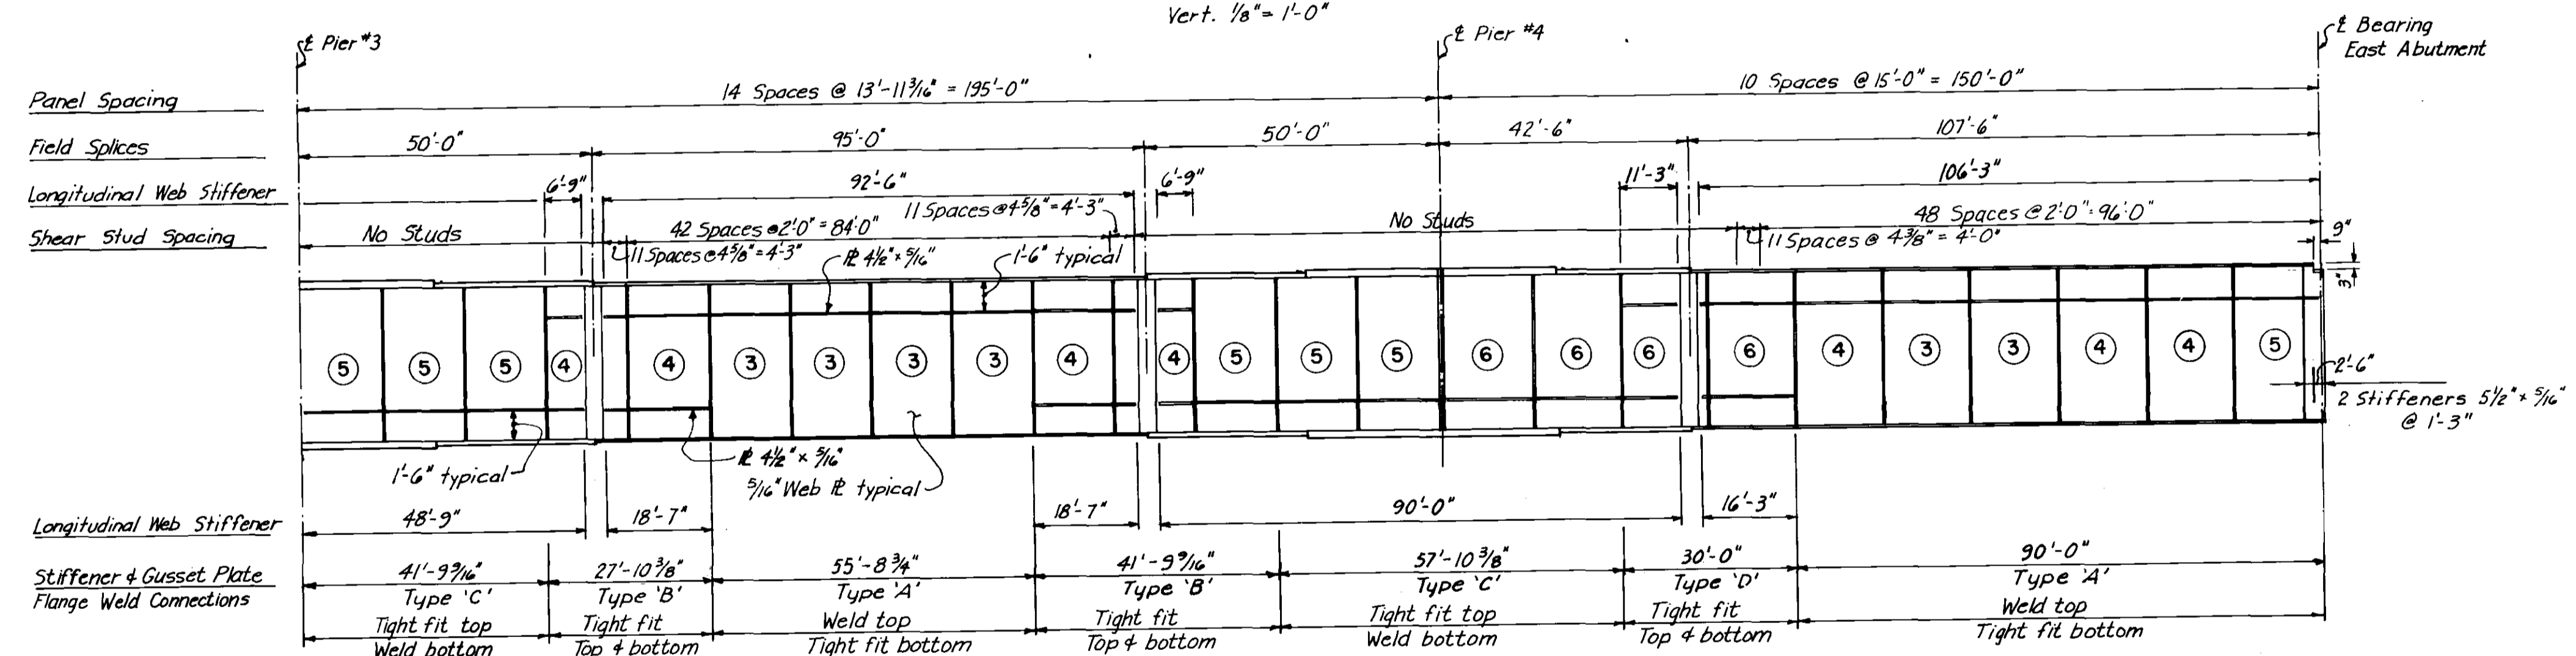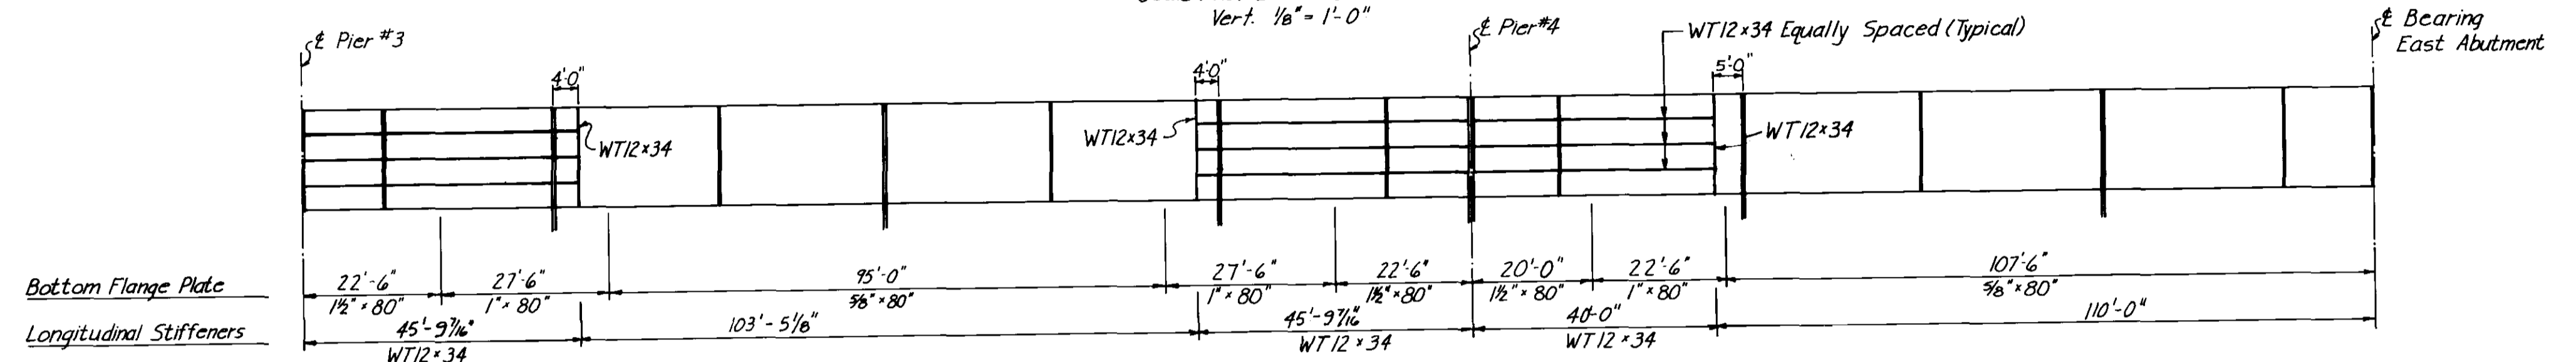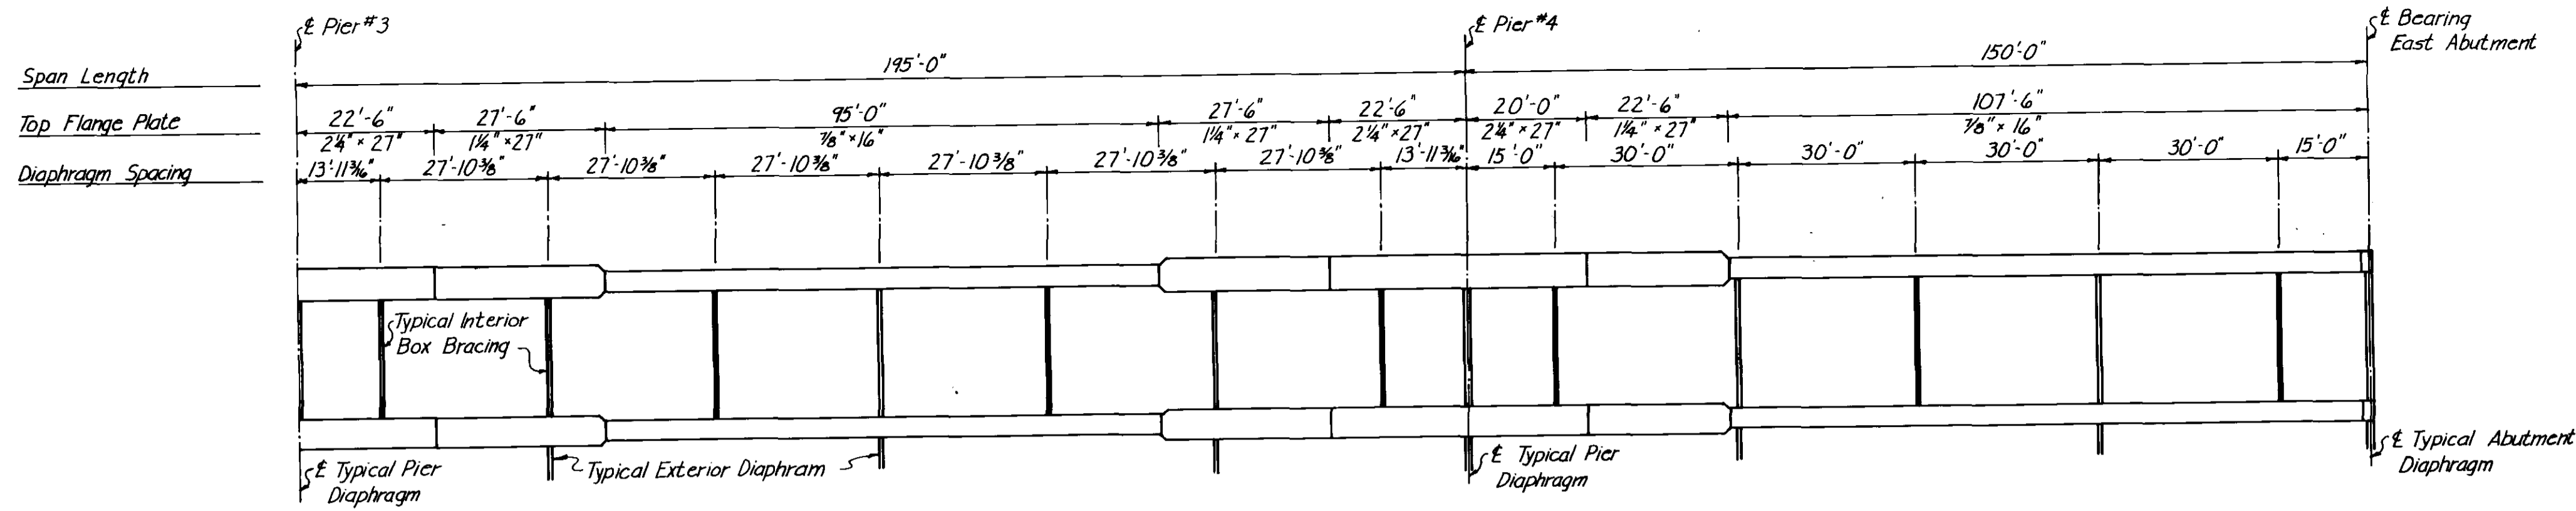

AS - BUILT
DATE: Nov. 16/77
FB. NO. _____
PAGE _____

SOUTH BRIDGE DECK ELEVATIONS AND DEAD LOAD DEFLECTIONS (FOR DECK ELEVATIONS SEE ELEVATION CHARTS 1-8)

LOCATION	PIER 3	.1	.2	SPLICE	.3	.4	.5	.6	.7	SPLICE	.8	.9	PIER 4	.1	.2	SPLICE	.3	.4	.5	.6	.7	.8	.9	E.ABUT.
DECK ELEVATION	772.95	772.89	772.81	772.76	772.71	772.62	772.52	772.42	772.32	772.29	772.23	772.13	772.03	771.96	771.88	771.82	771.81	771.73	771.66	771.58	771.51	771.43	771.36	771.28
GIRDER 3	FLANGE 'A'	772.75	772.69	772.61	772.56	772.51	772.42	772.32	772.22	772.09	772.03	771.93	771.83	771.76	771.68	771.62	771.61	771.53	771.46	771.38	771.31	771.23	771.16	771.08
GIRDER 3	FLANGE 'B'	.000	.030	.096	.141	.176	.243	.268	.244	.134	.099	.032	.000	.013	.050	.096	.105	.163	.208	.227	.213	.166	.091	.000
	Δ T	.000	.013	.048	.077	.097	.135	.150	.136	.098	.077	.049	.014	.000	.007	.027	.054	.061	.096	.123	.135	.128	.100	.055
DECK ELEVATION	FLANGE 'C'	772.55	772.49	772.41	772.36	772.31	772.22	772.12	772.02	771.92	771.89	771.83	771.73	771.63	771.56	771.48	771.42	771.41	771.33	771.26	771.18	771.11	771.03	770.96
	GIRDER 4	FLANGE 'D'	772.35	772.29	772.21	772.16	772.11	772.02	771.92	771.82	771.72	771.69	771.63	771.53	771.43	771.36	771.28	771.21	771.13	771.06	770.98	770.91	770.83	770.76
GIRDER 4	FLANGE 'E'	.000	.030	.096	.141	.176	.243	.268	.244	.134	.099	.032	.000	.013	.050	.096	.105	.163	.208	.227	.213	.166	.091	.000
	Δ T	.000	.013	.048	.077	.097	.135	.150	.136	.098	.077	.049	.014	.000	.007	.027	.054	.061	.096	.123	.135	.128	.100	.055
GIRDER 4	FLANGE 'F'	.000	.030	.096	.141	.176	.243	.268	.244	.134	.099	.032	.000	.013	.050	.096	.105	.163	.208	.227	.213	.166	.091	.000
	Δ C	.000	.013	.048	.077	.097	.135	.150	.136	.098	.077	.049	.014	.000	.007	.027	.054	.061	.096	.123	.135	.128	.100	.055

- Notes:
- Dead load deflections are shown in decimals of a foot.
ΔT denotes total deflection due to concrete, structural steel, & utilities.
ΔC denotes deflection due to concrete only.
 - ⑥ - Number of equal stiffener spaces per panel.
 - The location of welds connecting stiffener & gusset plates to flanges shall be as shown on the "Girder Elevation".
 - Camber to be 1.3 x ΔT.
 - North Bridge
 - Deck elevation = South Bridge Deck elevation + 0.075 feet.
 - ΔT & ΔC = South Bridge Deck ΔT & ΔC

THE CITY OF WINNIPEG
WORKS & OPERATIONS DEPARTMENT
STREETS & TRANSPORTATION DIVISION

W.L. WARDROP & ASSOCIATES LTD.
ENGINEERING CONSULTANTS
WINNIPEG - THUNDER BAY - REGINA - SASKATOON

ROUTE 165

TYPICAL GIRDER DETAILS

SCALE: AS SHOWN

APPROVED BY: *[Signature]* DATE: 25/1/77

DRAWN BY: J.T.K. NOV. 76
PRELIM. CHK. S.T.K. JAN. 77


DESIGN: S.T.K. NOV. 76
CHECK: D.L.M. JAN. 77

APPROVED BY: *[Signature]* DATE: 25/1/77


MANAGER OF STREETS AND TRAFFIC

DRAWING NO. B-5092-223


W.L.W. NO. 74012-21

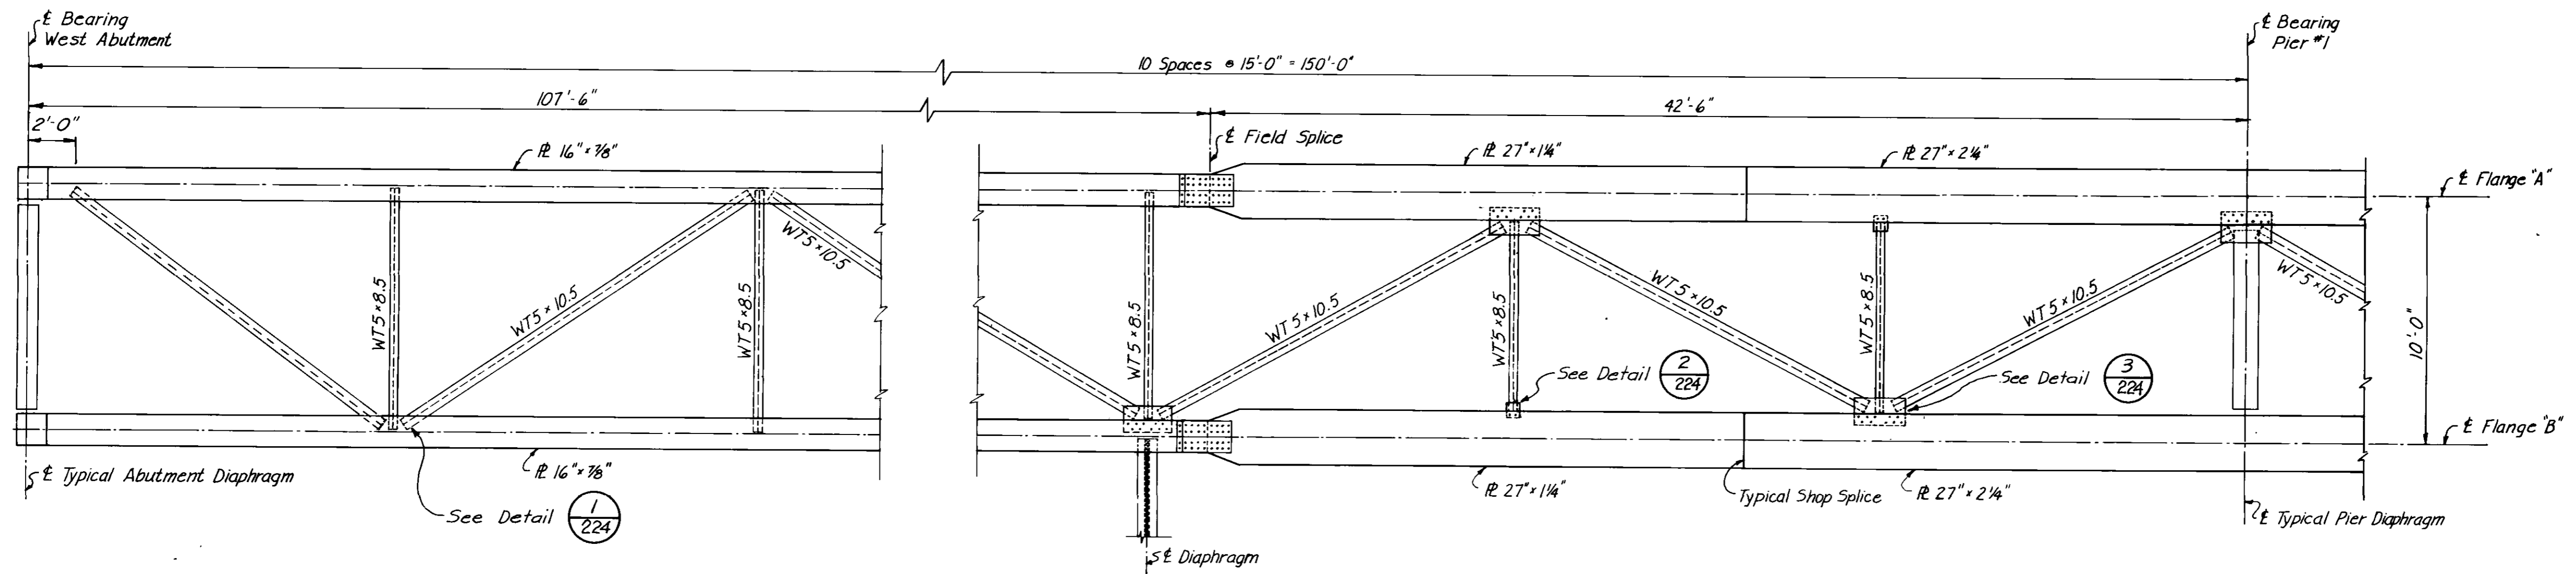


PLAN
Scale: 1/4" = 1'-0"

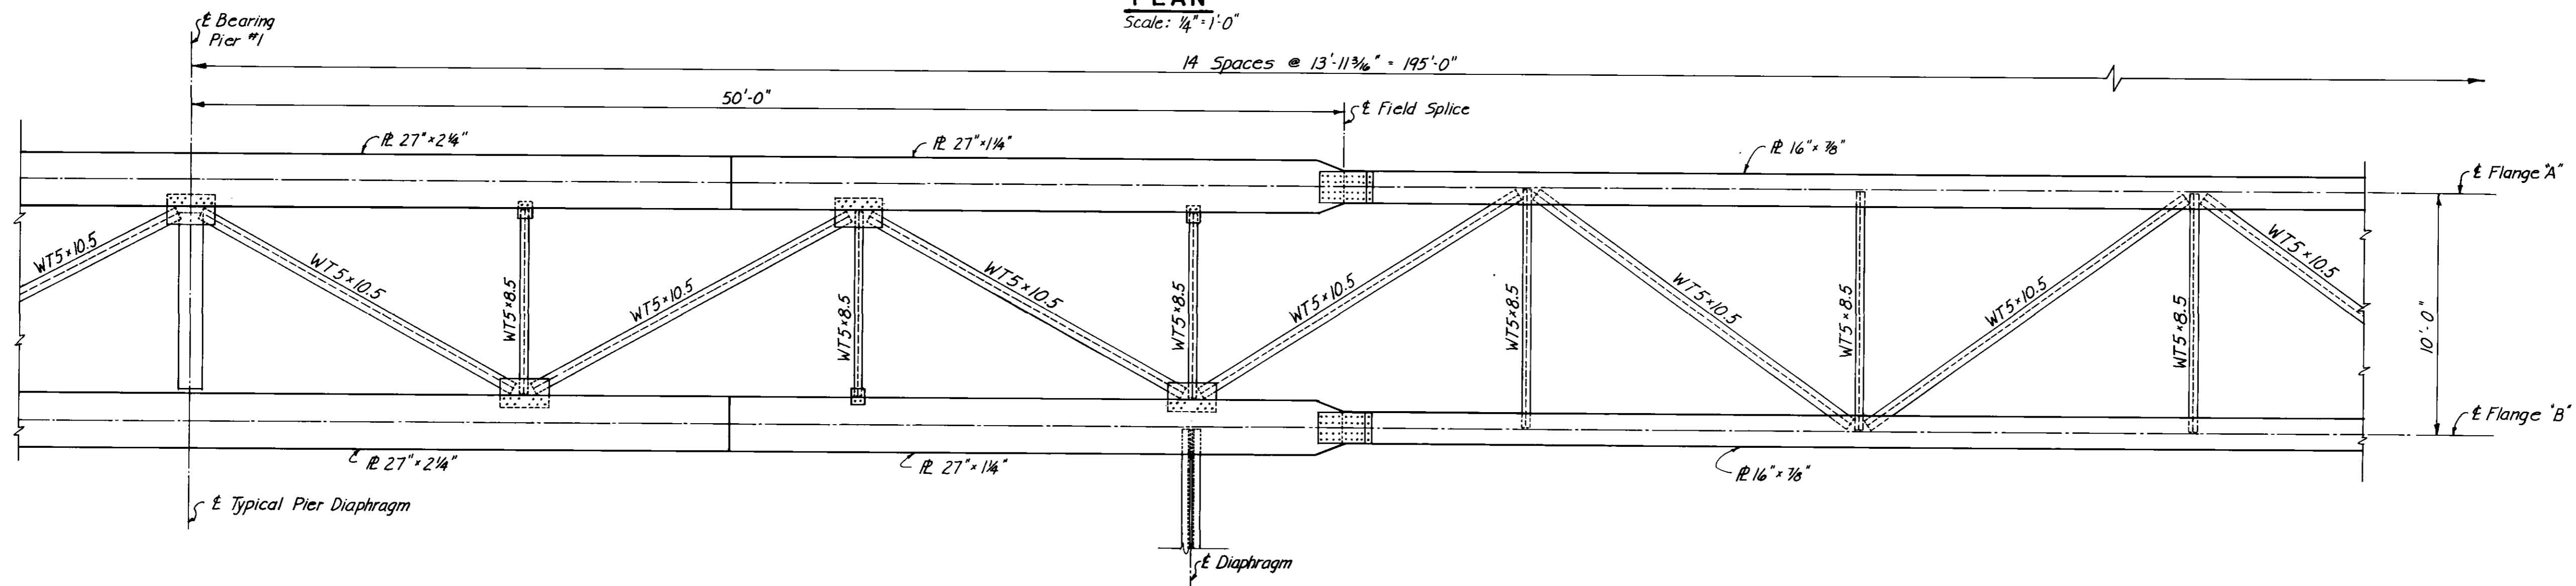


PLAN
Scale: 1/4" = 1'-0"

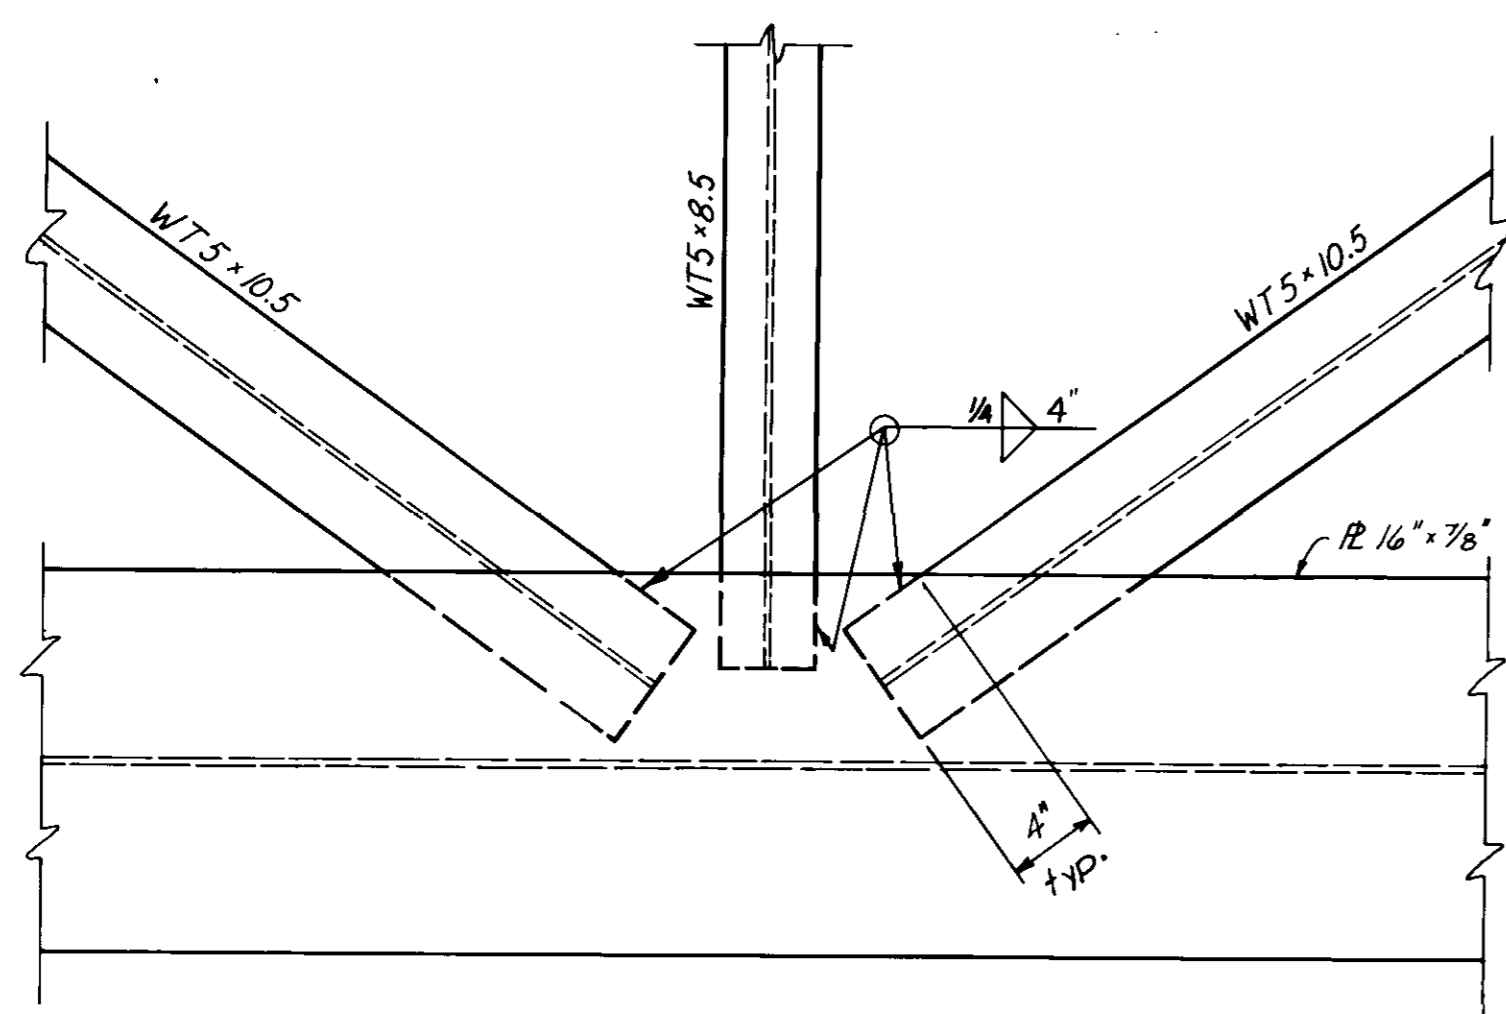

1 DETAIL
224 Scale 1/2" = 1'-0"

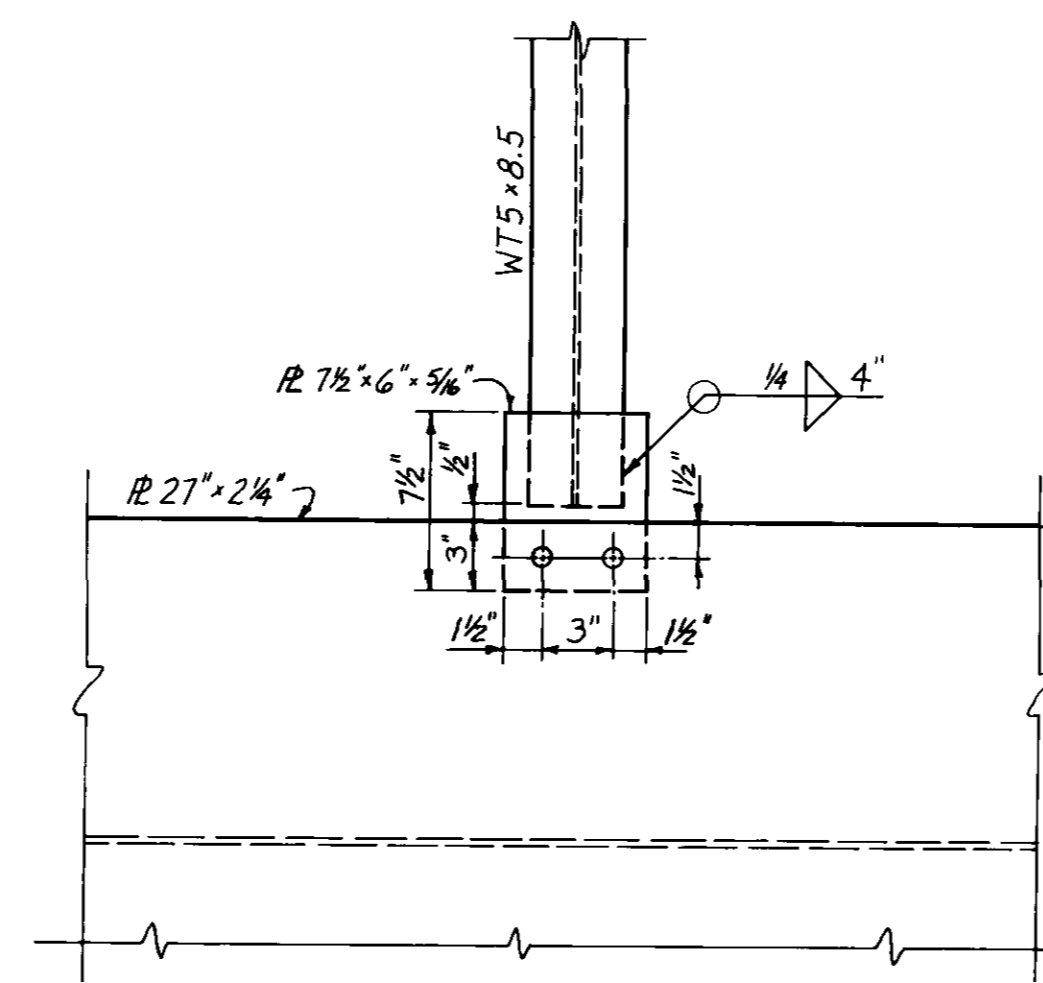

2 DETAIL
224 Scale 1/2" = 1'-0"

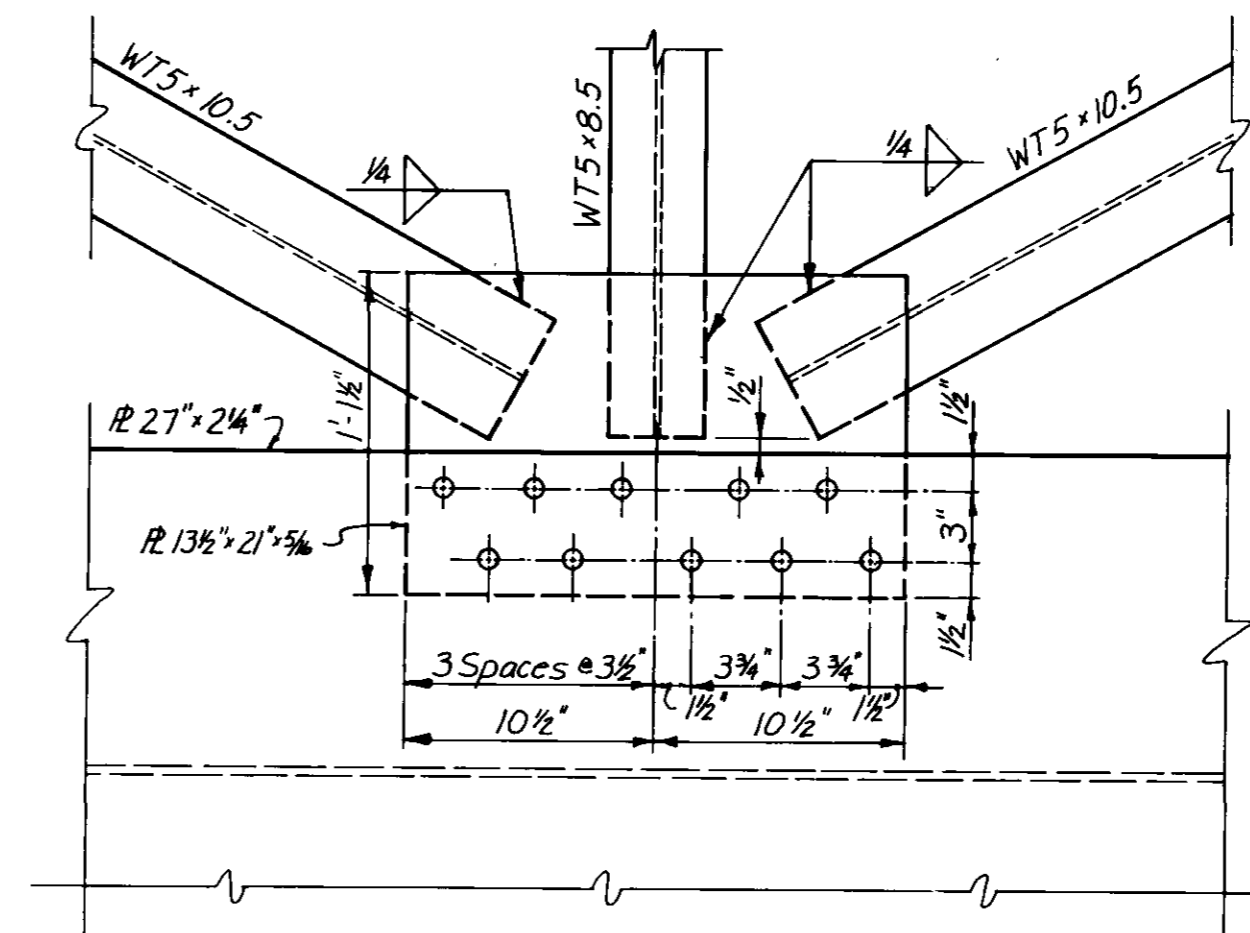


3 DETAIL
224 Scale 1/2" = 1'-0"

AS-BUILT
DATE FB NO PAGE
Nov. 16/79

ISSUED FOR TENDER			
NO	REVISIONS	DATE	BY


	THE CITY OF WINNIPEG WORKS & OPERATIONS DEPARTMENT STREETS & TRANSPORTATION DIVISION	ROUTE 165	
	W.L. WARDROP & ASSOCIATES LTD. ENGINEERING CONSULTANTS WINNIPEG - THUNDER BAY - REGINA - BARRIE - EDMONTON	TOP LATERAL BRACING	
	APPROVED BY: <i>[Signature]</i> DATE: 25 Nov 79 DRAWN BY: J.L.K. DATE: DEC 79 PRELIM. CHK: S.T.K. DATE: JAN 79 DESIGN: S.T.K. DATE: DEC 79 CHECK: D.L.M. DATE: JAN 79	APPROVED BY: <i>[Signature]</i> DATE: 25/3/22 MANAGER OF STREETS AND TRAFFIC	SCALE: AS SHOWN

110 INCHES
19
18
17
16
15
14
13
12
11
10

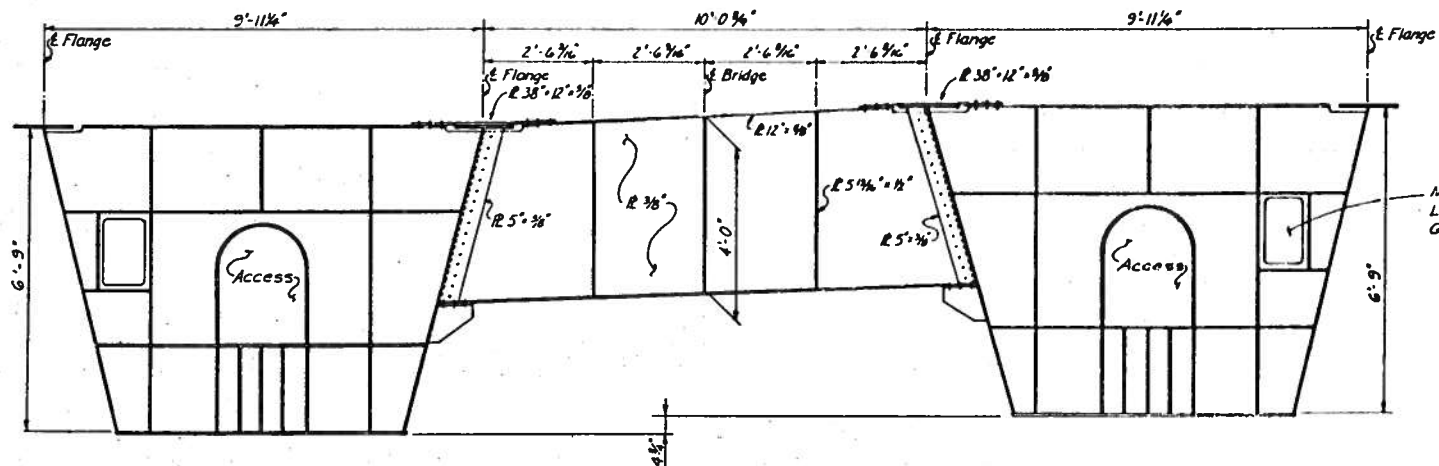


ELEVATION
Scale: 1/2" = 1'-0"

MTS. Utility Opening Located in North Box Girder in South Bridge

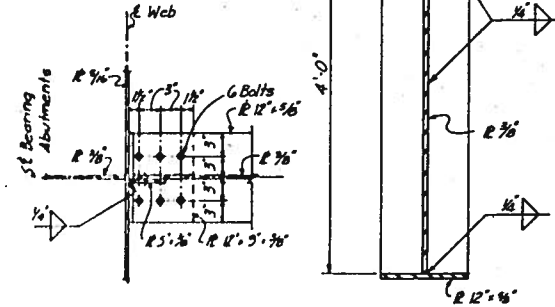


SECTION 1
226 Scale: 1" = 1'-0"

SECTION 2
226 Scale: 1" = 1'-0"

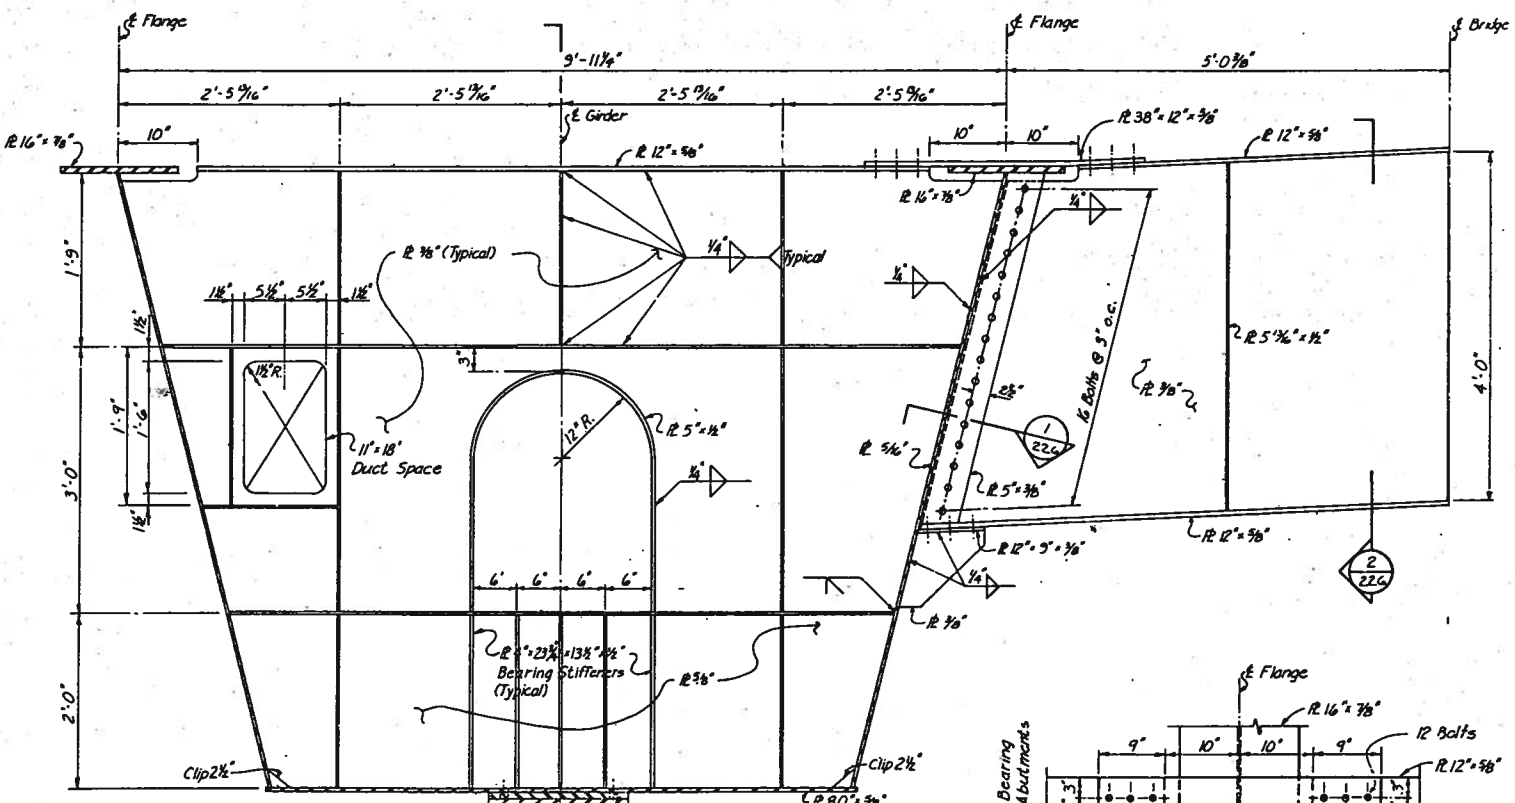

PLAN VIEW
Scale: 1" = 1'-0"

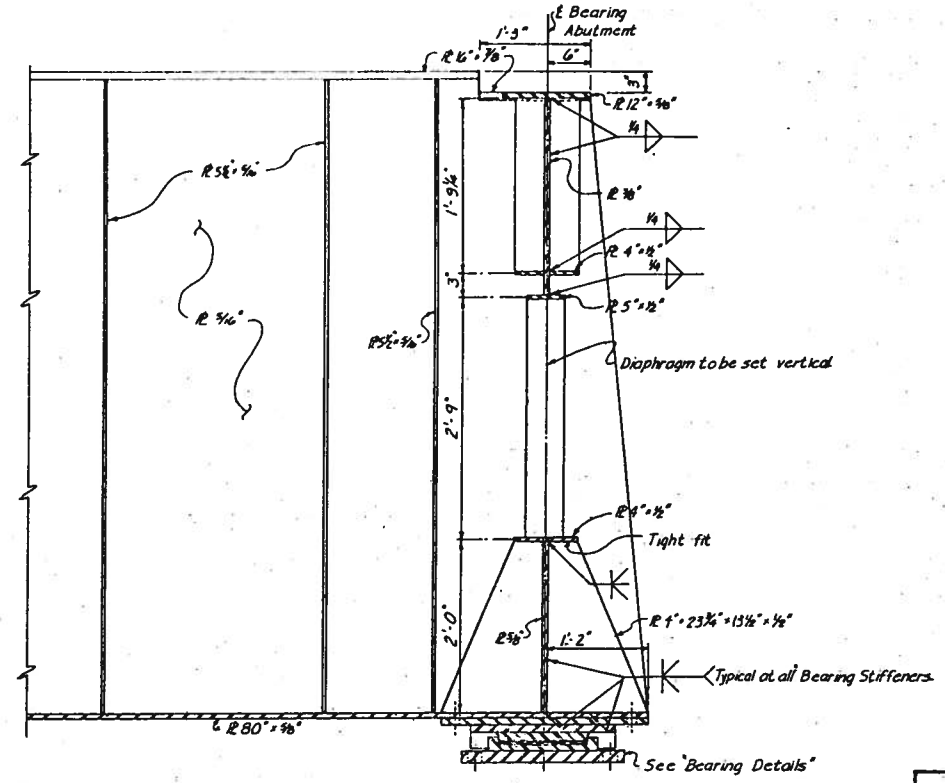

SECTION 3
226 Scale: 1" = 1'-0"

Note: Unless otherwise shown, all stiffeners in Girder Diaphragm to be R 4" x 1/2".

See "Bearing Details"

See "Bearing Details"


DETAIL
Scale: 1" = 1'-0"

AS - BUILT		
DATE	FB NO.	PAGE
Nov. 11/19		


<p>THE CITY OF WINNIPEG WORKS & OPERATIONS DEPARTMENT STREETS & TRANSPORTATION DIVISION</p>	<p>ROUTE 165</p>	
	<p>ABUTMENT DIAPHRAGM DETAILS</p>	
<p>W.L. WARDROP & ASSOCIATES LTD. ENGINEERING CONSULTANTS</p>	<p>APPROVED BY: [Signature] DATE: 25 JAN 77</p>	<p>SCALE: AS SHOWN</p>
<p>DRAWN BY: J.T.K. DEC 76 PHILLIP CHA S.T.K. JAN 77</p>	<p>DESIGN: S.T.K. DEC 76 CHECK: D.L.M. JAN 77</p>	<p>APPROVED BY: [Signature] DATE: 25/1/77 MANAGER OF STREETS AND TRAFFIC</p>
<p>DRAWING NO. B-5092-226</p>		<p>W.L.W. NO. 74012-21</p>




10 INCHES
19
18
7
16
4
13
12
11
10

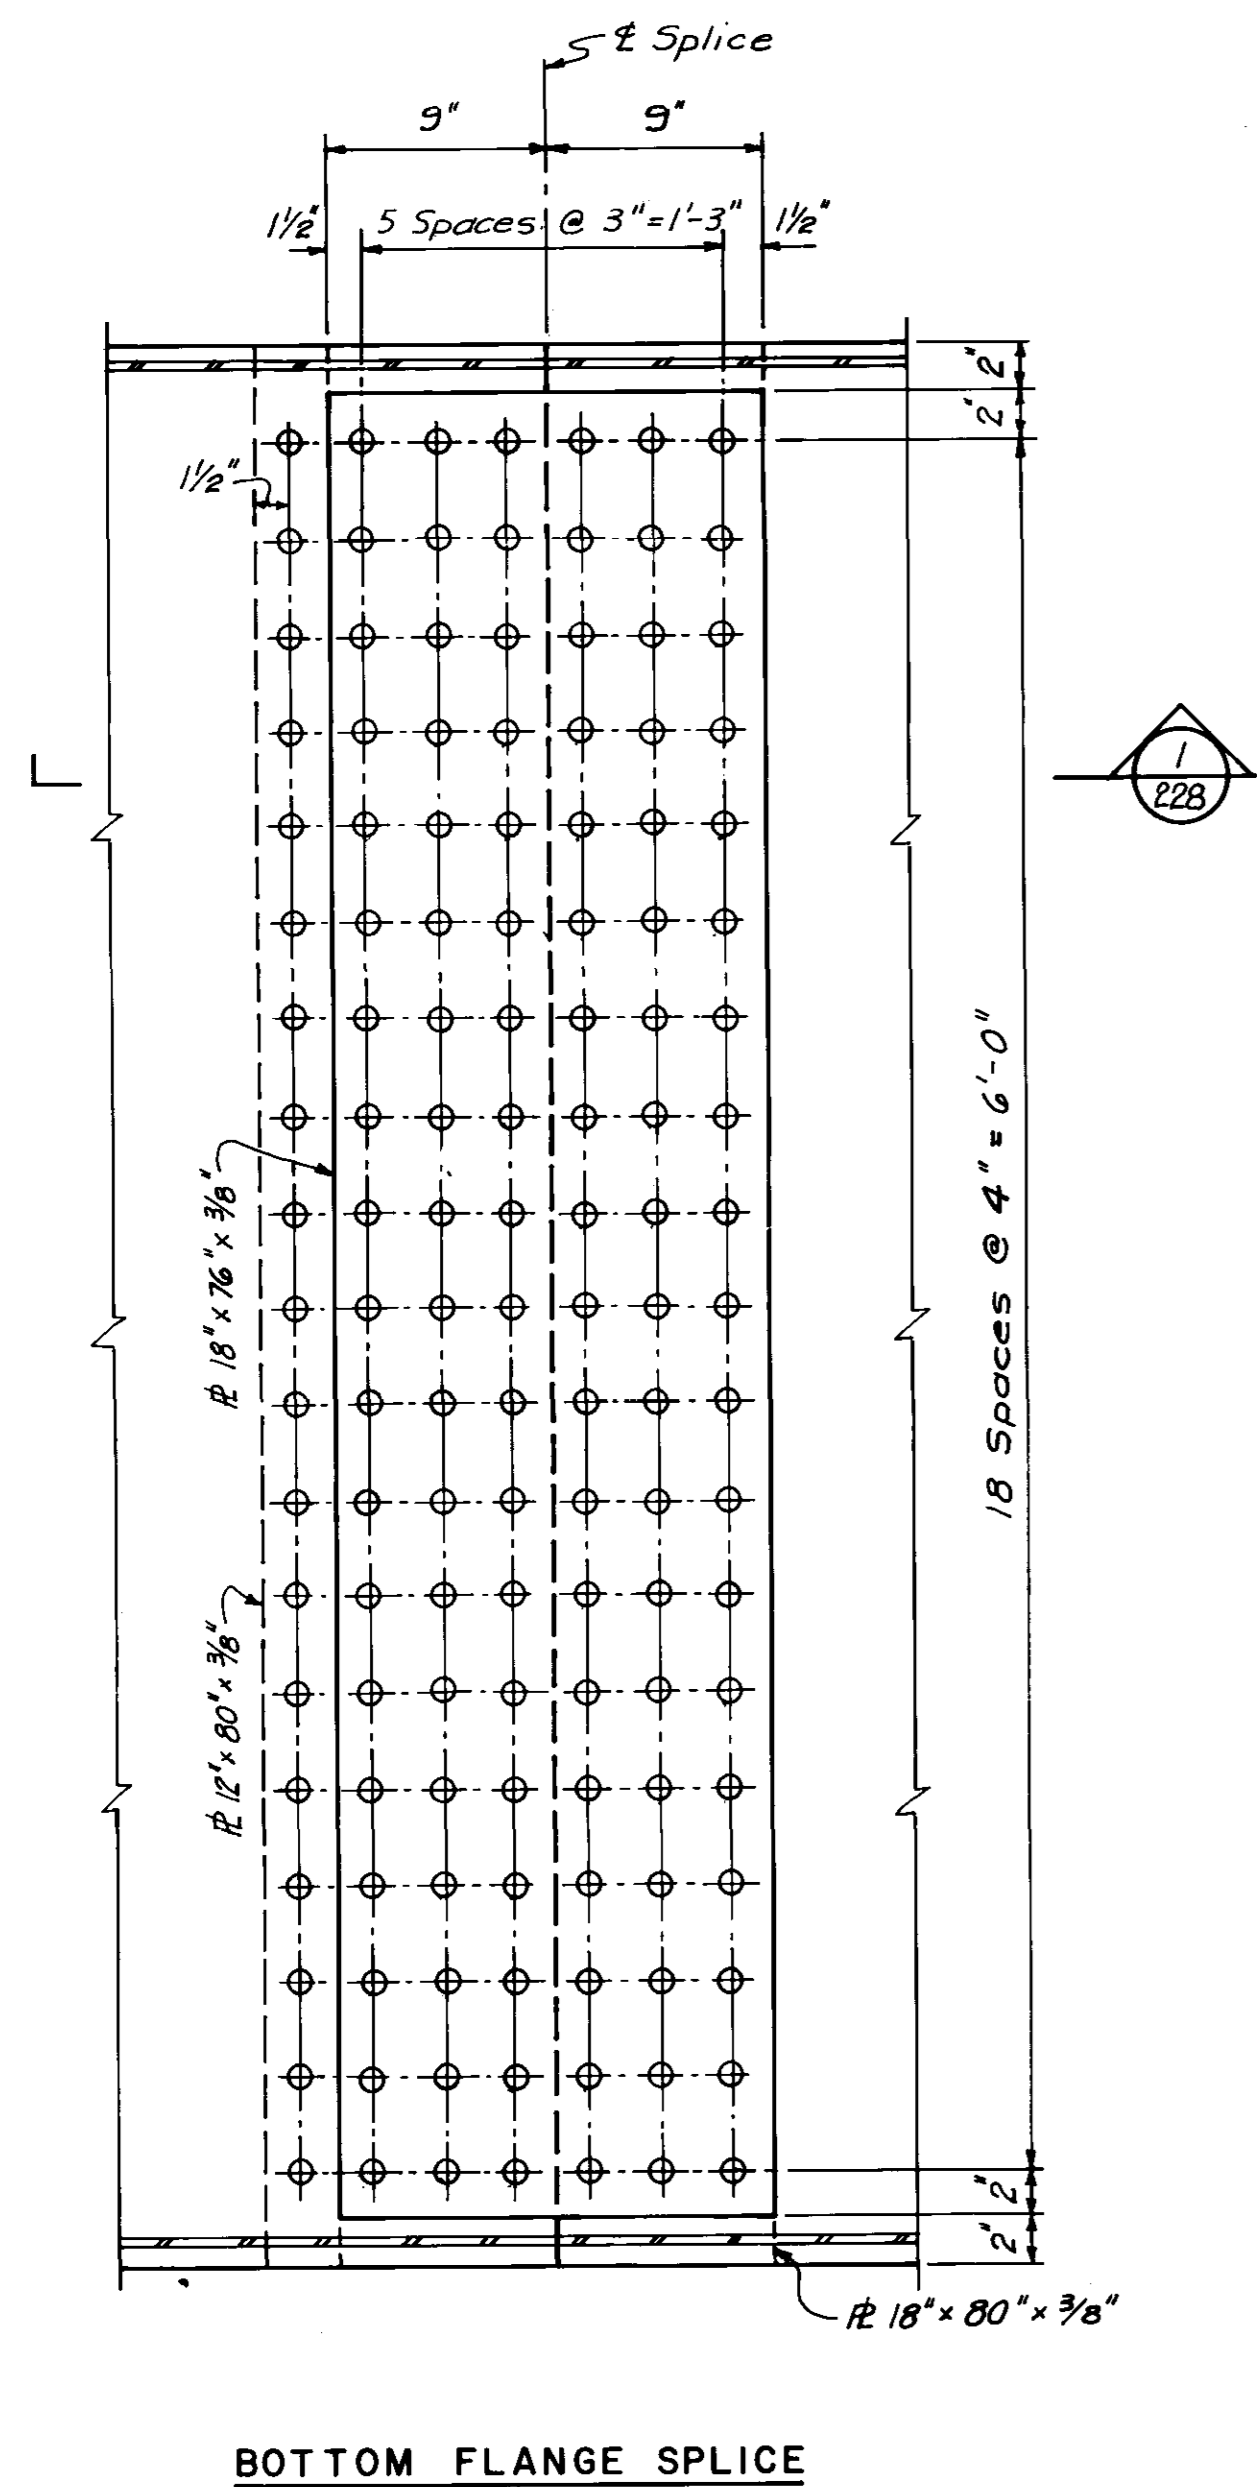


BOTTOM FLANGE SPLICE

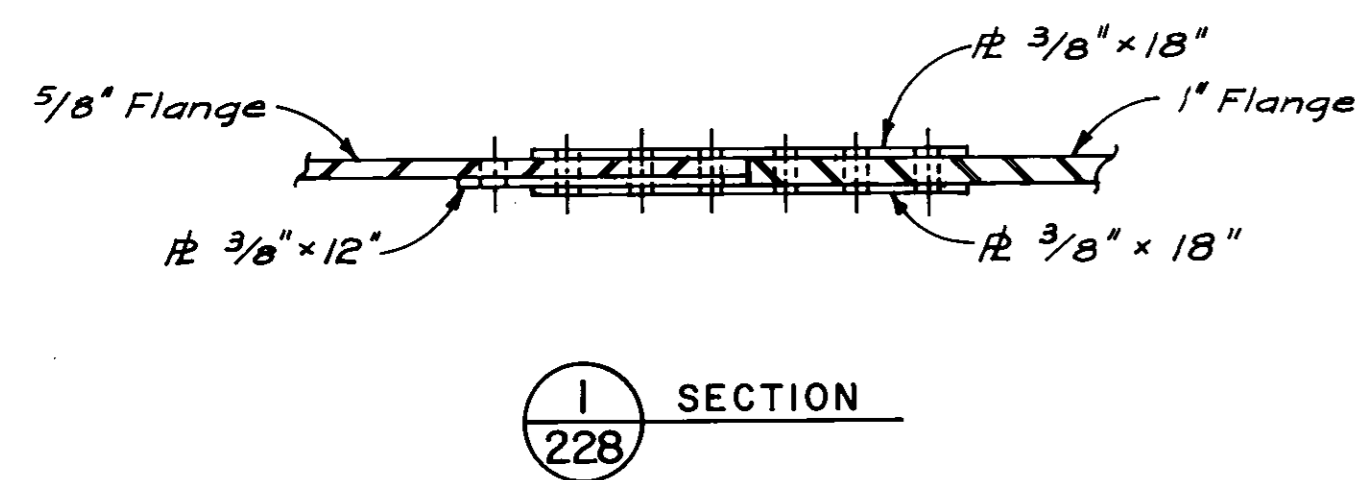


1 SECTION
228

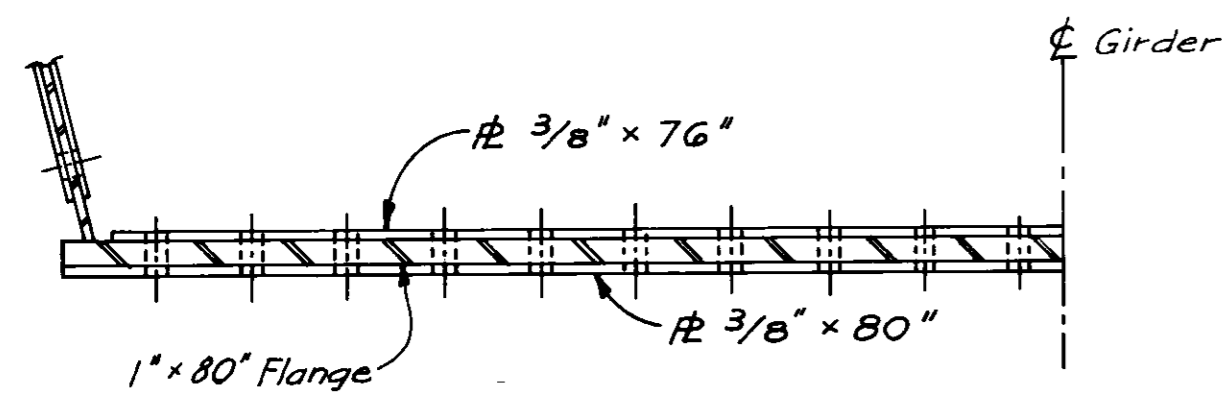


2 DETAIL
228

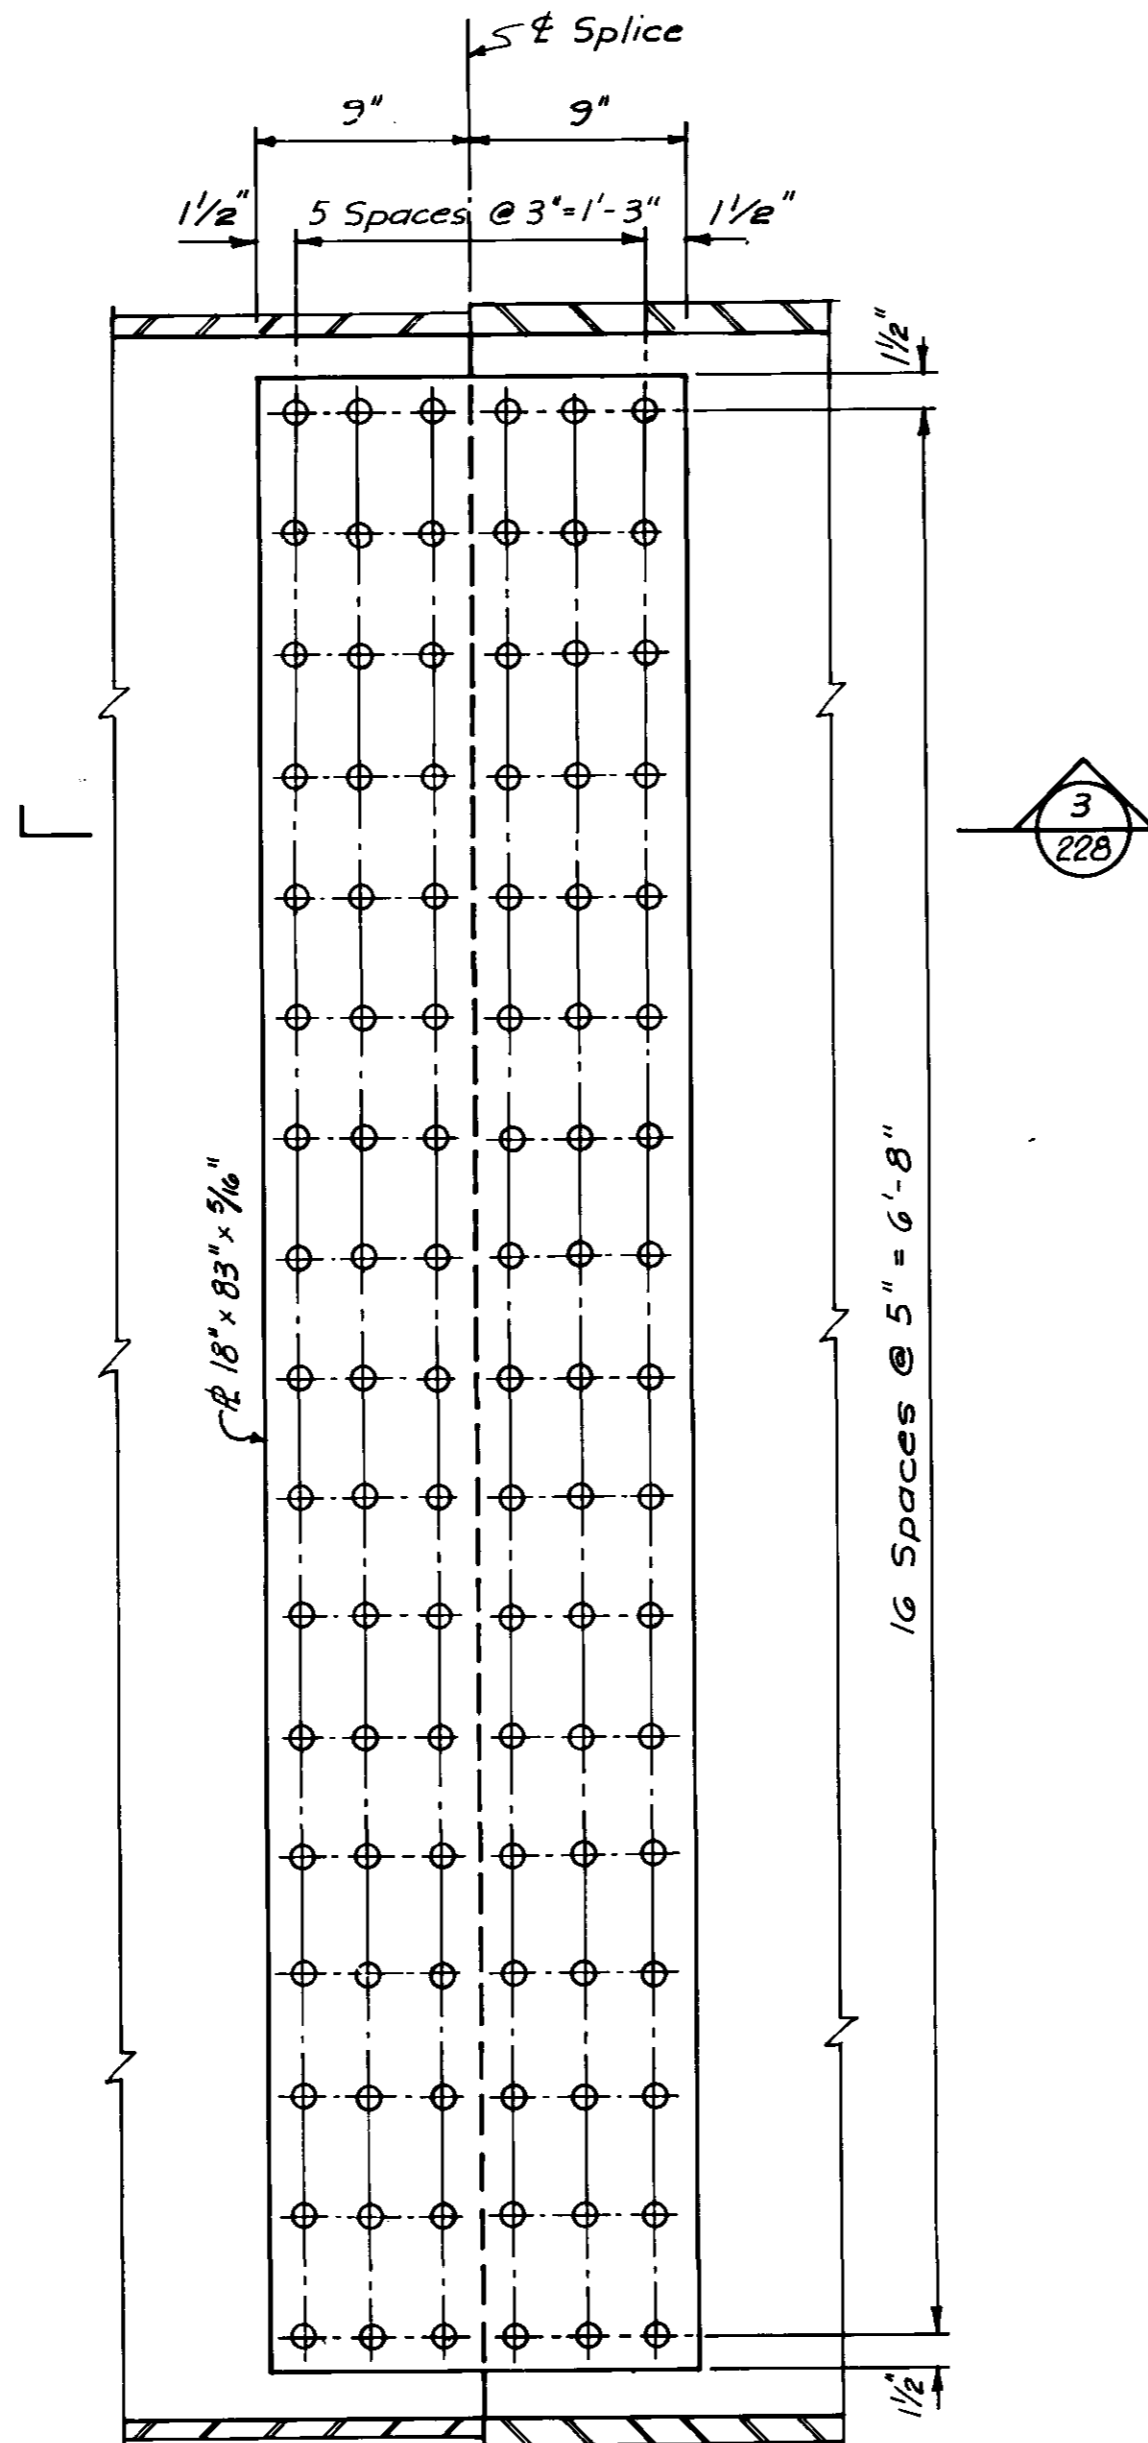


WEB SPLICE

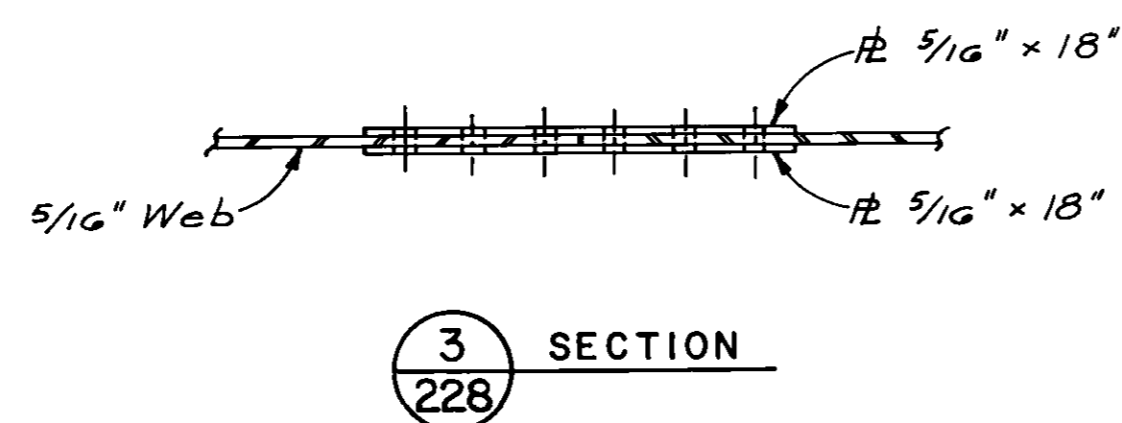


3 SECTION
228

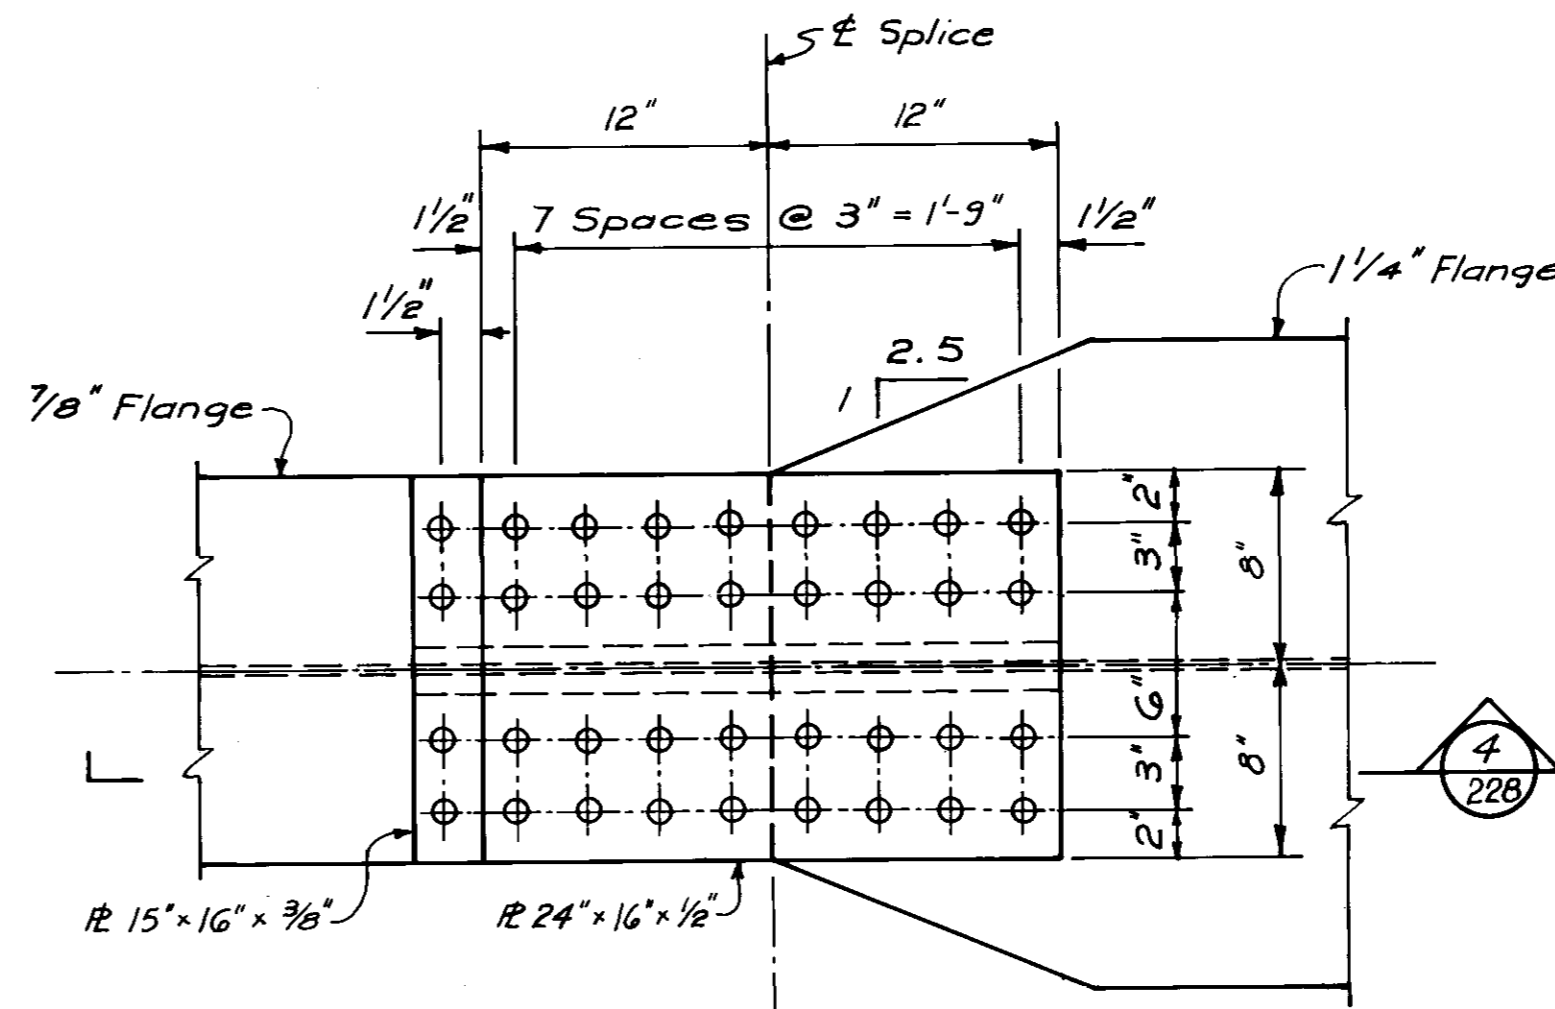


TOP FLANGE SPLICE

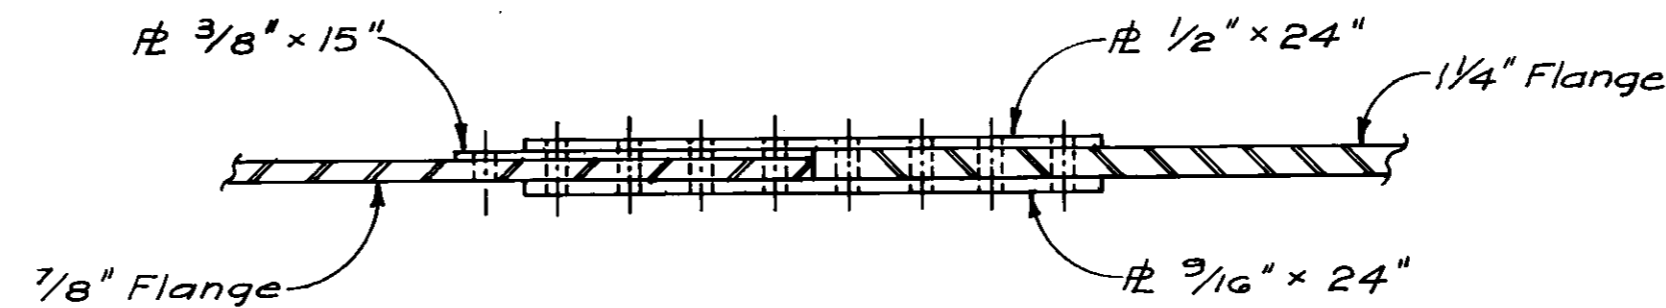

4 SECTION
228

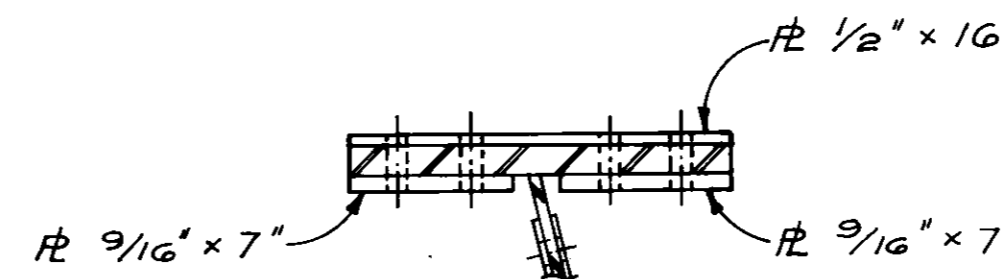

5 DETAIL
228

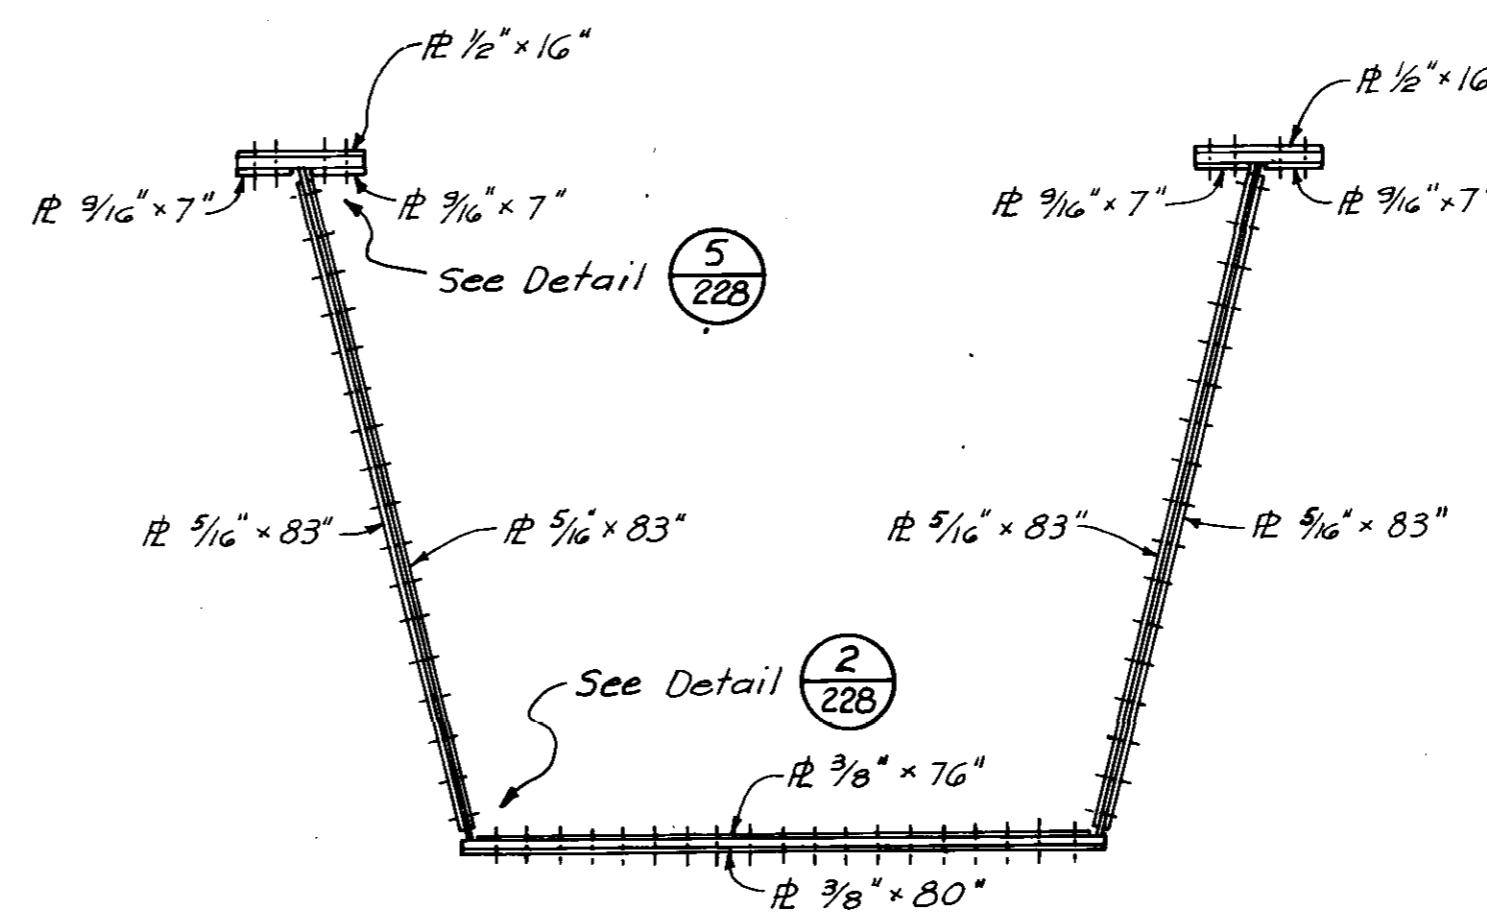

BOX GIRDER SECTION


Scale 1/2" = 1'-0"

Notes:

1. All bolts shall be 7/8" ϕ ASTM A325 type 3 high strength bolts in 9/16" ϕ holes.
2. Bolts shall be installed with the heads to the outside of web and to bottom of flanges.

AS - BUILT		
DATE	FB NO.	PAGE
Nov. 14/77		

NO.	ISSUED FOR TENDER	DATE	BY
		4.4.77	
	REVISIONS		

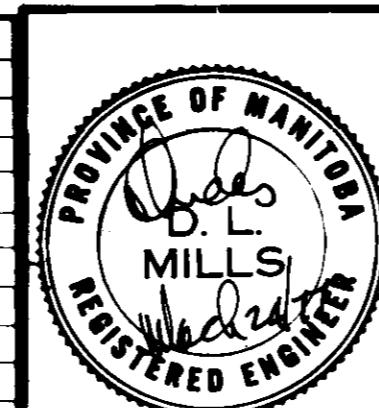


THE CITY OF WINNIPEG			
WORKS & OPERATIONS DEPARTMENT STREETS & TRANSPORTATION DIVISION			
W.L. WARDROP & ASSOCIATES LTD. ENGINEERING CONSULTANTS WINNIPEG - THUNDER BAY - REGINA - BARRIE - EDMONTON			
APPROVED BY:	DATE	DES. T.S.	DATE
<i>[Signature]</i>	25.11.77		
DRAWN BY:	DATE	CHECK	DATE
ST	JAN.77	D.L.M.	JAN.77
PRELIM. CHK.	S.T.K.		


ROUTE 165	
FIELD SPLICES	
APPROVED BY:	DATE
<i>[Signature]</i>	25.11.77
MANAGER OF STREETS AND TRAFFIC	

SCALE:	DRAWING NO.
1/2" = 1'-0"	B-5092-228

110 INCHES
9
8
7
6
5
4
3
2
1
0

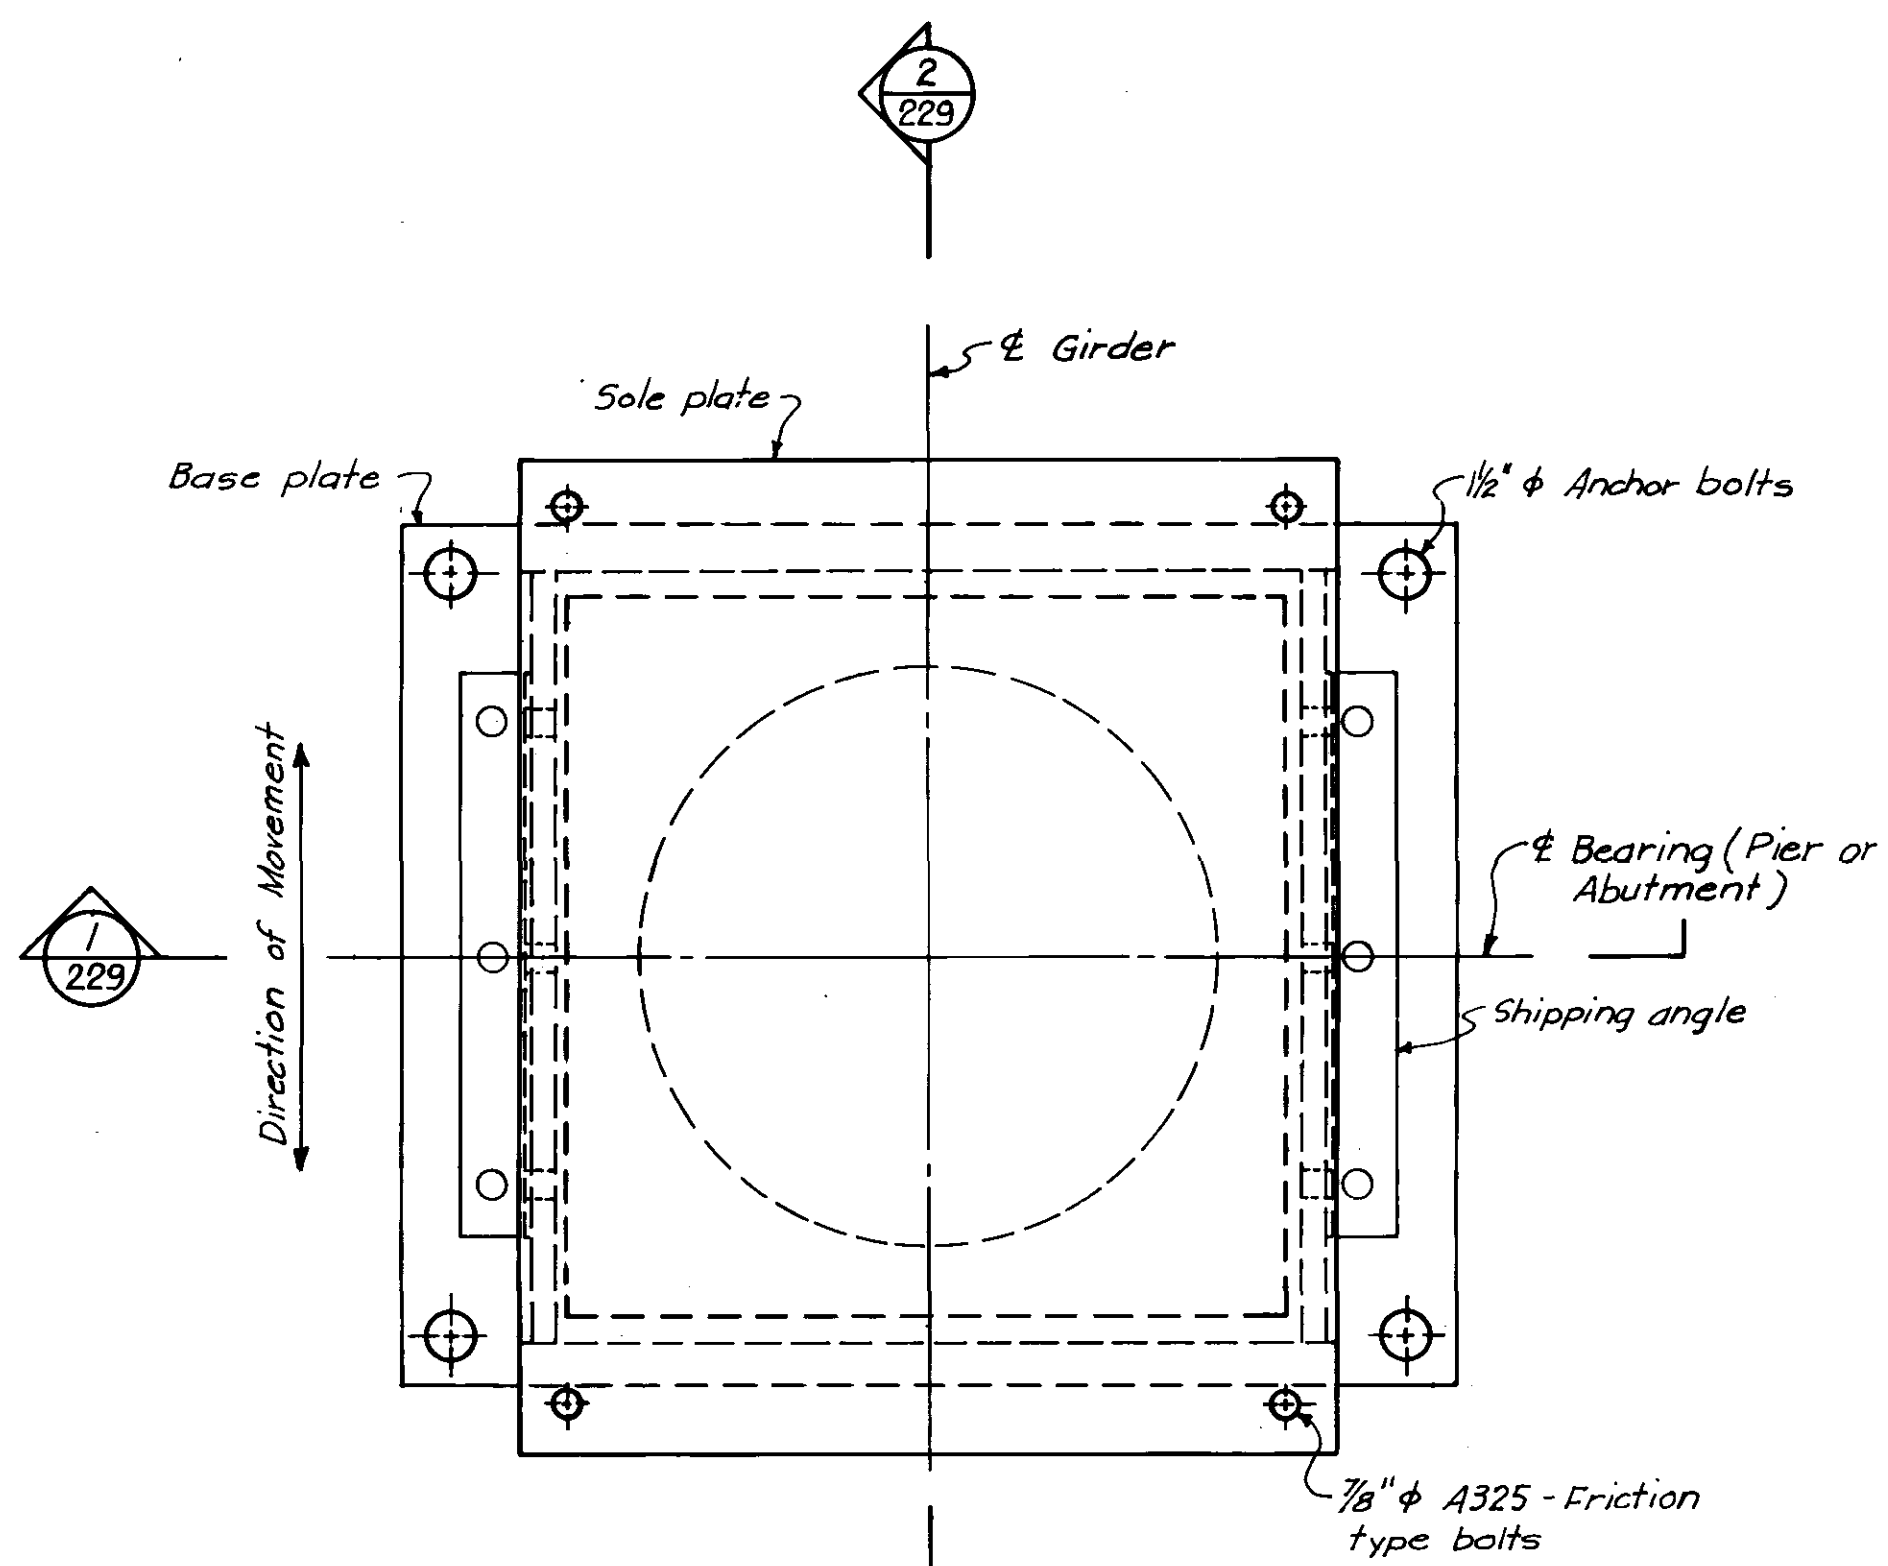


PLAN

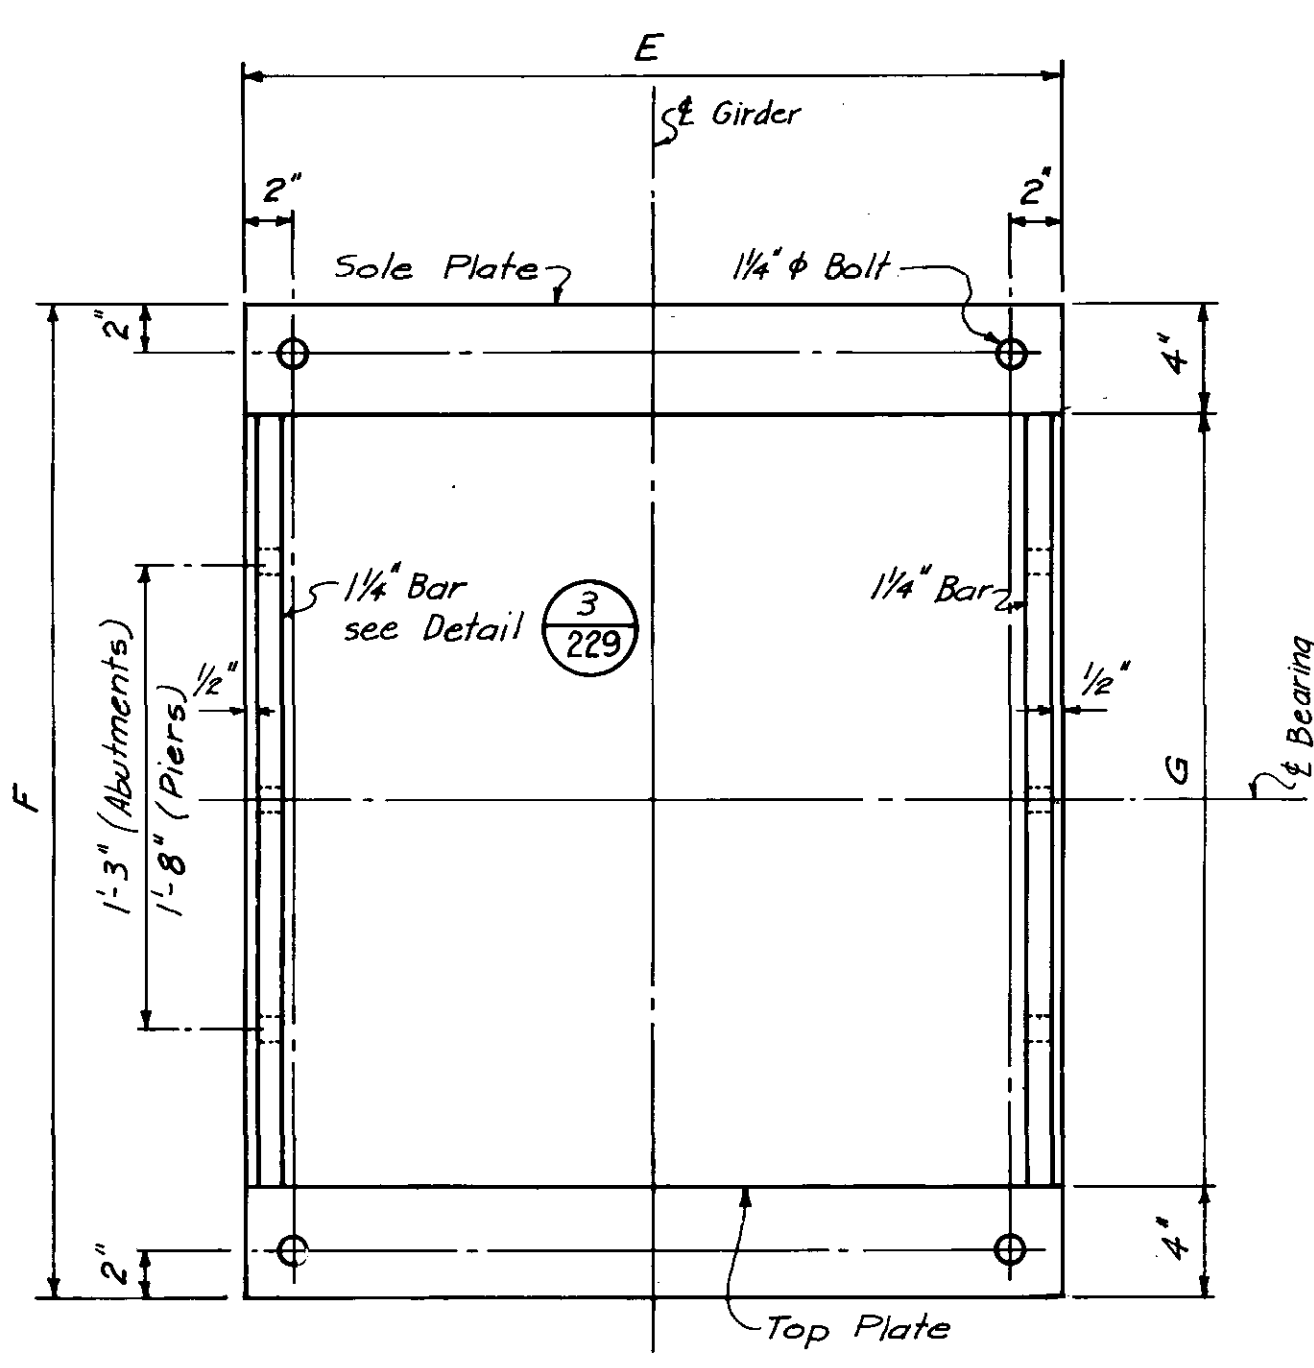

TOP PLATE ASSEMBLY
PIERS 1, 4 AND ABUTMENTS (EXPANSION)


TYPE	LOCATION	BASE PLATE		BASE POT		TOP PLATE			SOLE PLATE				LOAD CAPACITY (KIPS)	TOTAL NUMBER REQUIRED	
		A	B	C	D	I.D.	E	G	H	E	F	J ₁			J ₂
B1	WEST ABUTMENT	1'-10"	1'-10"	1/2"	1'-2 1/2"	1'-0"	1'-6 1/2"	1'-8"	1"	1'-6 1/2"	2'-4"	2 7/32"	1 5/32"	400	4
B2	PIER NO. 1	3'-0"	3'-0"	2"	2'-1 3/4"	1'-9 3/4"	2'-5 3/4"	2'-2 3/4"	1 1/8"	2'-5 3/4"	2'-10 3/4"	1 3/16"	1 3/16"	1300	4
B3	PIER NO. 2	3'-0"	3'-0"	2"	2'-1 3/4"	1'-9 3/4"	2'-5 3/4"	2'-7 1/4"	1 1/8"	2'-5 3/4"	3'-3 1/4"	1 3/16"	1 3/16"	1300	4
B3	PIER NO. 3	3'-0"	3'-0"	2"	2'-1 3/4"	1'-9 3/4"	2'-5 3/4"	2'-7 1/4"	1 1/8"	2'-5 3/4"	3'-3 1/4"	1"	1"	1300	4
B2	PIER NO. 4	3'-0"	3'-0"	2"	2'-1 3/4"	1'-9 3/4"	2'-5 3/4"	2'-2 3/4"	1 1/8"	2'-5 3/4"	2'-10 3/4"	1"	1"	1300	4
B1	EAST ABUTMENT	1'-10"	1'-10"	1/2"	1'-2 1/2"	1'-0"	1'-6 1/2"	1'-8"	1"	1'-6 1/2"	2'-4"	2 7/32"	1 5/32"	400	4

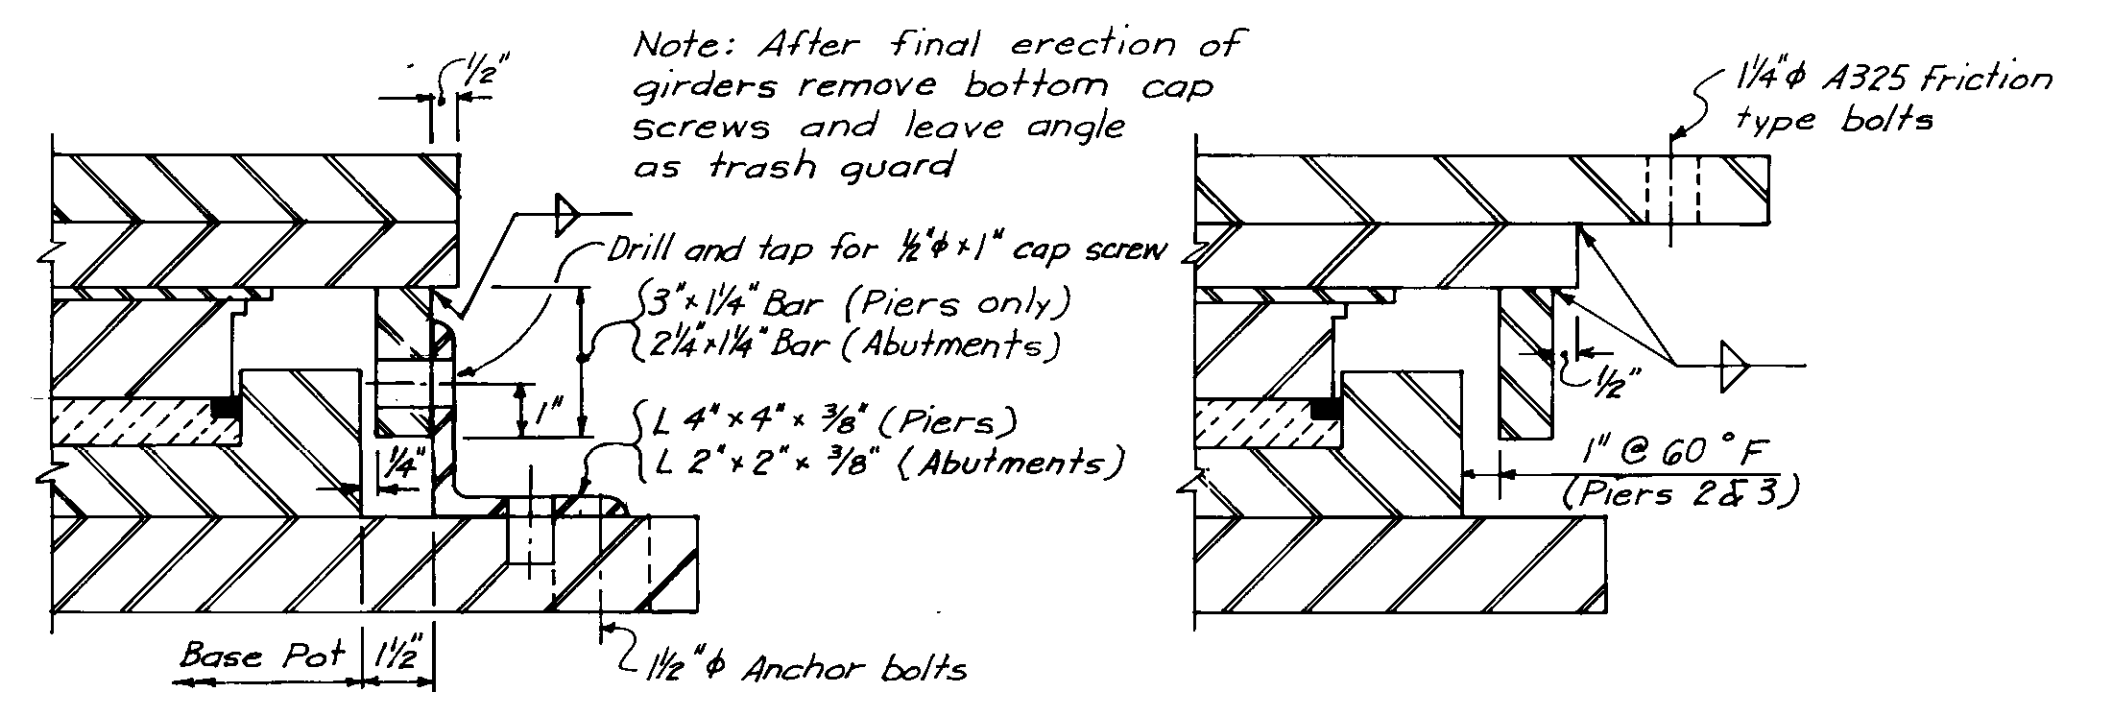


3 DETAIL

4 SECTION


AS - BUILT		
DATE	FB. NO.	PAGE
Nov. 16/77		

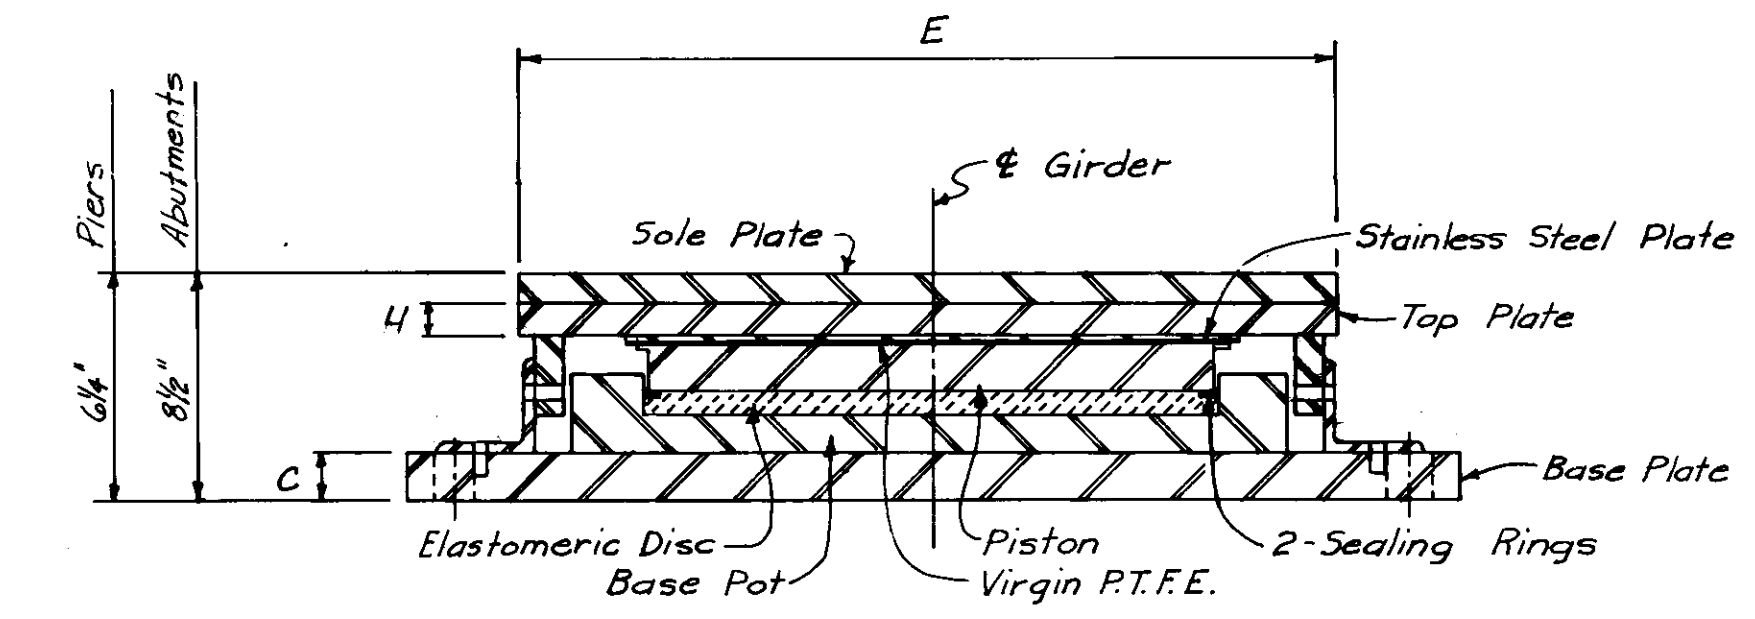

1 SECTION

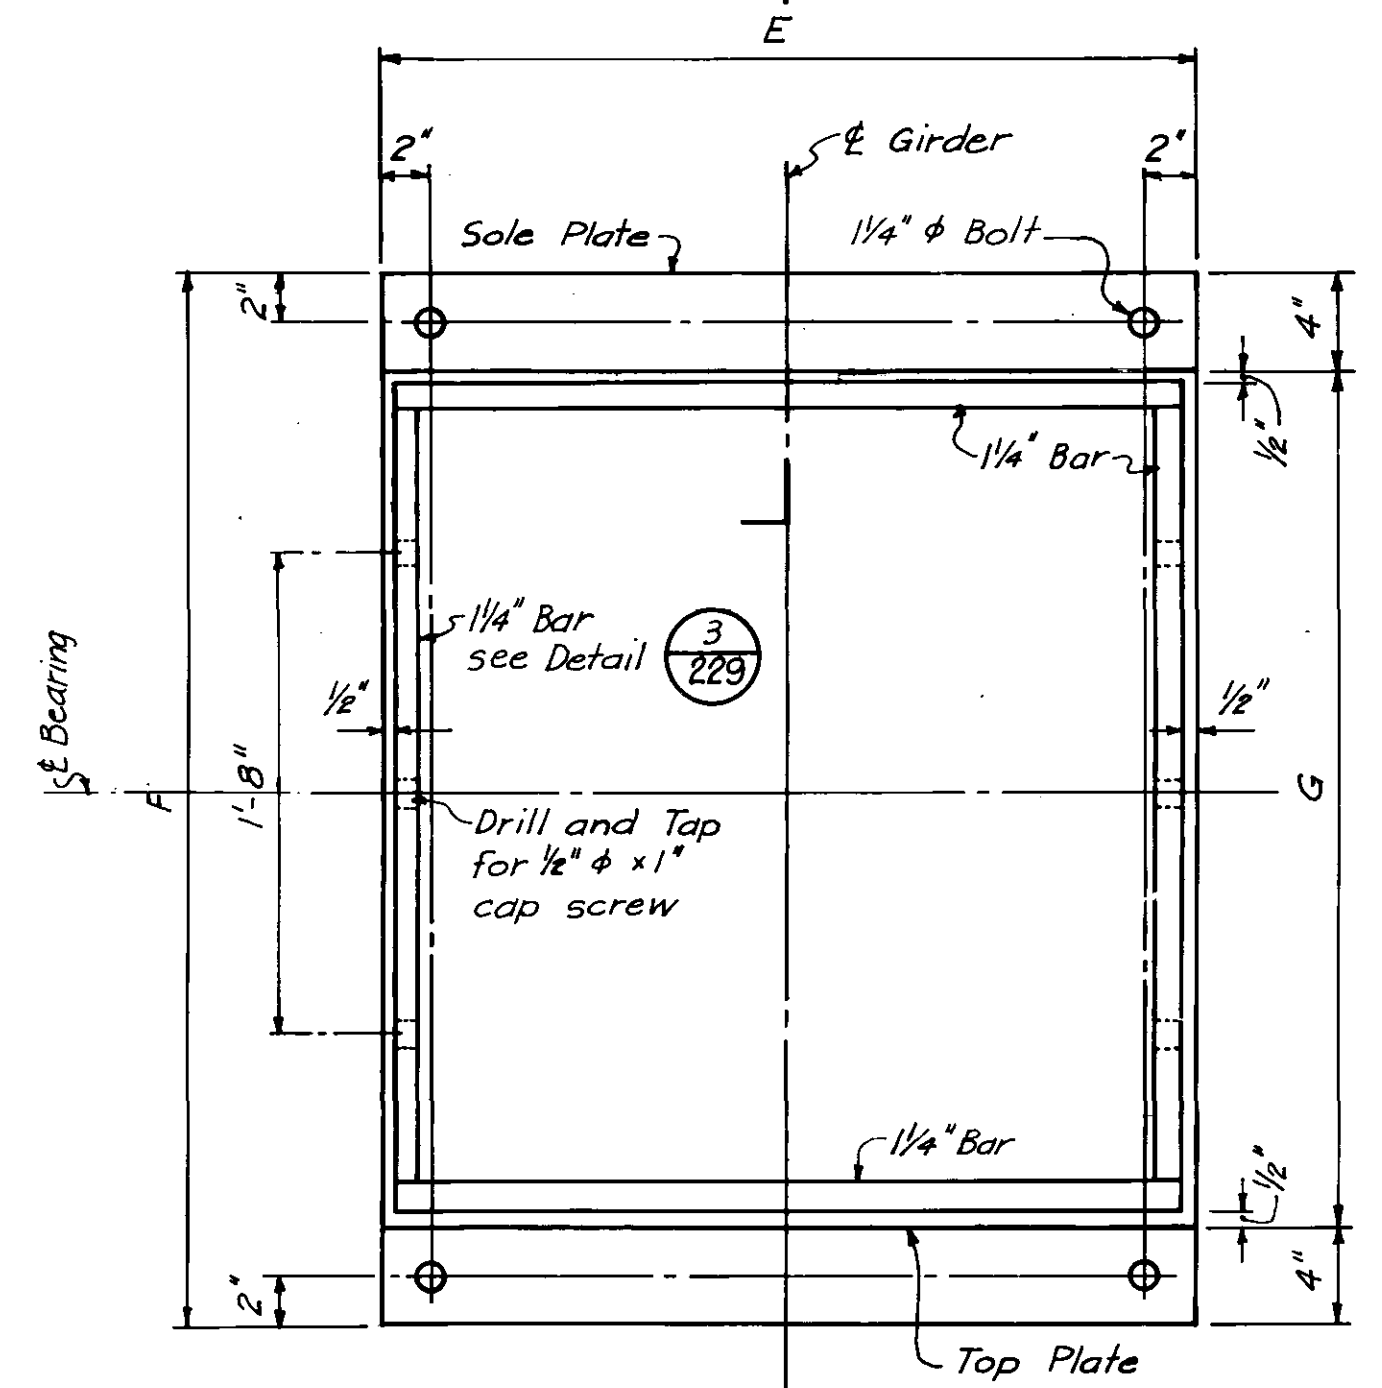


TOP PLATE ASSEMBLY
PIERS 2 AND 3 (FIXED)

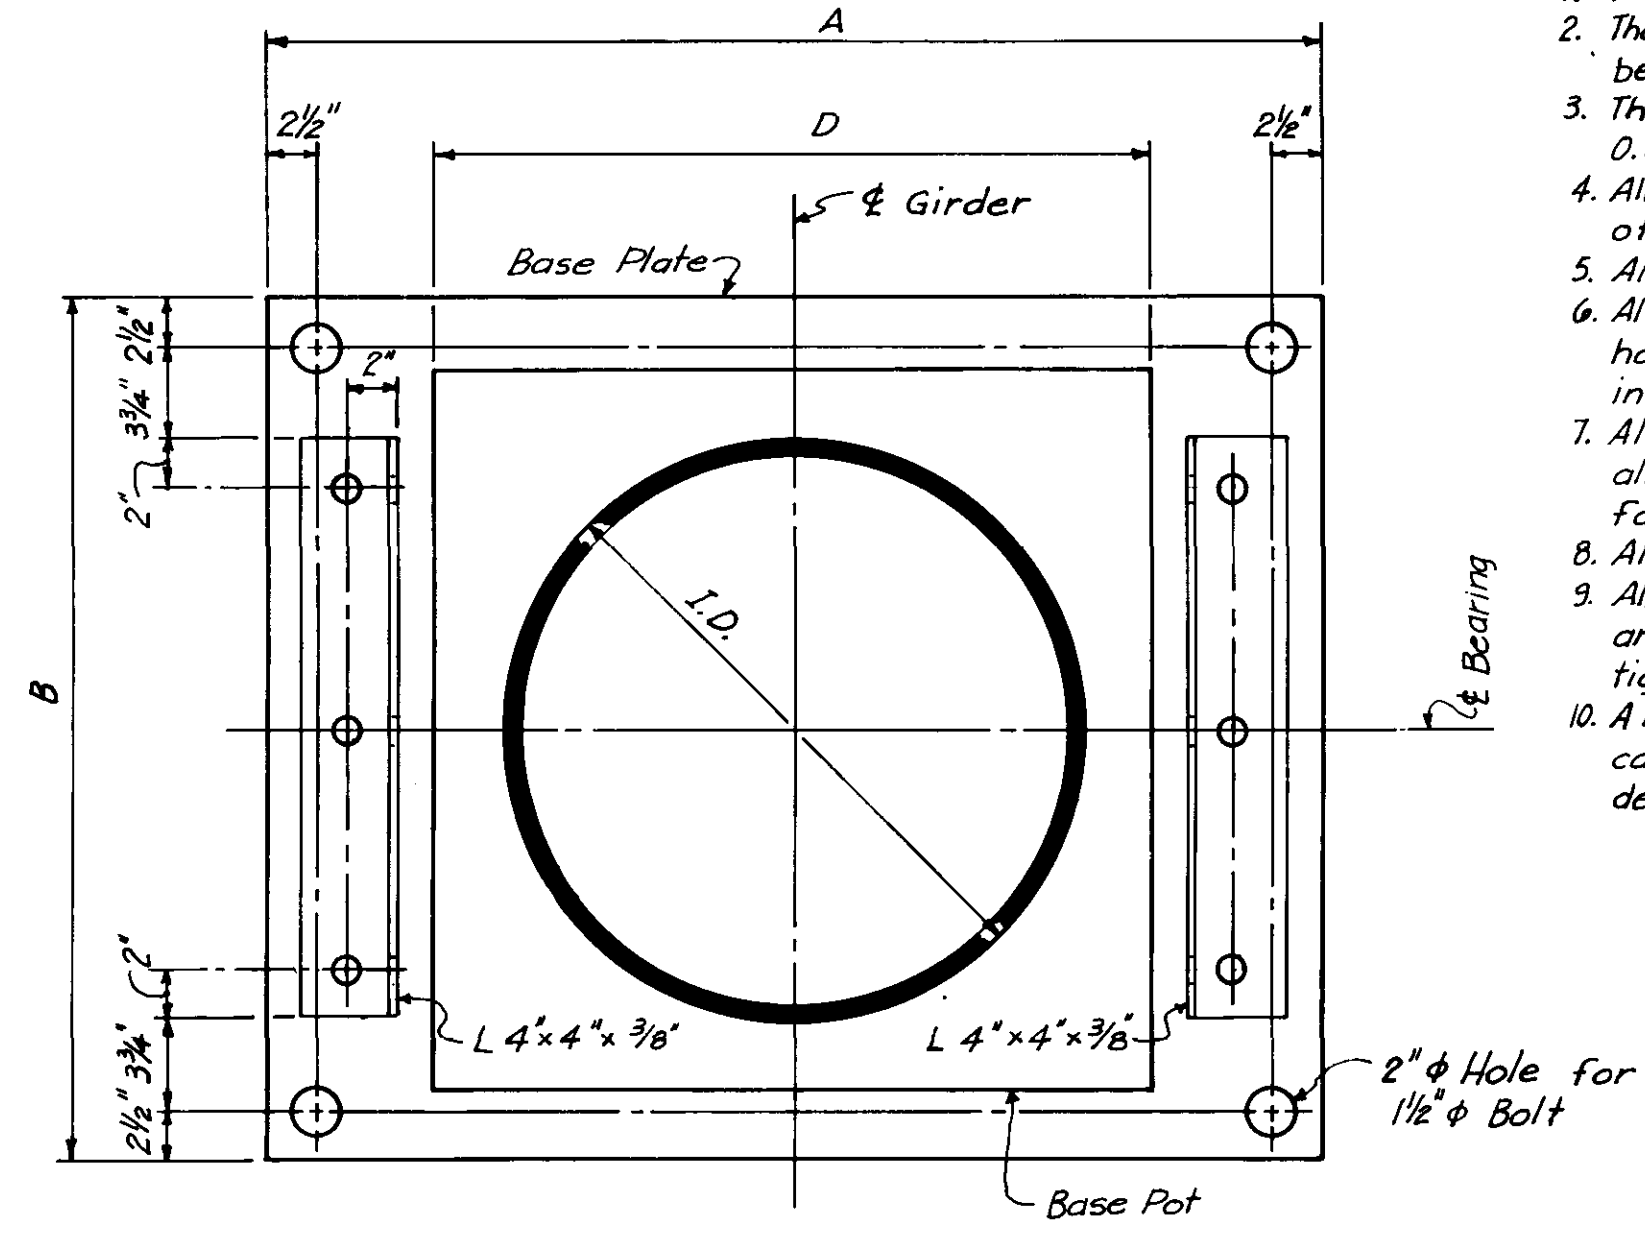

PLAN OF BOTTOM PLATE ASSEMBLY

- Notes:
- All steel in the bearings shall conform to C.S.A. G 40.21-38W.
 - The minimum compressive strength of the elastomeric disc shall be 3500 psi.
 - The minimum rotation capacity of the elastomeric disc shall be 0.01 radians.
 - All expansion and contraction movements are given for a setting of 60°F (15.6°C).
 - All bolt holes shall be made with a steel template.
 - All bearing surfaces shall be milled. Surface roughness shall have a roughness height rating not exceeding 250 as defined in C.S.A. Standard B 95.
 - All bearing surfaces shall be straight within the tolerances allowed by C.S.A. Standard G 40.1 and shall be measured after fabrication and also prior to erection.
 - All plates shall be galvanized in accordance with ASTM A123.
 - All bearings shall be secured to the pier by a single nut anchor bolt system. After adjustment the nut shall be tightened and set.
 - A lead sheet plate 1/8" thick shall be placed on the pier and abutment caps and shall over hang the piers by 1'-0" to act as rust deflectors.

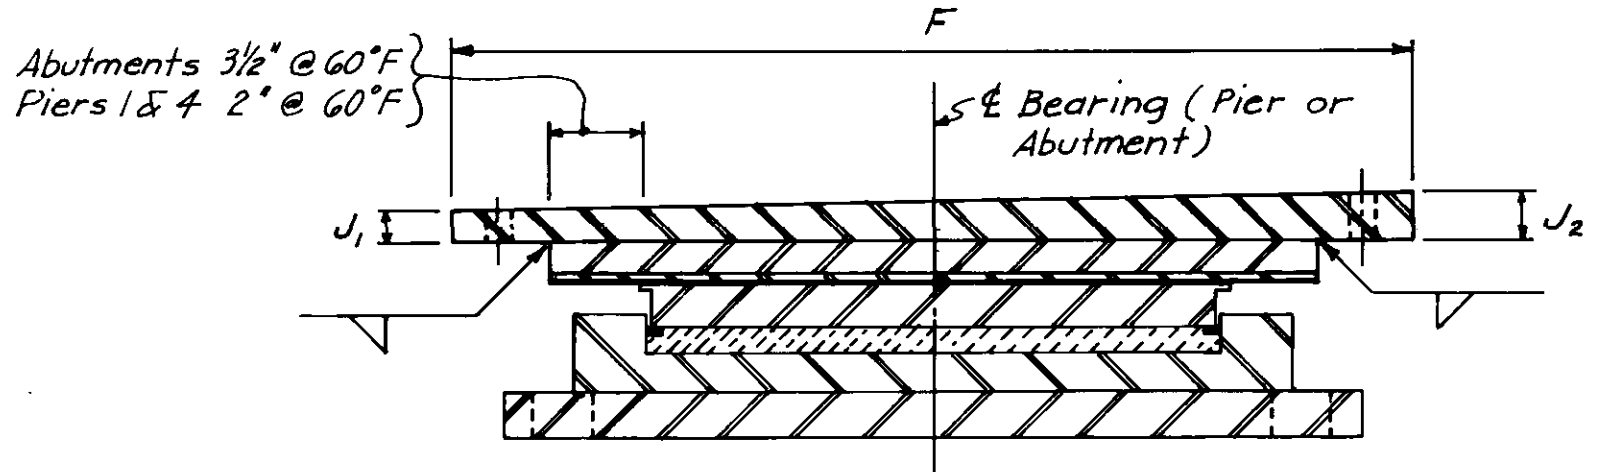


2 SECTION

ISSUED FOR TENDER		4. 4. 77
NO.	REVISIONS	DATE BY
0		

	THE CITY OF WINNIPEG WORKS & OPERATIONS DEPARTMENT STREETS & TRANSPORTATION DIVISION	ROUTE 165	SCALE: NONE
	W.L. WARDROP & ASSOCIATES LTD. ENGINEERING CONSULTANTS WINNIPEG - THUNDER BAY - REGINA - BARRIE - EDMONTON	BEARING DETAILS	
APPROVED BY: <i>[Signature]</i> DATE 25 JAN 77	APPROVED BY: <i>[Signature]</i> DATE 25 JAN 77	DRAWN BY: ST. JAN. 77 PRELIM. CHK. STK. JAN. 77	DESIGN: STK. DEC. 76 CHECK: DLM. JAN. 77


10 INCHES
19
18
17
16
15
14
13
12
11
10

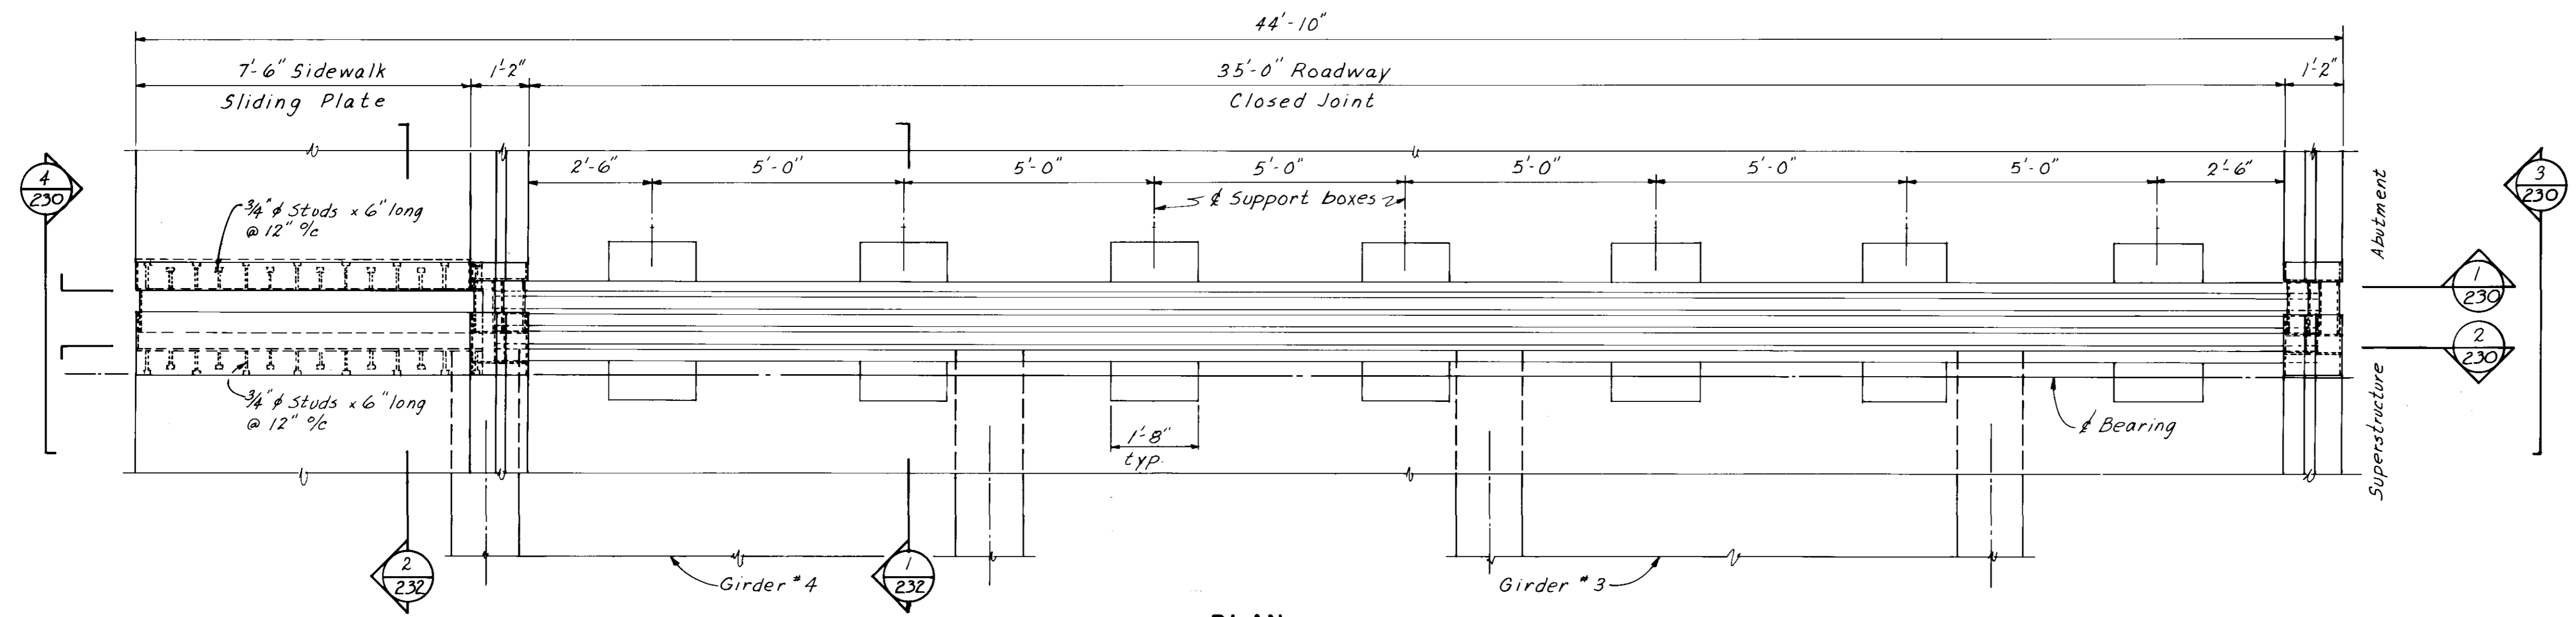


PLAN

Notes:


- Roadway expansion joint shall be similar to the modified Elastometal Limited Wabu Maurer D-1040 and shall be designed for an H525 loading and an impact of 60 %.
- Expansion joint manufacturer shall assist in the supervision of installation.
- Expansion joint to be made to grade and elevation of bridge deck.
- Expansion joint to be completely shop assembled in one length.
- All steel shall be in accordance with CSA specification G40.21 44W or equal.
- Neoprene seal to the requirements of MTC form 1310.
- All exposed surfaces of steel to be zinc metallized in accordance to CSA specification G-188 (5 mils thick) after fabrication.
- Steel extrusion to be in accordance with ASTM specification A-242.
- Welding to be in accordance with CSA W59.

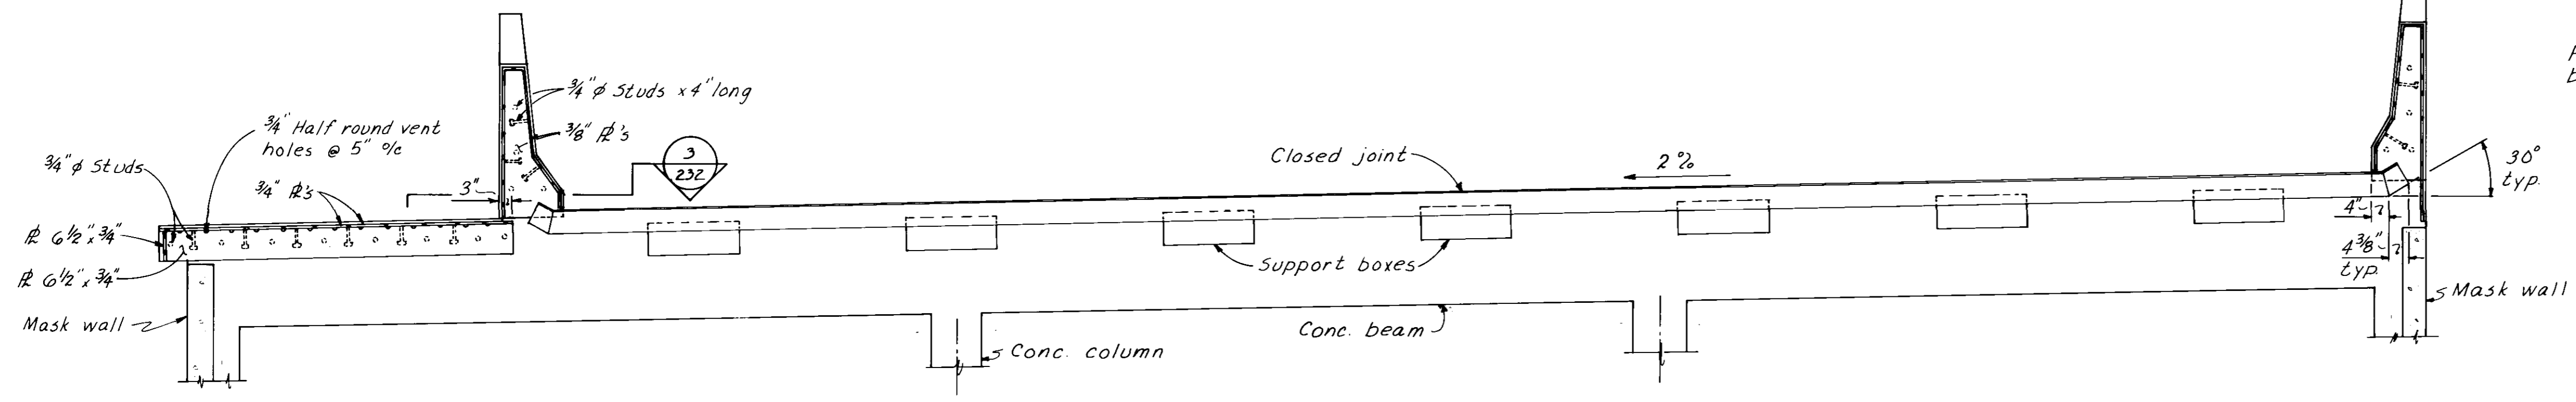


1 ELEVATION - ABUTMENT

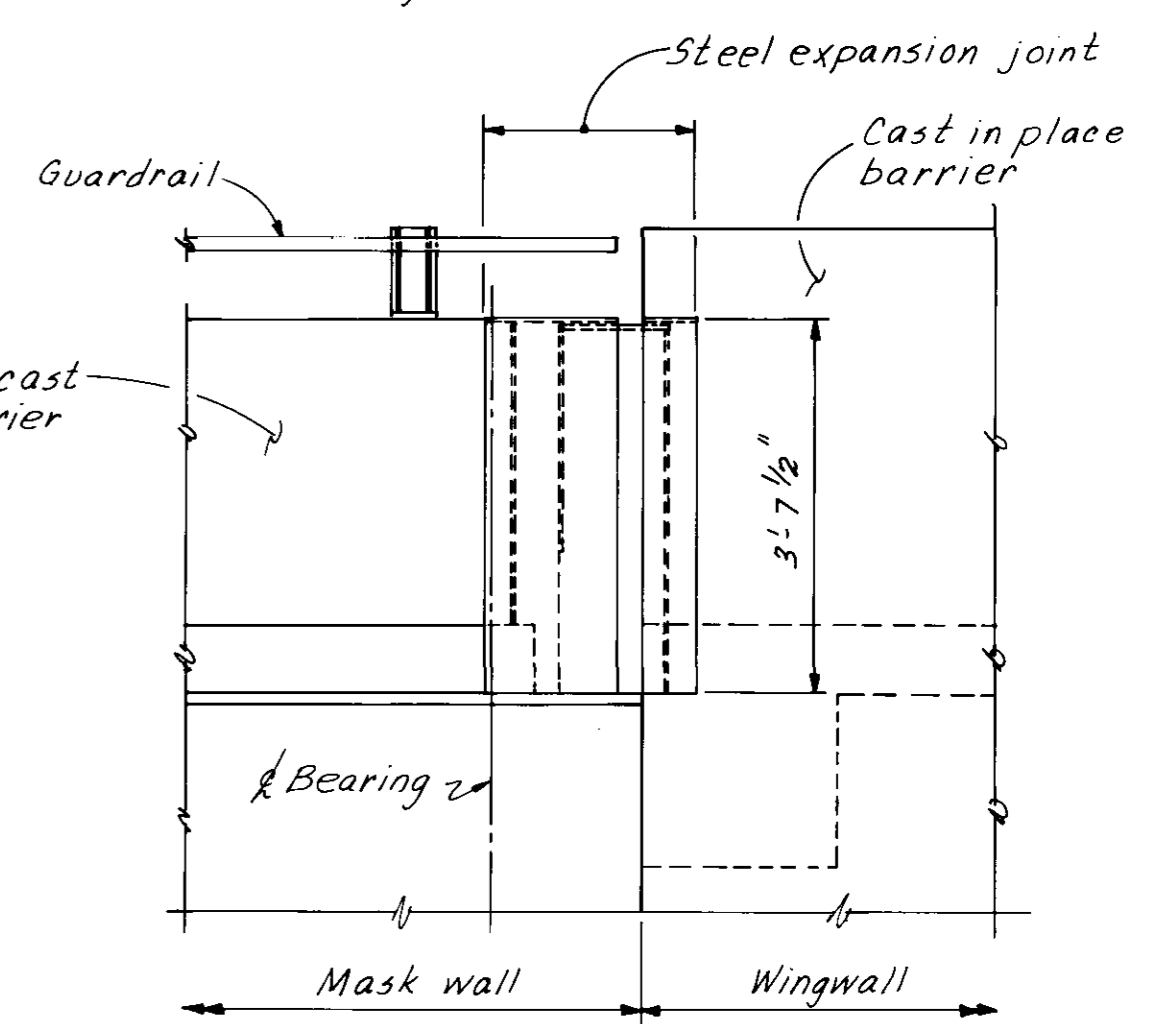

3 ELEVATION - BARRIER CURB

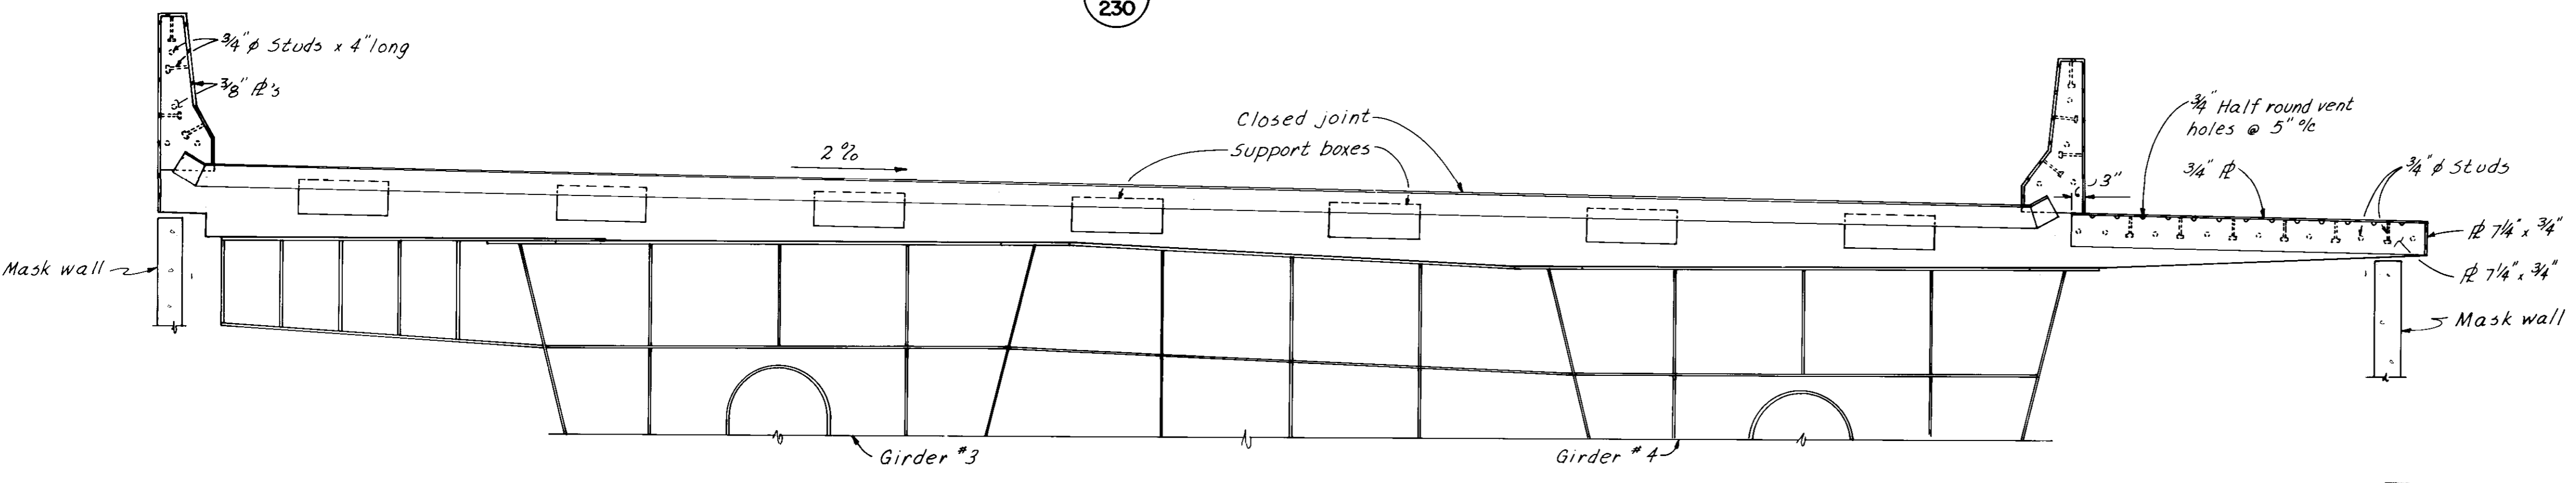

2 ELEVATION - SUPERSTRUCTURE

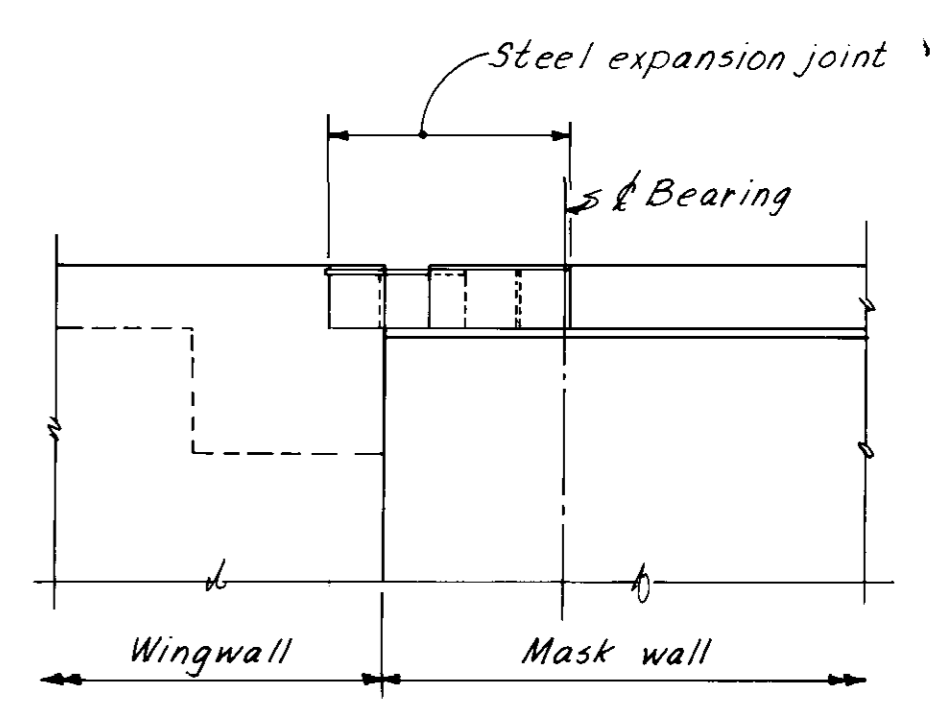


4 ELEVATION - SLIDING PLATE


AS - BUILT
DATE FEB 77
Nov. 16/77

	THE CITY OF WINNIPEG WORKS & OPERATIONS DEPARTMENT STREETS & TRANSPORTATION DIVISION		ROUTE 165	
	W.L. WARDROP & ASSOCIATES LTD. ENGINEERING CONSULTANTS <small>WINNIPEG - THUNDER BAY - REGINA - BARRIE - EDMONTON</small>		SOUTH BRIDGE EXPANSION JOINT LAYOUT	
	APPROVED BY: <i>[Signature]</i> DATE 25 MAR 77		SCALE: 1/2" = 1'-0"	
	DRAWN BY: L.M.G. MAR 77 PRELIM. CHK: <i>[Signature]</i> MAR 77	DESIGN: S.T.K. FEB 77 CHECK: <i>[Signature]</i> MAR 77	APPROVED BY: <i>[Signature]</i> 28/3/77 MANAGER OF STREETS AND TRAFFIC	DRAWING NO. B-5092-230


10 INCHES
9
8
7
6
4
3
12
11
10

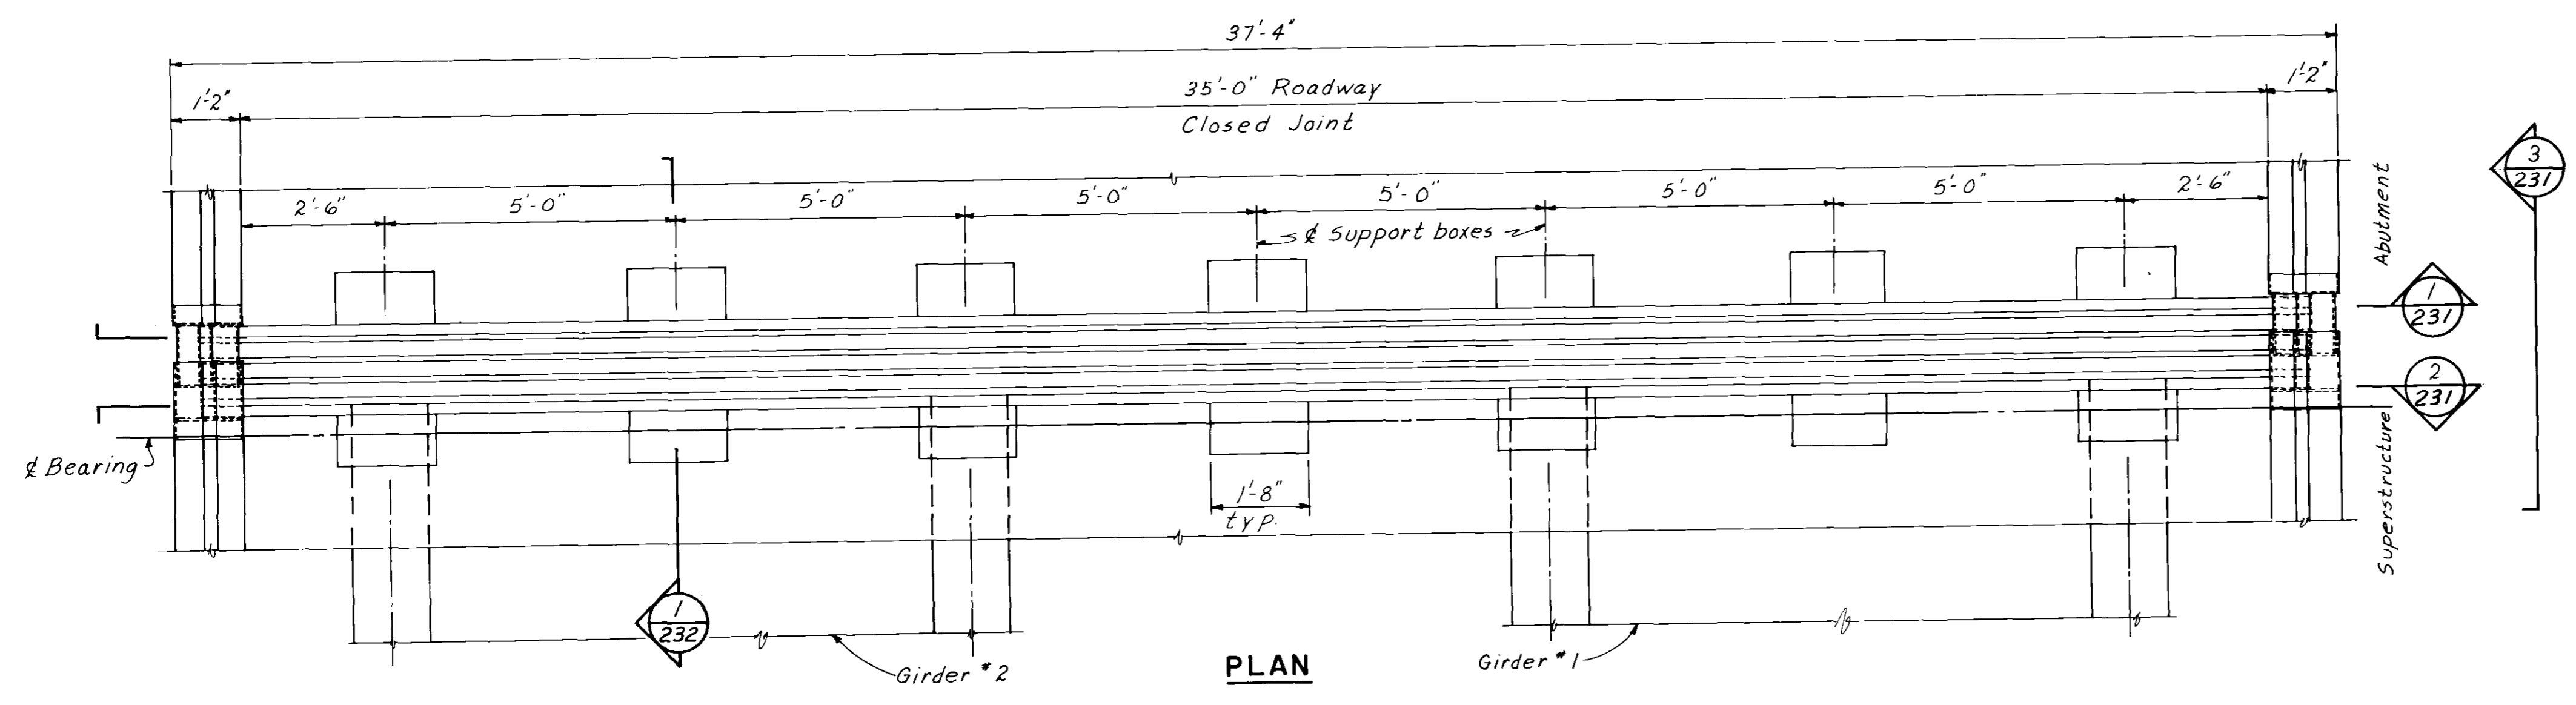


PLAN

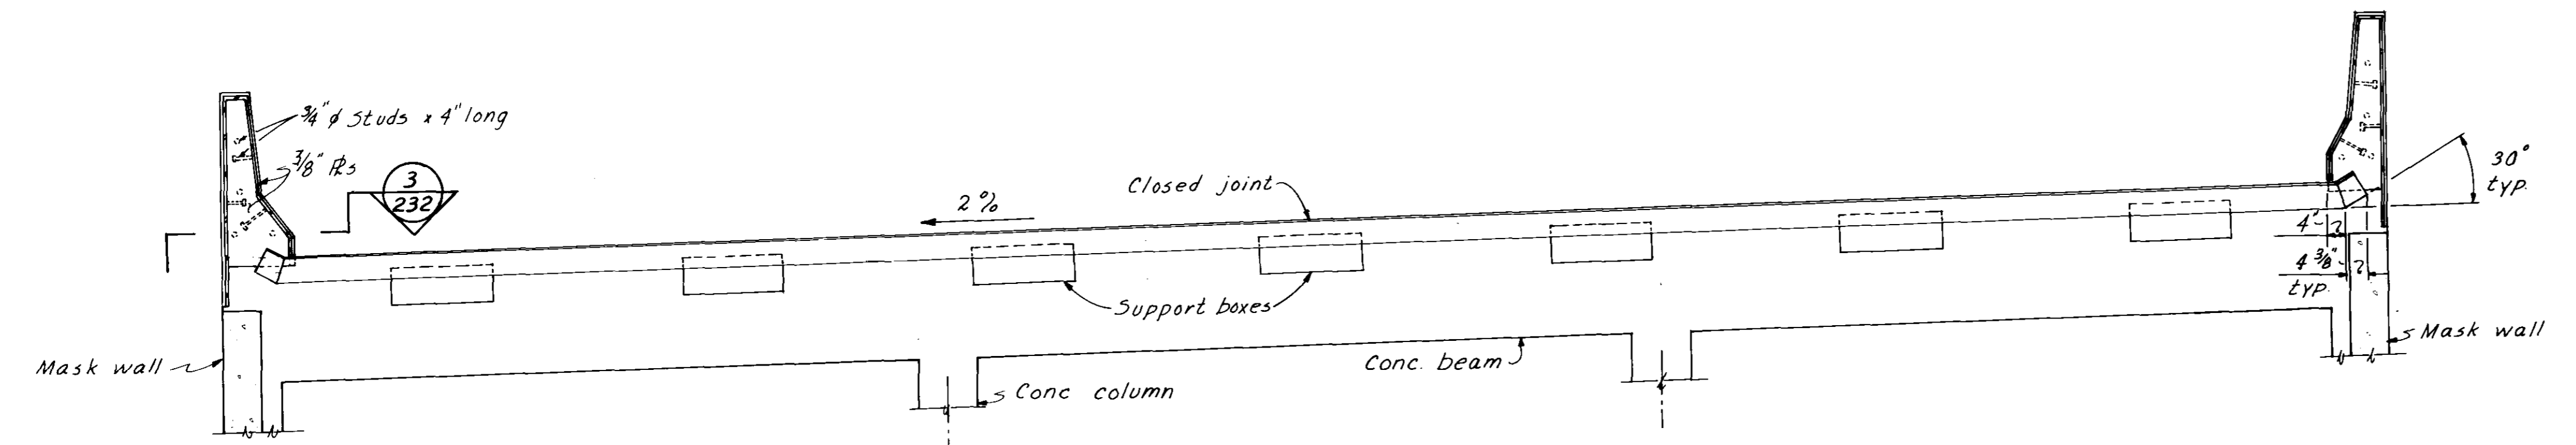

1 ELEVATION - ABUTMENT

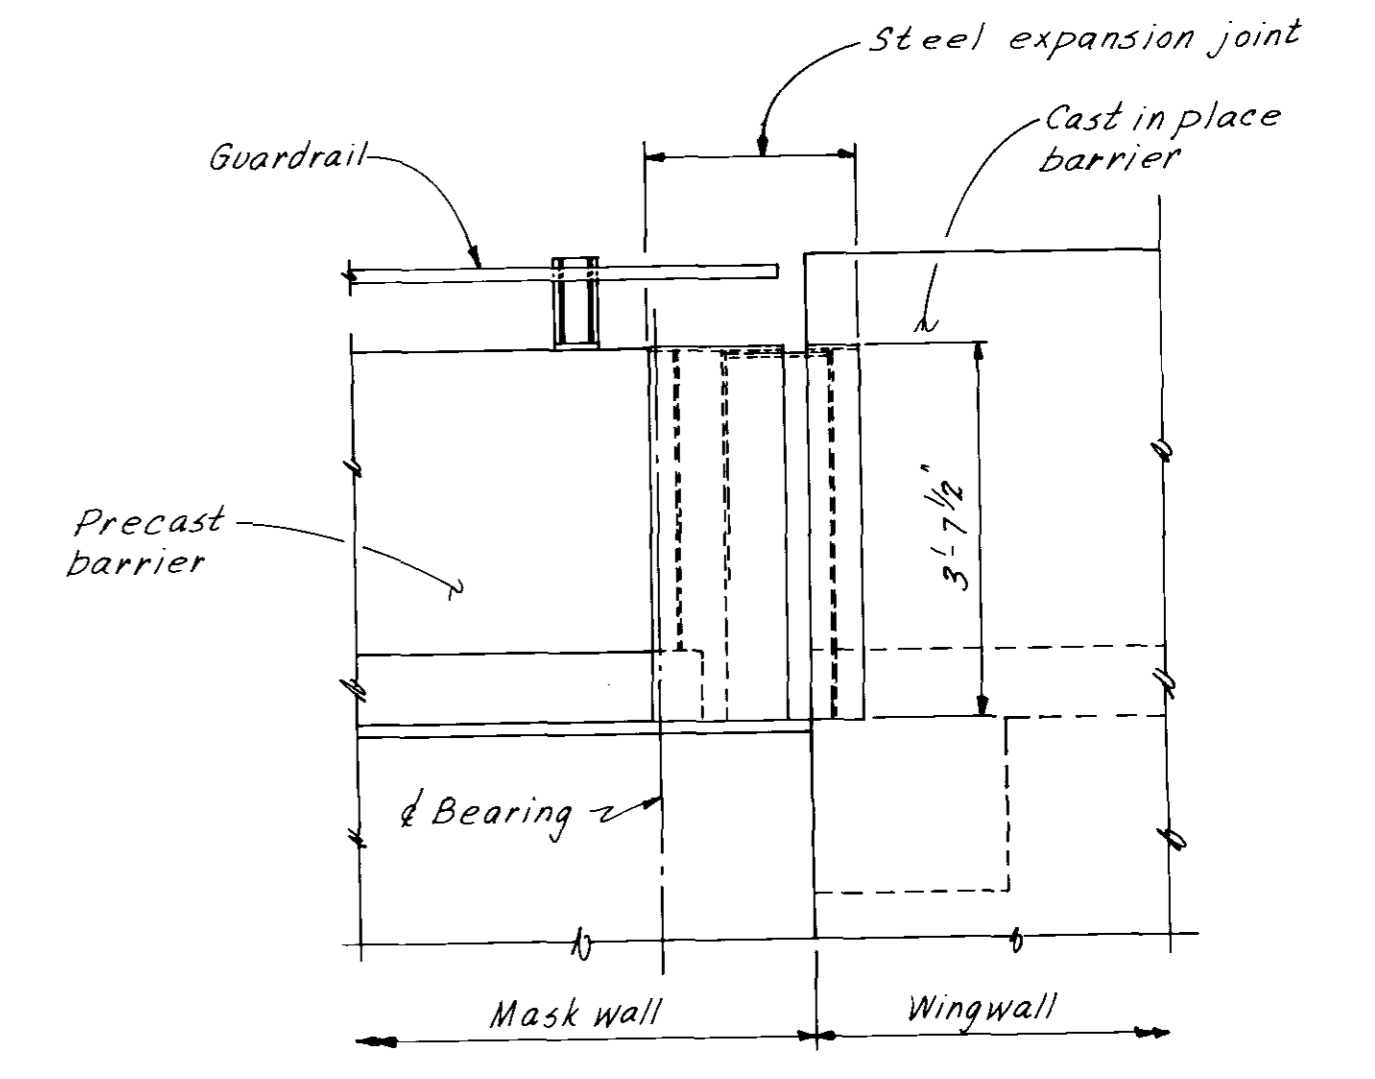

3 ELEVATION - BARRIER CURB




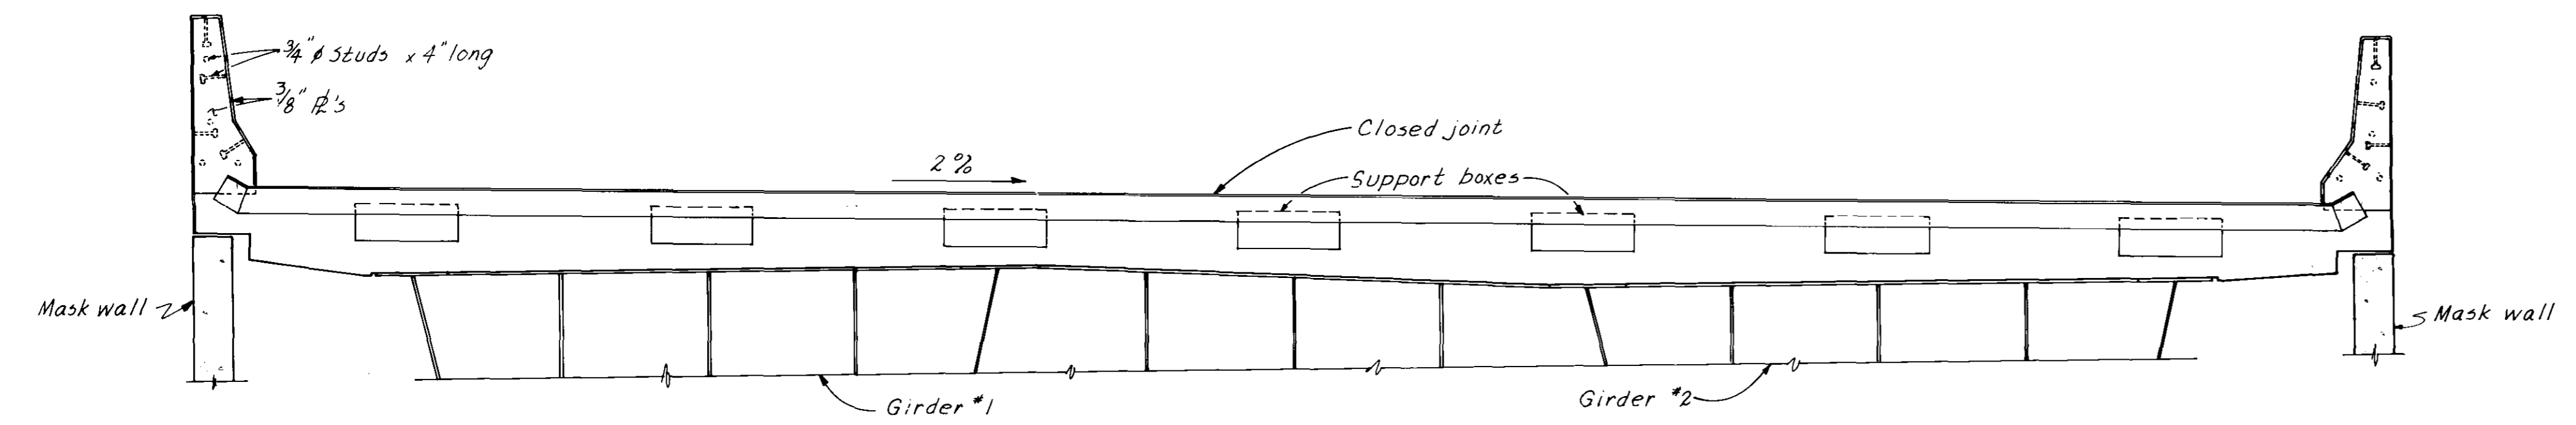


2 ELEVATION - SUPERSTRUCTURE

AS BUILT
DATE
Nov. 14/77

REVISIONS DATE BY 4.4.77		THE CITY OF WINNIPEG WORKS & OPERATIONS DEPARTMENT STREETS & TRANSPORTATION DIVISION	ROUTE 165	SCALE: 1/2" = 1'-0"
		W.L. WARDROP & ASSOCIATES LTD. ENGINEERING CONSULTANTS <small>REGISTERED ENGINEERS - PROFESSIONAL ENGINEERS - COMPTON</small>	NORTH BRIDGE EXPANSION JOINT LAYOUT	
		APPROVED BY: <i>[Signature]</i> DATE 25 May 77	APPROVED BY: <i>[Signature]</i> DATE 25/5/77	
		DRAWN BY: LMG MAR 77 PRELIM CHK: <i>[Signature]</i> MAR 77	DESIGN: STK FEB 77 CHECK: <i>[Signature]</i> MAR 77	
		DRAWING NO. B-5092-231	W.L.W. NO. 74012-21	


110 INCHES
19
18
17
16
15
14
13
12
11
10

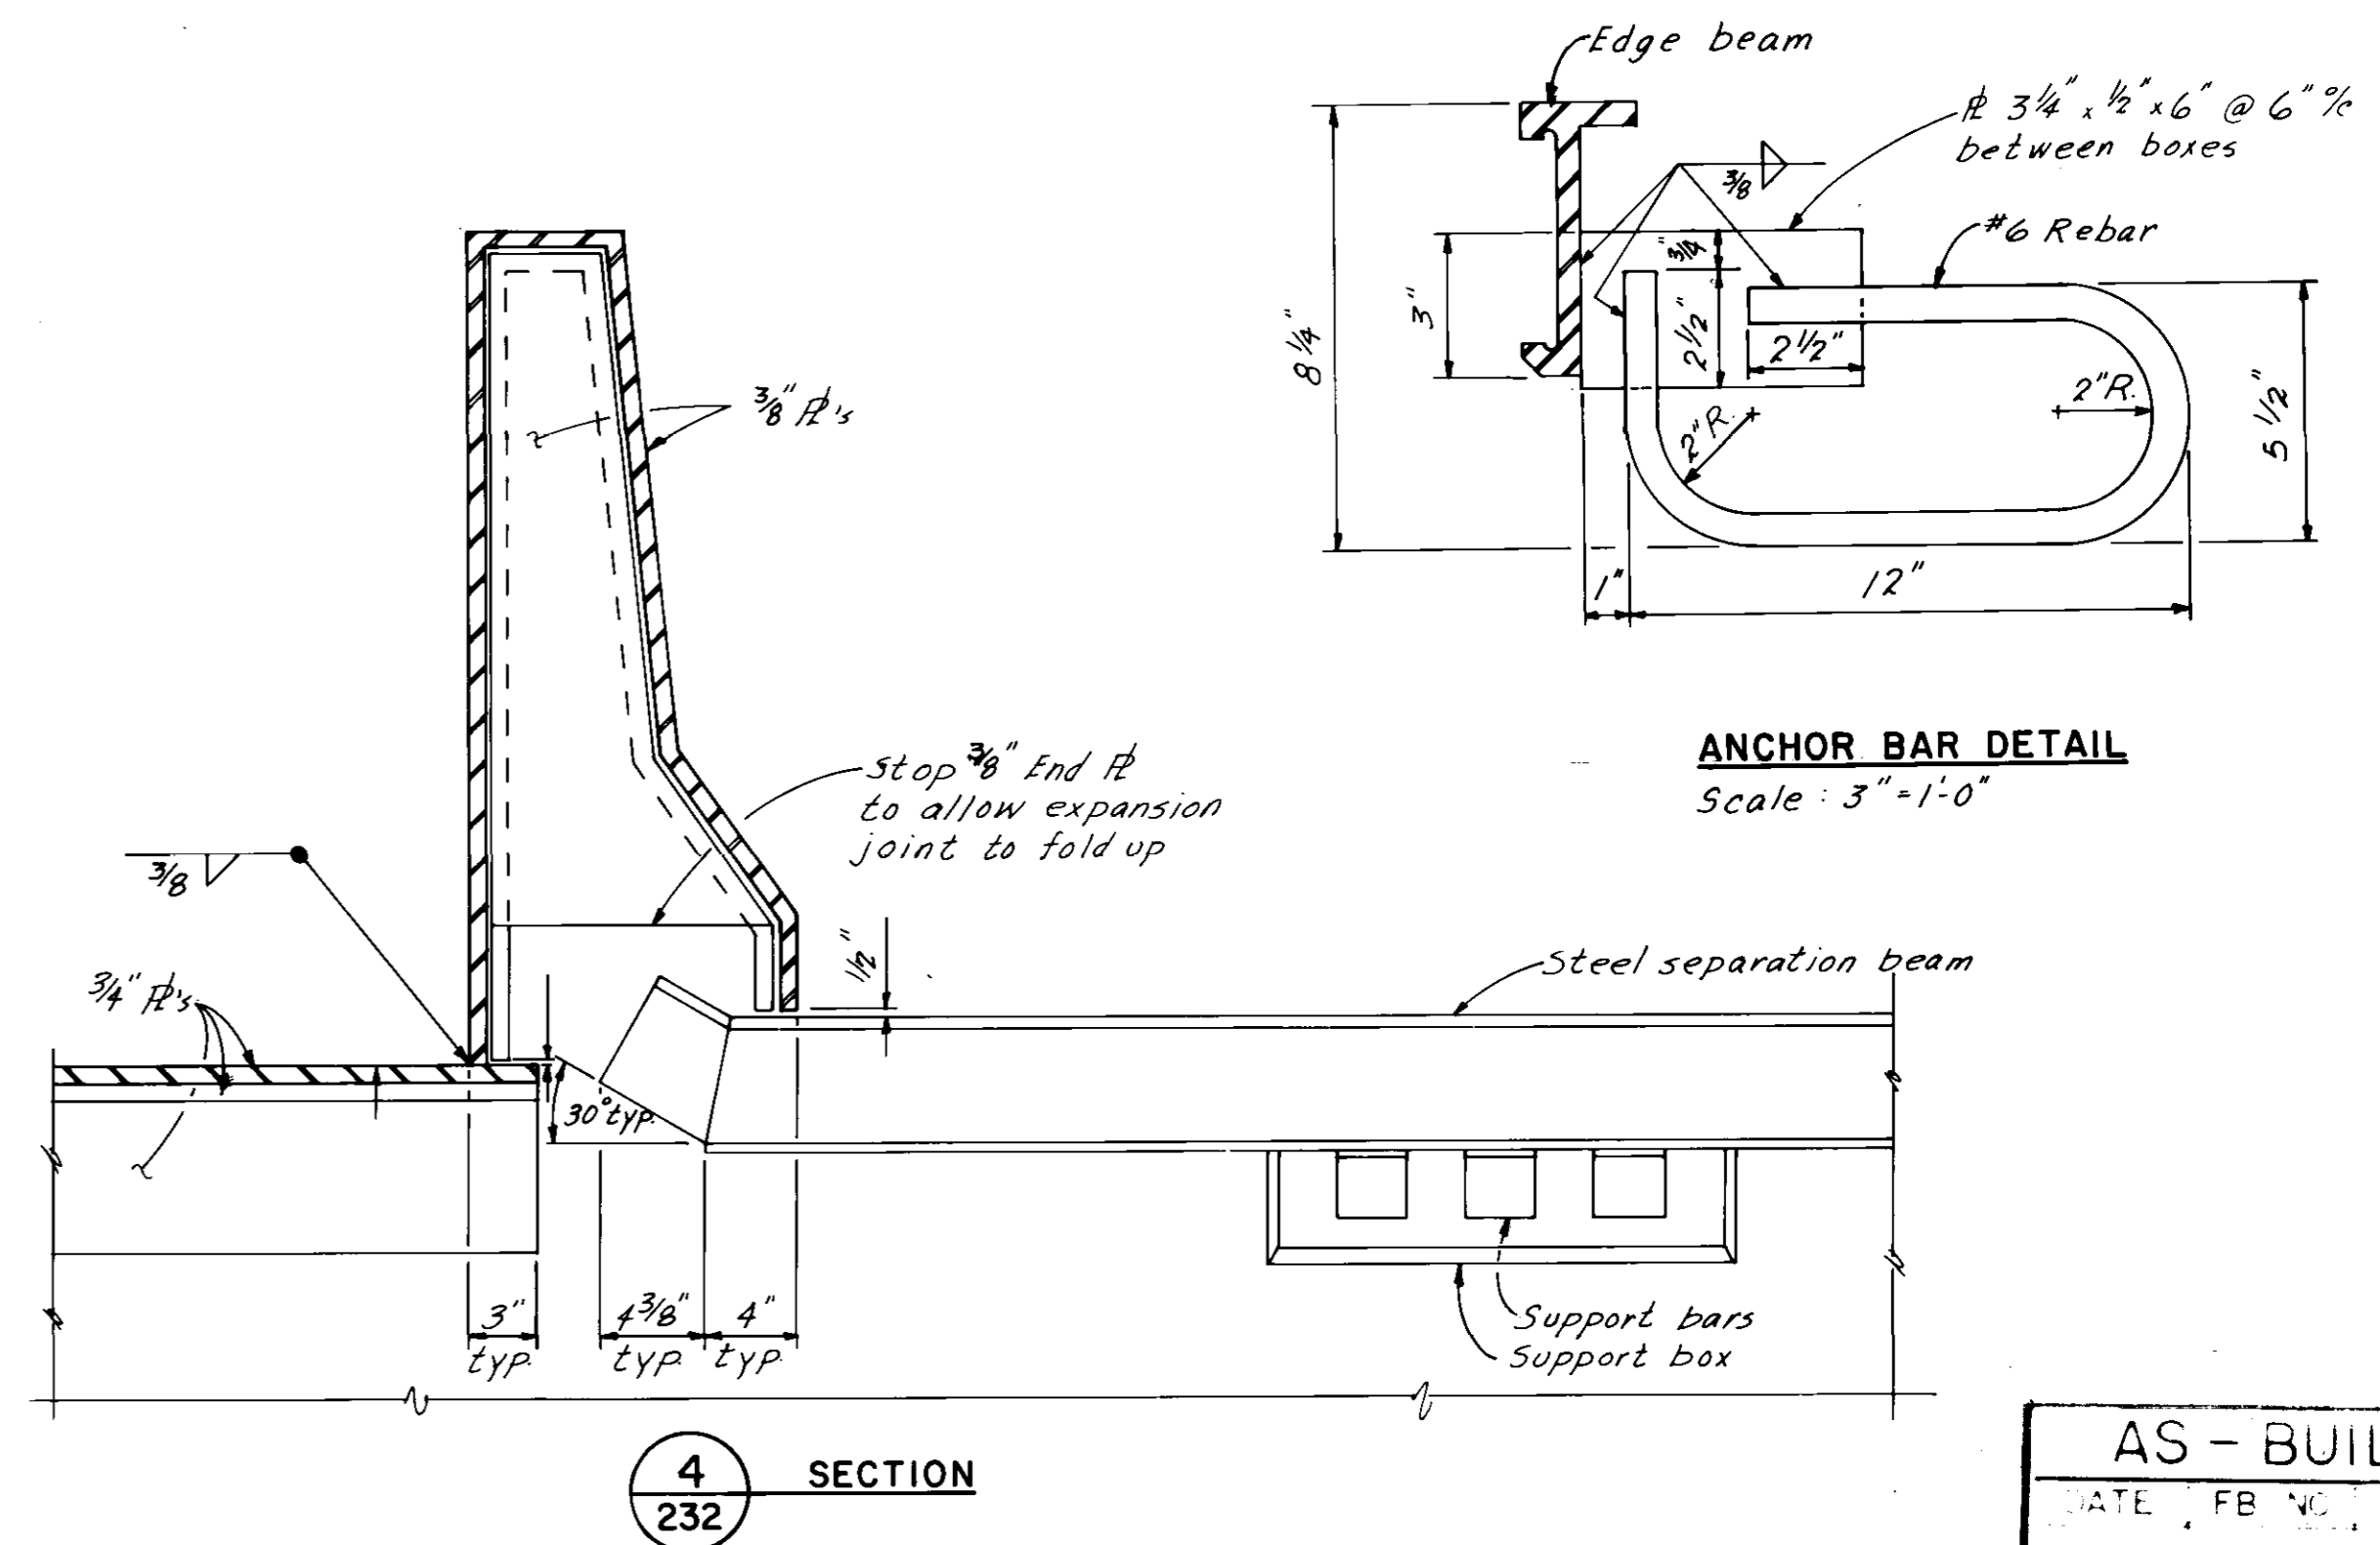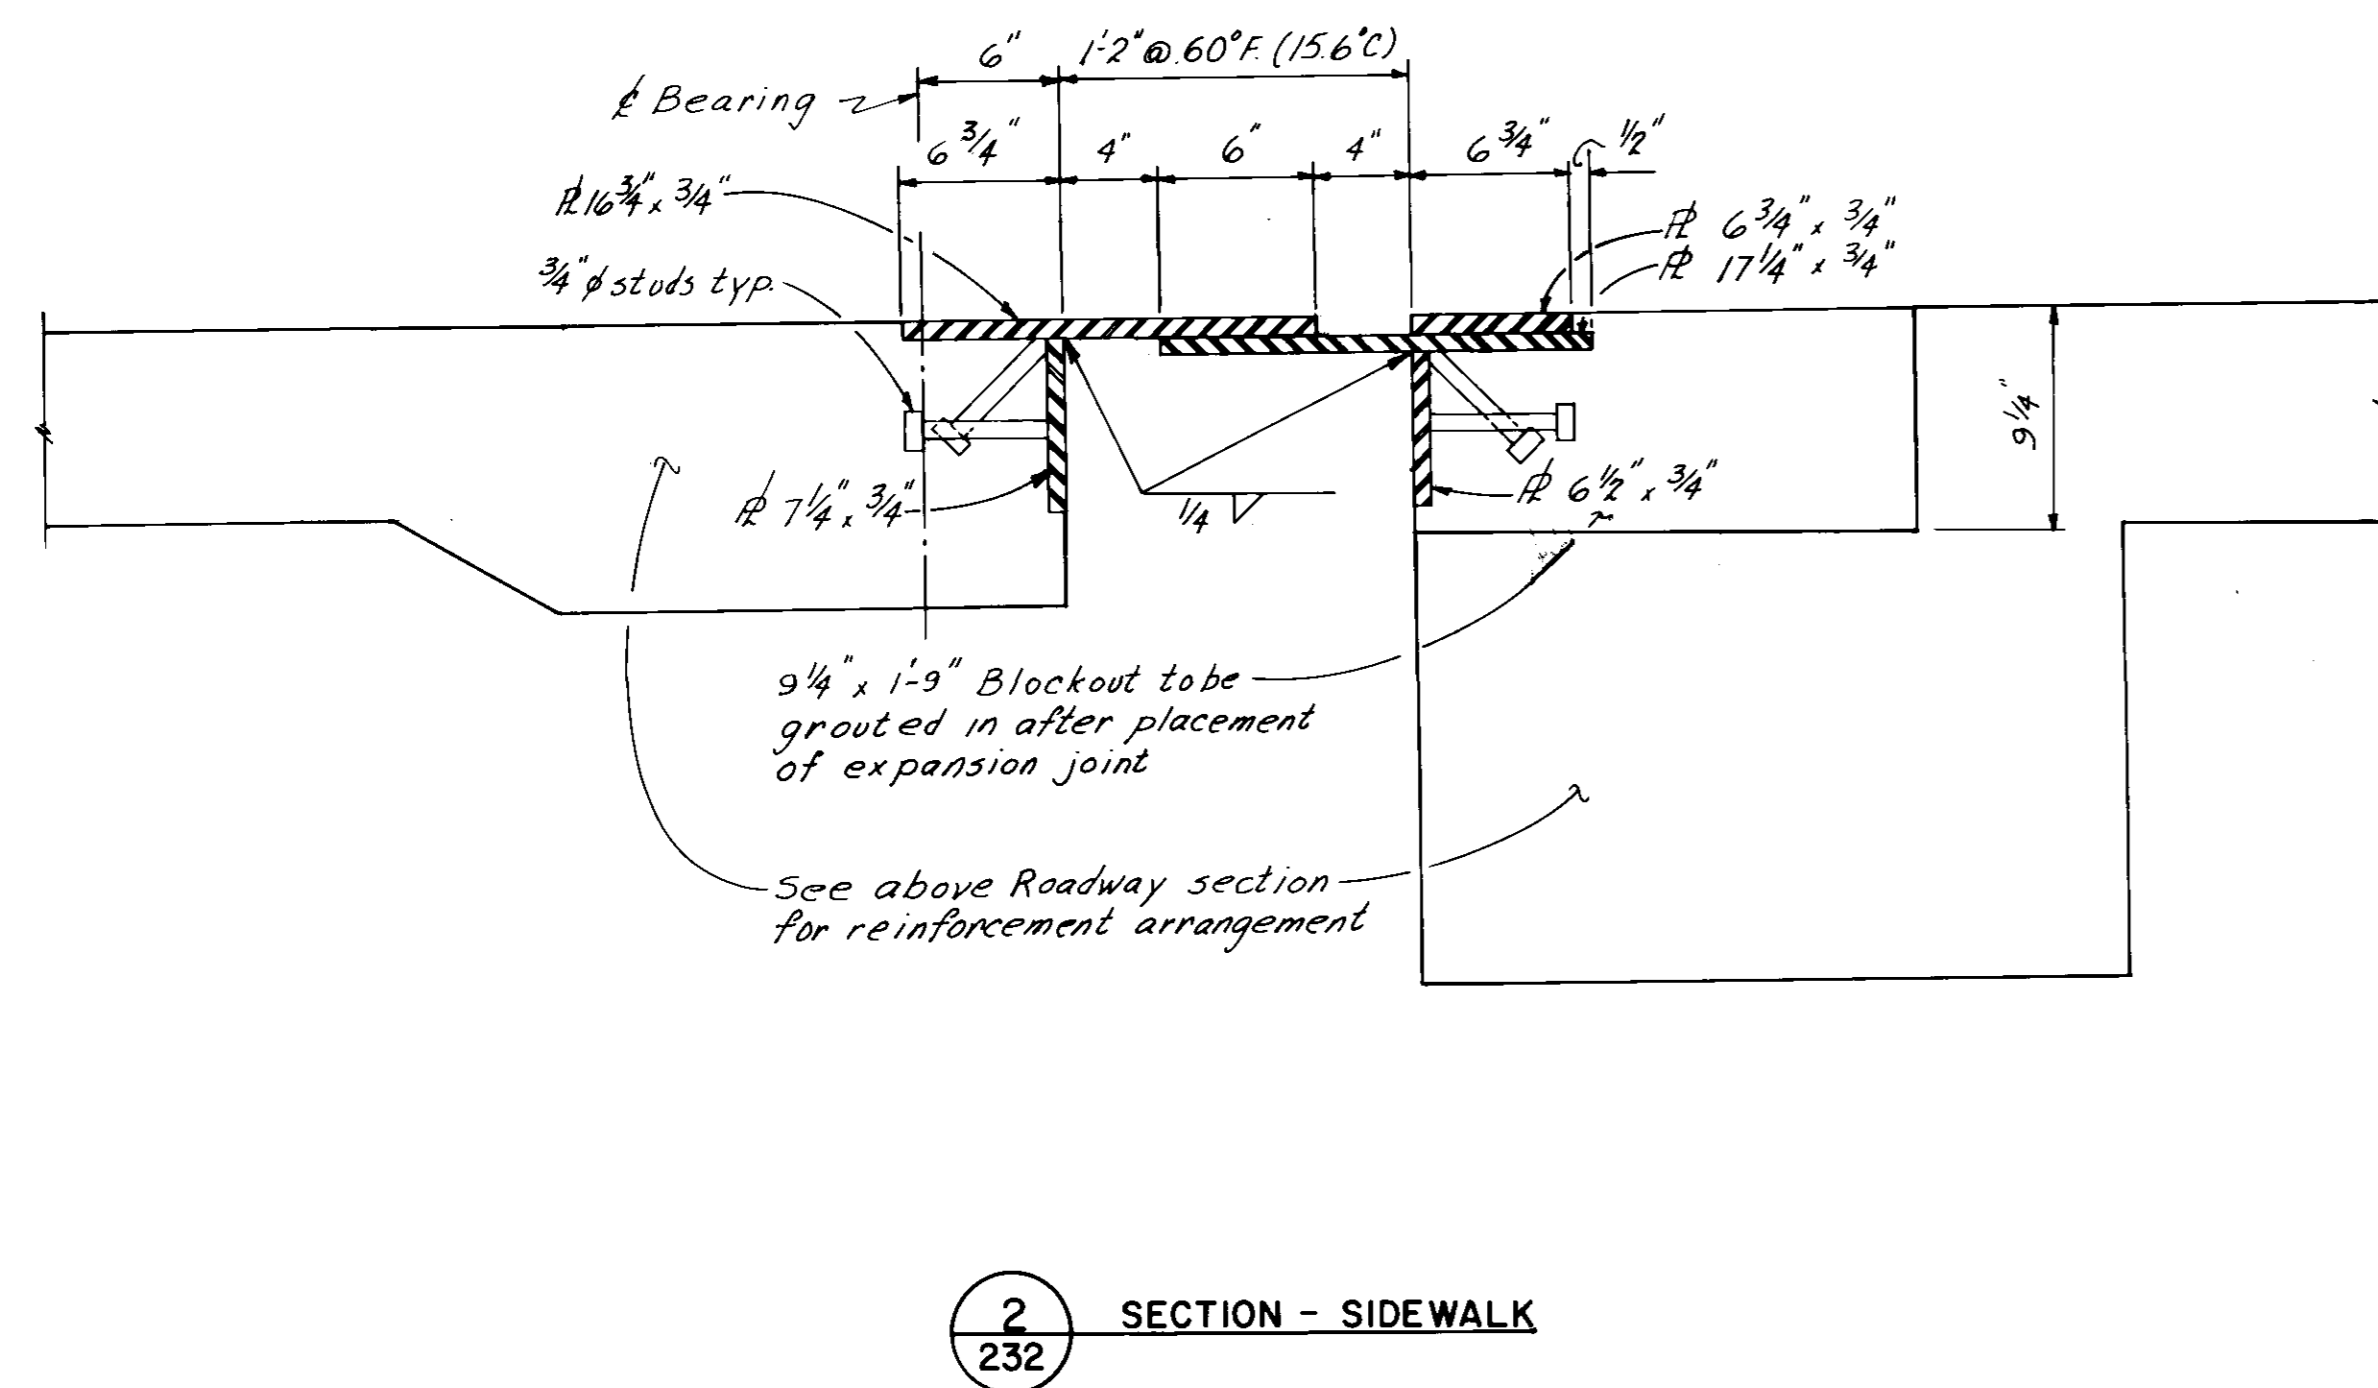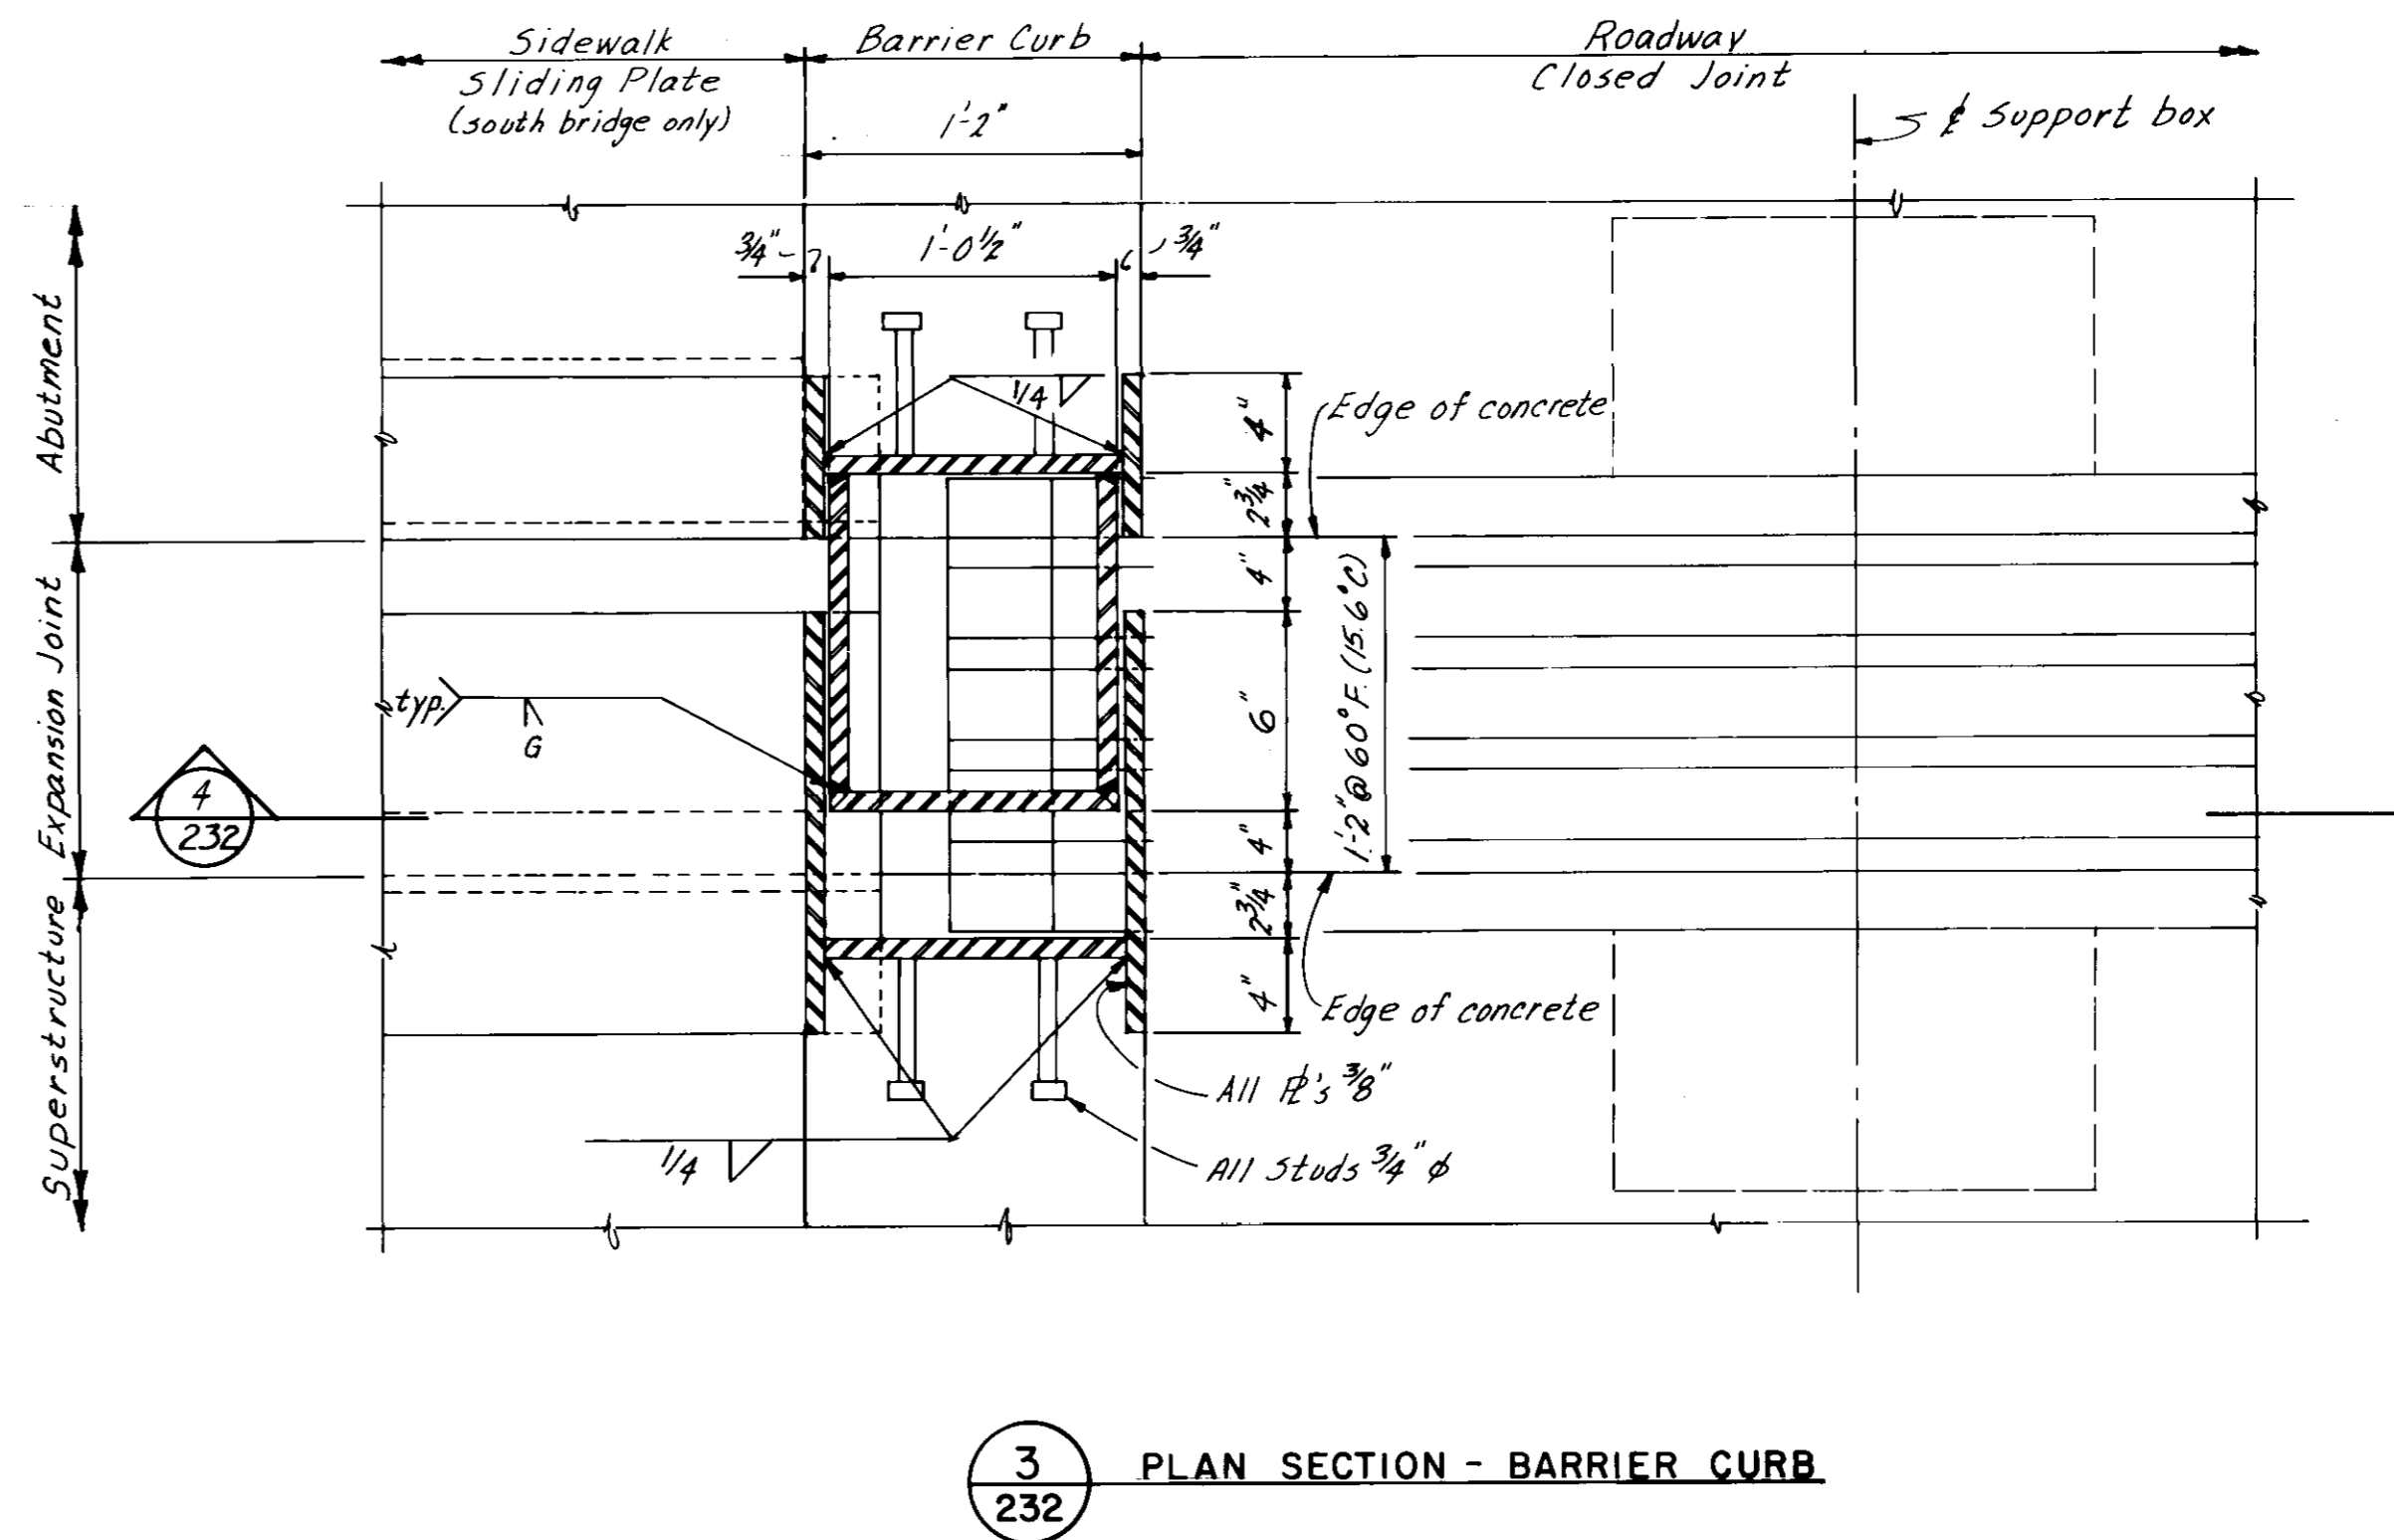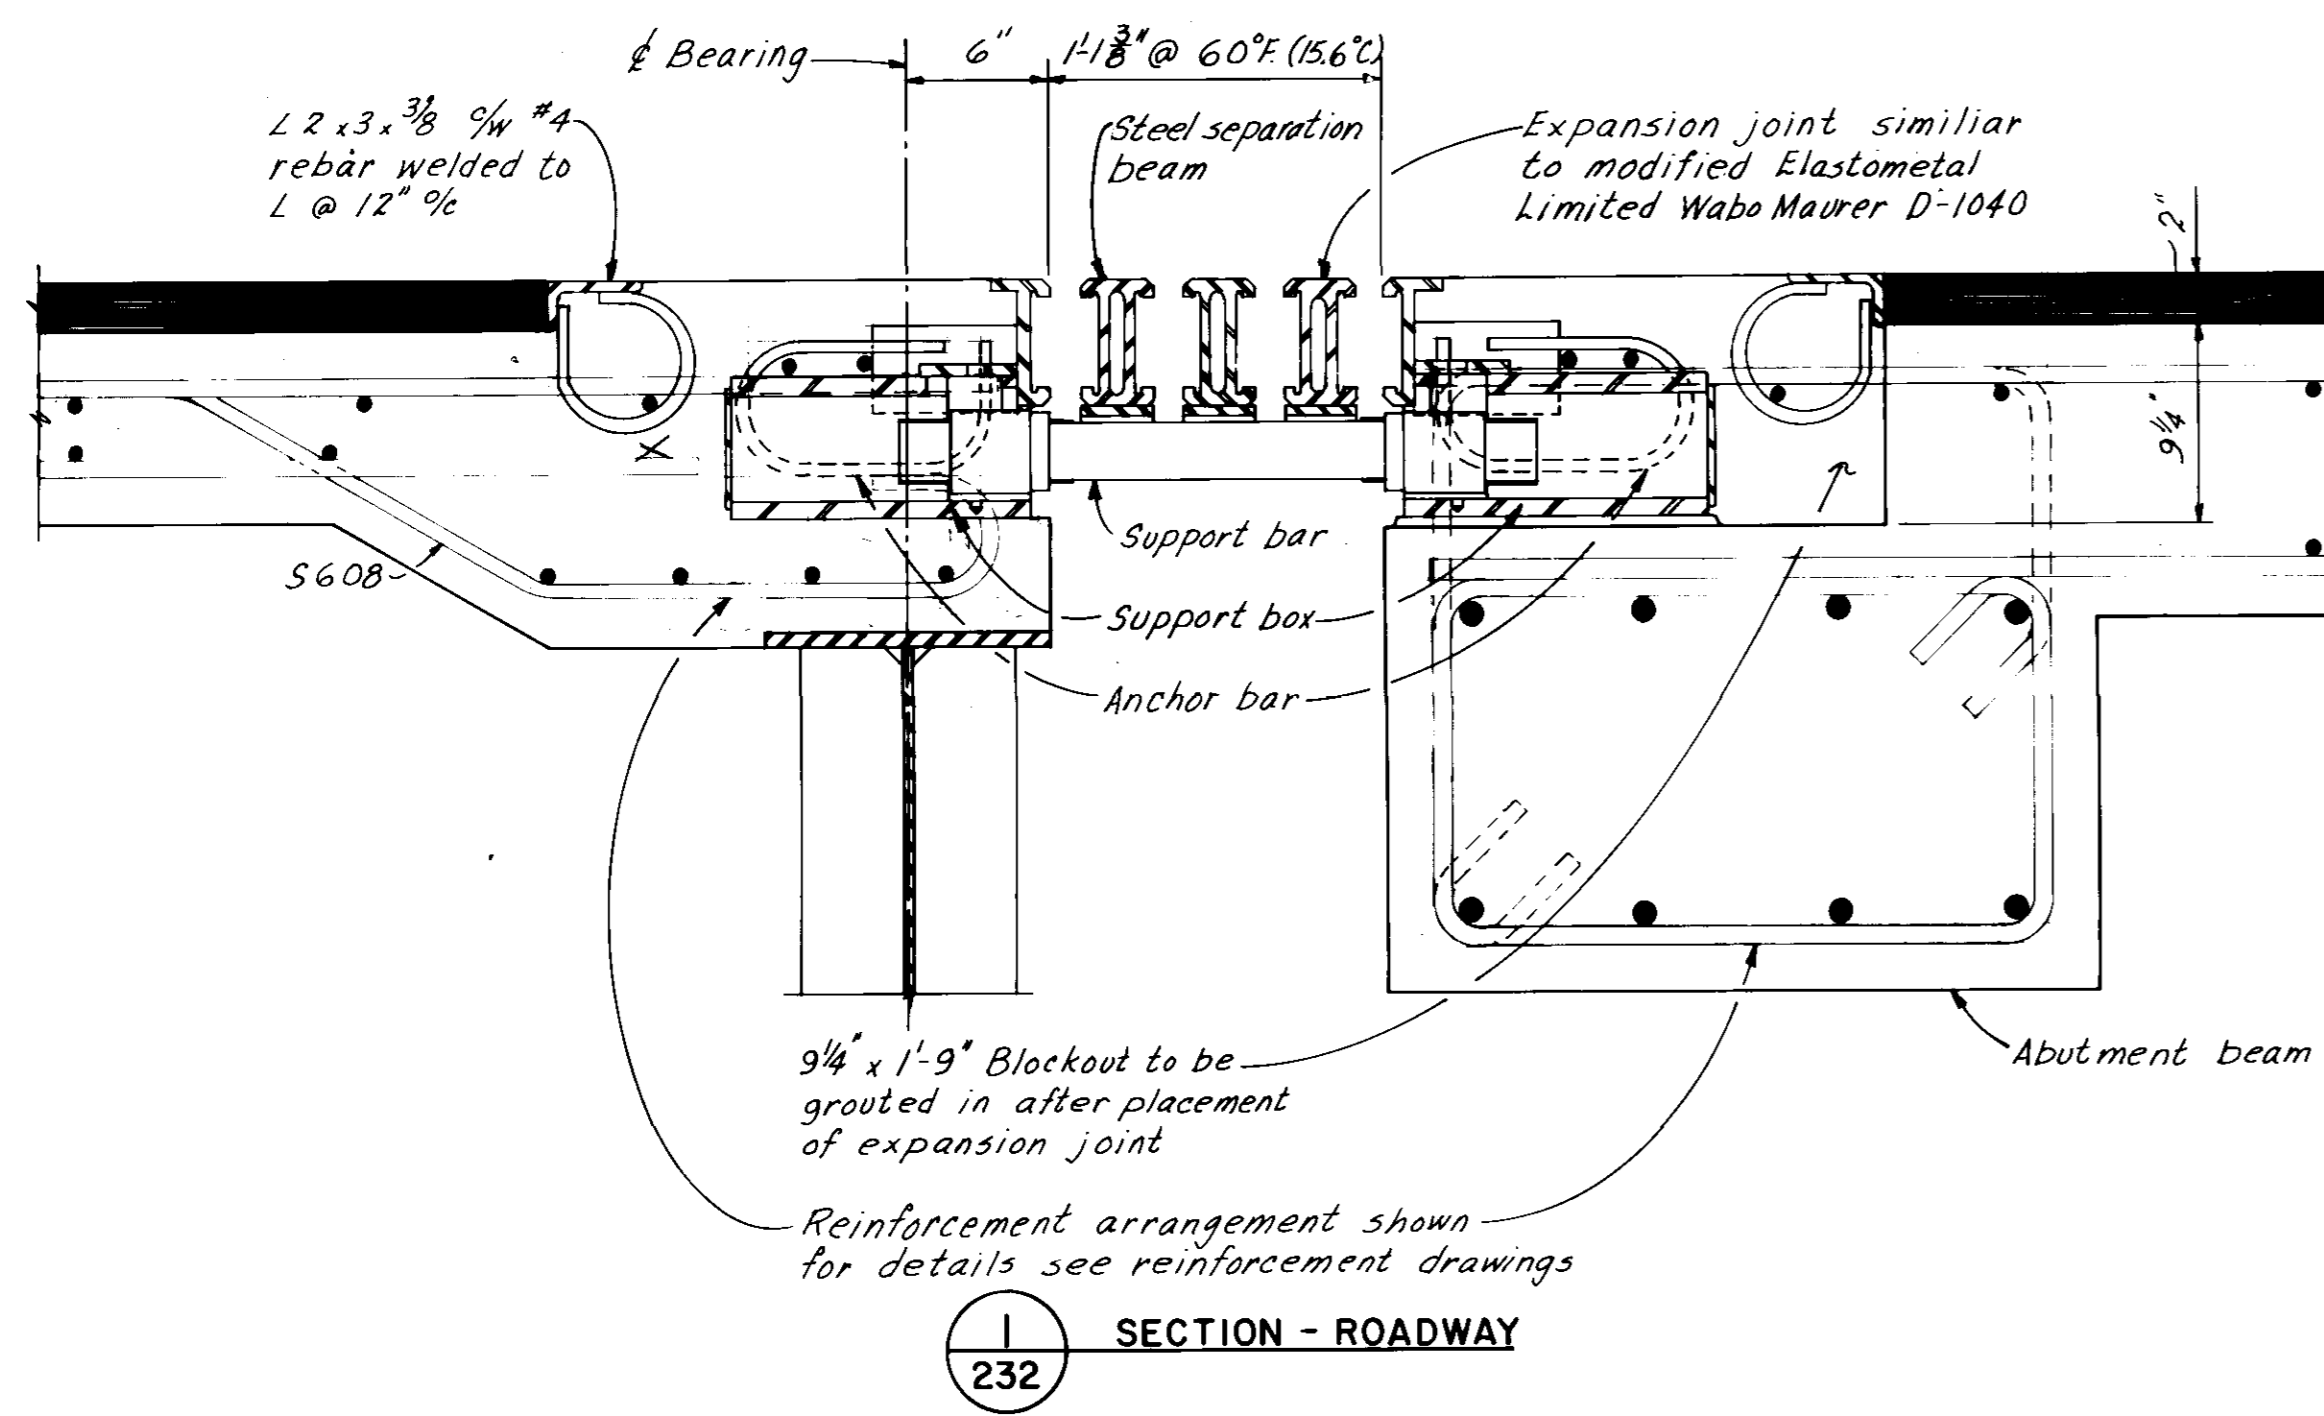

AS - BUILT
DATE: FB NO. PAGE
Nov. 16/70


	THE CITY OF WINNIPEG WORKS & OPERATIONS DEPARTMENT STREETS & TRANSPORTATION DIVISION		ROUTE 165	
	W.L. WARDROP & ASSOCIATES LTD. ENGINEERING CONSULTANTS WINNIPEG - THUNDER BAY - REGINA - BARRIE - EDMONTON		EXPANSION JOINT DETAILS	
	APPROVED BY: <i>[Signature]</i> DATE: 25 MAR 77	DATE: 25 MAR 77	APPROVED BY: <i>[Signature]</i> DATE: 25 MAR 77	DRAWING NO. B-5092-232
DRAWN BY: L.M.G. MAR 77 PRELIM. CHK: <i>[Signature]</i>	DESIGN: S.T.K. MAR 77 CHECK: <i>[Signature]</i>	MANAGER OF STREETS AND TRAFFIC	SCALE: 1 1/2" = 1'-0"	

110 INCHES
19
18
17
16
15
14
13
12
11
10





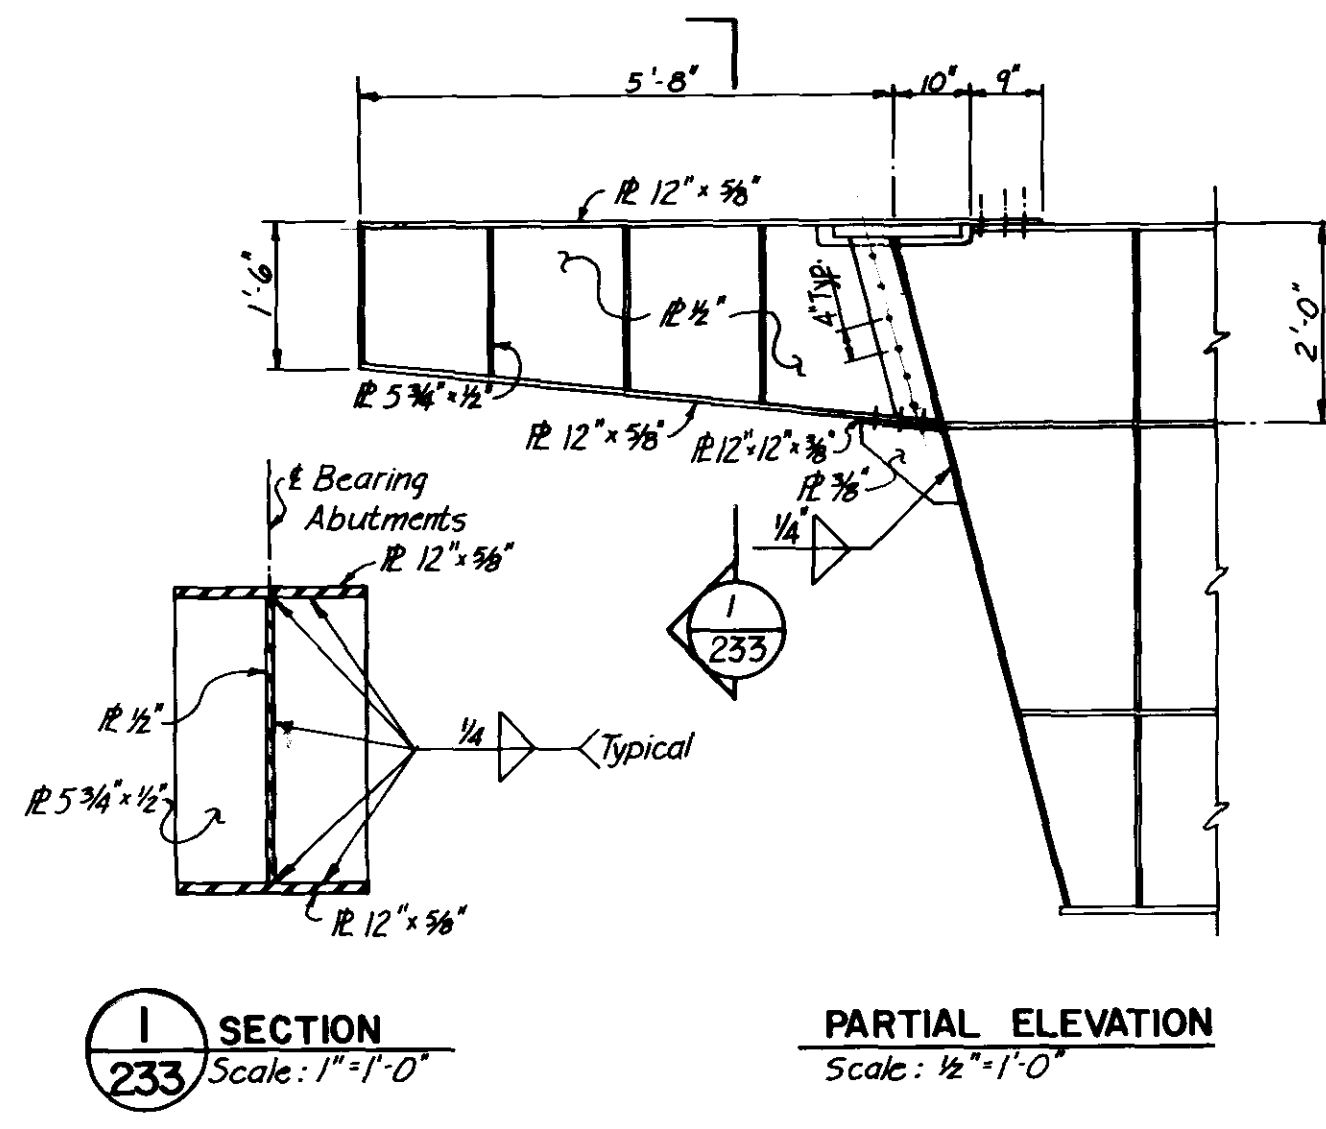


I SECTION
233 Scale: 1"=1'-0"
PARTIAL ELEVATION
Scale: 1/2"=1'-0"





EXPANSION JOINT BEAM CANTILEVER DETAILS

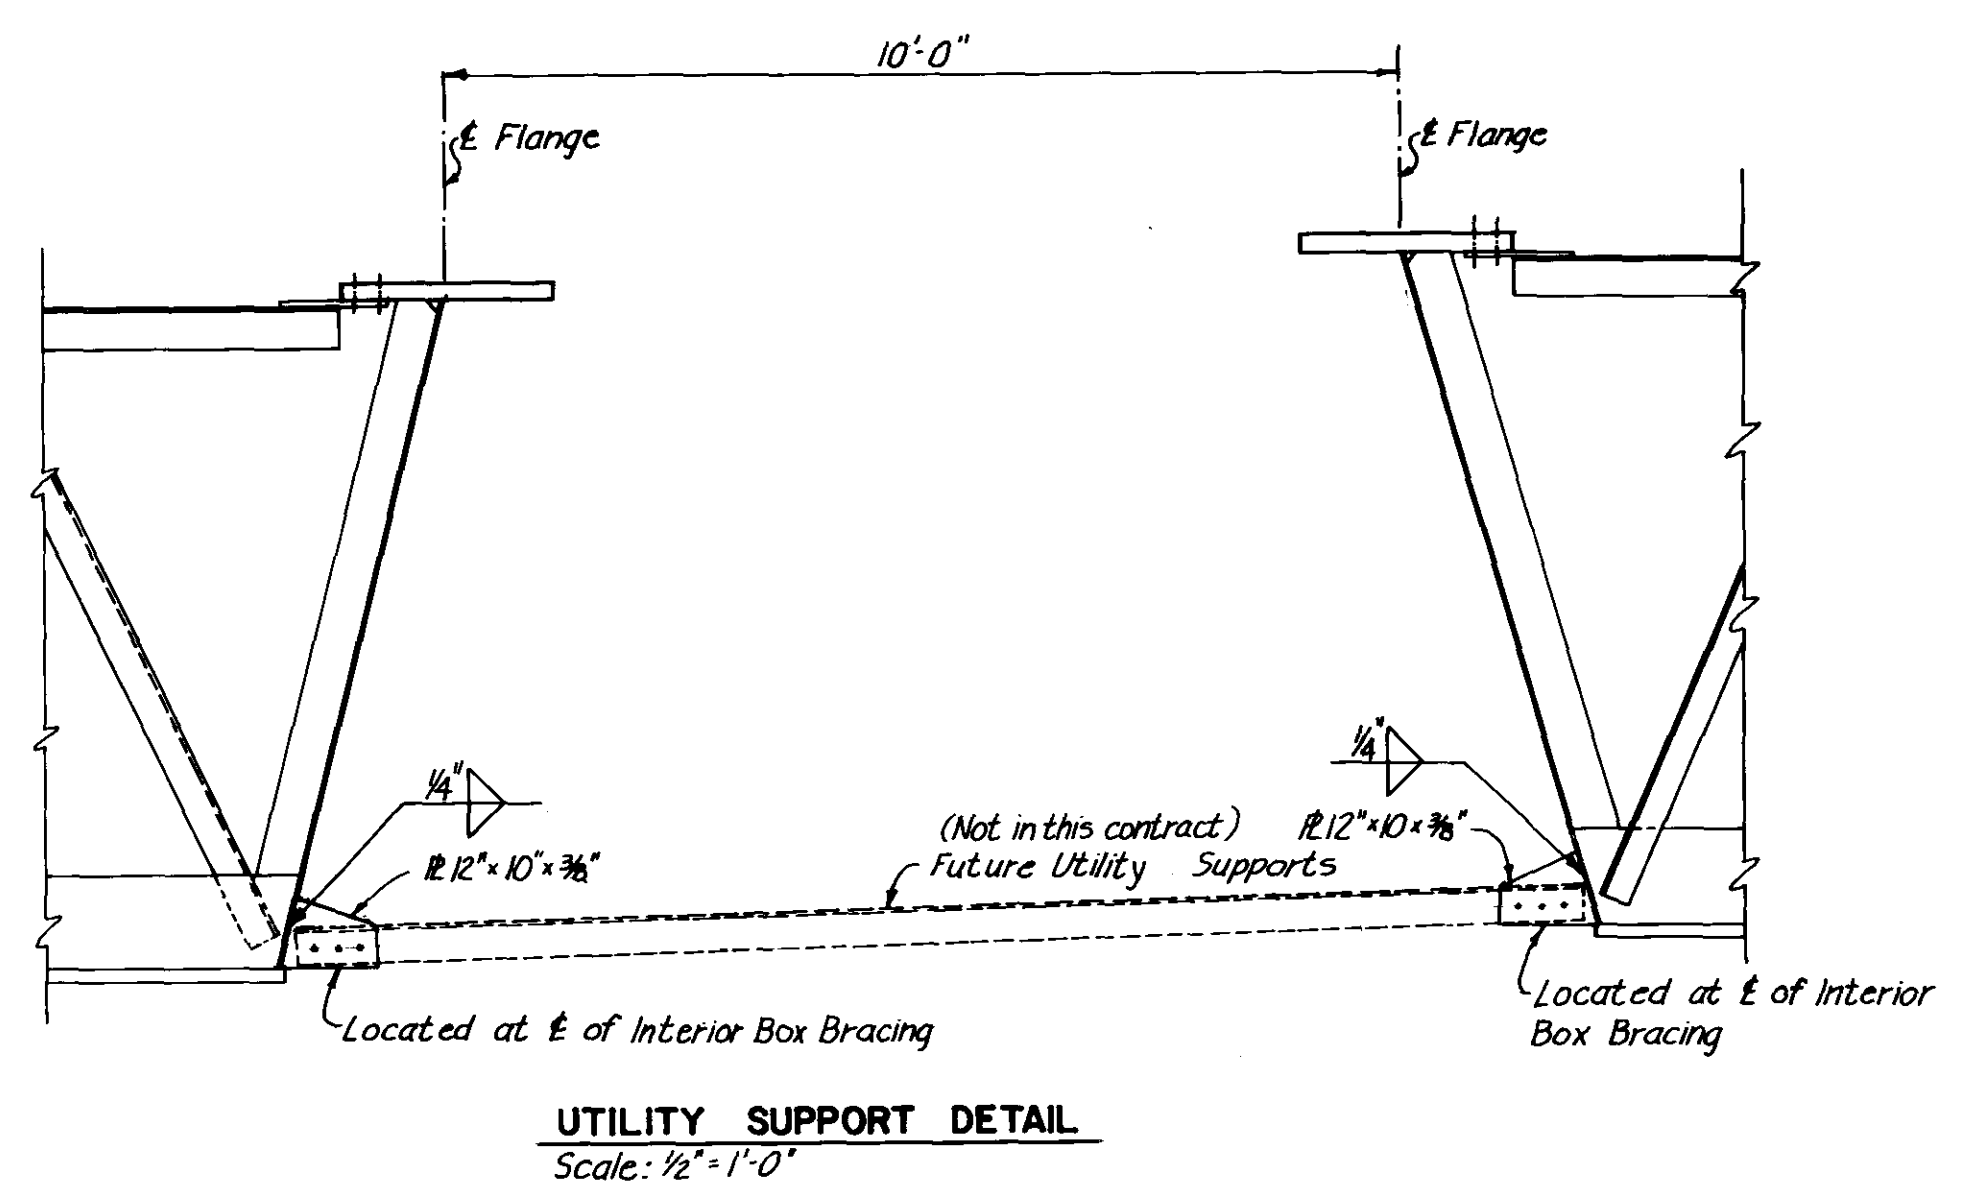

UTILITY SUPPORT DETAIL
Scale: 1/2"=1'-0"

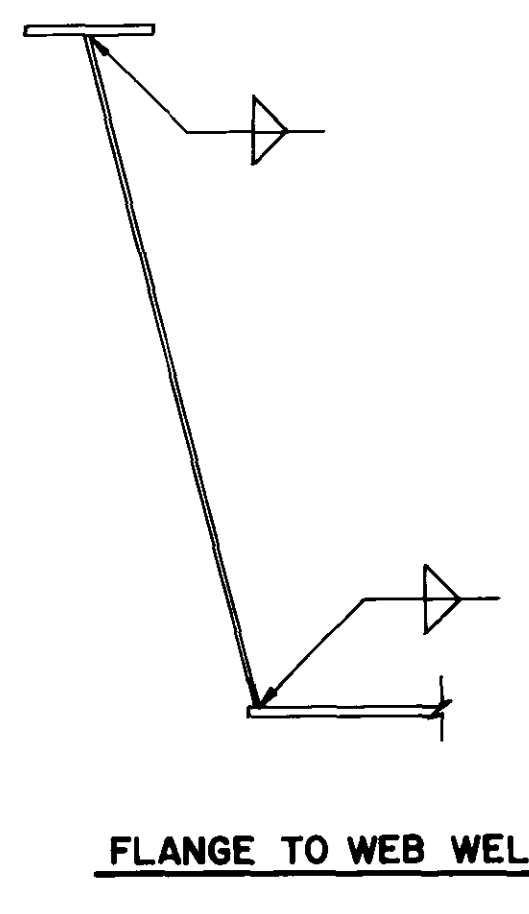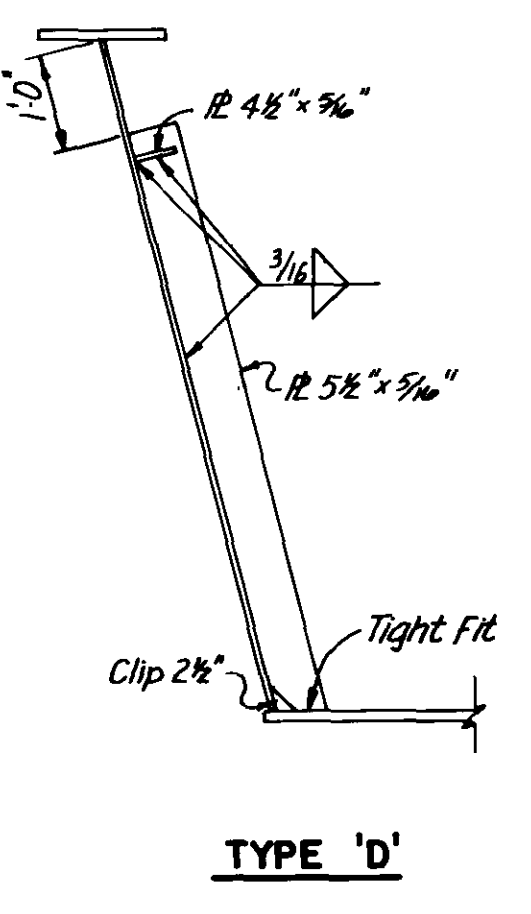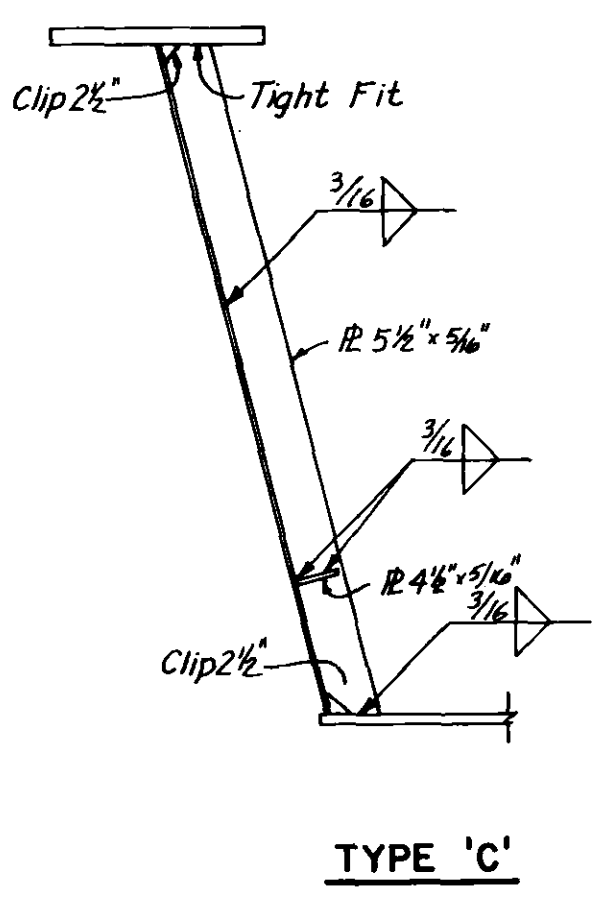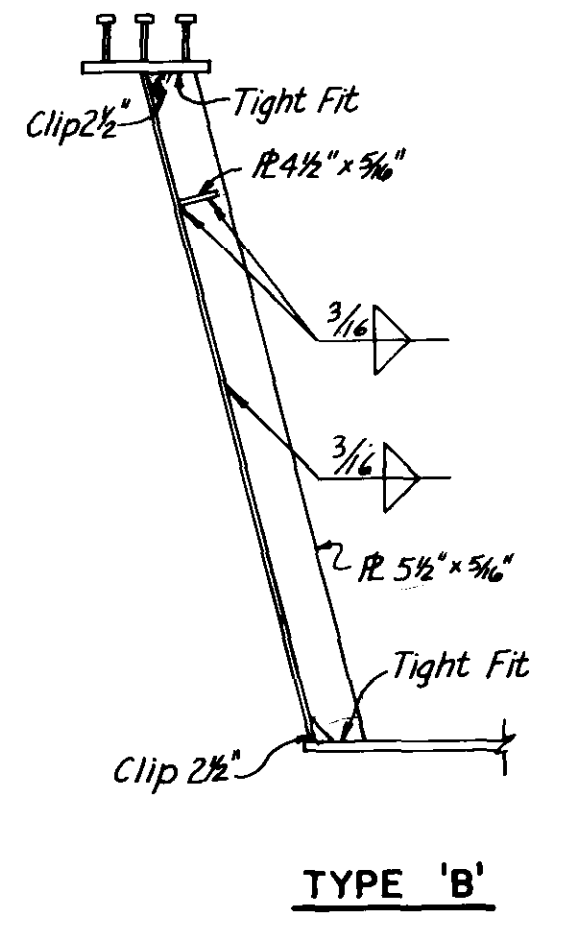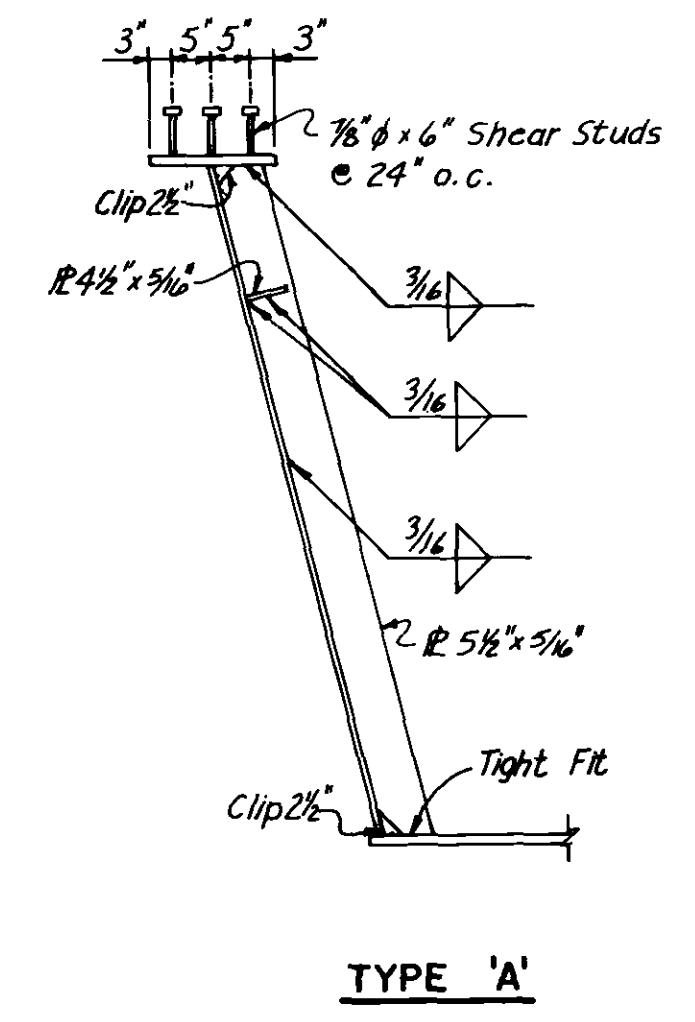




TYPICAL STIFFENER WELDS

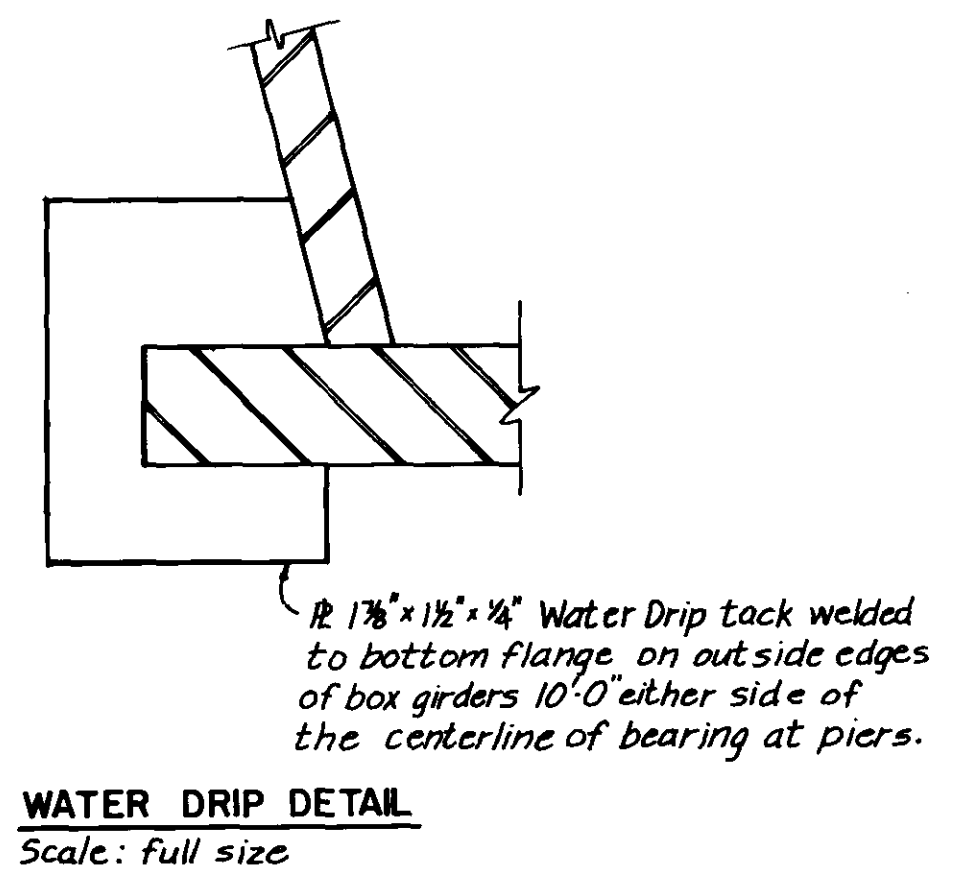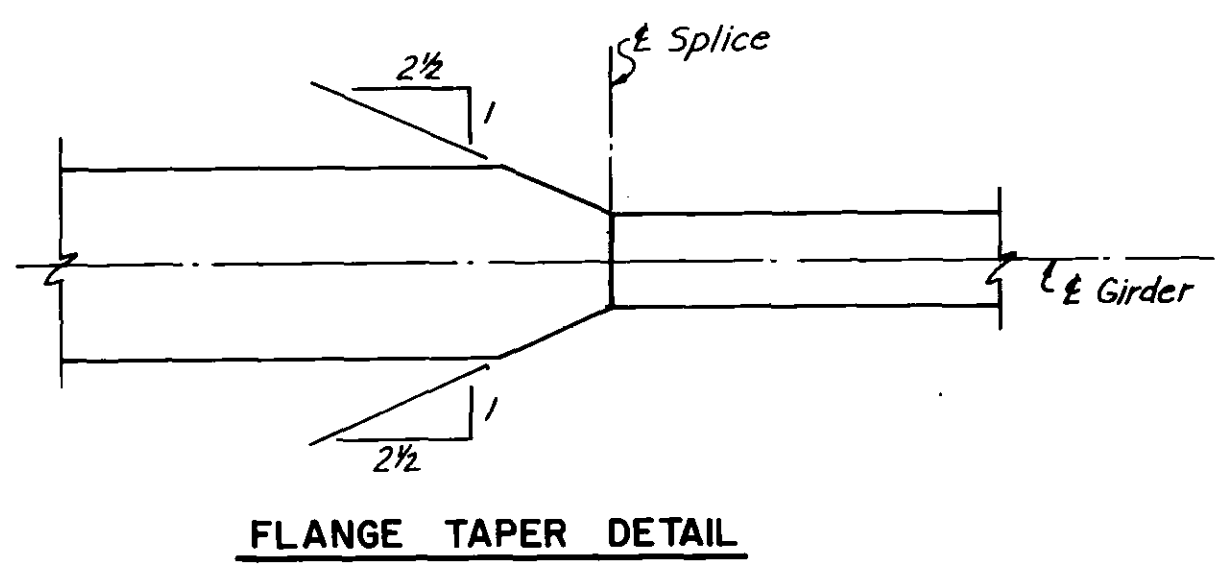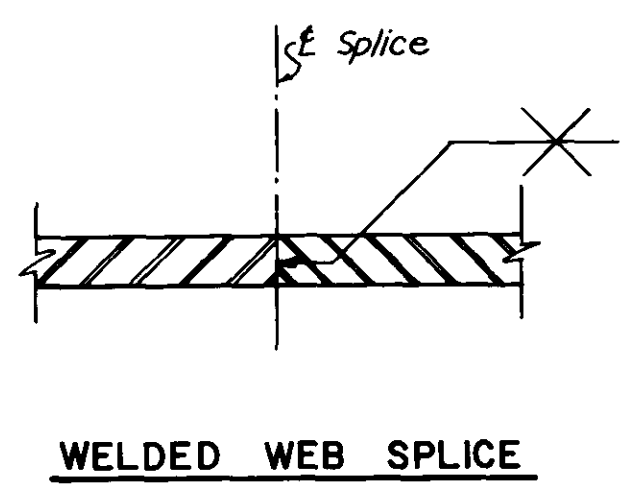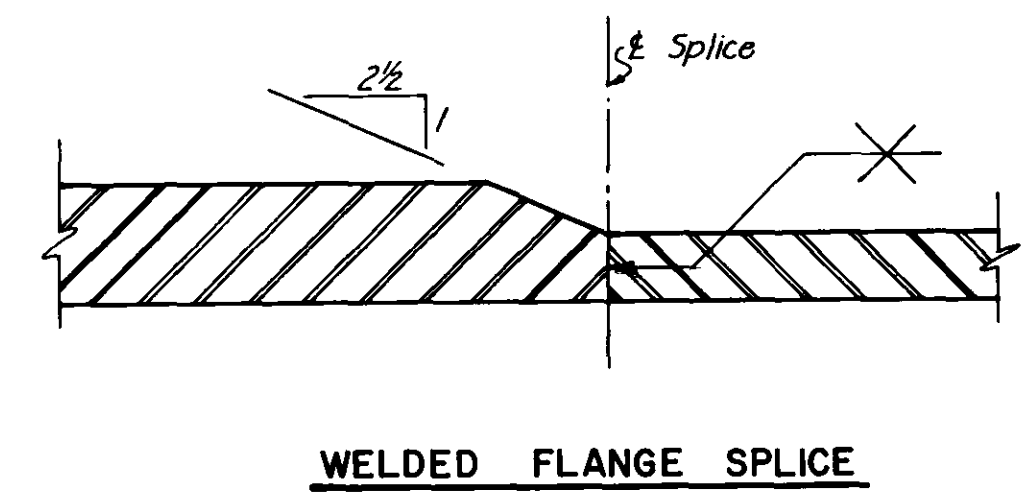

WATER DRIP DETAIL
Scale: full size


AS - BUILT		
DATE	FB. NO.	PAGE
Nov. 14/79		

ISSUED FOR TENDER REVISION: _____ DATE: 4.4.77 BY: _____		THE CITY OF WINNIPEG WORKS & OPERATIONS DEPARTMENT STREETS & TRANSPORTATION DIVISION	ROUTE 165	SCALE: AS SHOWN
		W.L. WARDROP & ASSOCIATES LTD. ENGINEERING CONSULTANTS WINNIPEG - THUNDER BAY - REGINA - BARRIE - EDMONTON	MISCELLANEOUS STEEL DETAILS	DRAWING NO. B-5092-233
APPROVED BY: _____ DATE: 25 Nov 77 DRAWN BY: J.T.K. JAN 77 PRELIM. CHK: S.T.K. JAN 77	DATE: 25 Nov 77 DESIGN: S.T.K. JAN 77 CHECK: D.L.M. JAN 77	APPROVED BY: <i>Snell R. Campbell</i> MANAGER OF STREETS AND TRAFFIC DATE: 25/11/77	DATE: 25/11/77	W.L.W. NO. 74012-21

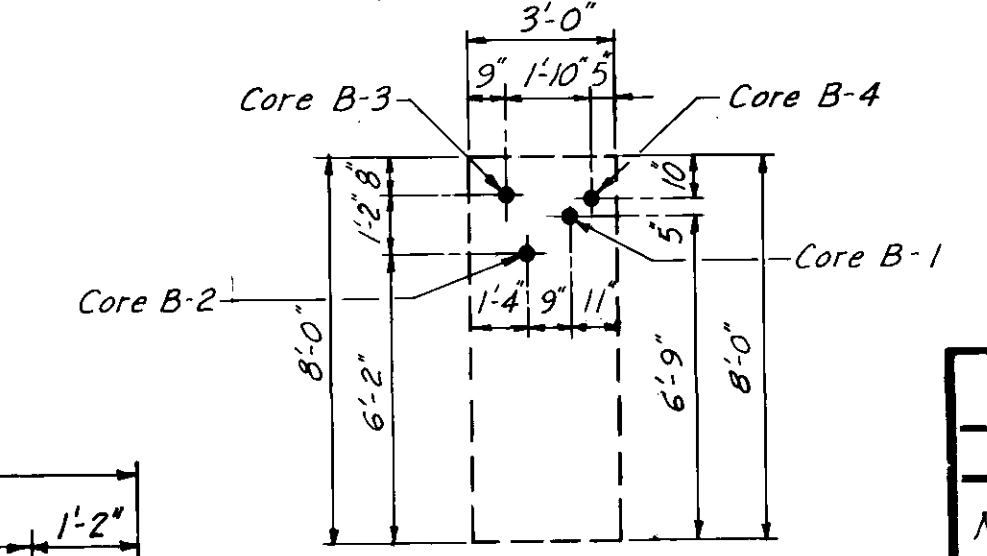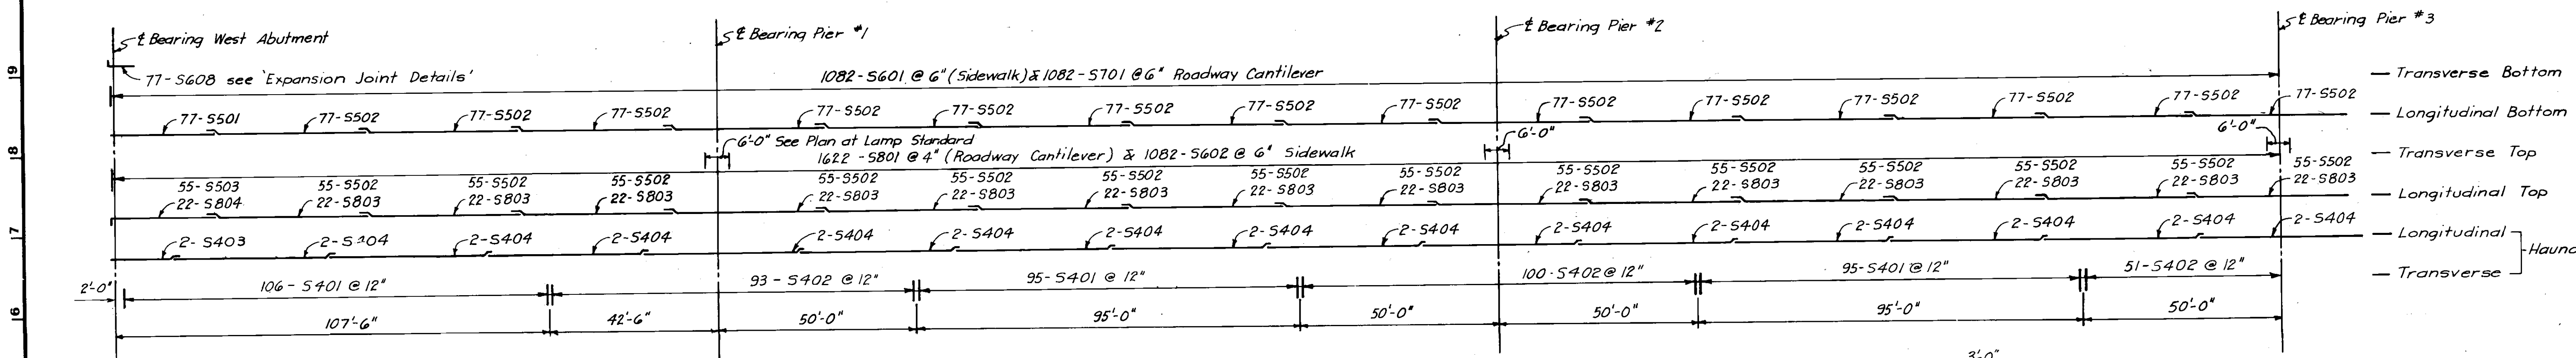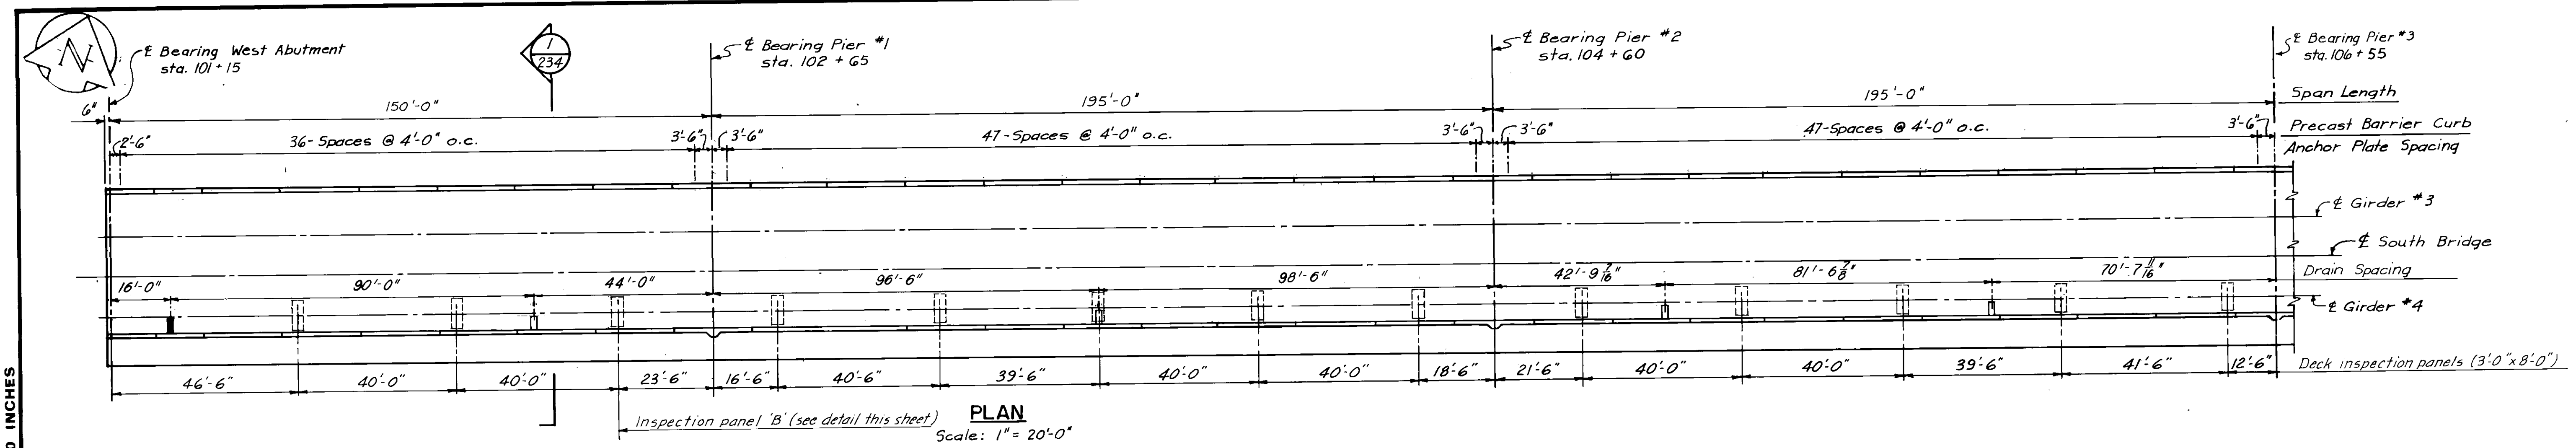

AS - BUILT		
DATE	FB. NO.	PAGE
Nov. 11/77		

- Notes:
- Concrete shall have compressive strength of 4500 psi at 28 days.
 - Reinforcing shall be grade 40 for No. 4 bars and grade 60 for No. 5 bars and larger.
 - Splicing of bars shall conform to ACI 318-71 with a minimum development length of 30 bar diameters.
 - For pouring sequence see 'Slab Plan North Bridge'.

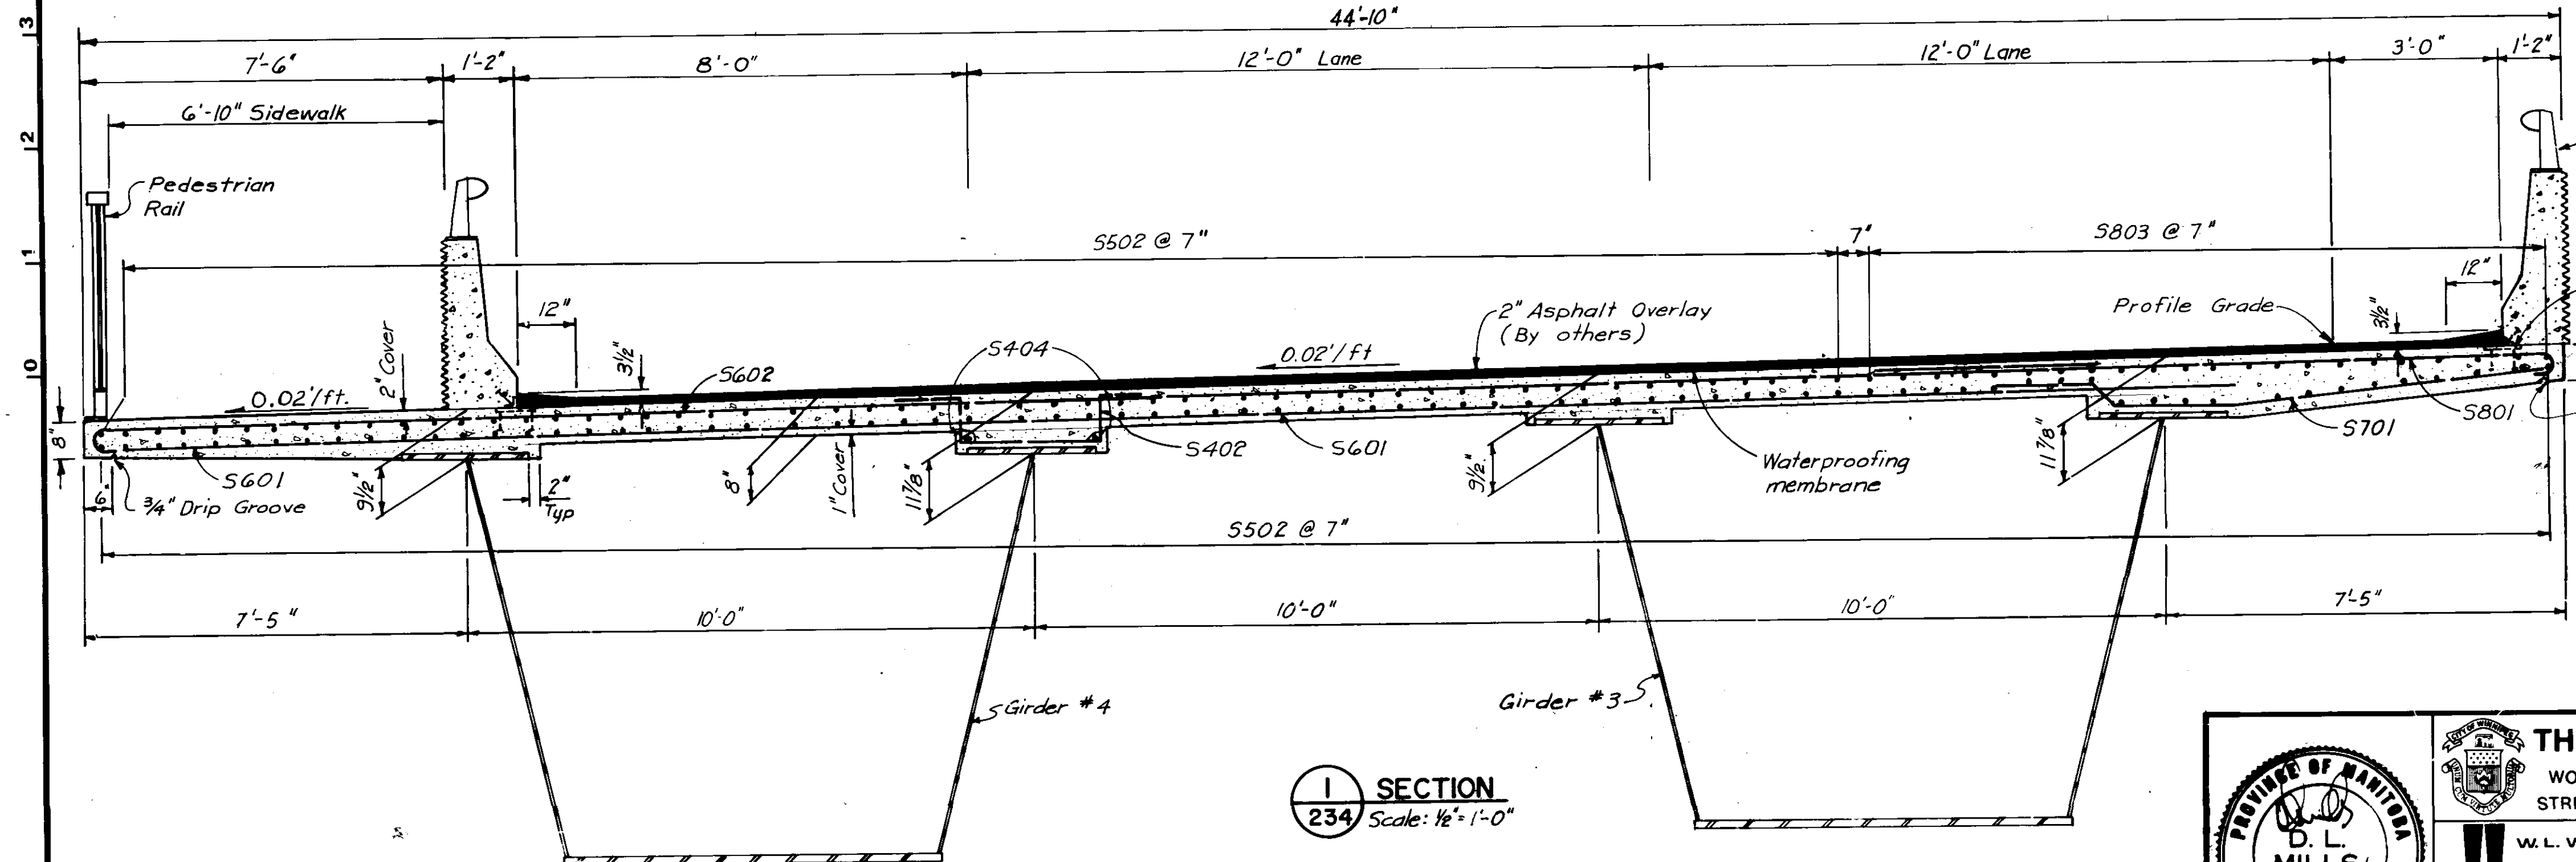

ISSUED FOR TENDER			
NO.	REVISIONS	DATE	BY
0		4.4.77	

D.L. MILLS
REGISTERED ENGINEER

THE CITY OF WINNIPEG
WORKS & OPERATIONS DEPARTMENT
STREETS & TRANSPORTATION DIVISION

W.L. WARDROP & ASSOCIATES LTD.
ENGINEERING CONSULTANTS
WINNIPEG - THUNDER BAY - REGINA - BARRIE - EDMONTON

ROUTE 165



SLAB PLAN SOUTH BRIDGE

APPROVED BY: <i>[Signature]</i>	DATE: 25 Jan 77
DRAWN BY: S.T.K.	DESIGN: S.T.K.
PRELIM. CHK.: S.T.K.	CHECK: D.L.M.





APPROVED BY: <i>[Signature]</i>	DATE: 25/1/77
MANAGER OF STREETS AND TRAFFIC	

Note: For haunches see attached sheets.

10 INCHES
19
18
17
16
15
14
13
12
11
10

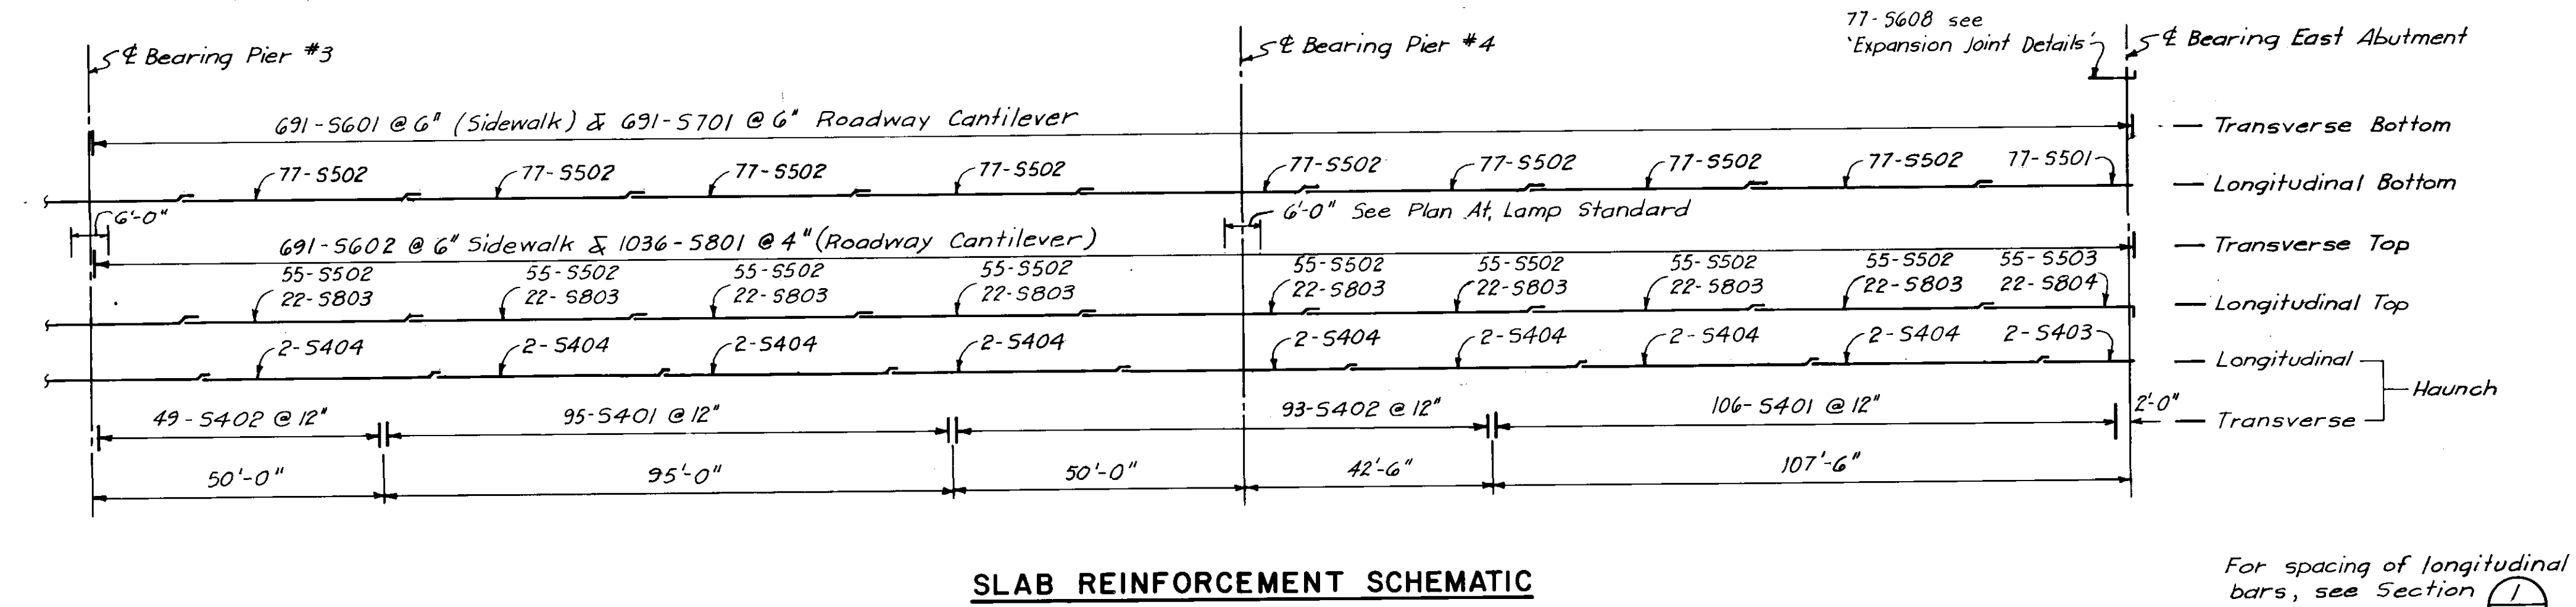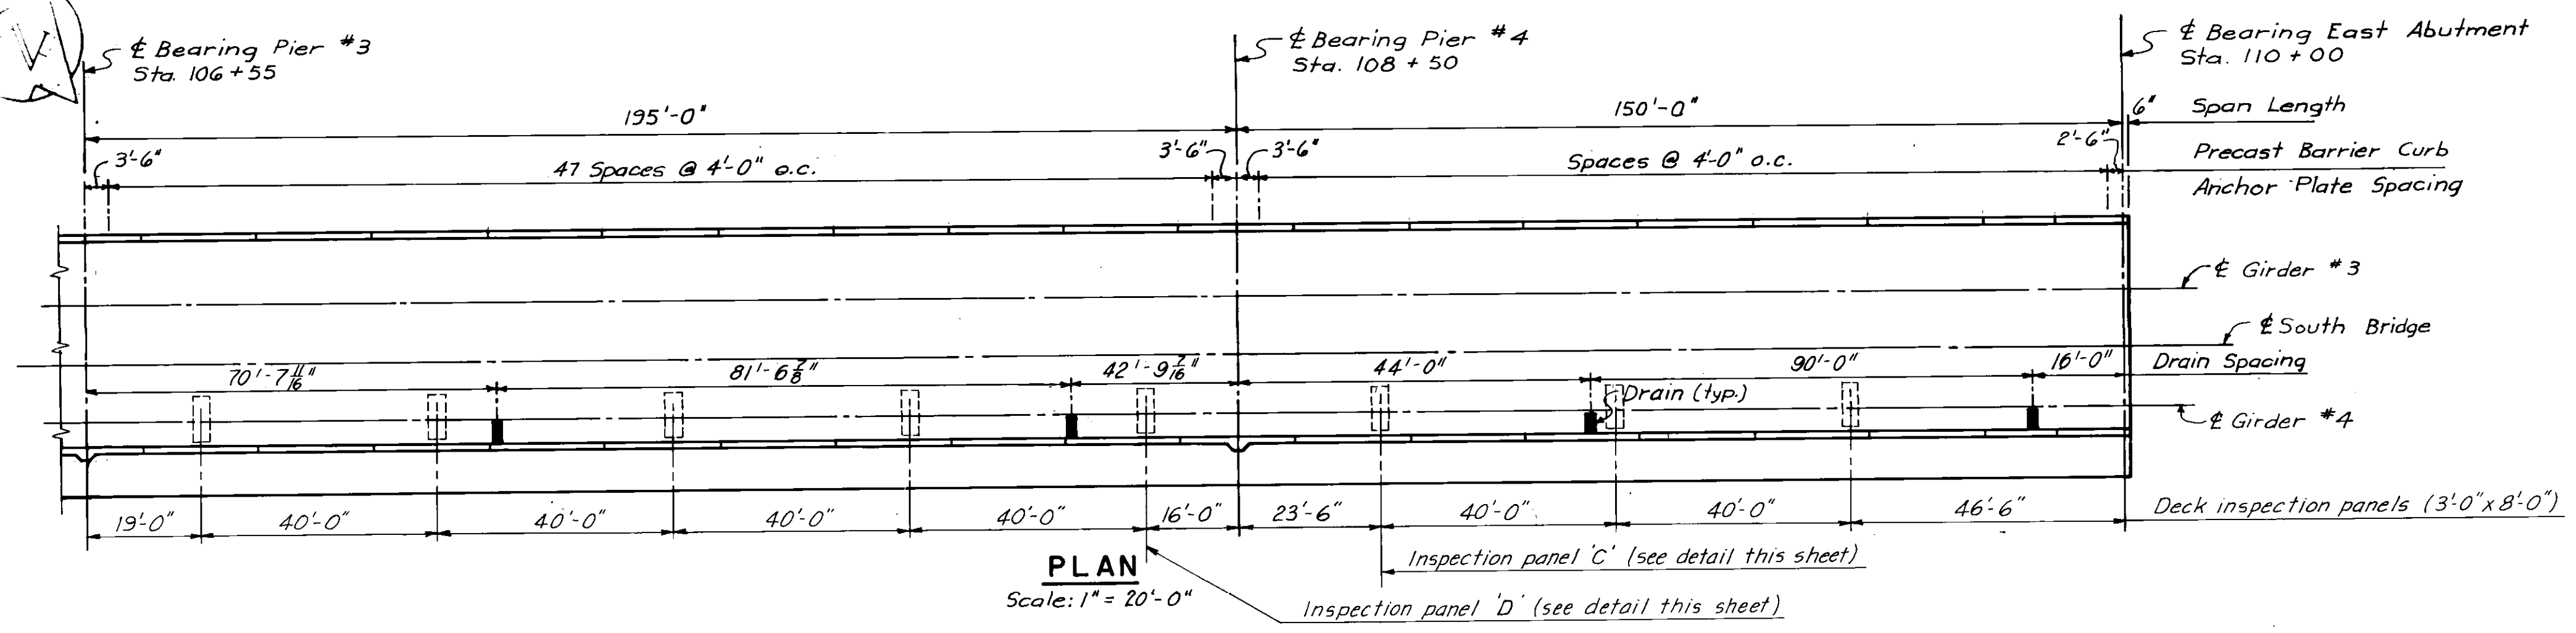

MARK	NUMBER	LENGTH	WEIGHT (POUNDS)	TYPE	DIMENSIONS				
					A	B	C	D	E
* 5401	497	4-6	1494	102	1-6	0-9	0-8 1/2		
* 5402	386	5-6	1418	102	2-5	0-9	0-8 1/2		
* 5403	4	15-0	40	str					
* 5404	44	40-0	1176	str					
5501	154	27-0	4337	str					
5502	2904	40-0	121155	str					
5503	110	27-7	3165	101	27-7				
5601	1773	39-2	104303	str					
5602	1773	41-2	109630	101	40-6				
5607	40	3-0	180	str					
5608	154	5-4	1233	118	2-0	1-1	1-7		
5701	1773	10-3	37146	119	1-9	0-4	2-2	6-0	0-9
5801	2658	12-11	91668	101	12-0				
5802	56	41-5	6194	101	40-6				
5803	484	40-0	51691	str					
5804	44	51-11	6100	101	51-0				
TOTAL WEIGHT FOR SLAB					GRADE 40 = 4128 LBS				
					GRADE 60 = 536802 LBS				

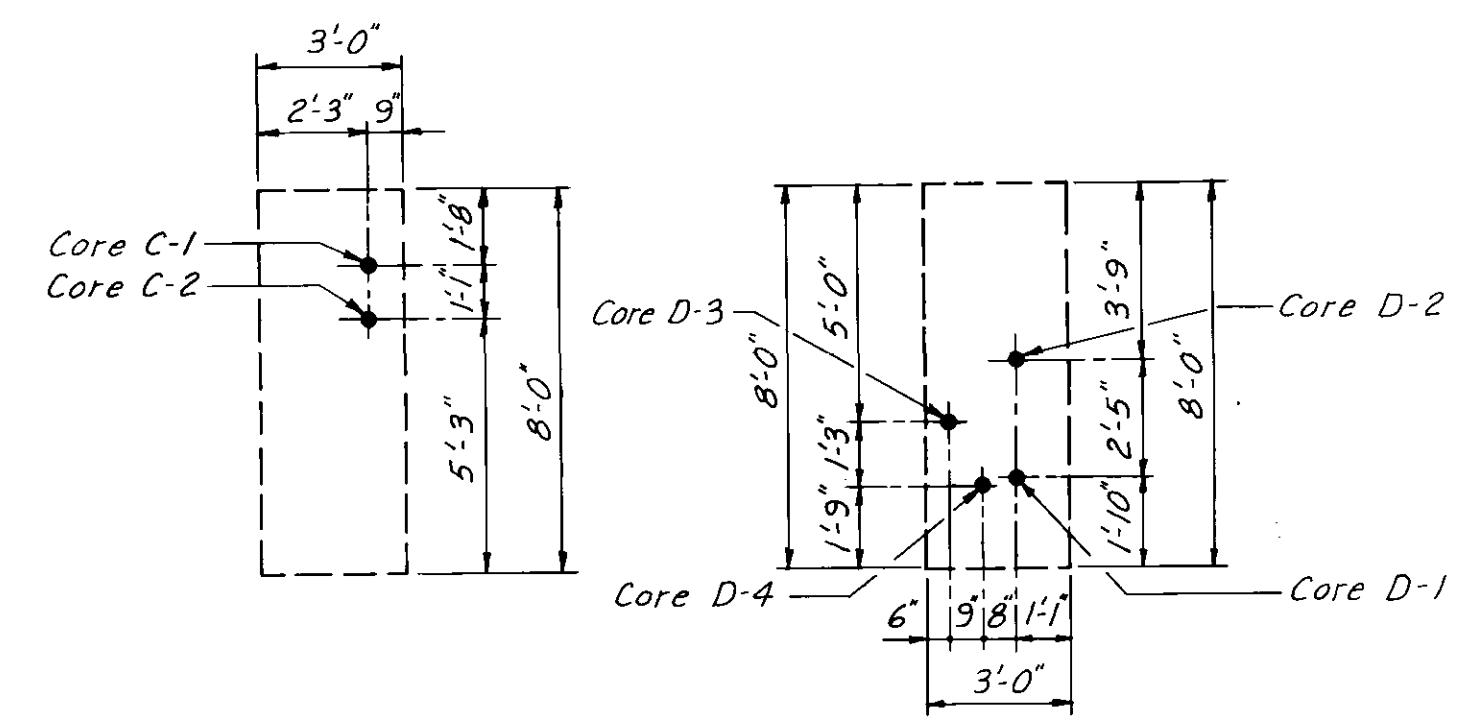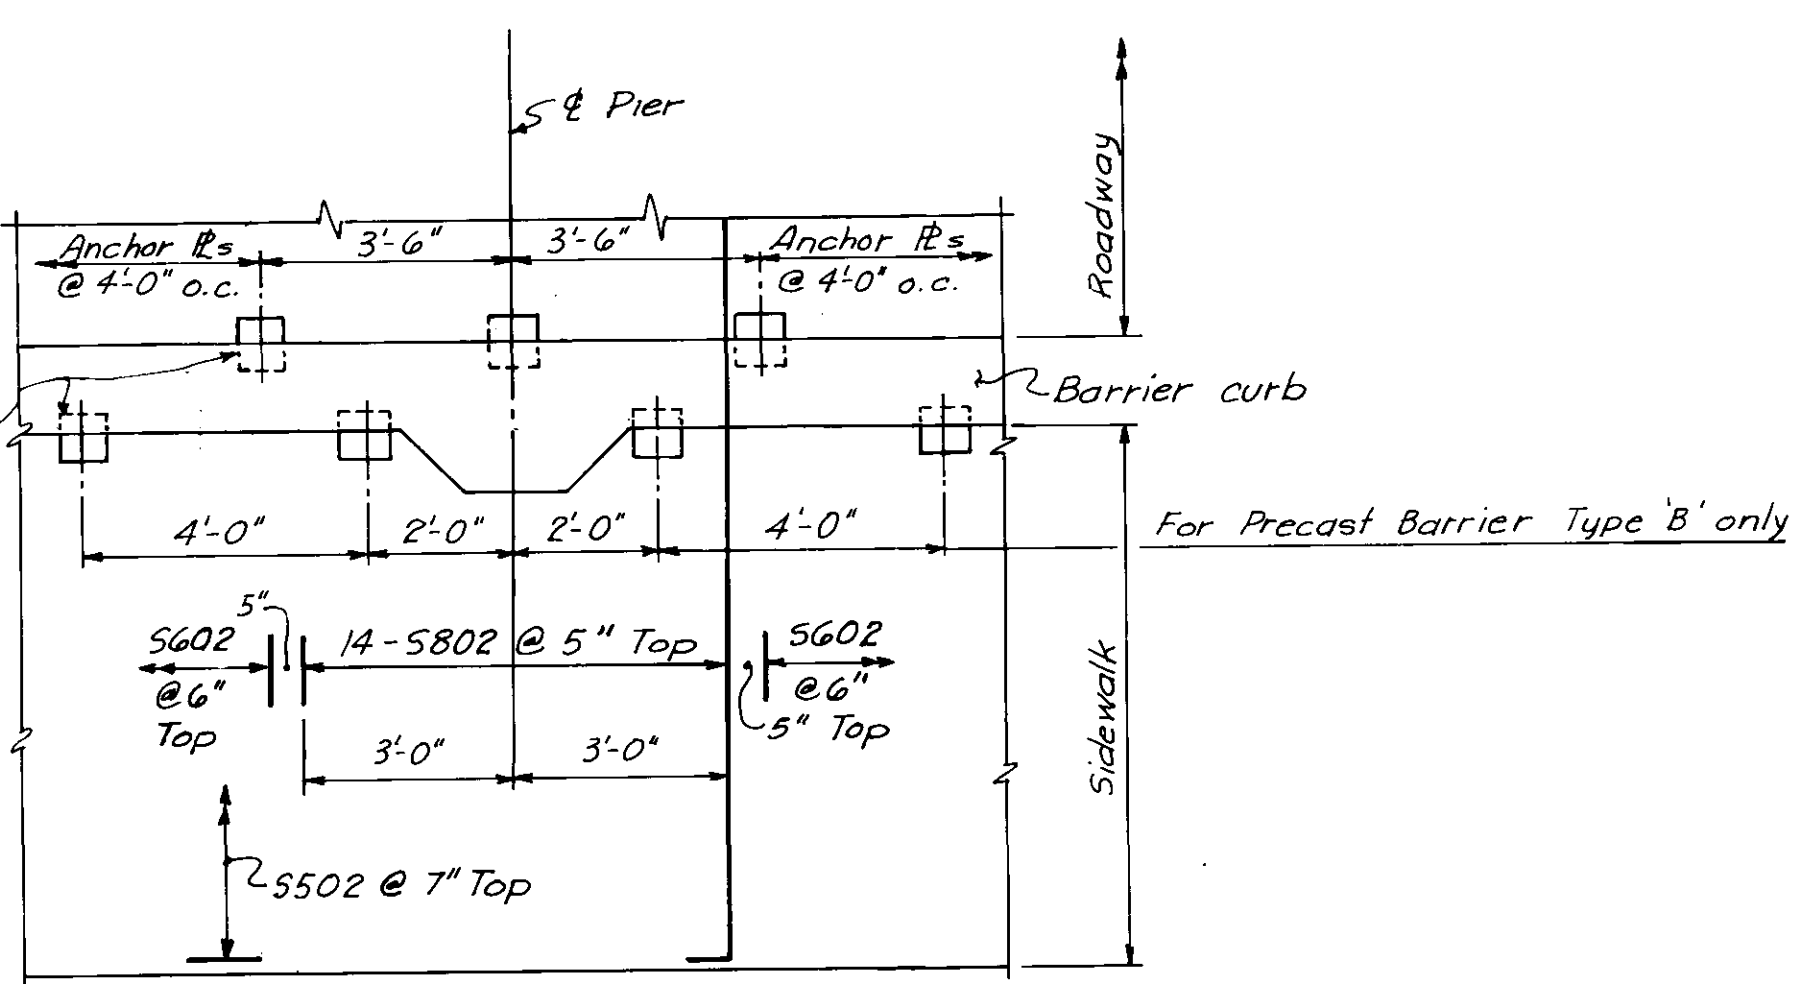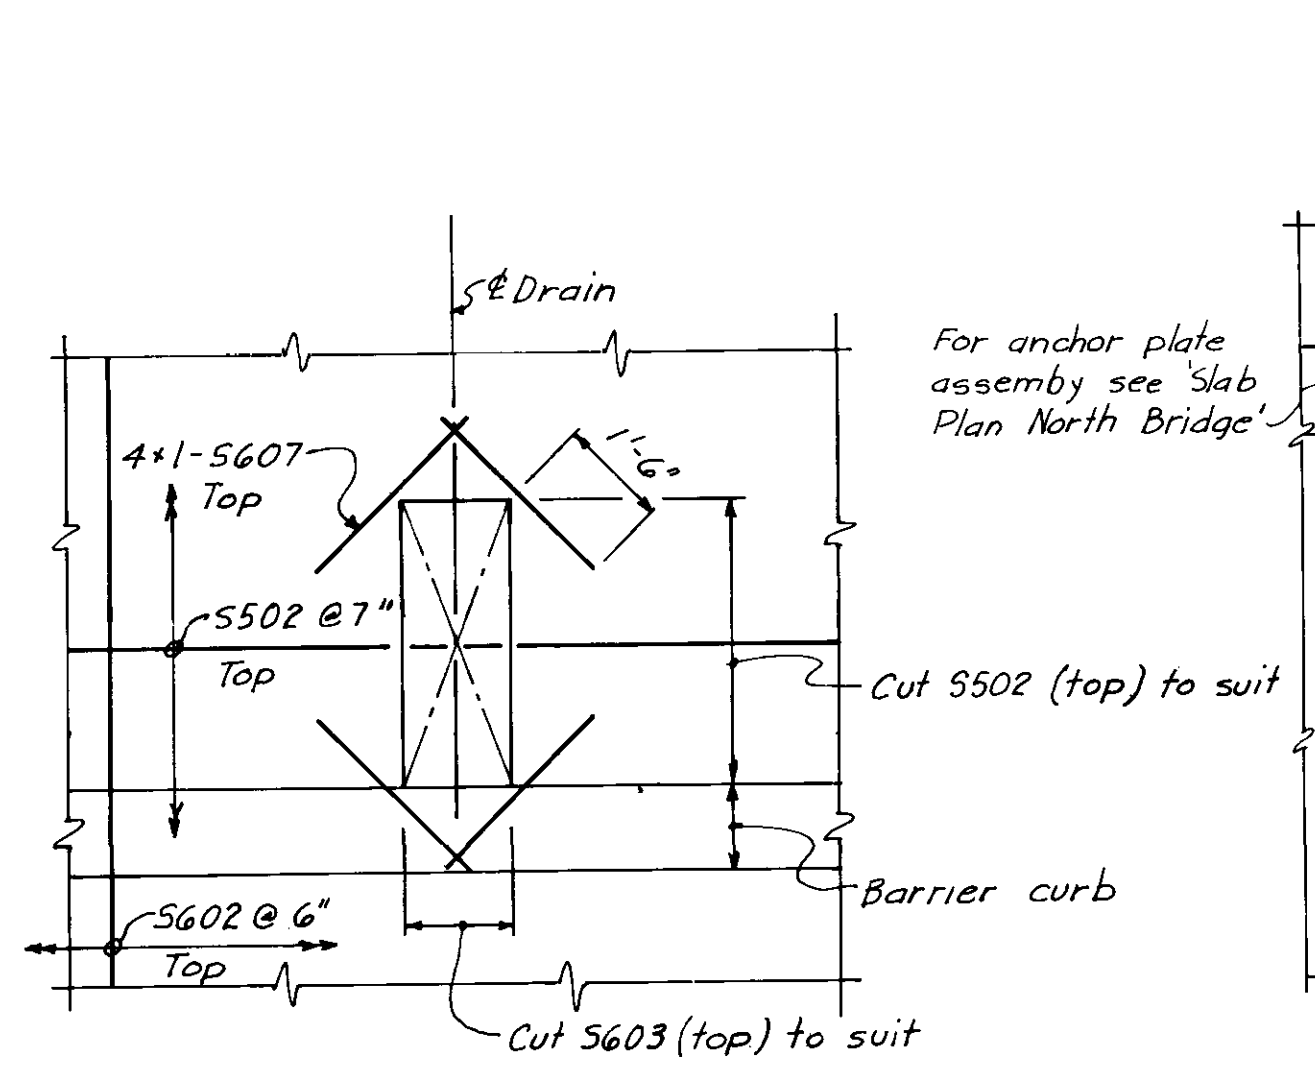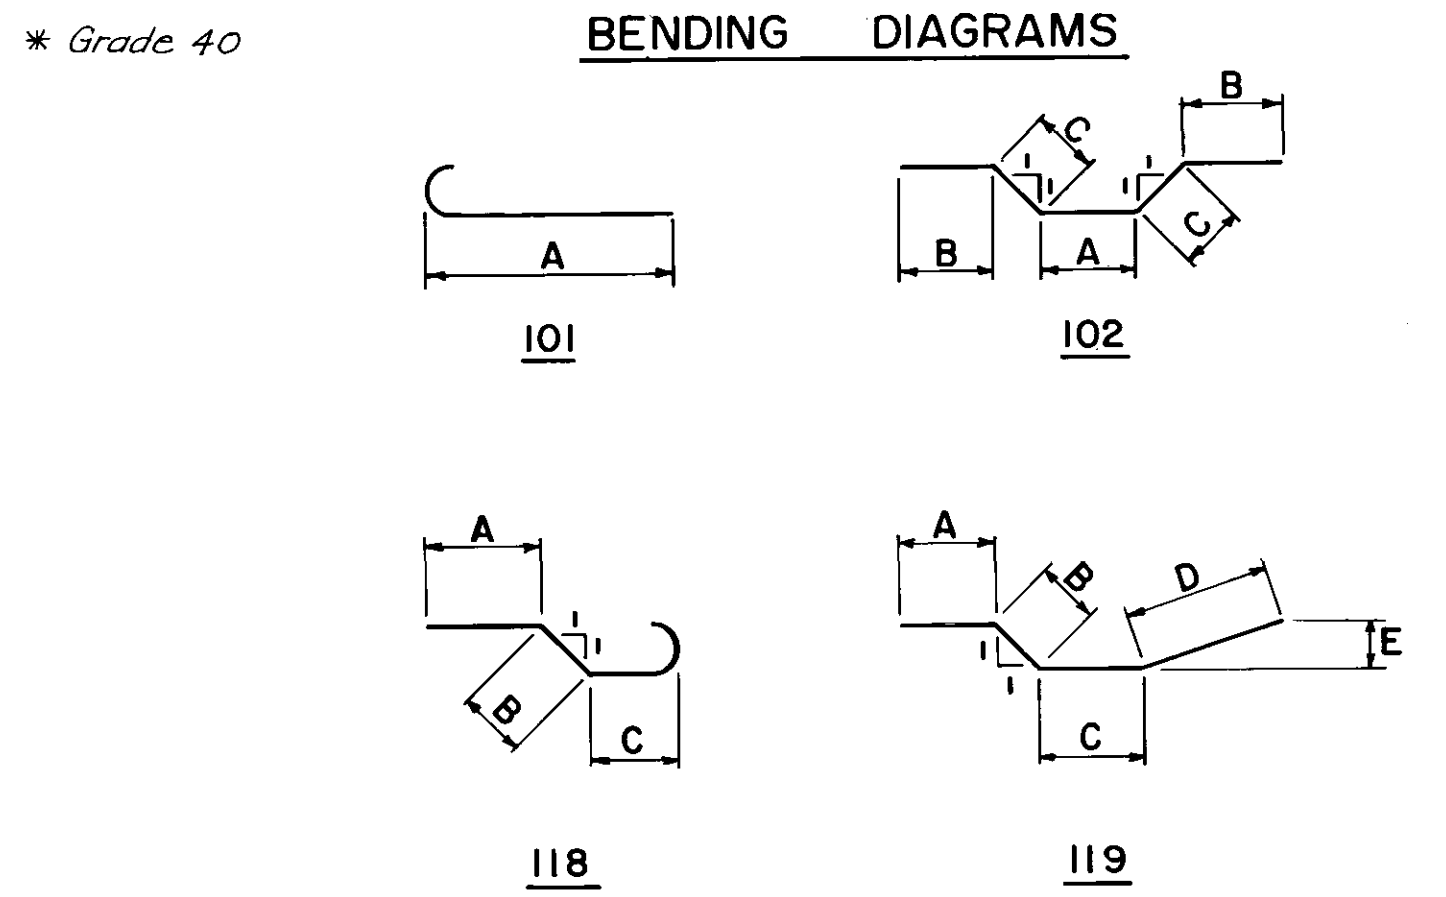

AS - BUILT		
DATE	FB. NO.	PAGE
Nov. 14/75		

NO.	ISSUED FOR TENDER	DATE	BY
0	ISSUED FOR TENDER	4.4.77	
	REVISIONS	DATE	BY

W.L. WARDROP & ASSOCIATES LTD.
ENGINEERING CONSULTANTS
WINNIPEG - THUNDER BAY - REGINA - BARRIE - EDMONTON

APPROVED BY: *[Signature]* DATE: 25.12.77

DRAWN BY: S.T.K. DATE: JAN.77
PHELM. CHK.: S.T.K. DATE: JAN.77

THE CITY OF WINNIPEG
WORKS & OPERATIONS DEPARTMENT
STREETS & TRANSPORTATION DIVISION

ROUTE 165

SLAB PLAN SOUTH BRIDGE

APPROVED BY: *[Signature]* DATE: 25.12.77
MANAGER OF STREETS AND TRAFFIC

SCALE: AS SHOWN

DRAWING NO. **B-5092-235**

10 INCHES

19

18

17

16



14


13

12


11

10

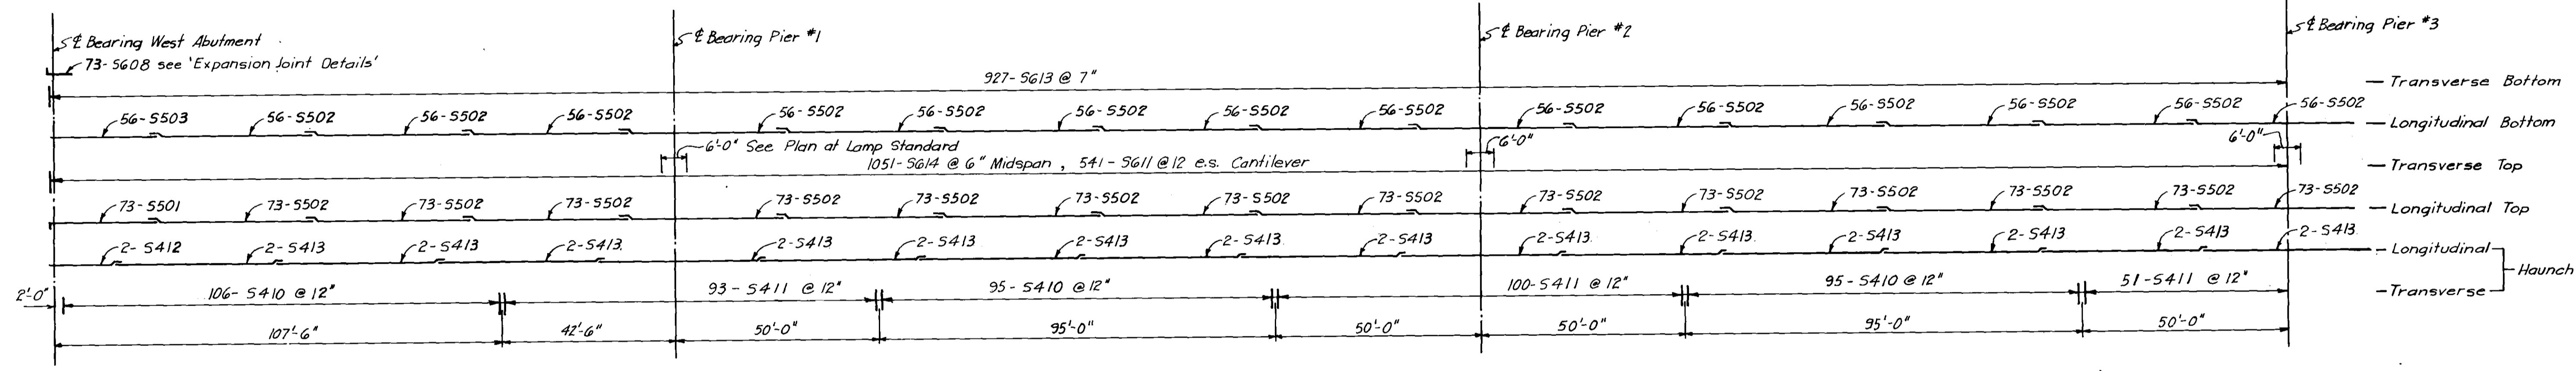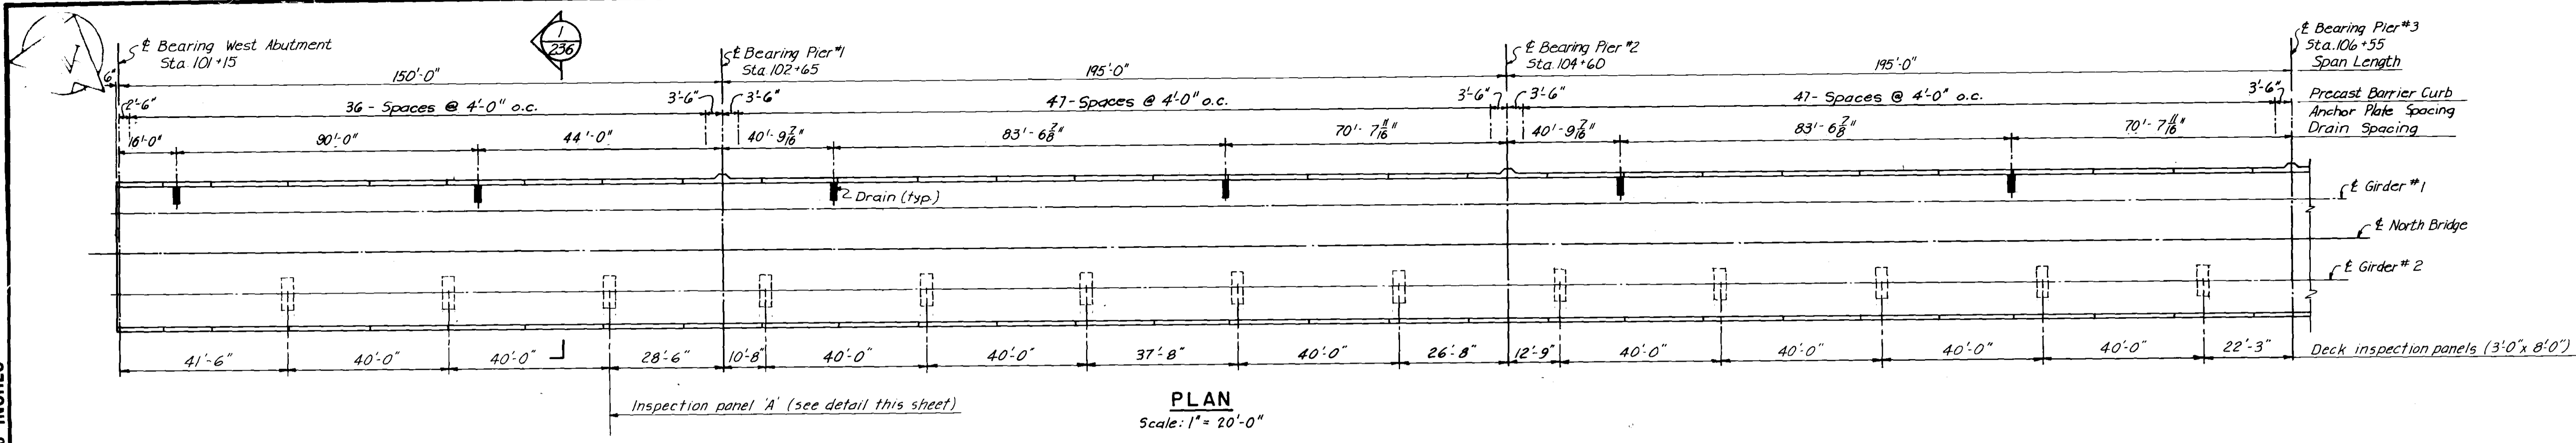


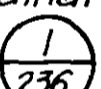For spacing of longitudinal bars, see Section 

AS - BUILT		
DATE	FB NO	PAGE
Nov. 14/77		

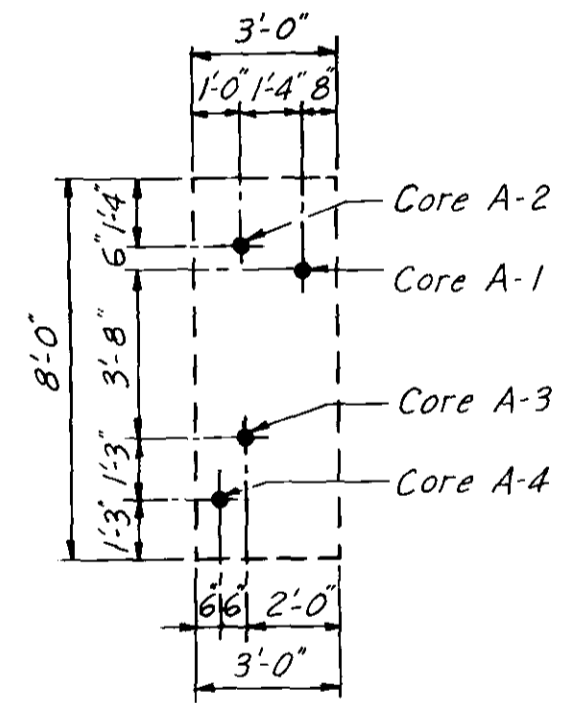



- Notes:
1. Concrete shall have a compressive strength of 4500 psi at 28 days.
 2. Reinforcing shall be grade 40 for No. 4 bars and grade 60 for No. 5 bars and larger.
 3. Splicing of bars shall conform to ACI 318-71 with a minimum development length of 30 bar diameters.

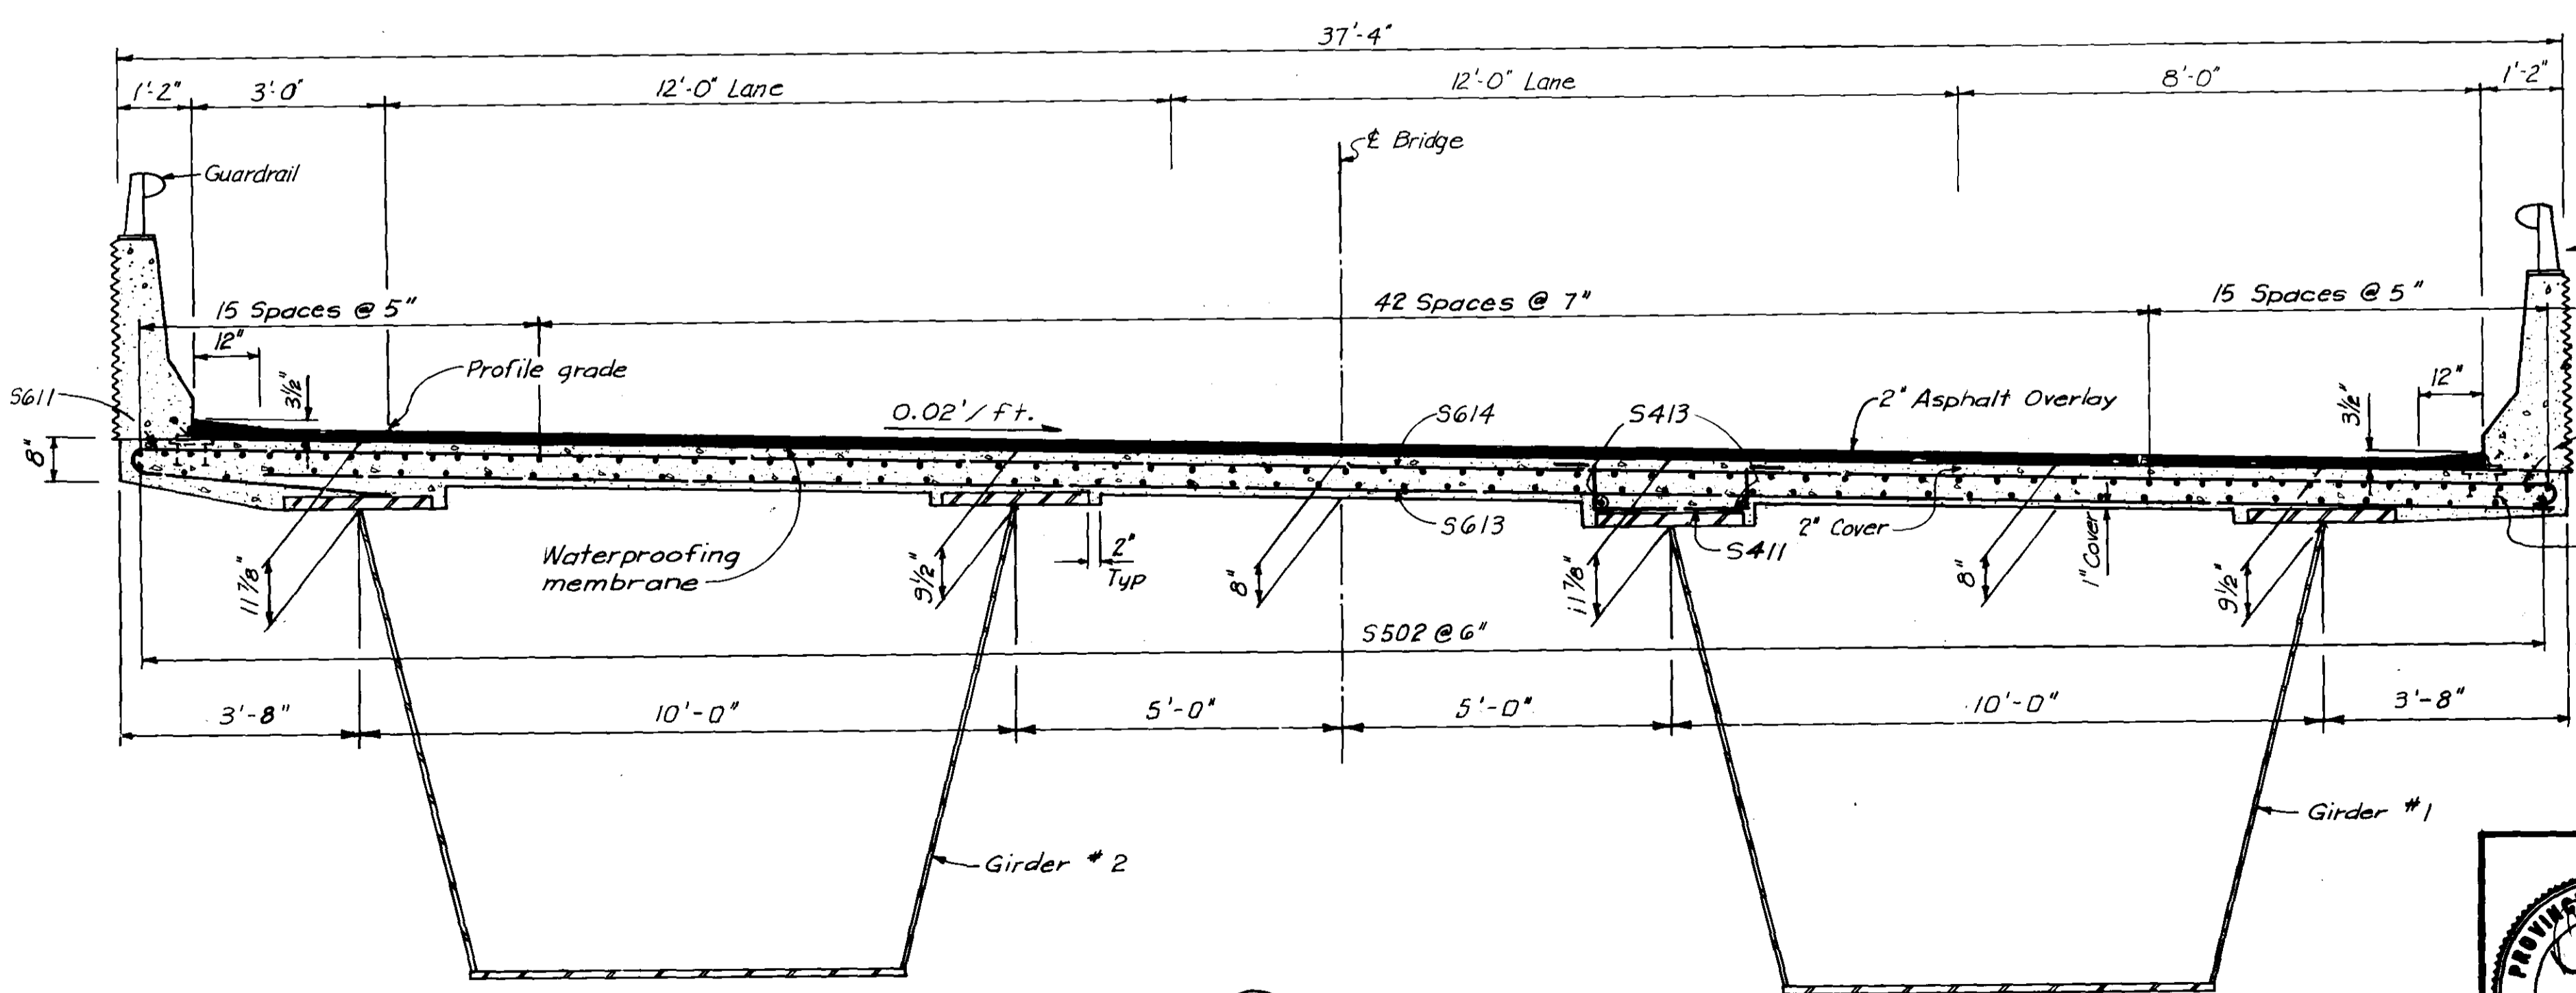

Note: For haunches see attached sheets.

ISSUED FOR TENDER			
NO.	REVISIONS	DATE	BY
0		4.7.77	

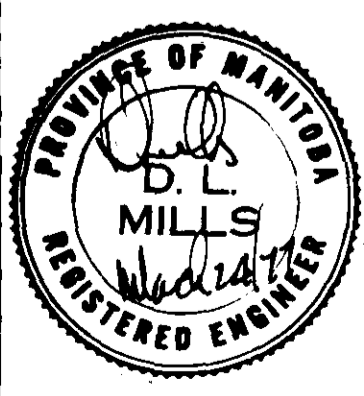	THE CITY OF WINNIPEG WORKS & OPERATIONS DEPARTMENT STREETS & TRANSPORTATION DIVISION	ROUTE 165
	W.L. WARDROP & ASSOCIATES LTD. ENGINEERING CONSULTANTS <small>WINNIPEG - THUNDER BAY - REGINA - SASKATOON</small>	SLAB PLAN NORTH BRIDGE
APPROVED BY: <i>[Signature]</i> DATE: 25/11/77 DRAWN BY: S.T. JAN. 77 PRELIM. CHK: S.T.K. JAN. 77	DESIGN: S.T.K. DEC. 76 CHECK: D.L.M. JAN. 77	APPROVED BY: <i>[Signature]</i> DATE: 26/3/77 MANAGER OF STREETS AND TRAFFIC
DRAWING NO. B-5092-236		W.L.W. NO. 74012-21

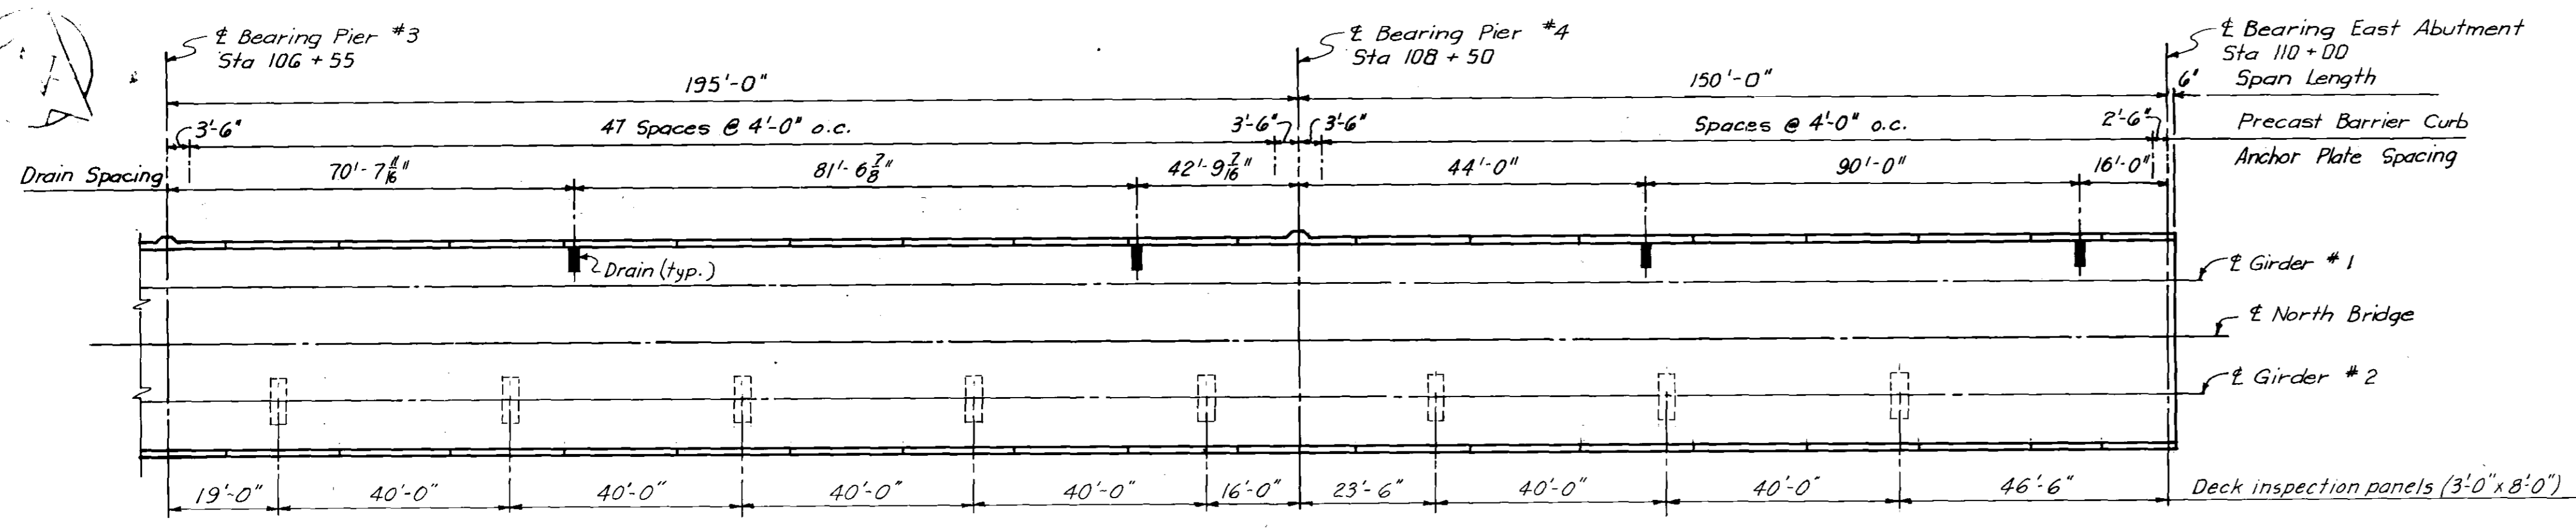


PLAN
Scale: 1" = 20'-0"


MARK	NUMBER	LENGTH	WEIGHT	TYPE	DIMENSIONS			
					A	B	C	D
* 5410	497	3-0	996	102	1-6	0-9	0-8 1/2	
* 5411	386	4-0	1031	102	2-5	0-9	0-8 1/2	
* 5412	4	14-0	40	str				
* 5413	44	40-0	1176	str				
5501	146	27-0	4112	101	26-6			
5502	2838	40-0	118401	str				
5503	112	27-0	3154	str				
5608	146	5-4	1169	118	2-0	1-1	1-7	
5611	1774	7-8	20436	101				
5613	1519	35-0	79854	str				
5614	1724	43-0	111346	103	37-3	4-0	1-0	
5615	40	3-0	180	str				
5810	56	43-0	6429	103	37-3	4-0	1-0	

TOTAL WEIGHT FOR SLAB GRADE 40 = 3243 LBS
GRADE 60 = 345081 LBS

* Grade 40

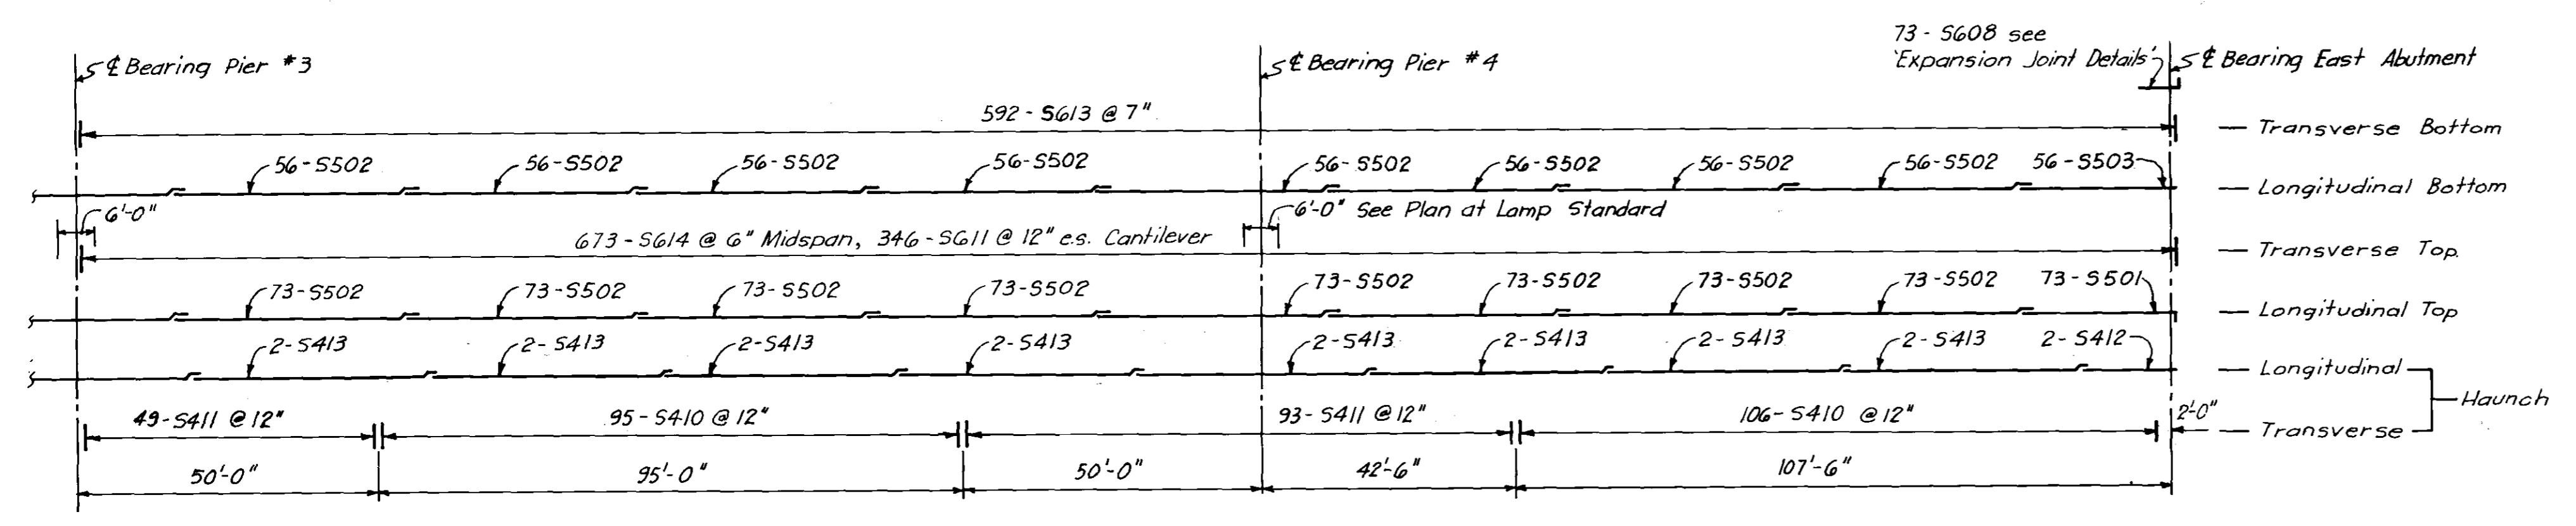


SLAB REINFORCEMENT SCHEMATIC

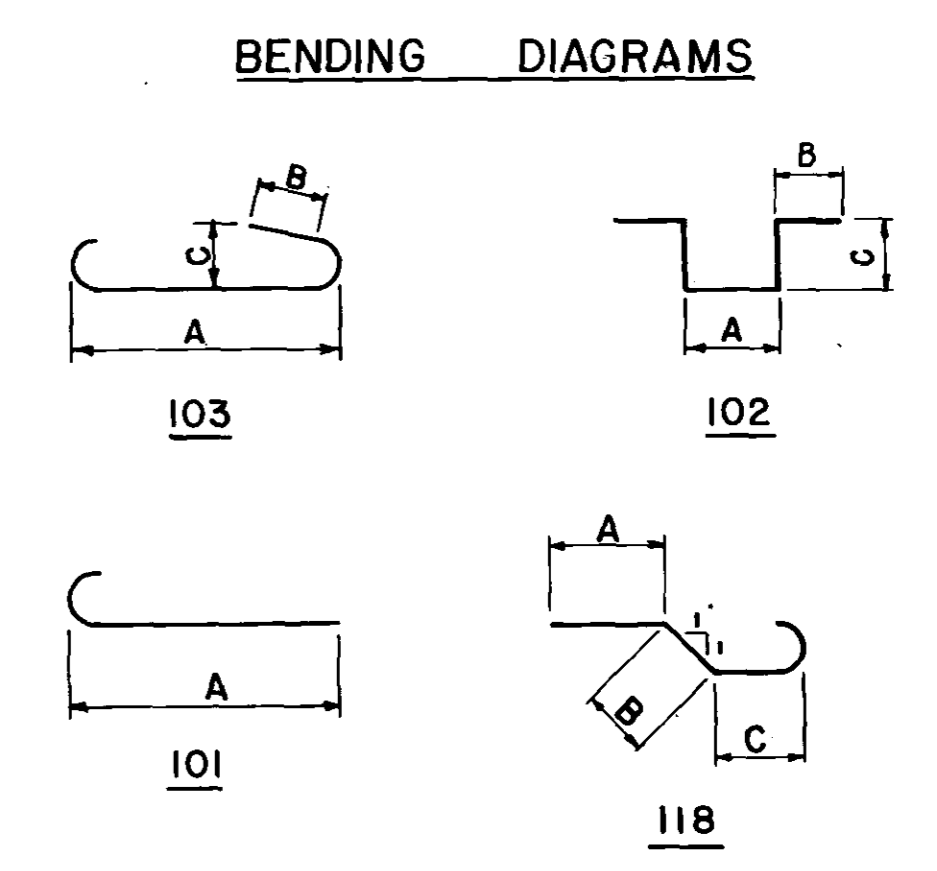


BENDING DIAGRAMS

For spacing of longitudinal bars see Section 236

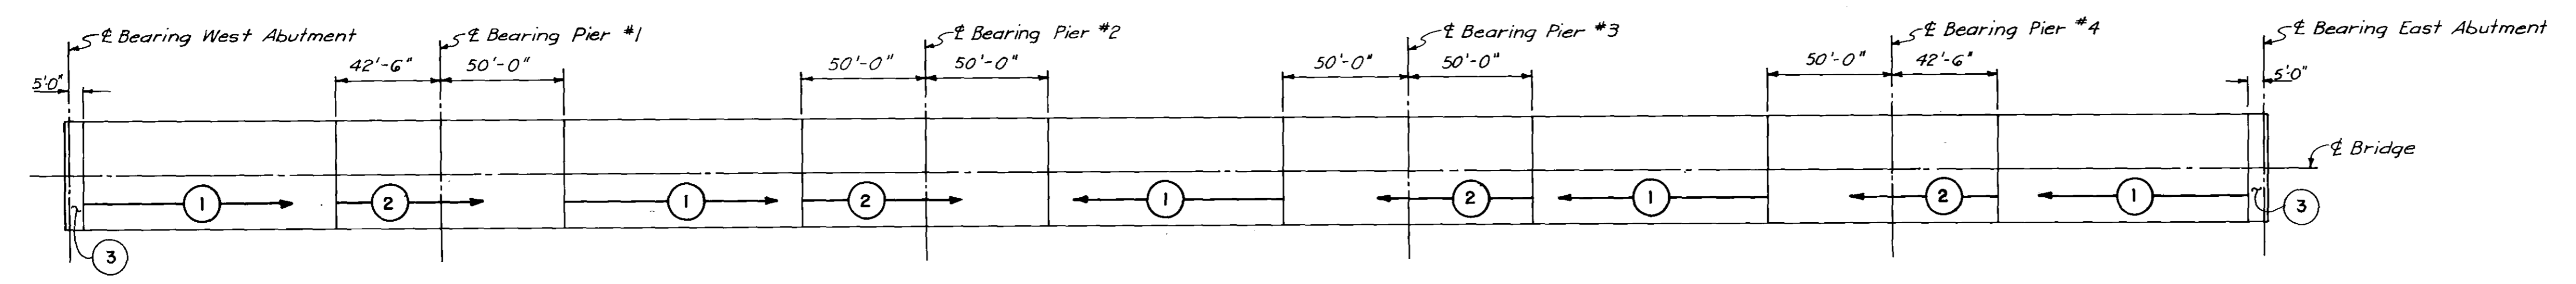


POURING SEQUENCE


AS - BUILT
DATE: 18 NOV 1977

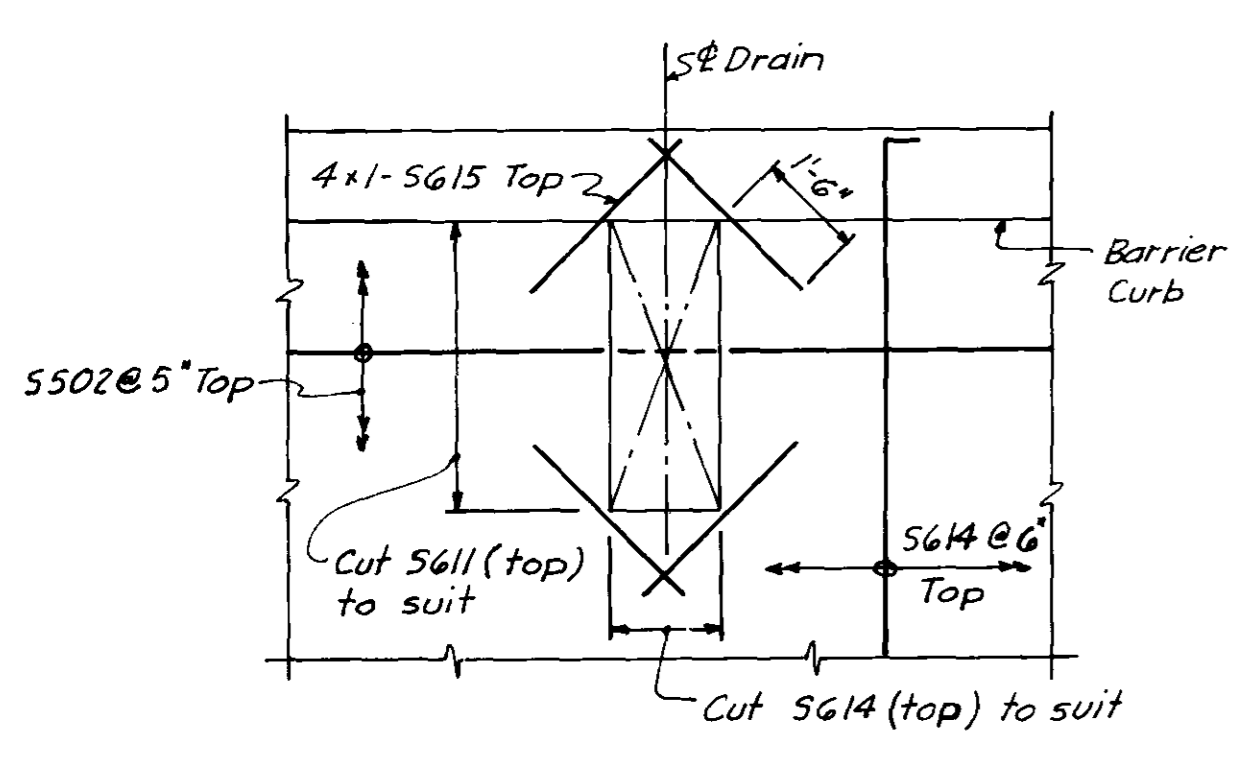

TYPICAL PLAN AT DRAIN
Scale: 3/8" = 1'-0"













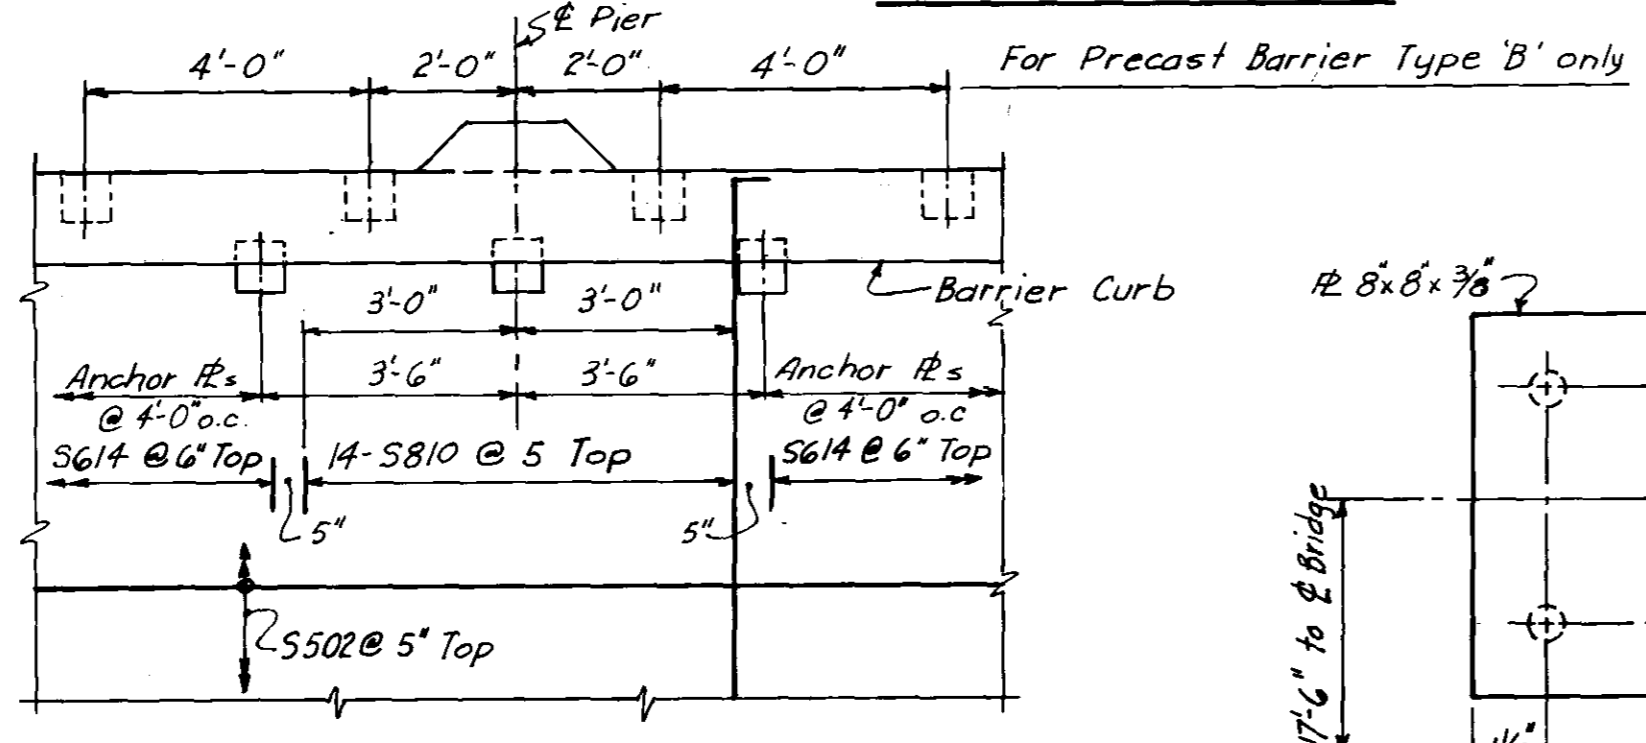


PLAN AT LAMP STANDARD
Scale: 3/8" = 1'-0"

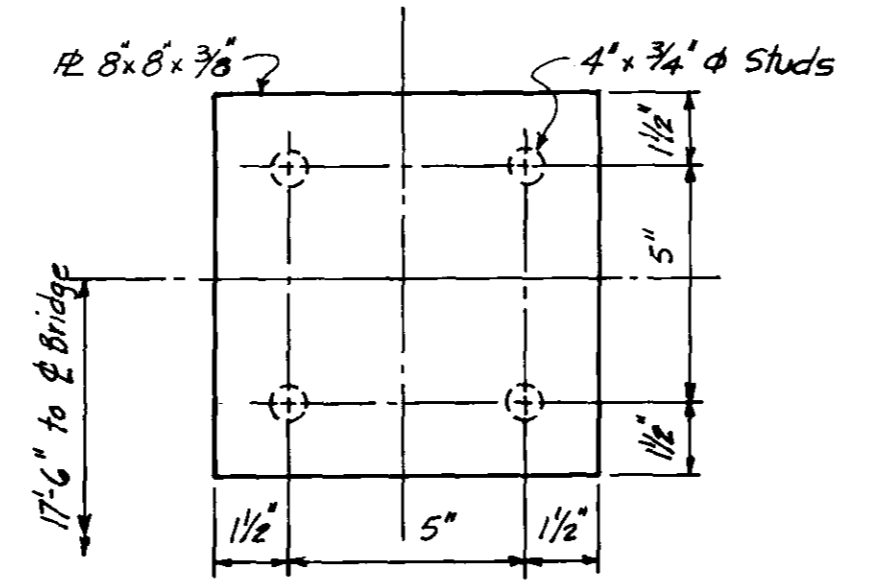

ANCHOR PLATE ASSEMBLY
Scale: 3" = 1'-0"

	THE CITY OF WINNIPEG WORKS & OPERATIONS DEPARTMENT STREETS & TRANSPORTATION DIVISION	ROUTE 165	SCALE: AS SHOWN
	W.L. WARDROP & ASSOCIATES LTD. ENGINEERING CONSULTANTS WINNIPEG · THUNDER BAY · REGINA · BARRIE · EDMONTON	SLAB PLAN NORTH BRIDGE	
APPROVED BY: <i>[Signature]</i> DATE: 25 JAN 77		APPROVED BY: <i>[Signature]</i> DATE: 25 JAN 77	
DRAWN BY: ST. DATE: JAN 77 PRELIM. CHK: STK. DATE: JAN 77		DESIGN: STK. DATE: DEC 76 CHECK: DLM. DATE: JAN 77	

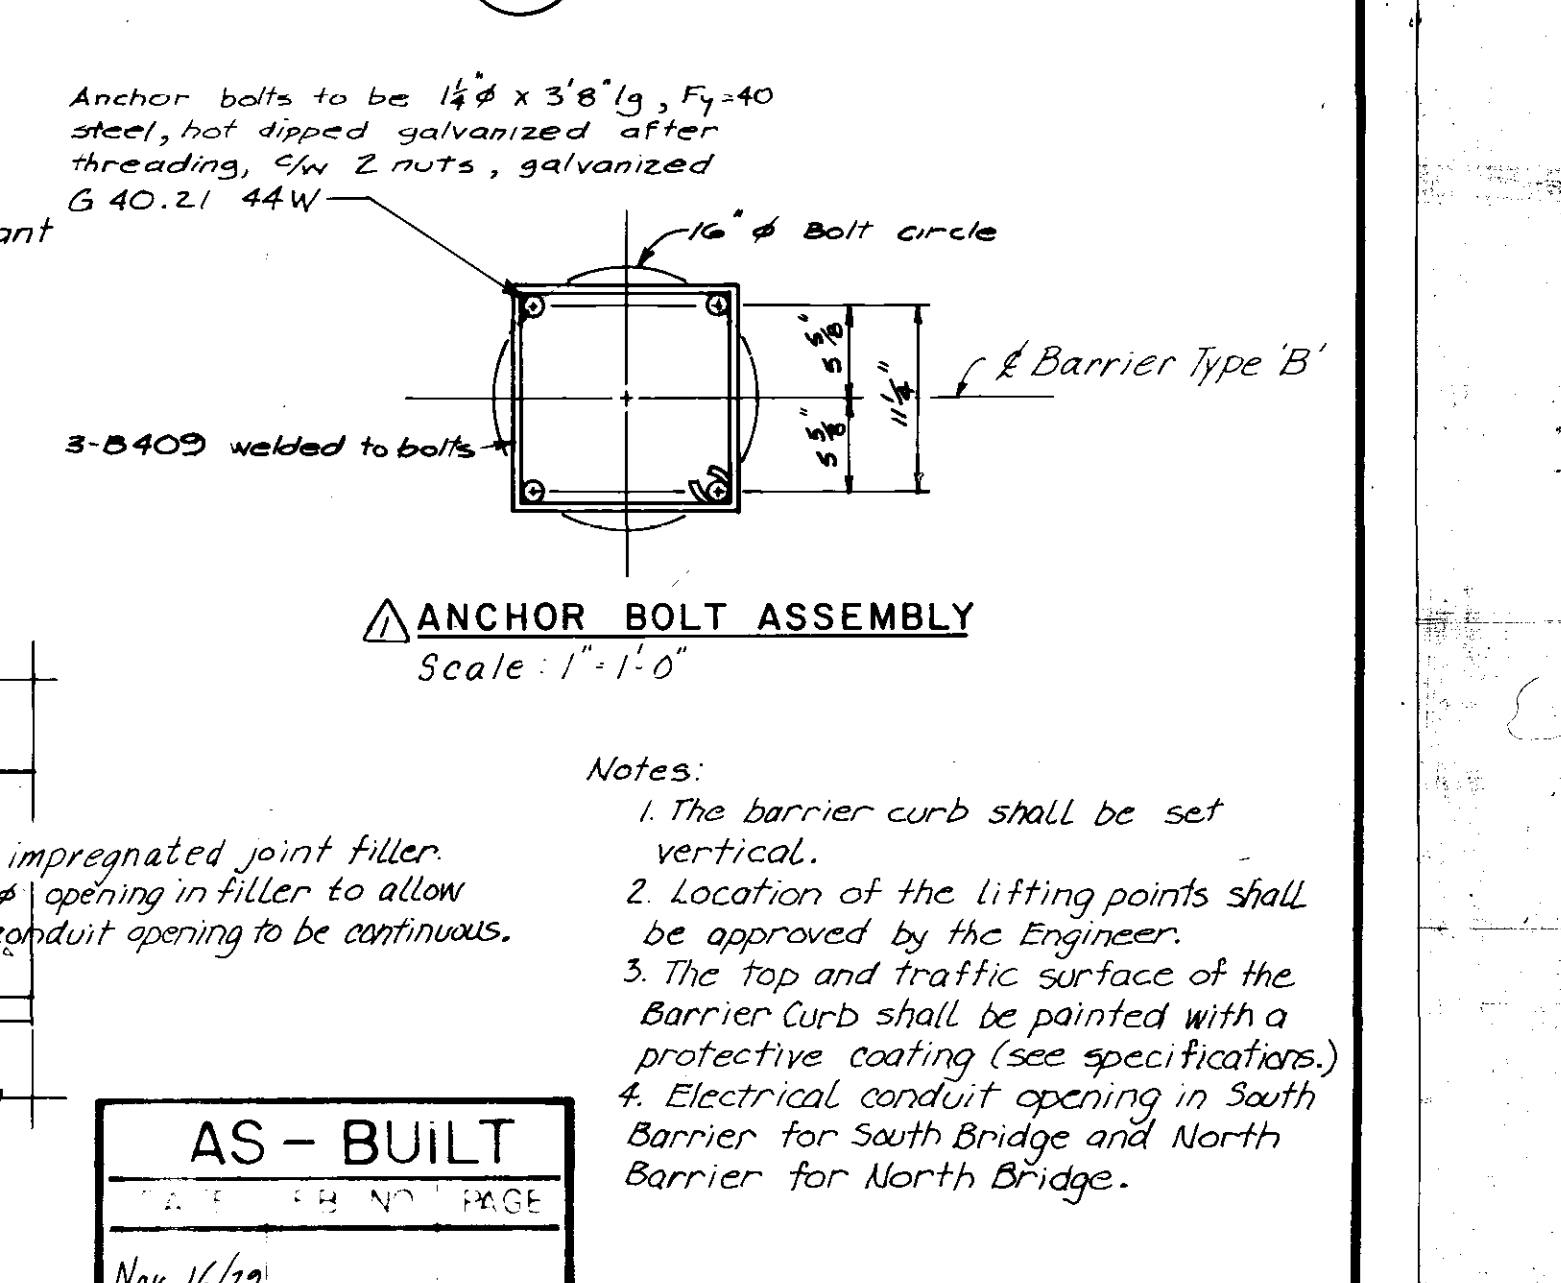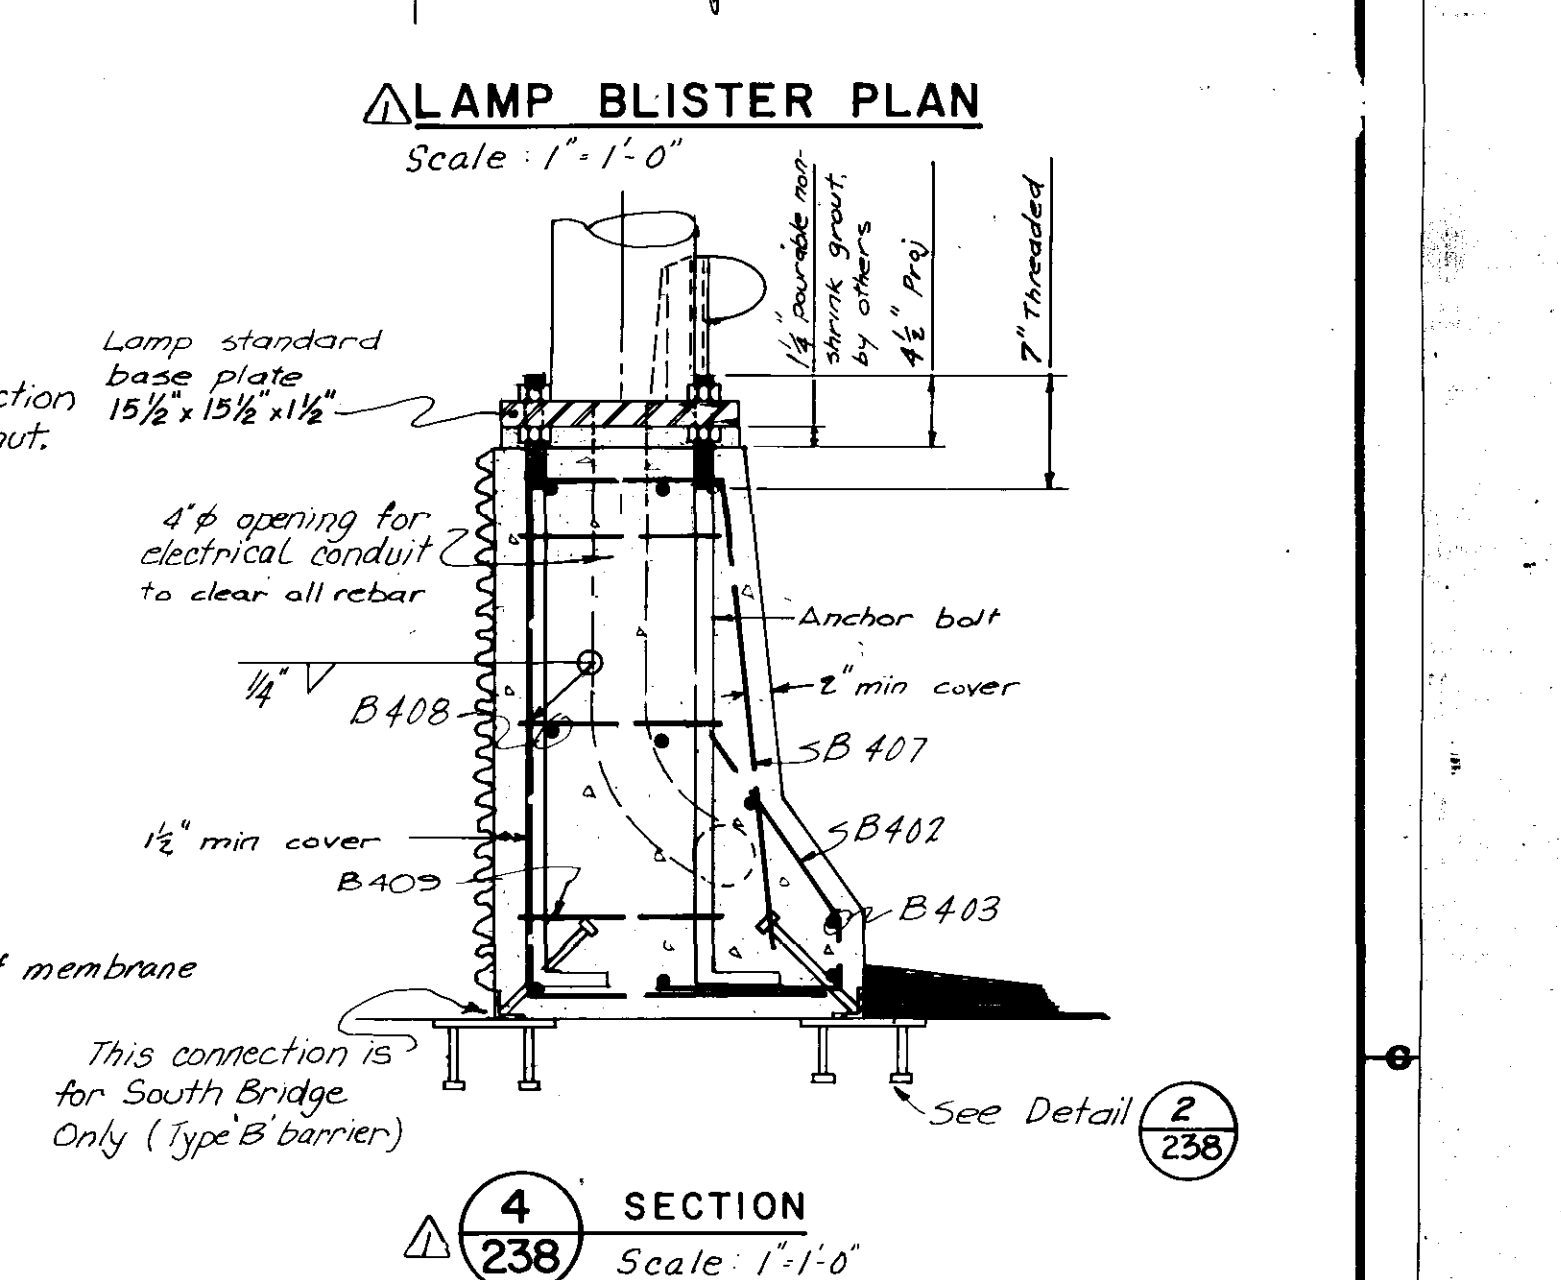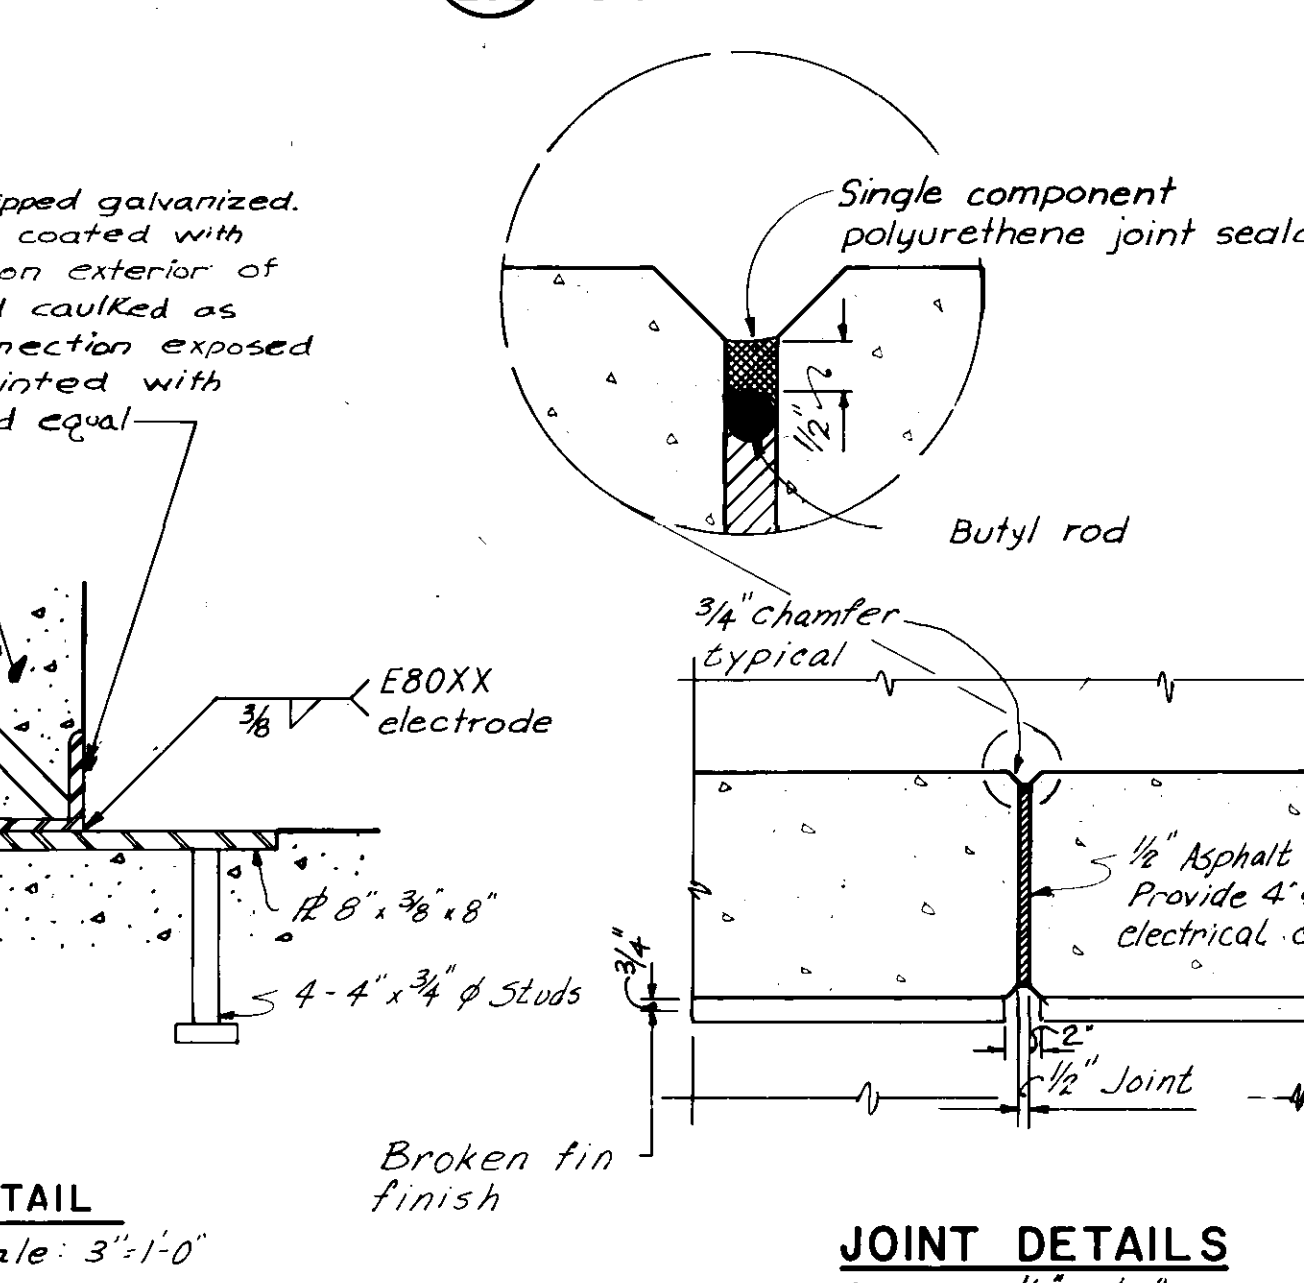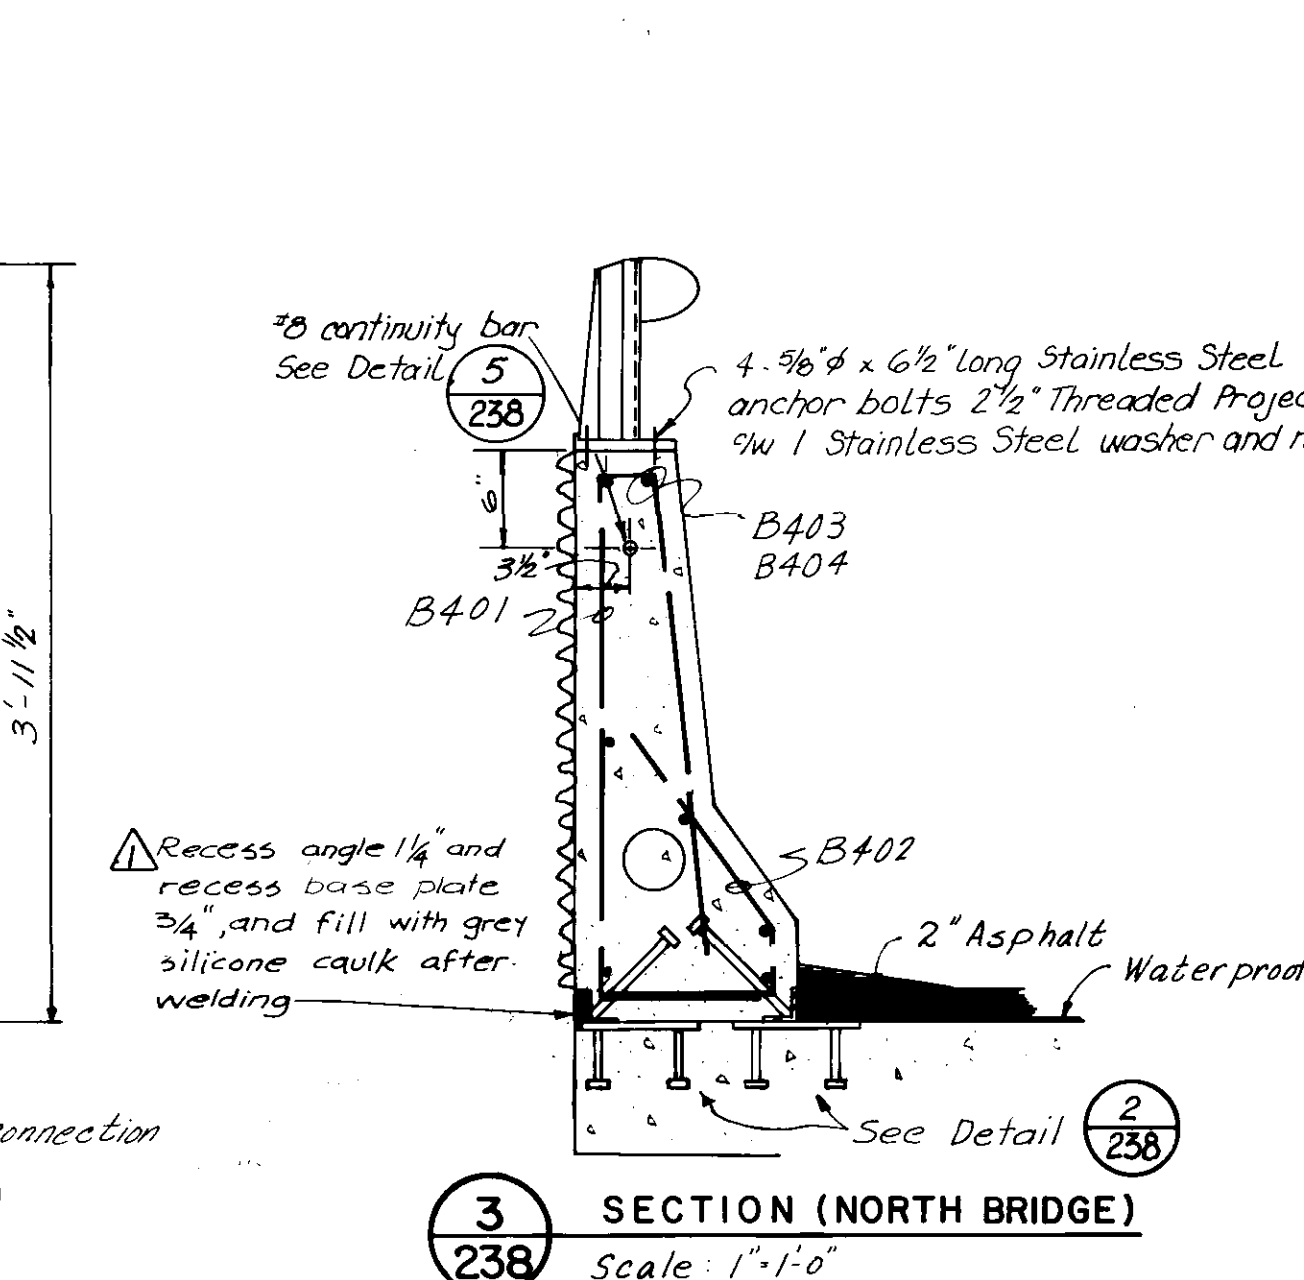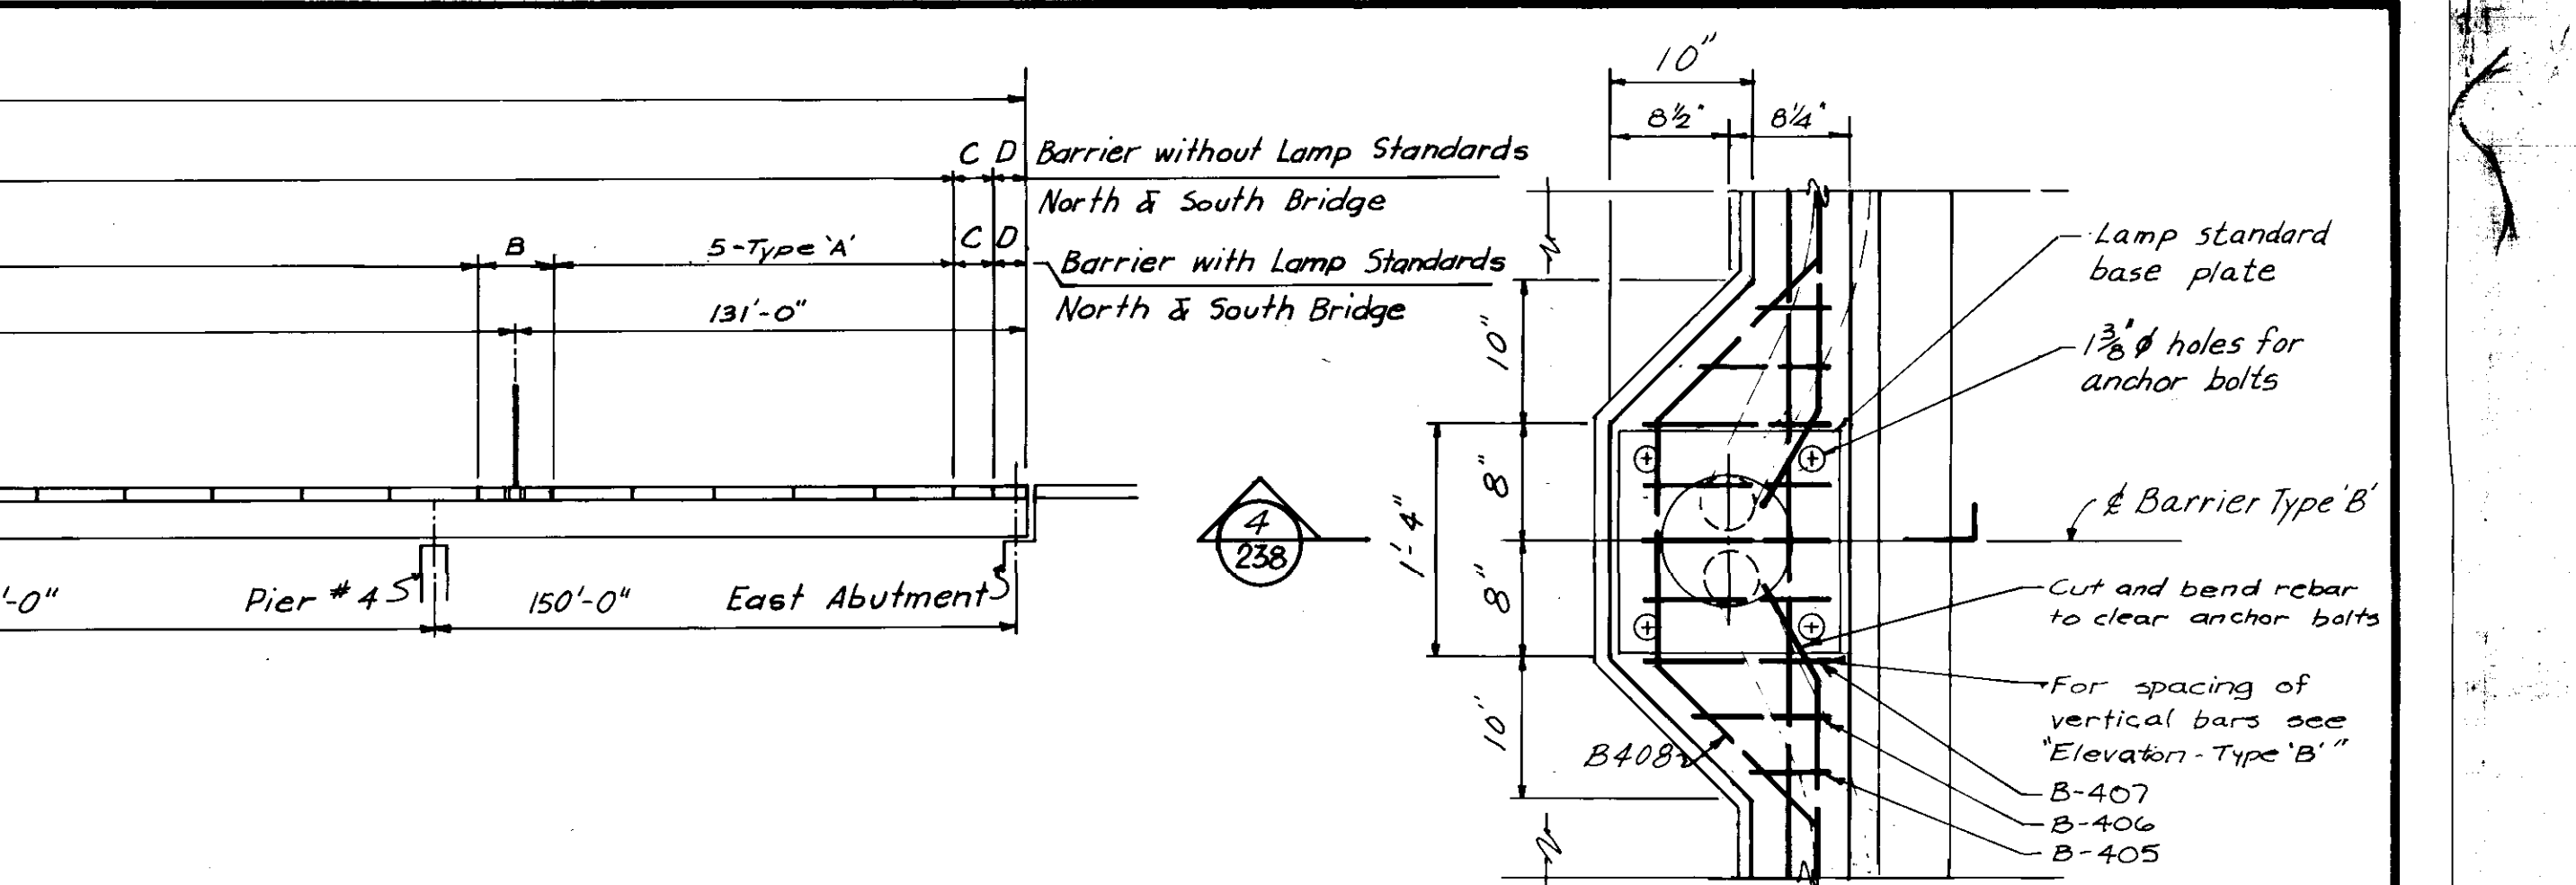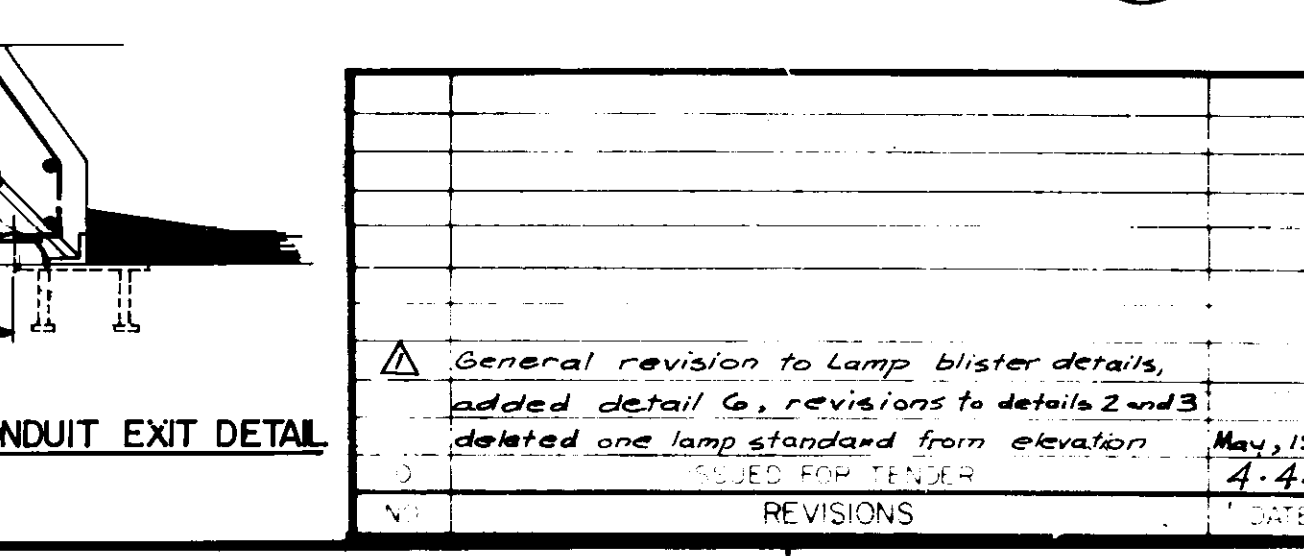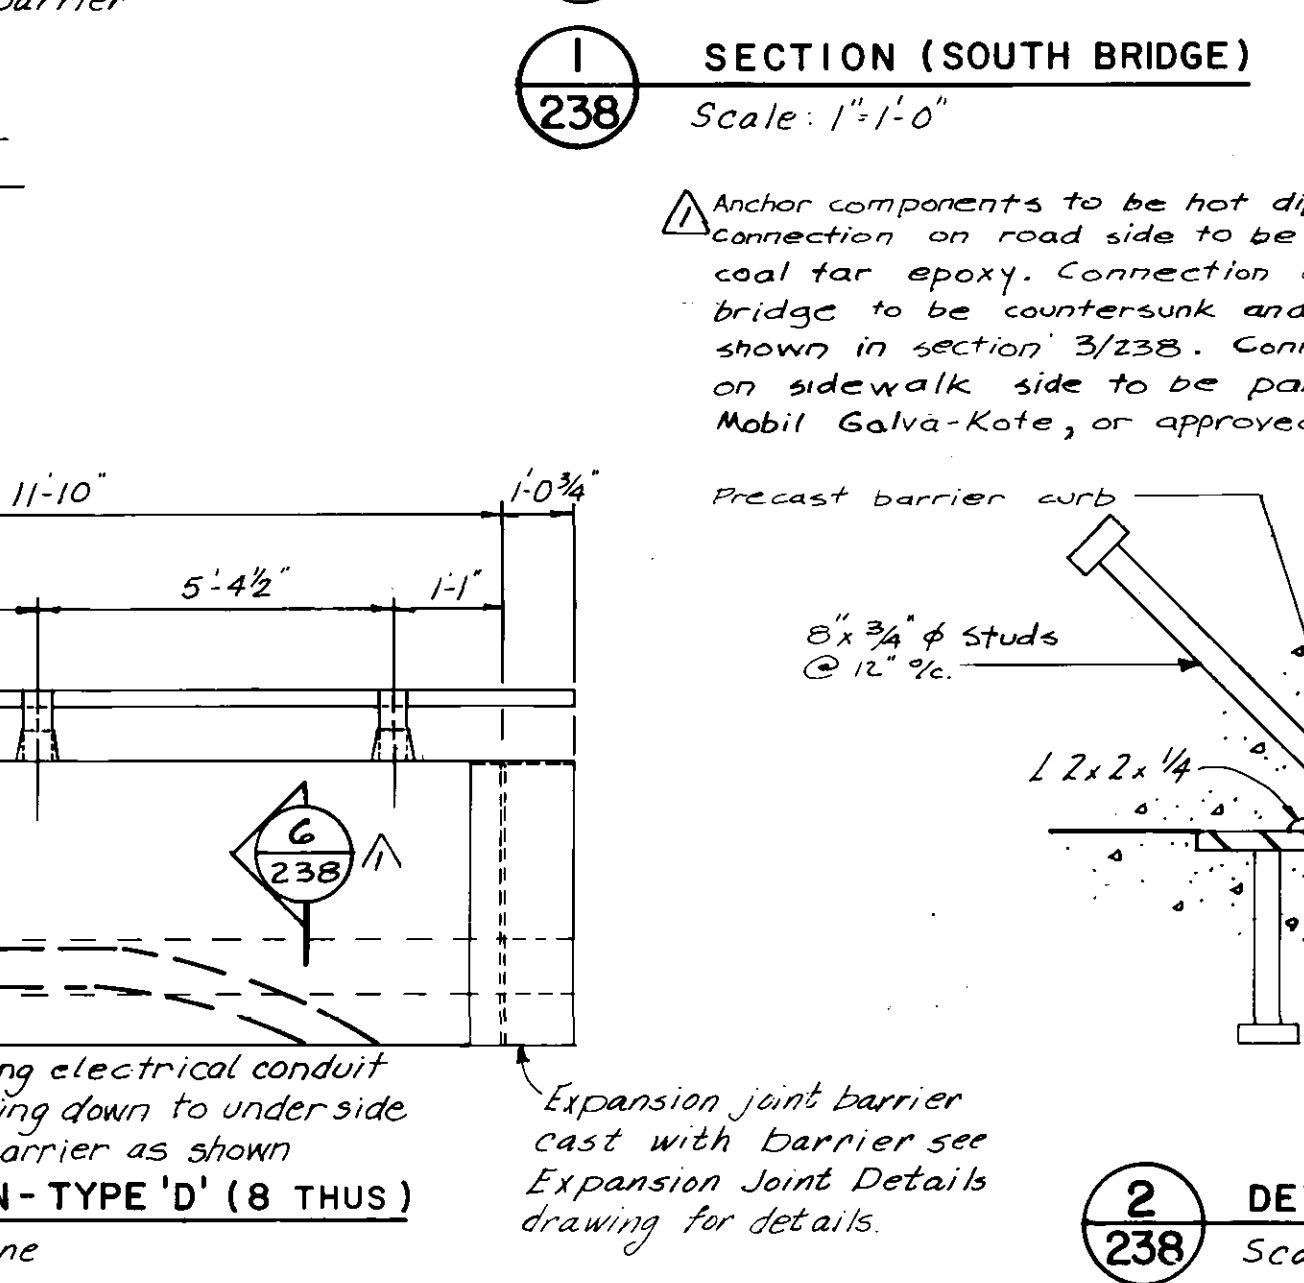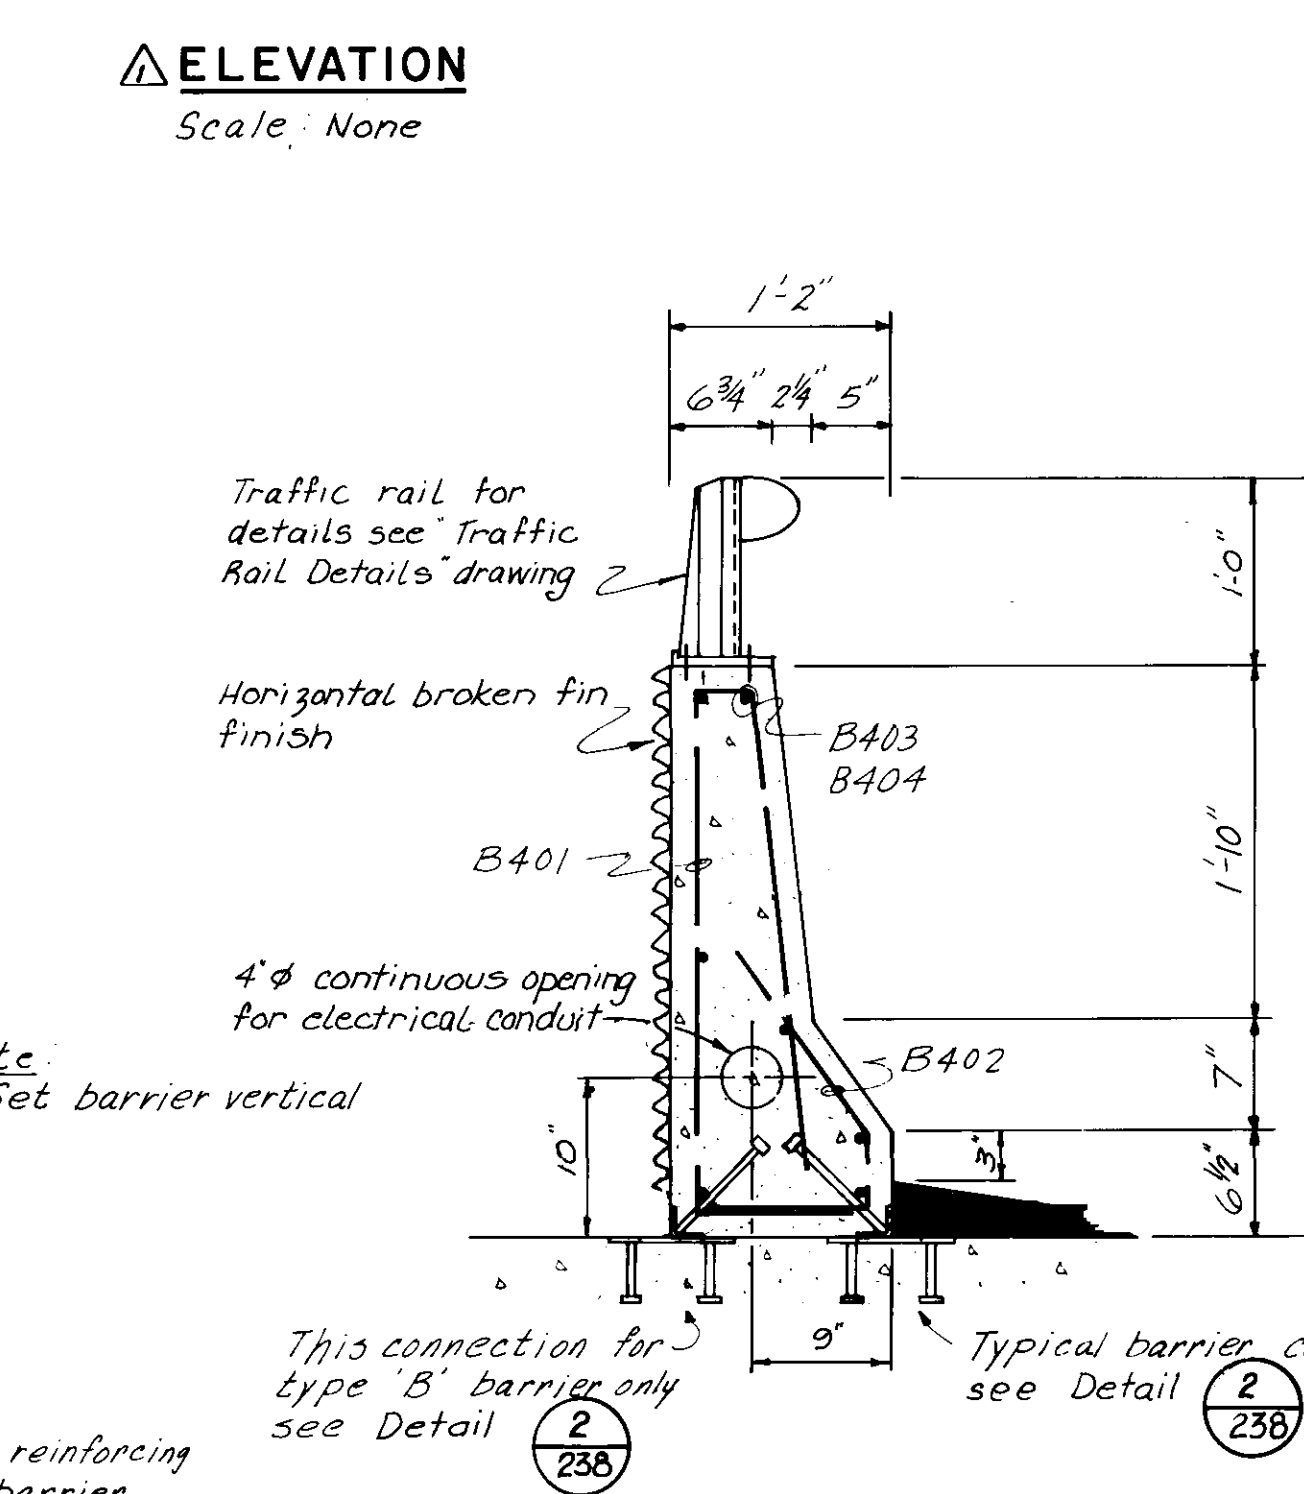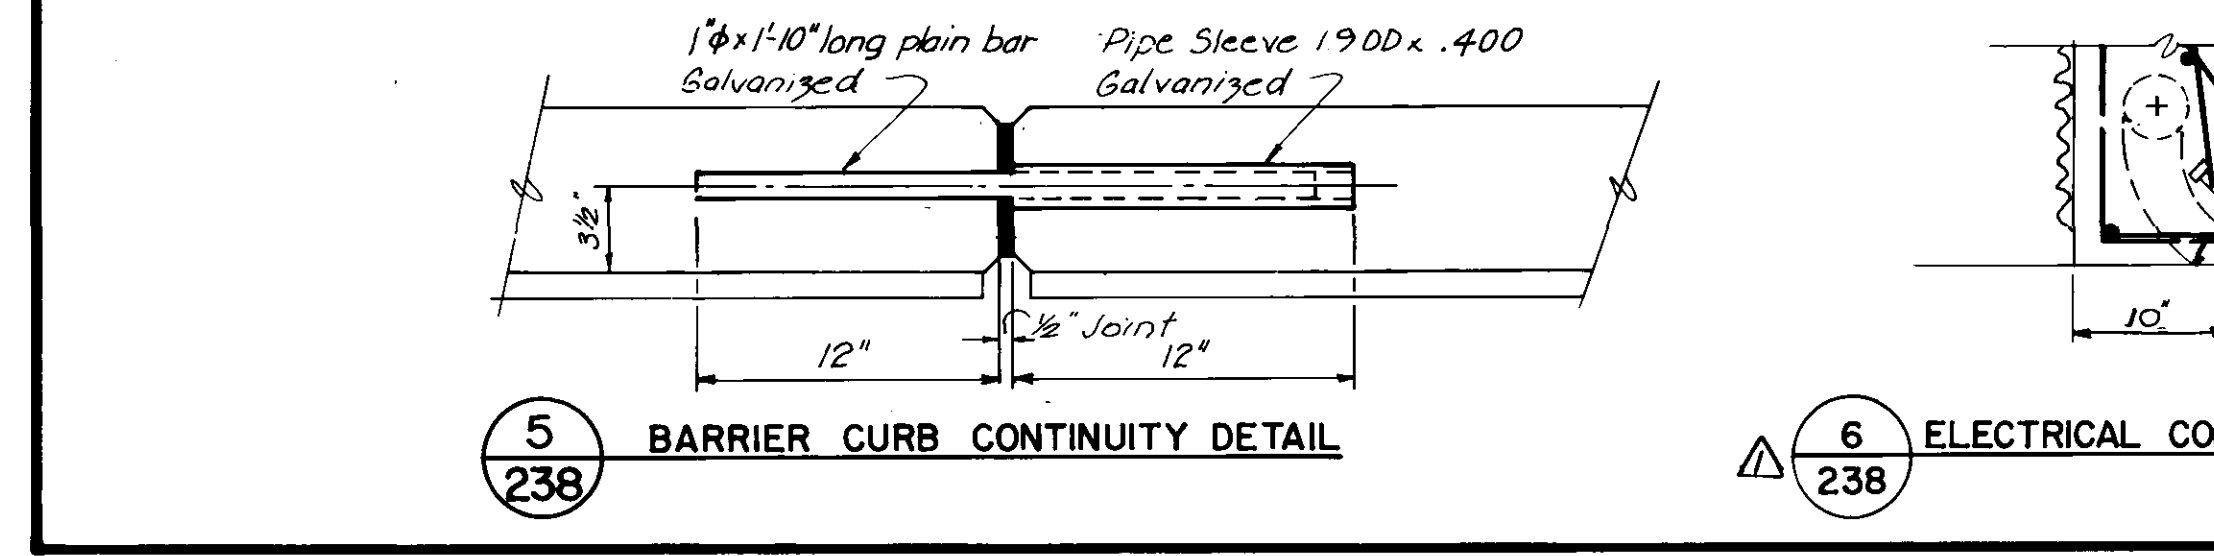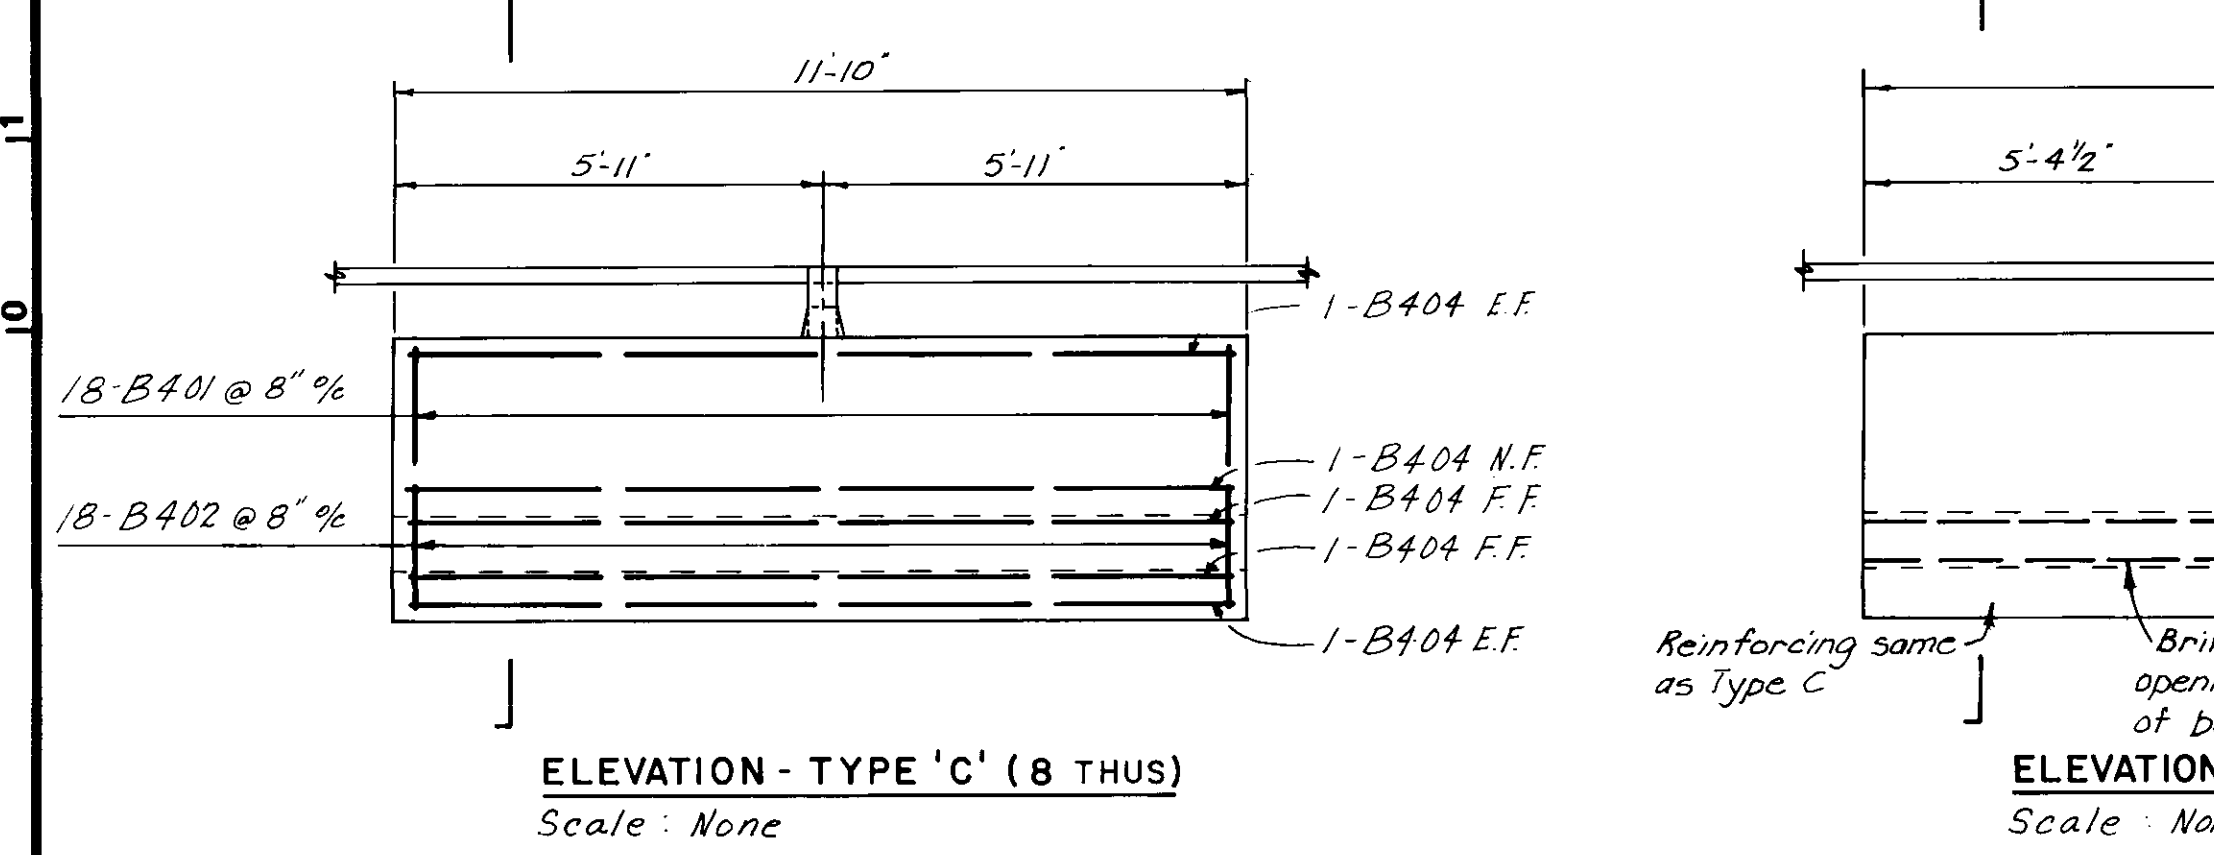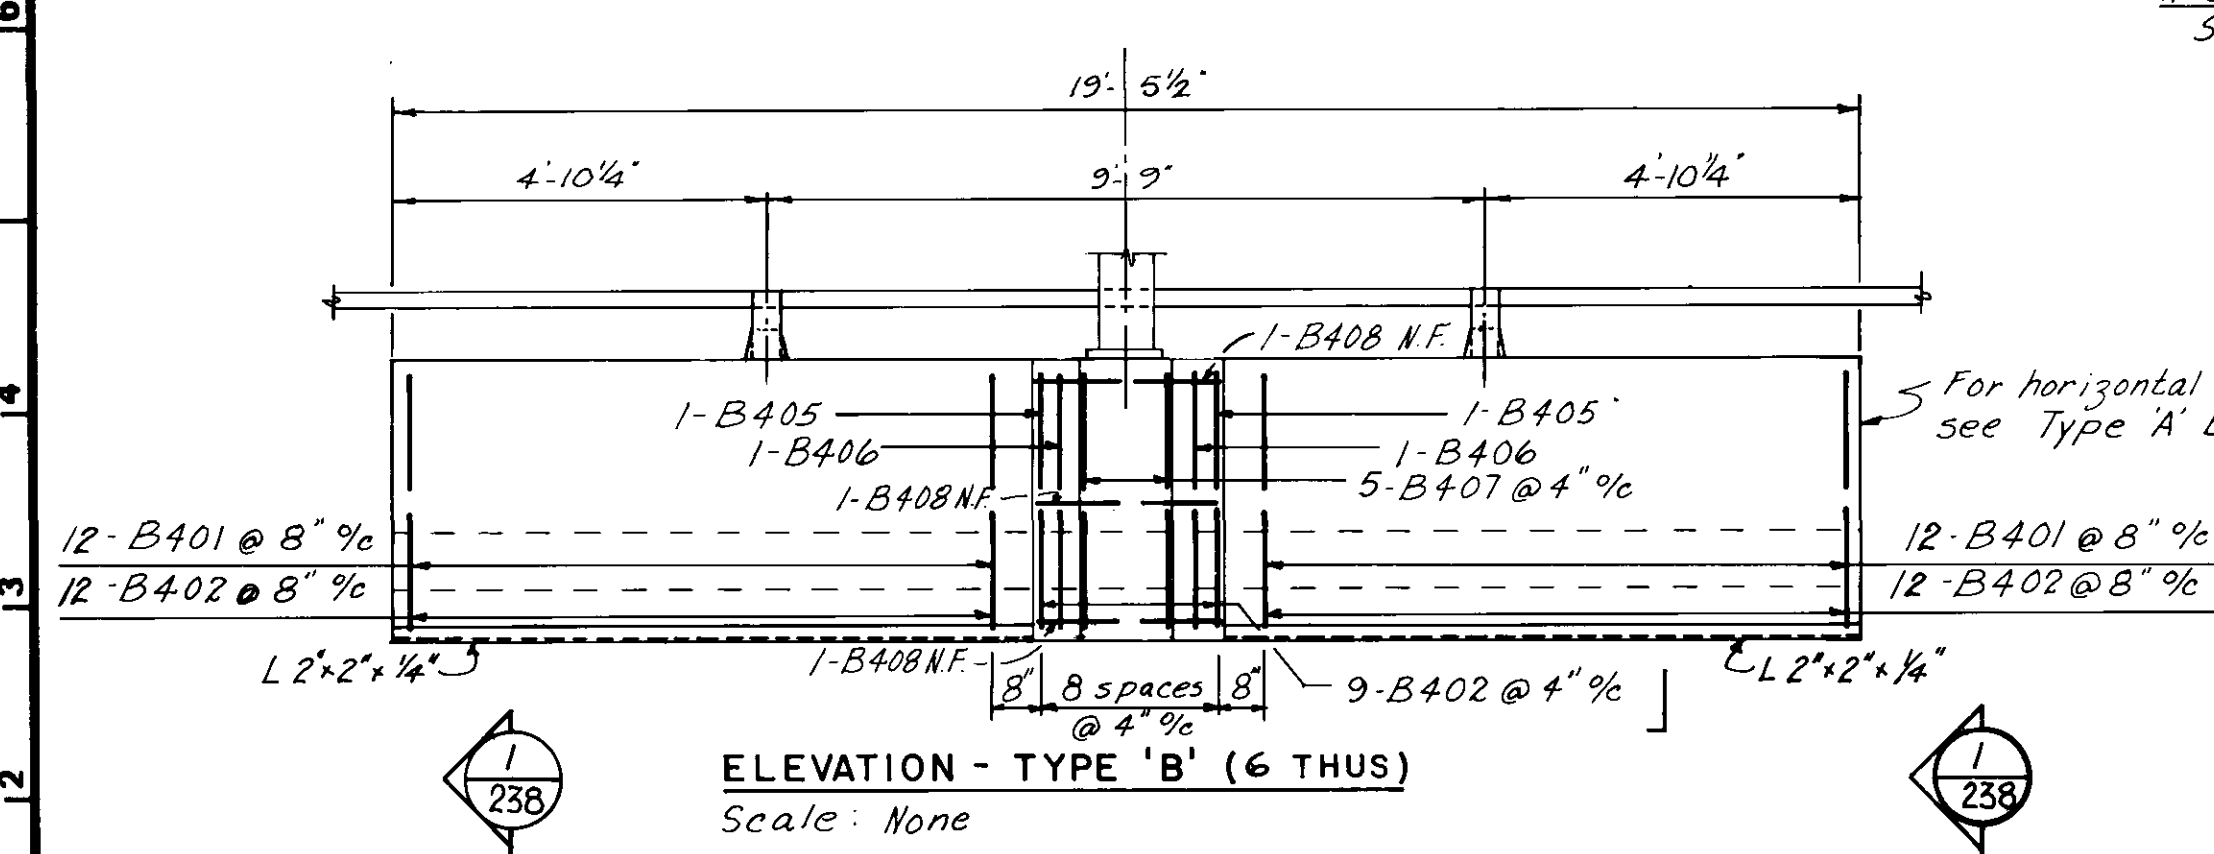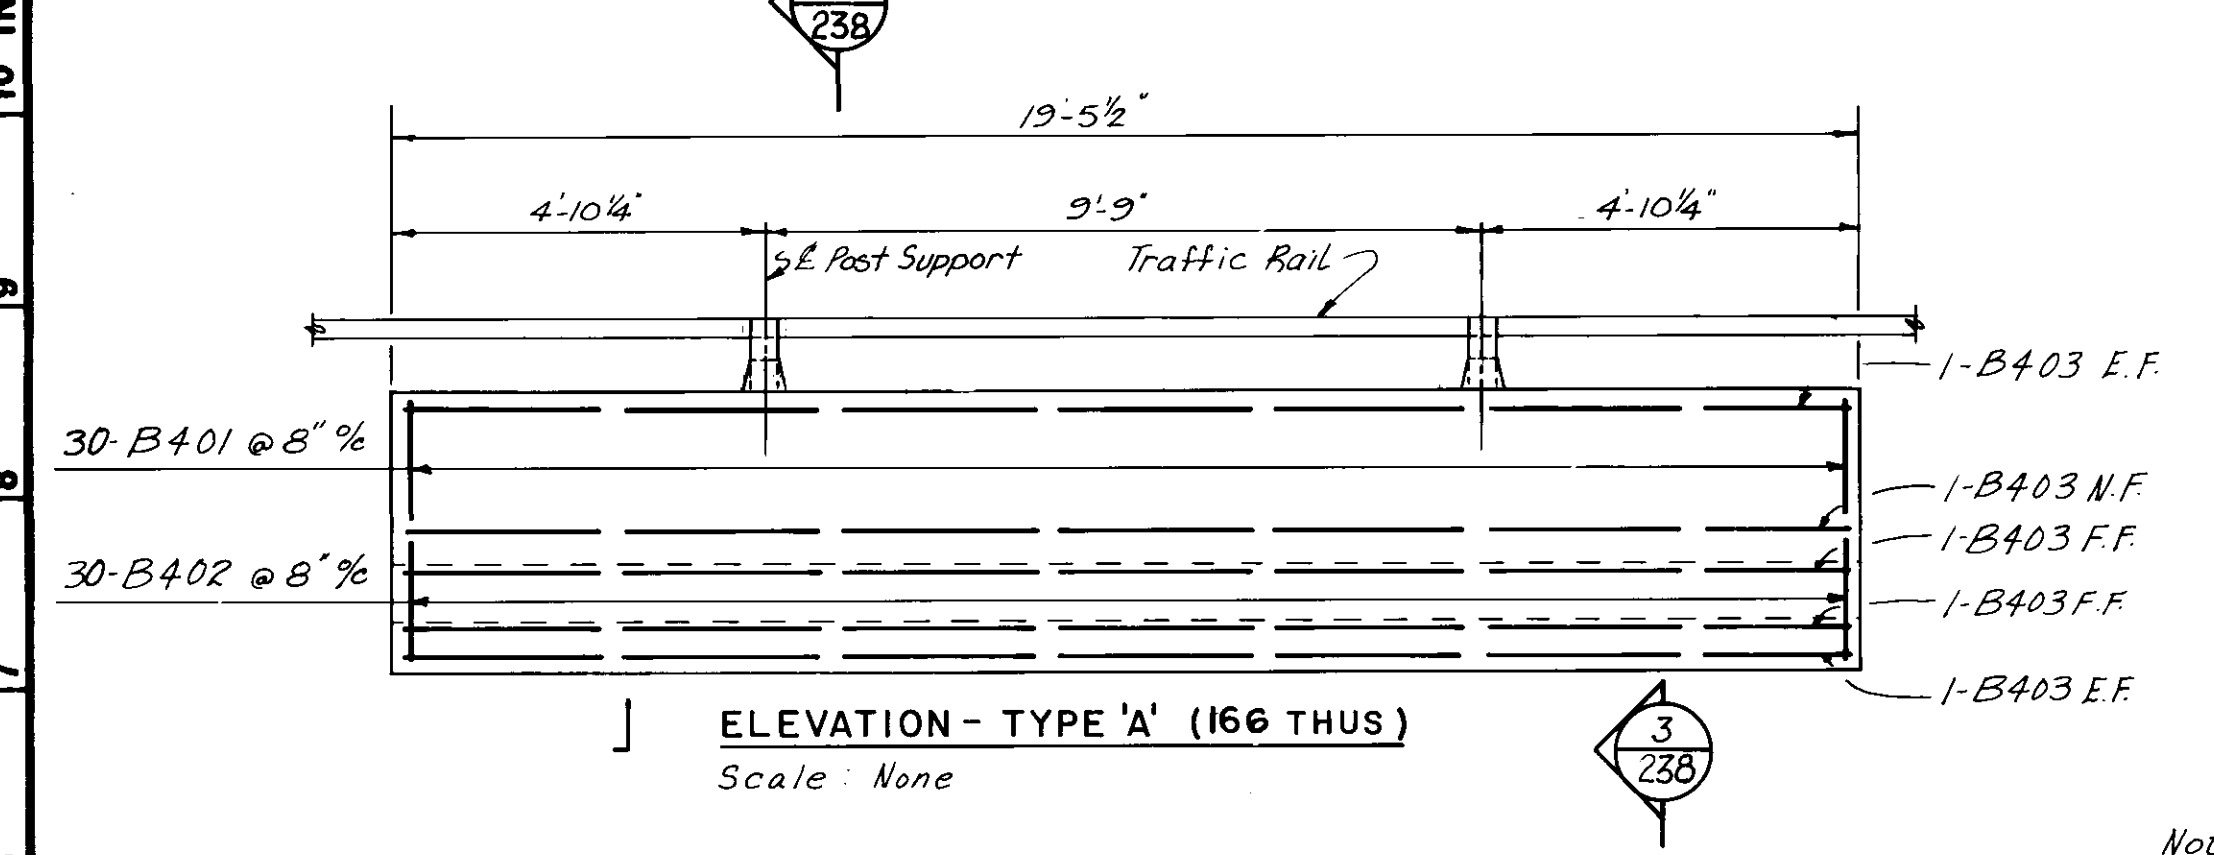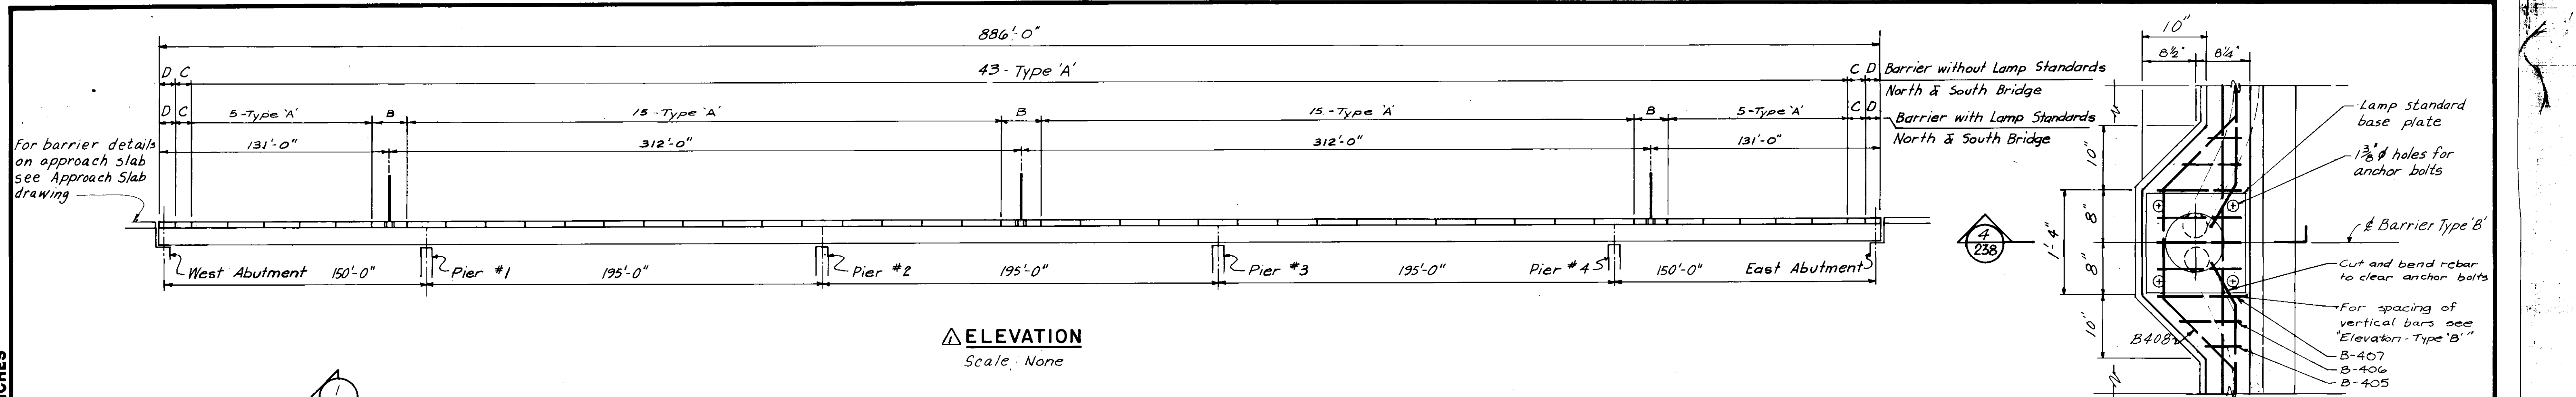

ELEVATION
Scale: None

LAMP BLISTER PLAN
Scale: 1" = 1'-0"

ELEVATION - TYPE 'A' (166 THUS)
Scale: None

ELEVATION - TYPE 'B' (6 THUS)
Scale: None

ELEVATION - TYPE 'C' (8 THUS)
Scale: None

ELEVATION - TYPE 'D' (8 THUS)
Scale: None

SECTION (SOUTH BRIDGE)
Scale: 1" = 1'-0"

SECTION (NORTH BRIDGE)
Scale: 1" = 1'-0"

SECTION
Scale: 1" = 1'-0"

DETAIL
Scale: 3" = 1'-0"


JOINT DETAILS
Scale: 1 1/2" = 1'-0"

ANCHOR BOLT ASSEMBLY
Scale: 1" = 1'-0"


AS-BUILT
NOV. 16/19

- Notes:
- The barrier curb shall be set vertical.
 - Location of the lifting points shall be approved by the Engineer.
 - The top and traffic surface of the Barrier Curb shall be painted with a protective coating (see specifications.)
 - Electrical conduit opening in South Barrier for South Bridge and North Barrier for North Bridge.


<p>General revision to Lamp blister details, added detail G, revisions to details 2 and 3, deleted one lamp standard from elevation. DATED FOR TENDER 4.4.77</p>			<p>THE CITY OF WINNIPEG WORKS & OPERATIONS DEPARTMENT STREETS & TRANSPORTATION DIVISION</p>		<p>ROUTE 165</p>	
<p>APPROVED BY: [Signature] DATE 25 MAR 77</p>			<p>W.L. WARDROP & ASSOCIATES LTD. ENGINEERING CONSULTANTS WINNIPEG - THUNDER BAY - REGINA - BARRIE - EDMONTON</p>		<p>PRECAST BARRIER CURB DETAILS</p>	
<p>DRAWN BY: S.T. JAN 77 DESIGN: KWS DATE: DEC 76 PRELIM. CHK.: S.T.K. JAN 77 CHECK: D.L.M. JAN 77</p>		<p>APPROVED BY: [Signature] DATE 25/3/77</p>		<p>MANAGER OF STREETS AND TRAFFIC</p>		
<p>REVISIONS</p>		<p>SCALE: AS SHOWN</p>		<p>DRAWING NO. B-5092-238</p>		

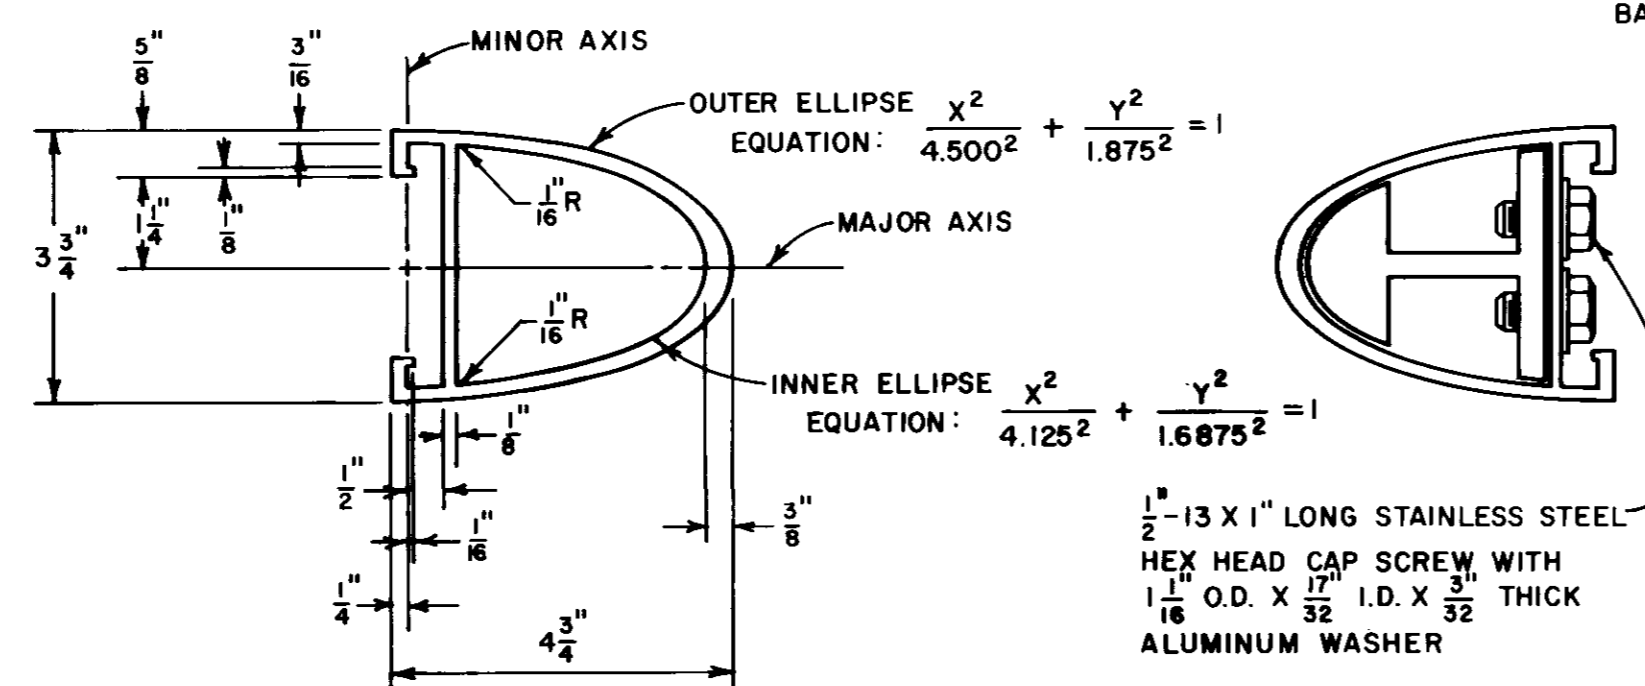


BARRIER RAIL
 SCALE $\frac{3}{8}$ " = 1"

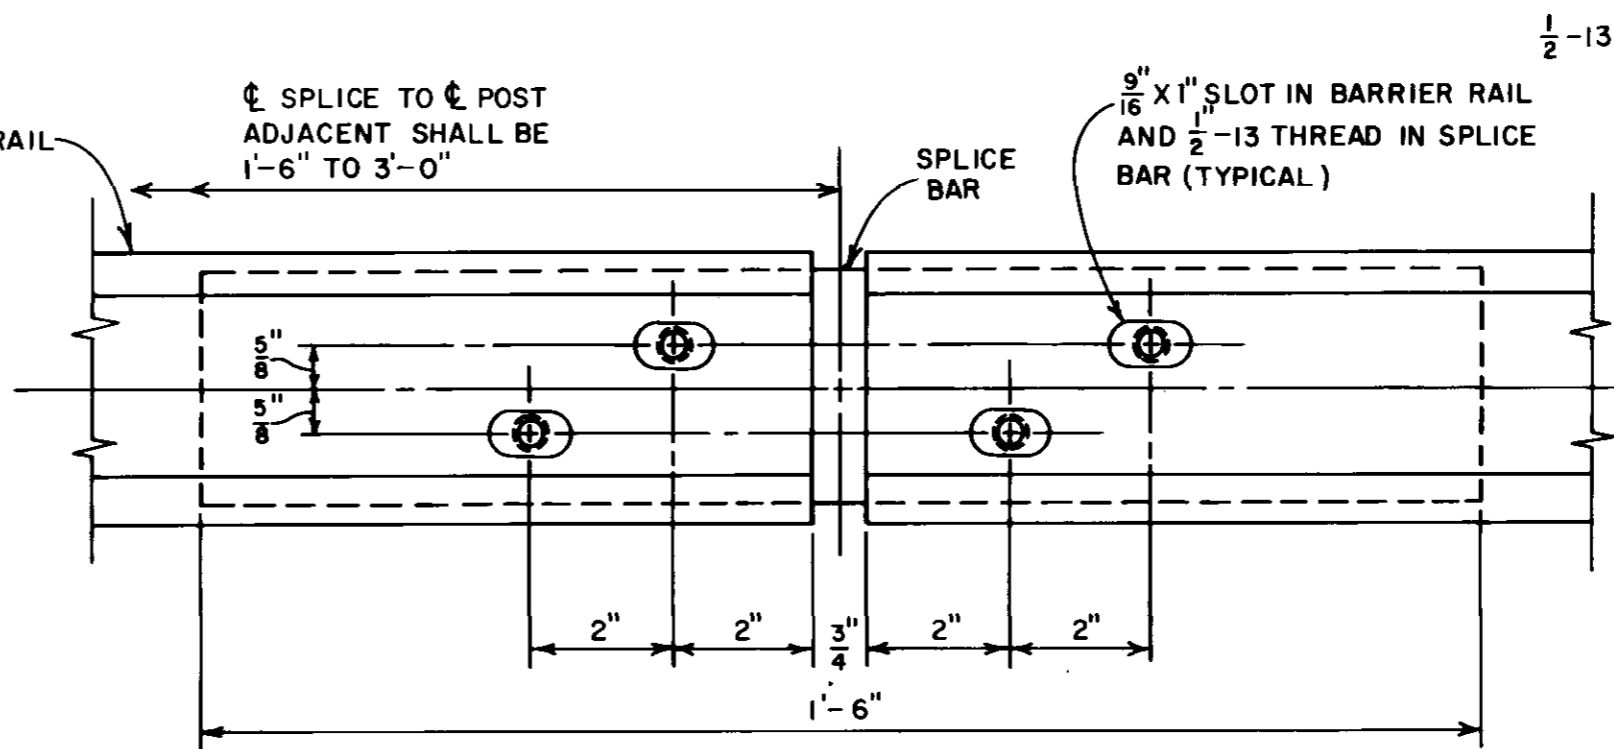


SPLICE DETAIL
 SCALE $\frac{3}{8}$ " = 1"

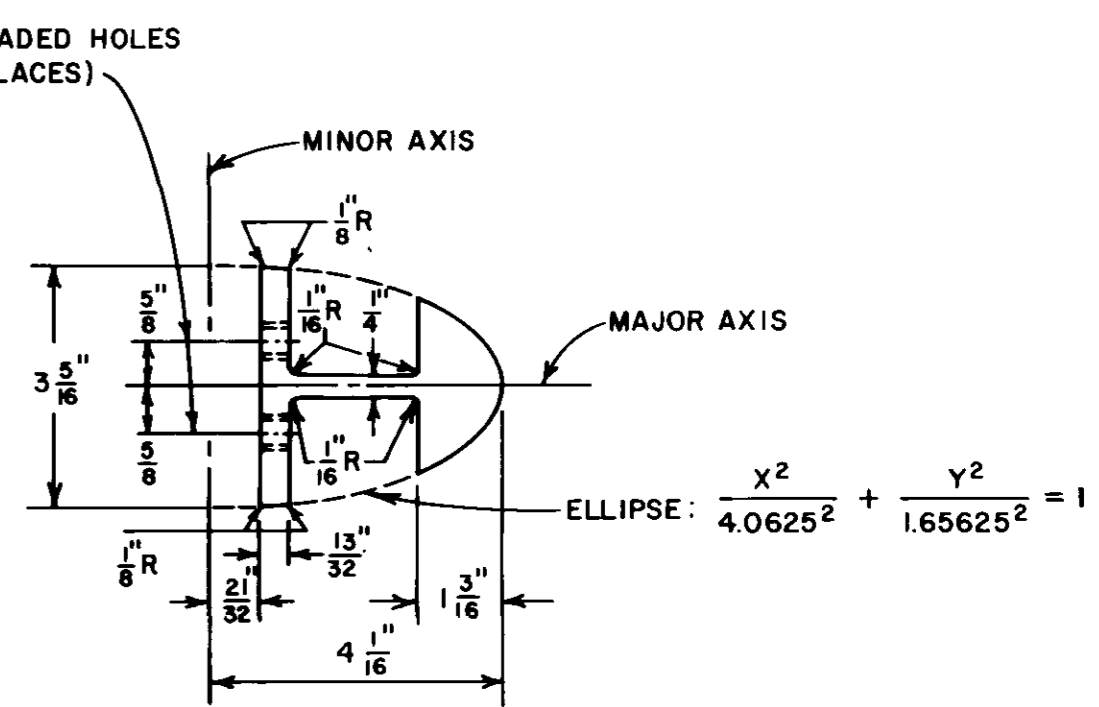


SPLICE BAR
 SCALE $\frac{3}{8}$ " = 1"

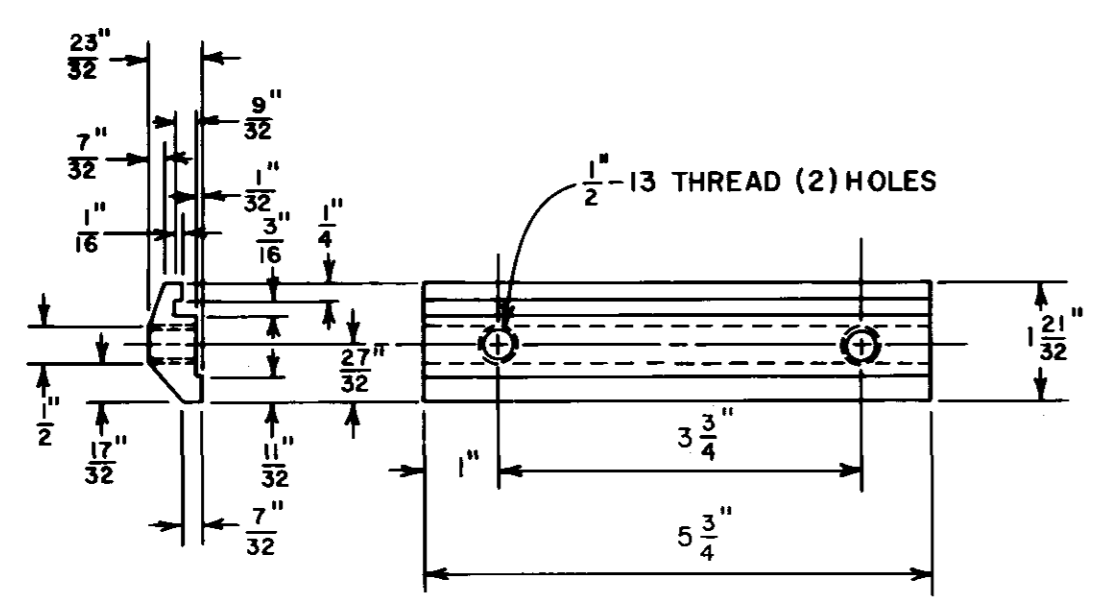


RAIL CLAMP BAR
 SCALE $\frac{3}{8}$ " = 1"

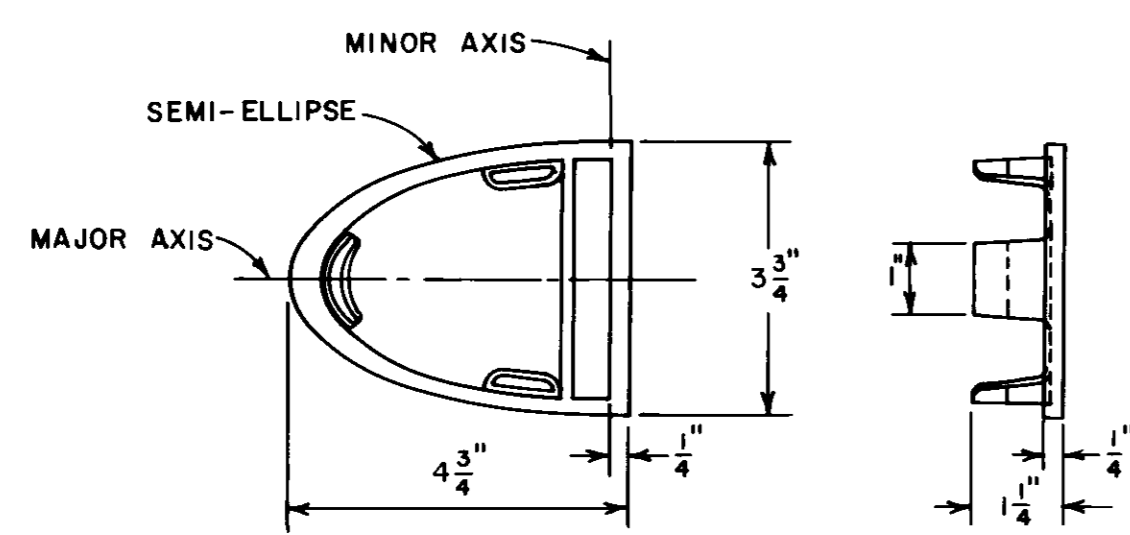


RAIL END CAP
 SCALE $\frac{3}{8}$ " = 1"

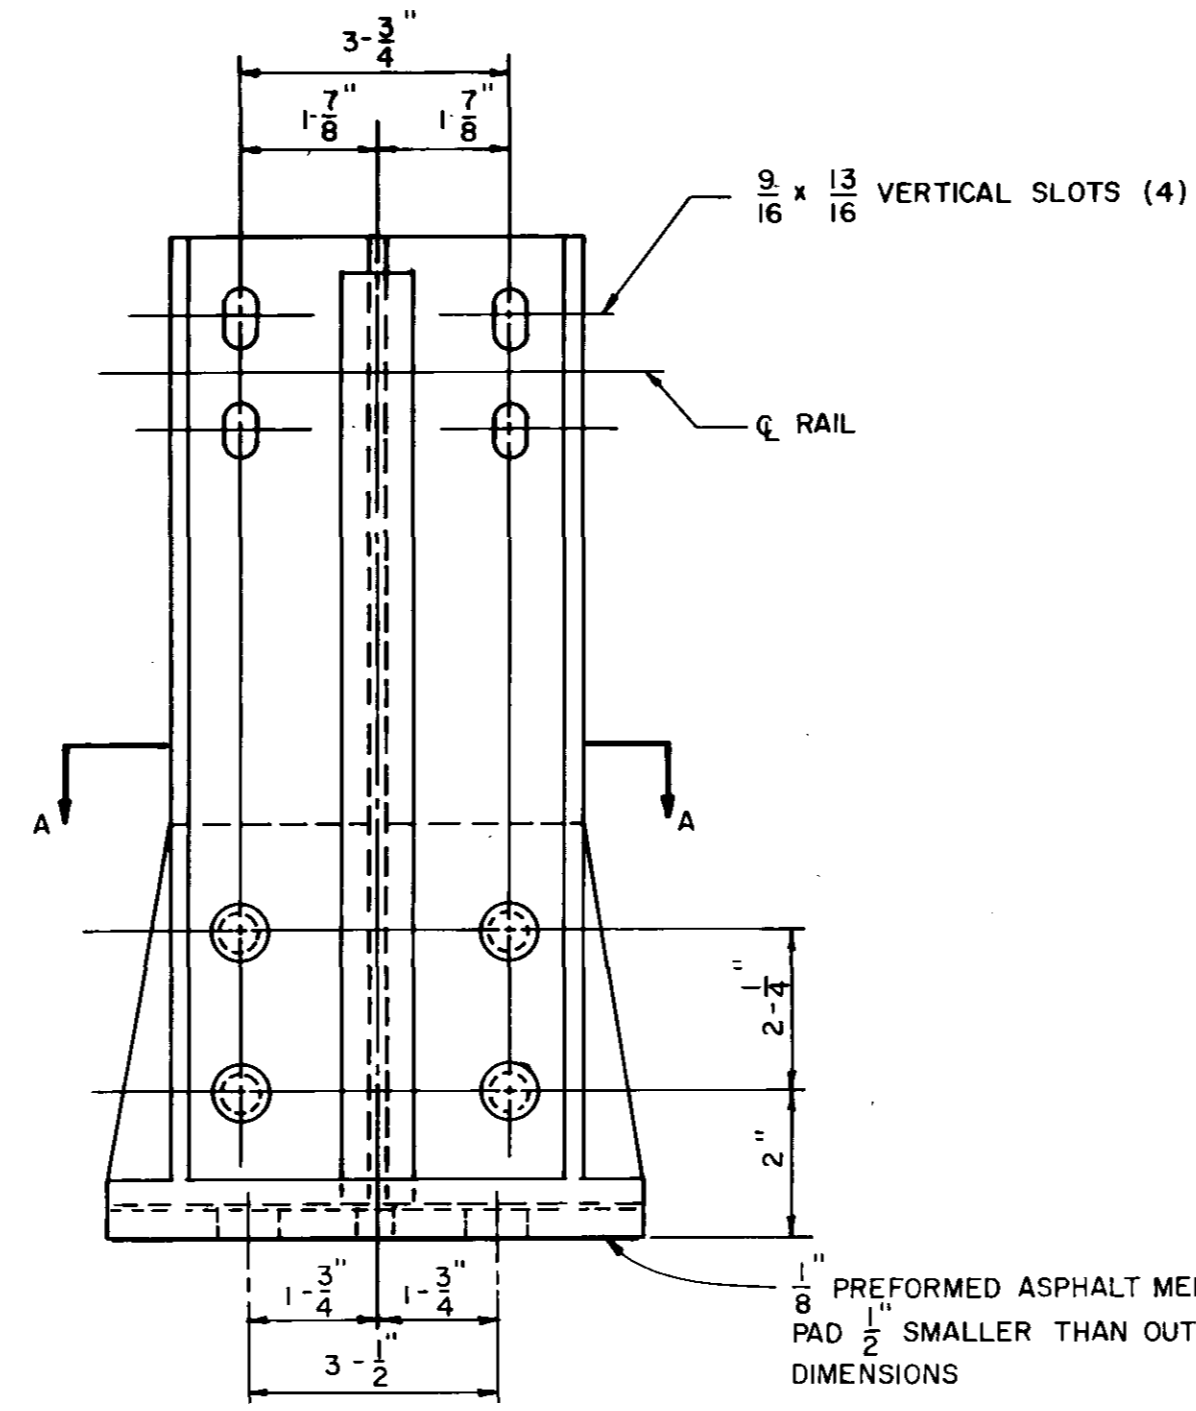


POST FRONT ELEVATION
 SCALE $\frac{3}{8}$ " = 1"

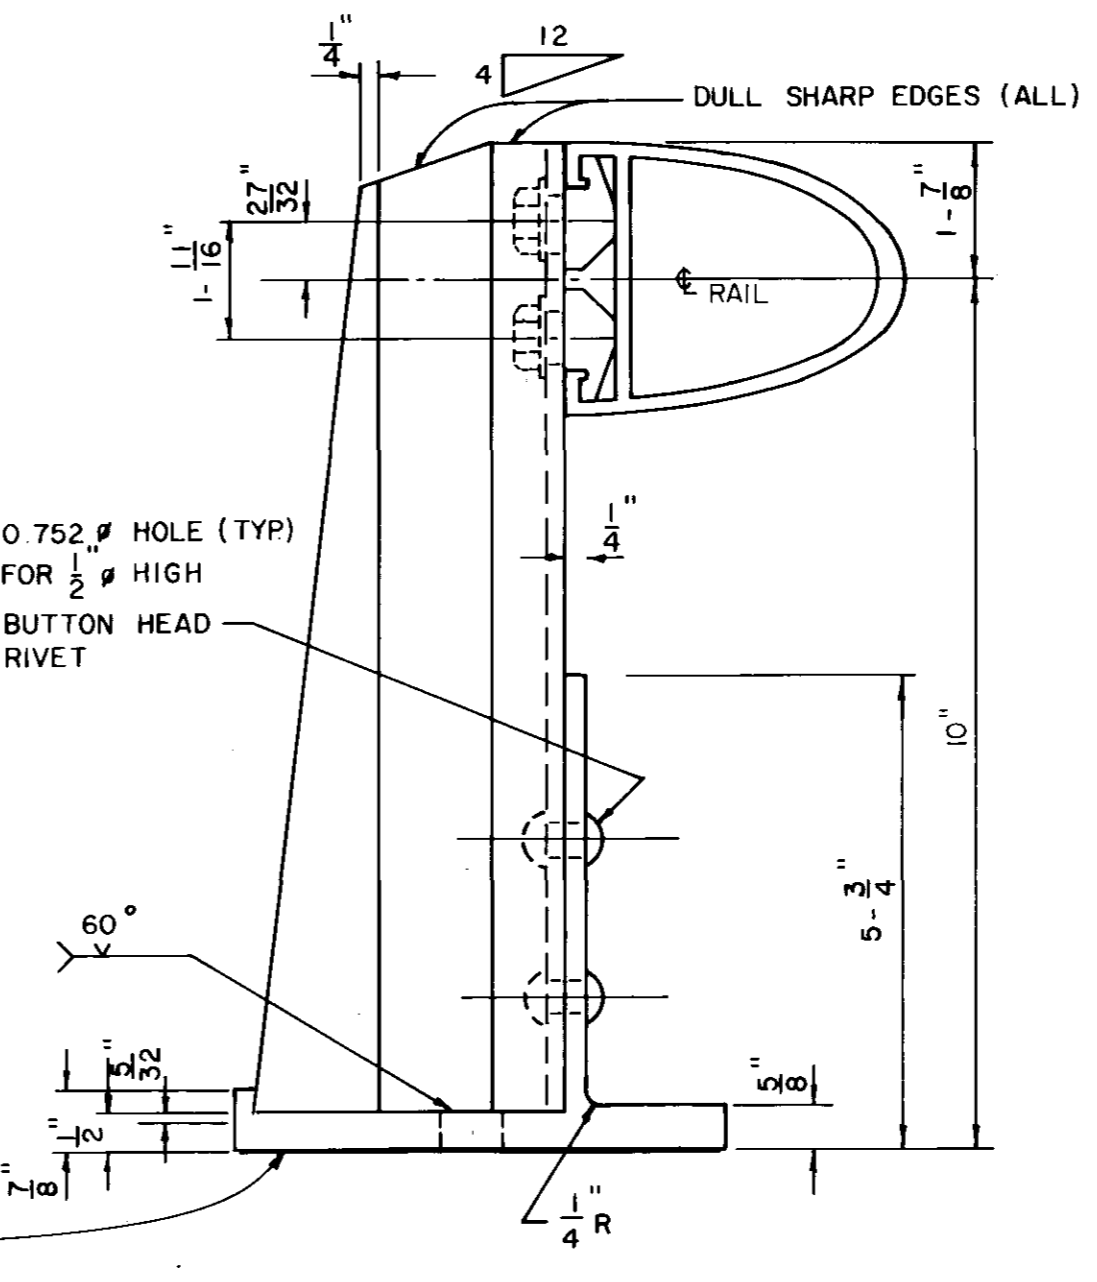

POST SIDE ELEVATION
 SCALE $\frac{3}{8}$ " = 1"

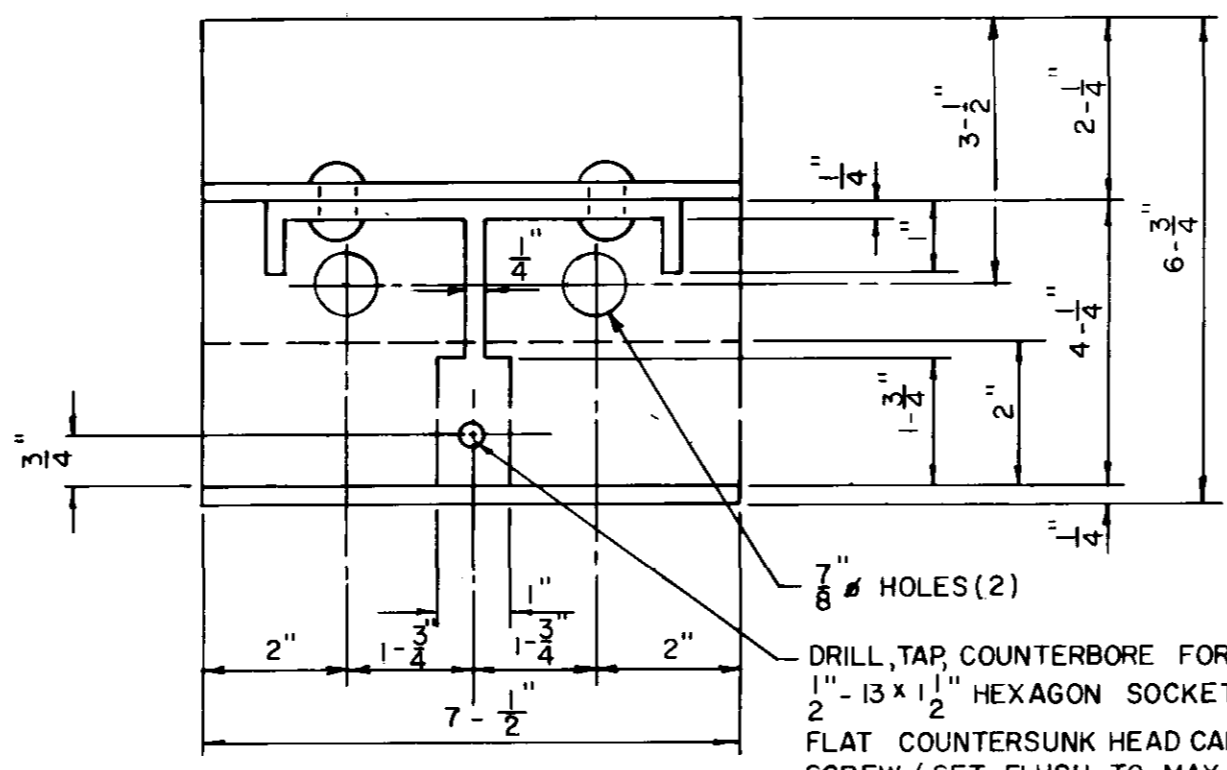

SECTION A-A
 SCALE $\frac{3}{8}$ " = 1"

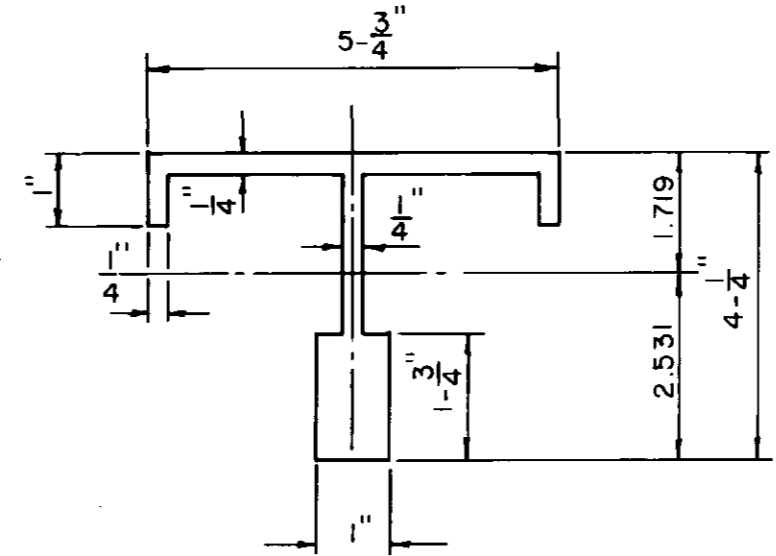

POST DETAIL
 SCALE $\frac{3}{8}$ " = 1"

AS - BUILT		
DATE	FB. NO	PAGE
Nov 16/77		


NOTES:

- ALUMINUM RAILS, POSTS, SPLICE BARS, CLAMP BARS, AND RAIL SPACERS SHALL BE ASTM B221, ALLOY 6061-T6
- CAP SCREWS AND ANCHOR BOLT ASSEMBLY (STUD, NUT AND WASHER) SHALL CONFORM TO ASTM A276, TYPE 430 STAINLESS STEEL
- MISCELLANEOUS STEEL AS REQUIRED SHALL CONFORM TO CSA G4021 38W
- THE BOTTOM OF POSTS SHALL BE PAINTED WITH ONE COAT OF ZINC CHROMATE PRIMER


ISSUED FOR TENDER 4-4-77

<p>THE CITY OF WINNIPEG WORKS & OPERATIONS DEPARTMENT STREETS & TRANSPORTATION DIVISION</p> <p>W.L. WARDROP & ASSOCIATES LTD. ENGINEERING CONSULTANTS WINNIPEG - THUNDER BAY - REGINA - BARRIE - EDMONTON</p>	<p>ROUTE 165</p>		<p>SCALE: AS SHOWN</p>
	<p>TRAFFIC RAIL DETAILS</p>		
<p>APPROVED BY: <i>[Signature]</i> DATE 25 MAR 77</p> <p>DRAWN BY: DAP DATE MAR 77</p> <p>PRELIM. CHK. CHECK</p>	<p>DESIGN DATE</p>	<p>APPROVED BY: <i>[Signature]</i> DATE 25/3/77</p> <p>MANAGER OF STREETS AND TRAFFIC</p>	<p>DRAWING NO. B-5092-239</p>


10 INCHES
9
8
7
6
5
4
3
2
1
0

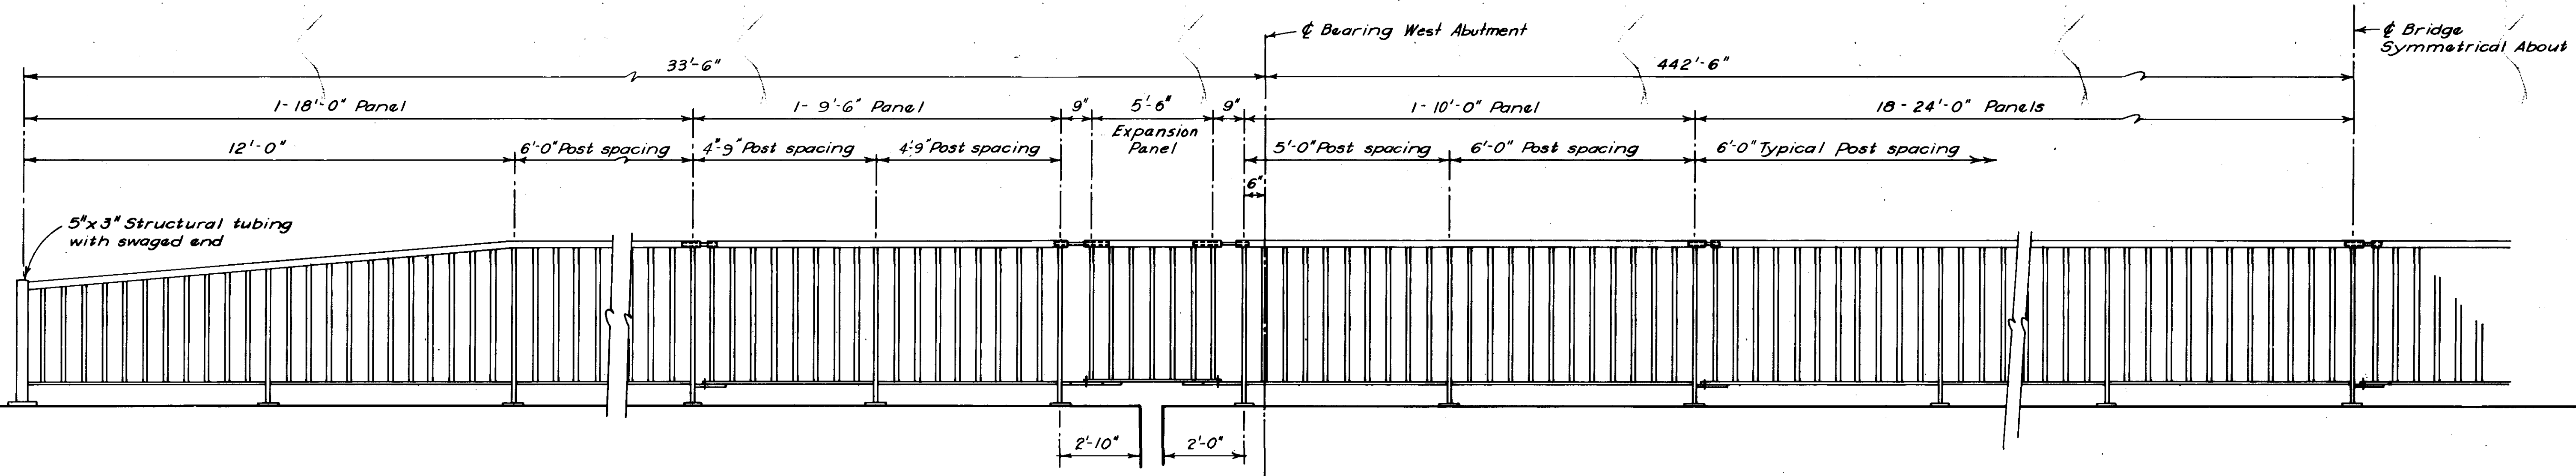


ELEVATION OF PEDESTRIAN HANDRAIL SOUTH BRIDGE
LOOKING DOWNSTREAM
Scale: 1/2" = 1'-0"

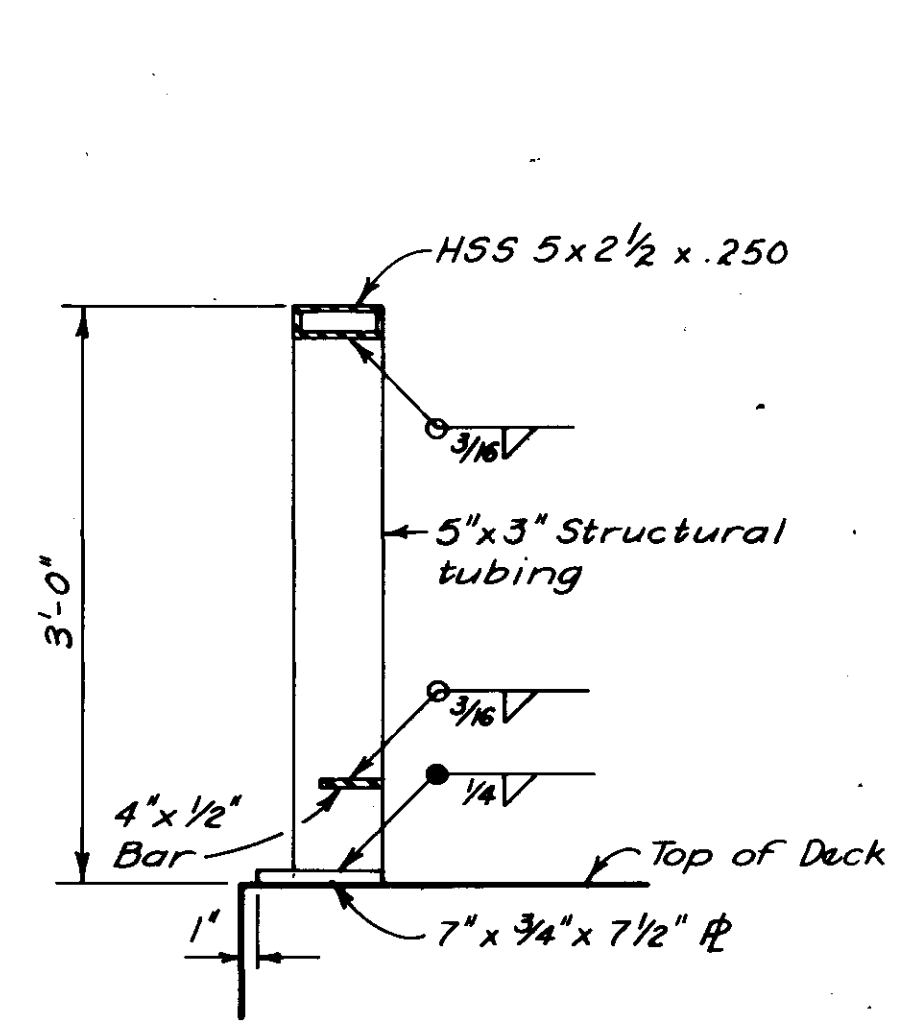


END POST
Scale: 1" = 1'-0"

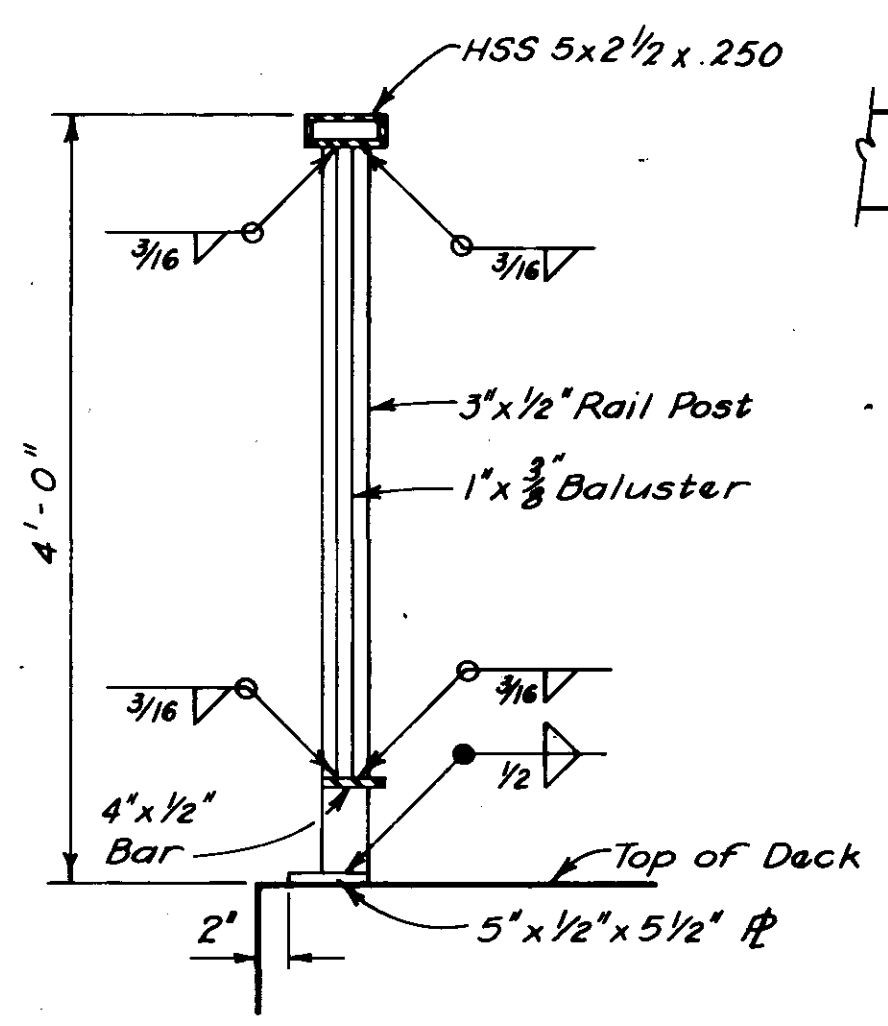


TYPICAL RAIL POST
Scale: 1" = 1'-0"

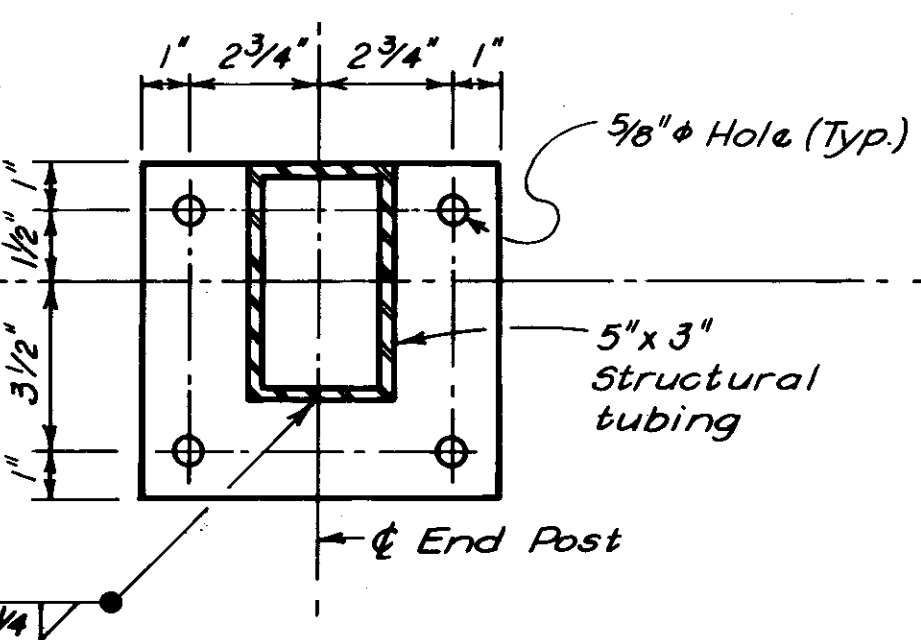


HANDRAIL BASE PLATE DETAILS
Scale: 3" = 1'-0"

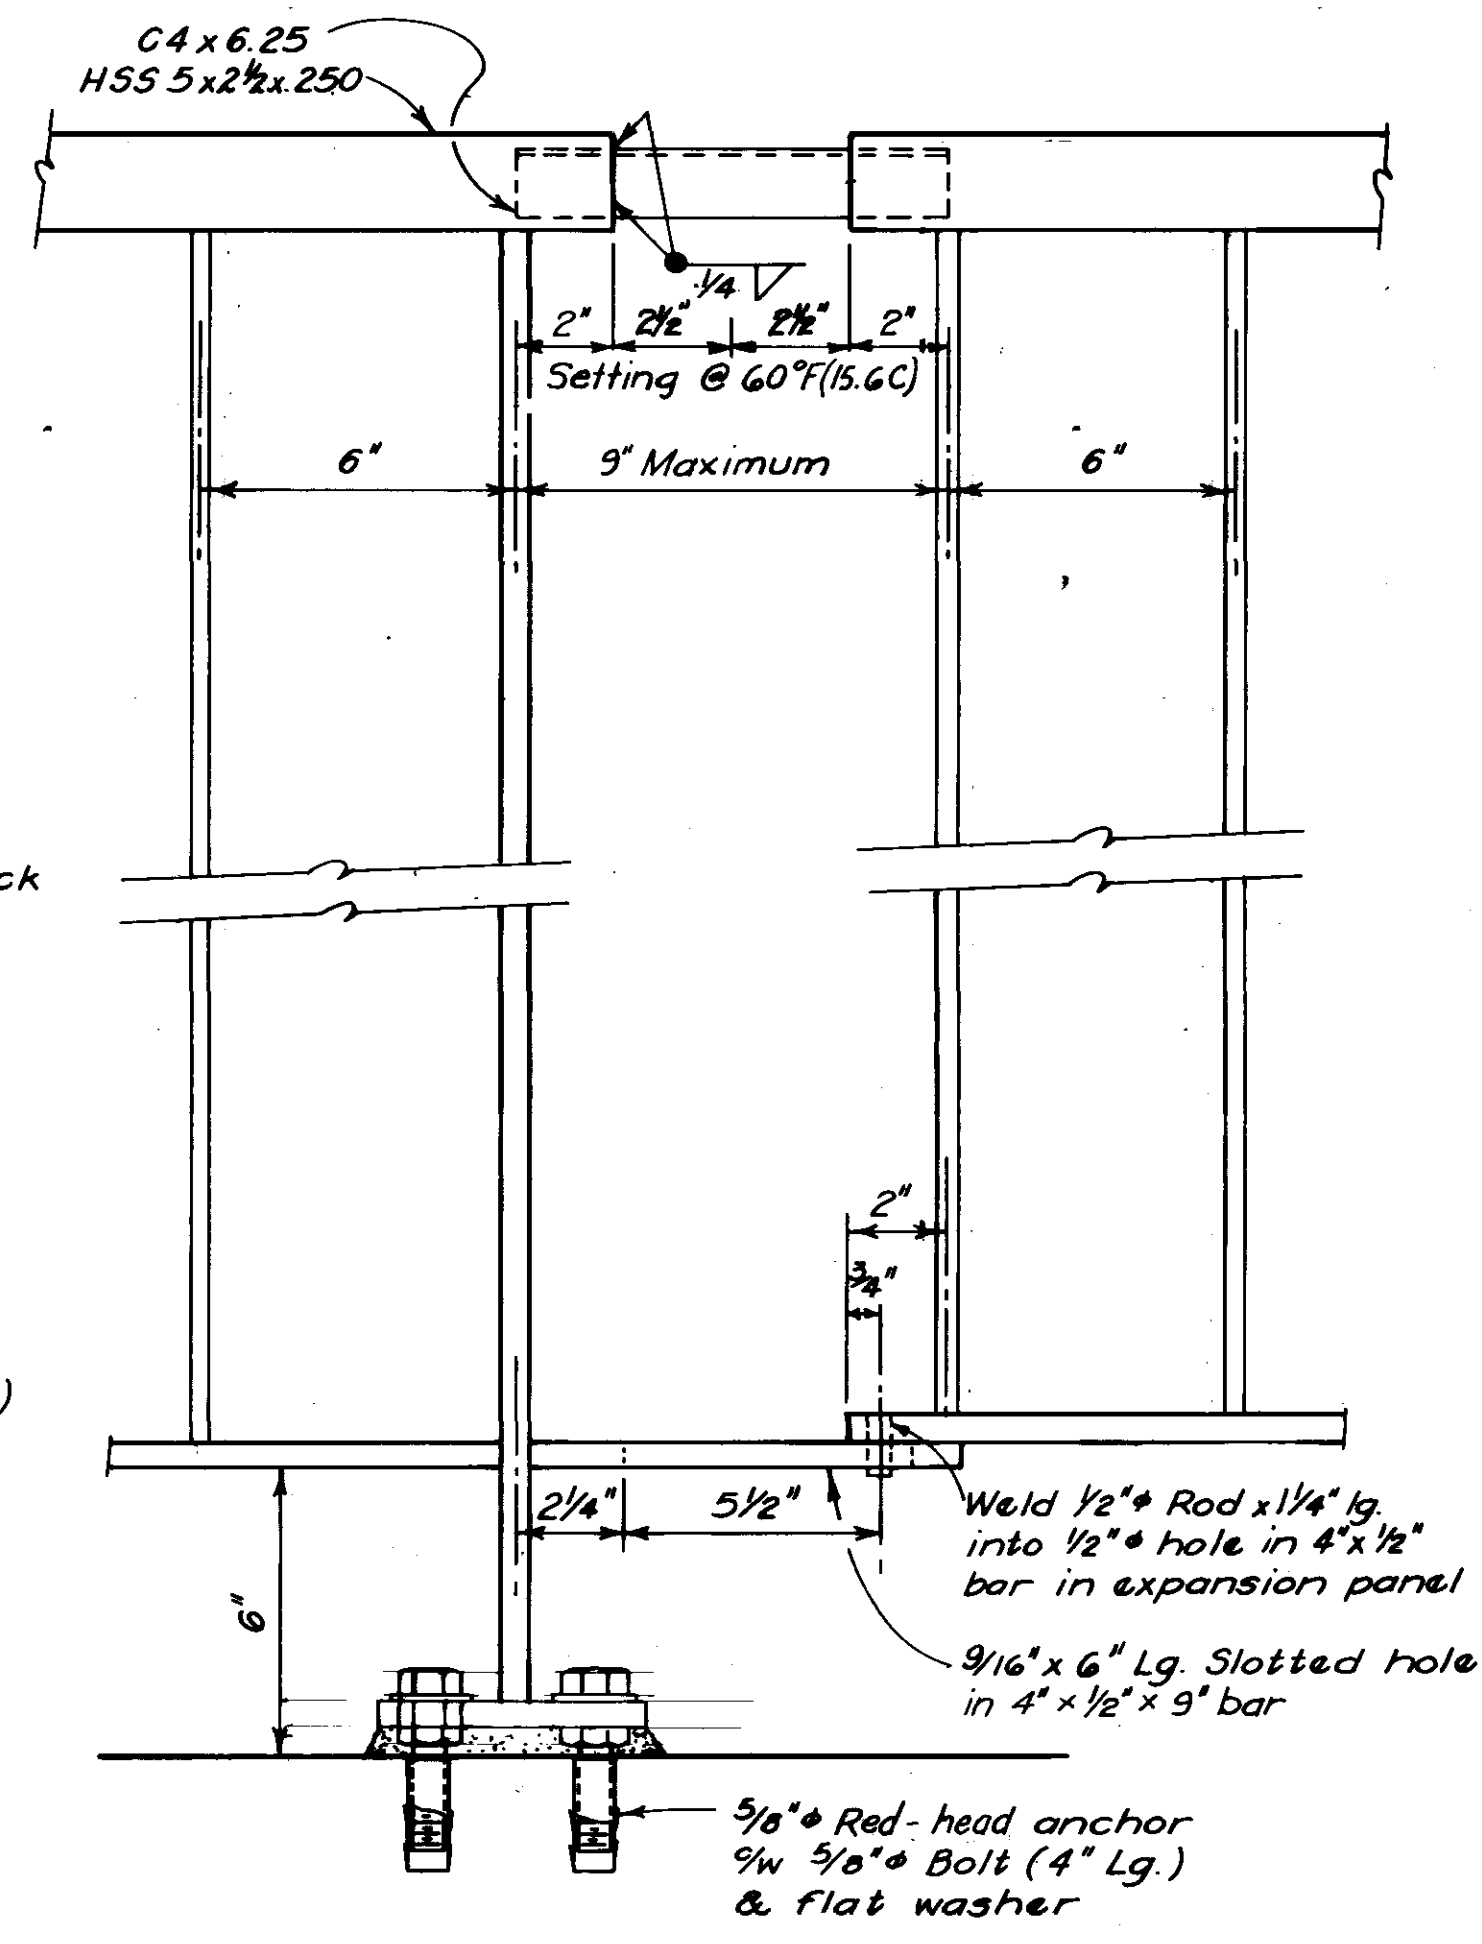

EXPANSION JOINT DETAIL
Scale: 3" = 1'-0"

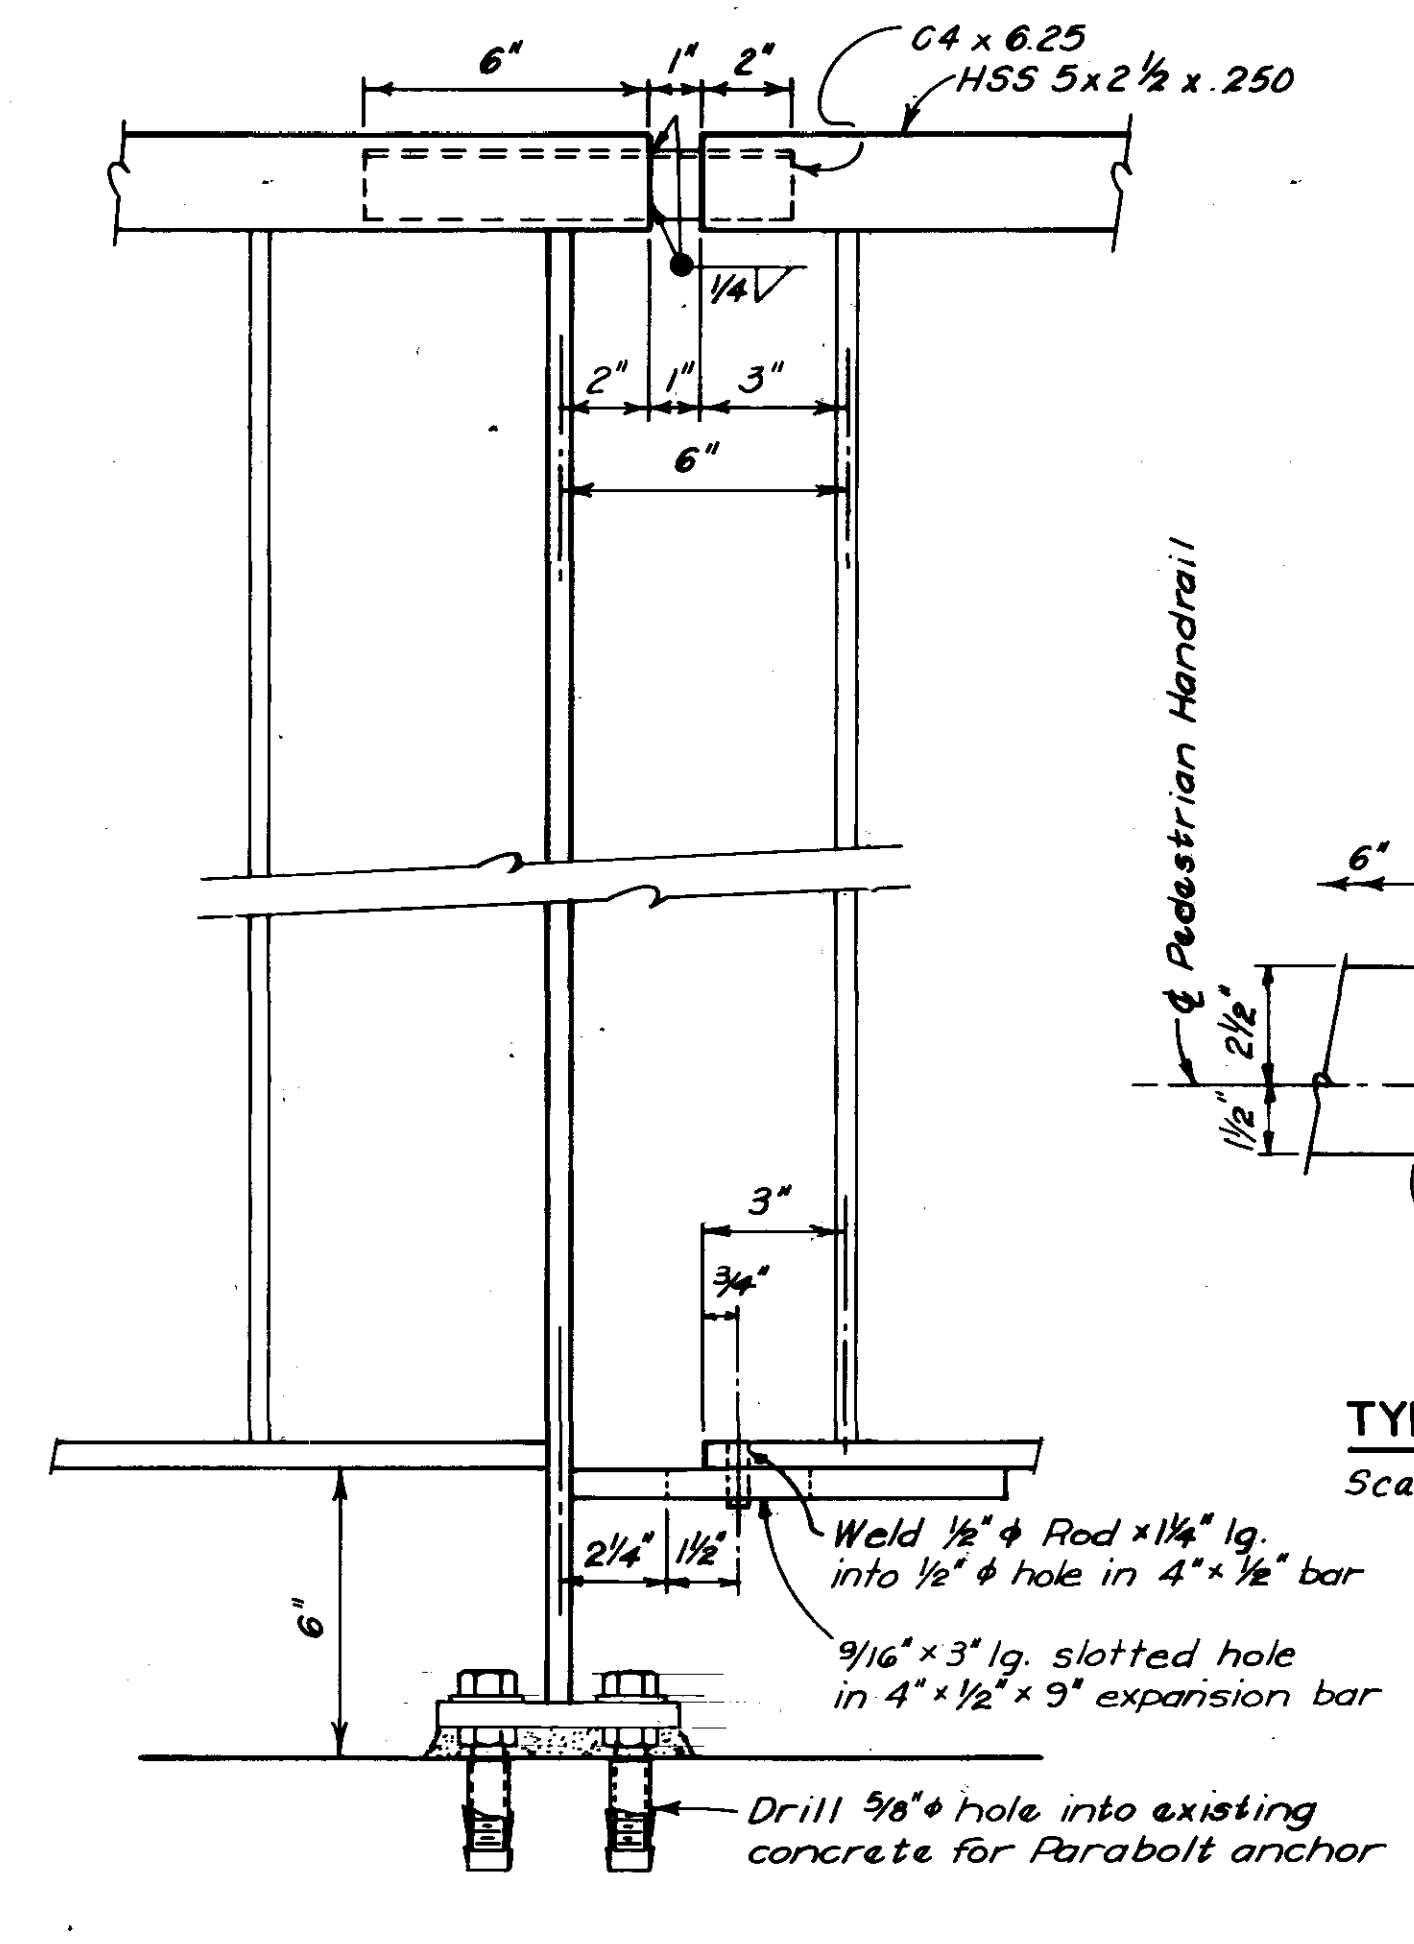

JOINT DETAIL
Scale: 3" = 1'-0"

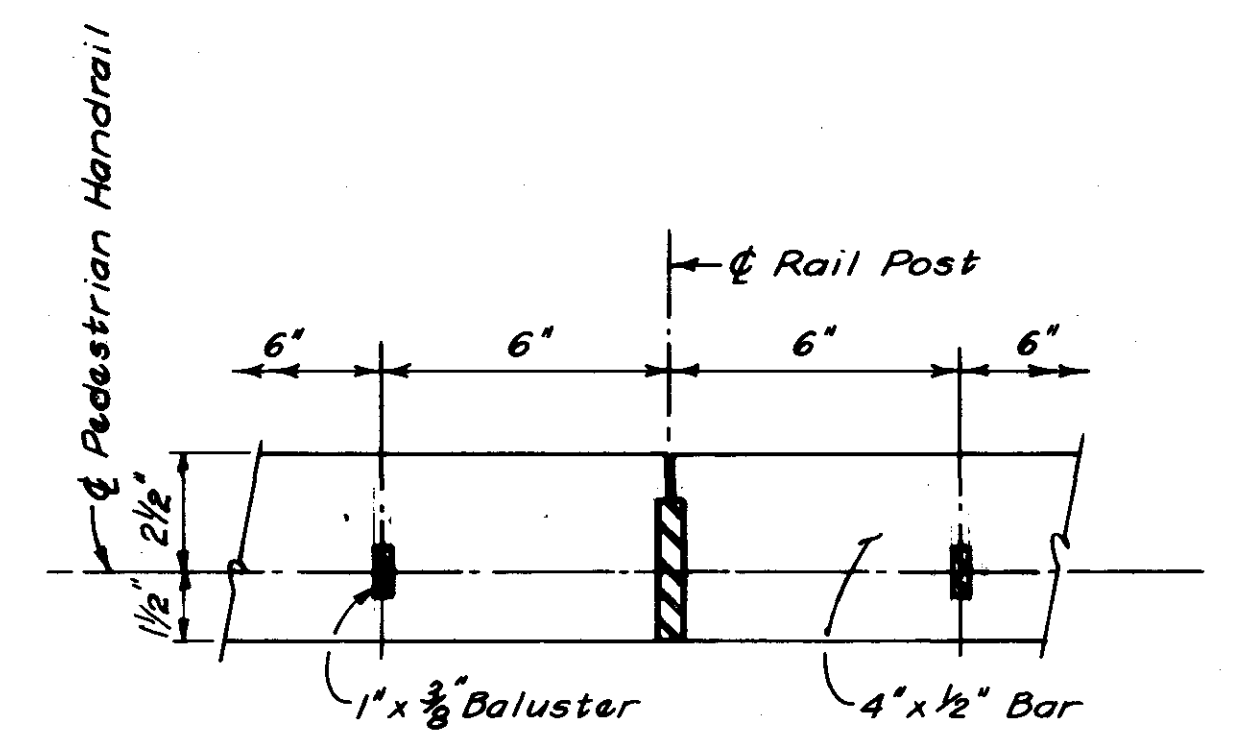


TYPICAL ARRANGEMENT OF BALUSTERS
Scale: 3" = 1'-0"

AS - BUILT		
DATE	FB. NO.	PAGE
Nov 14/70		


NO.	ISSUED FOR TENDER	DATE	BY
		4-4-77	
NO.	REVISIONS	DATE	BY

	THE CITY OF WINNIPEG WORKS & OPERATIONS DEPARTMENT STREETS & TRANSPORTATION DIVISION W.L. WARDROP & ASSOCIATES LTD. ENGINEERING CONSULTANTS WINNIPEG - THUNDER BAY - REGINA - EDMONTON	ROUTE 165 PEDESTRIAN HANDRAIL DETAILS	SCALE: AS SHOWN
	APPROVED BY: <i>[Signature]</i> DATE: 25 JAN 77 DRAWN BY: GAN DATE: 24/1/77 PRELIM. CHK: EUS DATE: 4/1/77 DESIGN: D.L.M. DATE: 9/6/76 CHECK: R.W.S. DATE: 1/10/77	APPROVED BY: <i>[Signature]</i> DATE: 28/1/77 MANAGER OF STREETS AND TRAFFIC	DRAWING NO. B-5092-240


10 INCHES
9
8
7
6
5
4
3
2
1
0

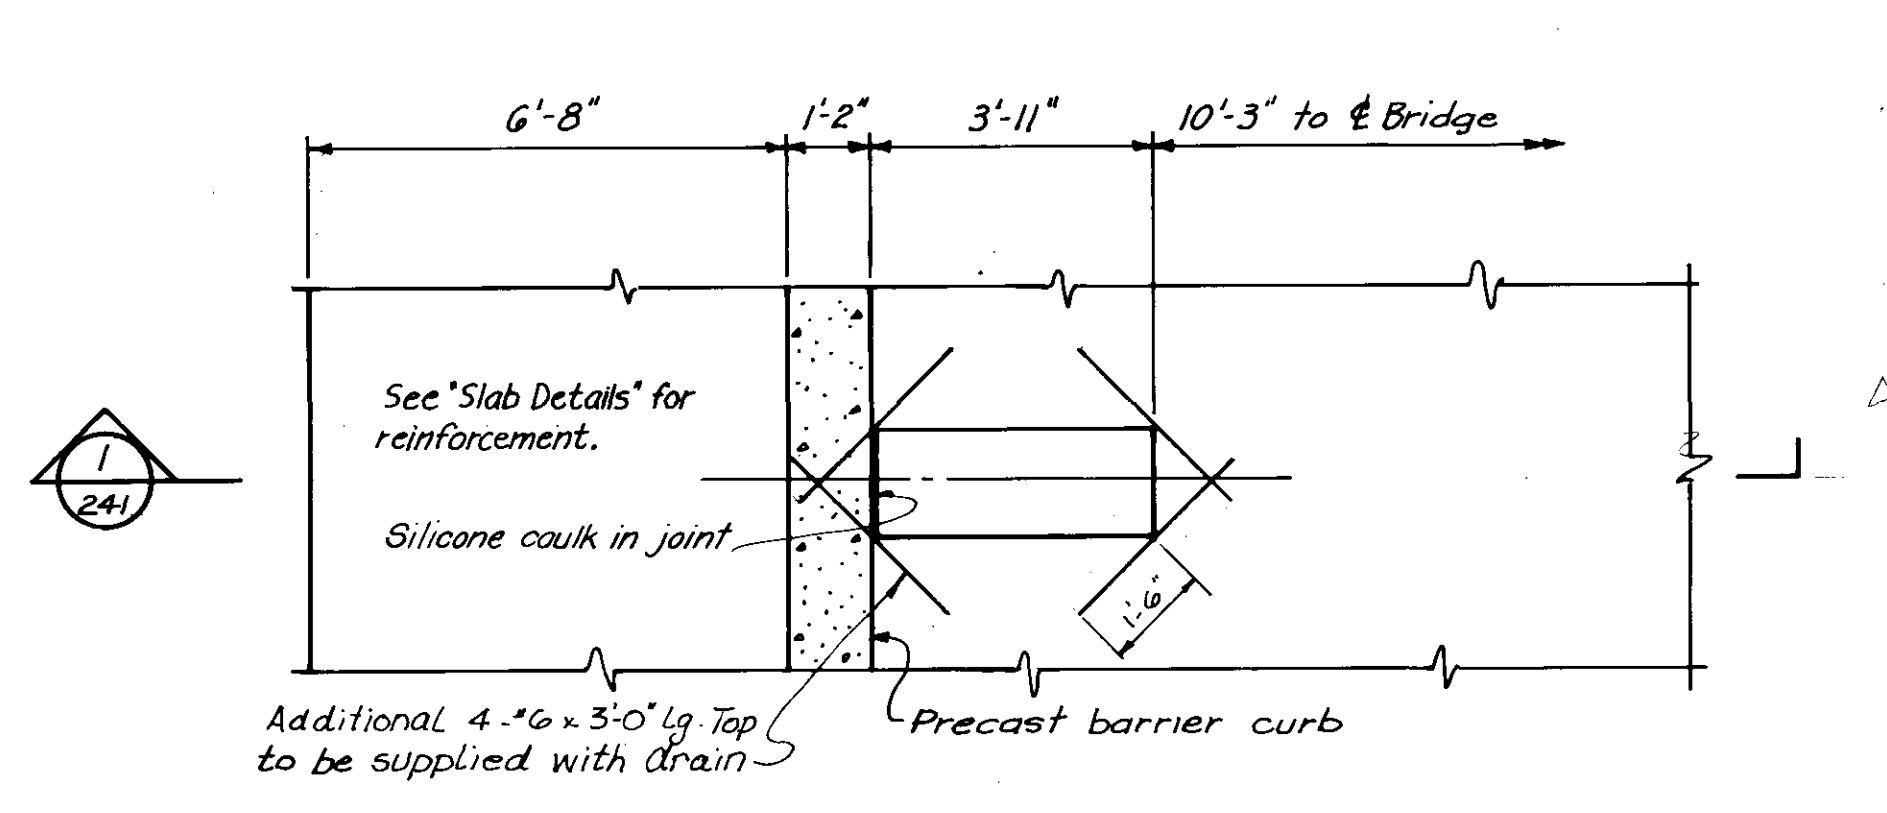


PART PLAN - SOUTH BRIDGE

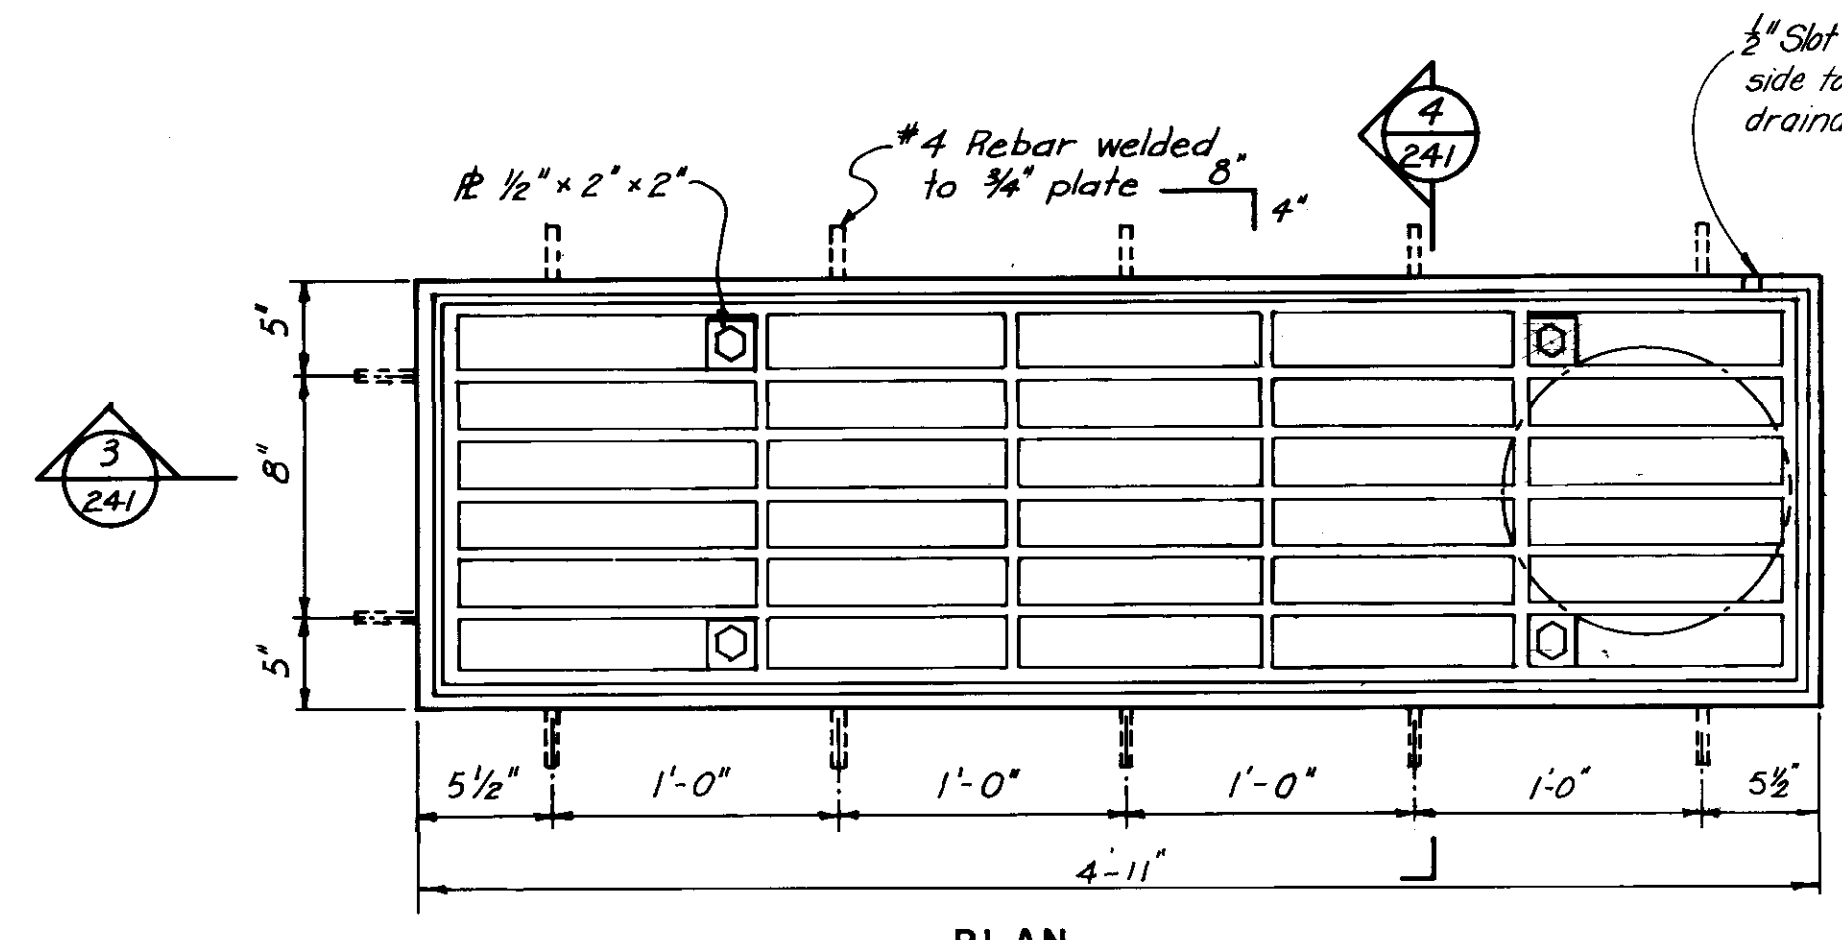


PLAN

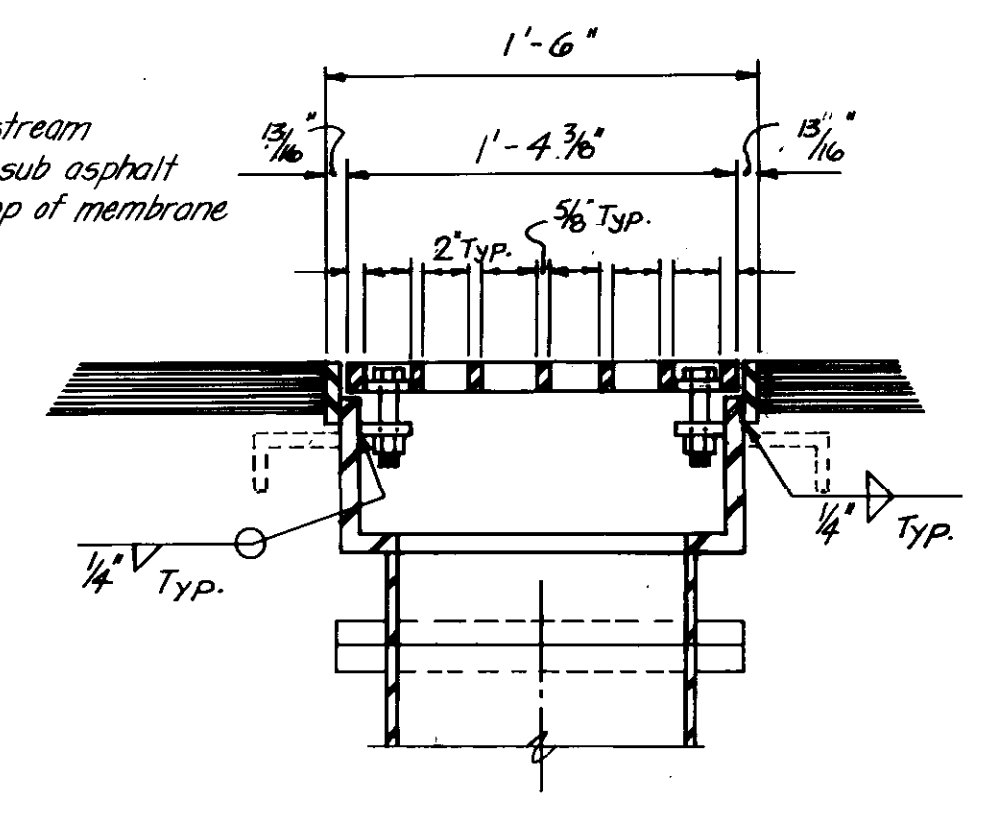

SECTION 4
241 Scale 1 1/2"=1'-0"

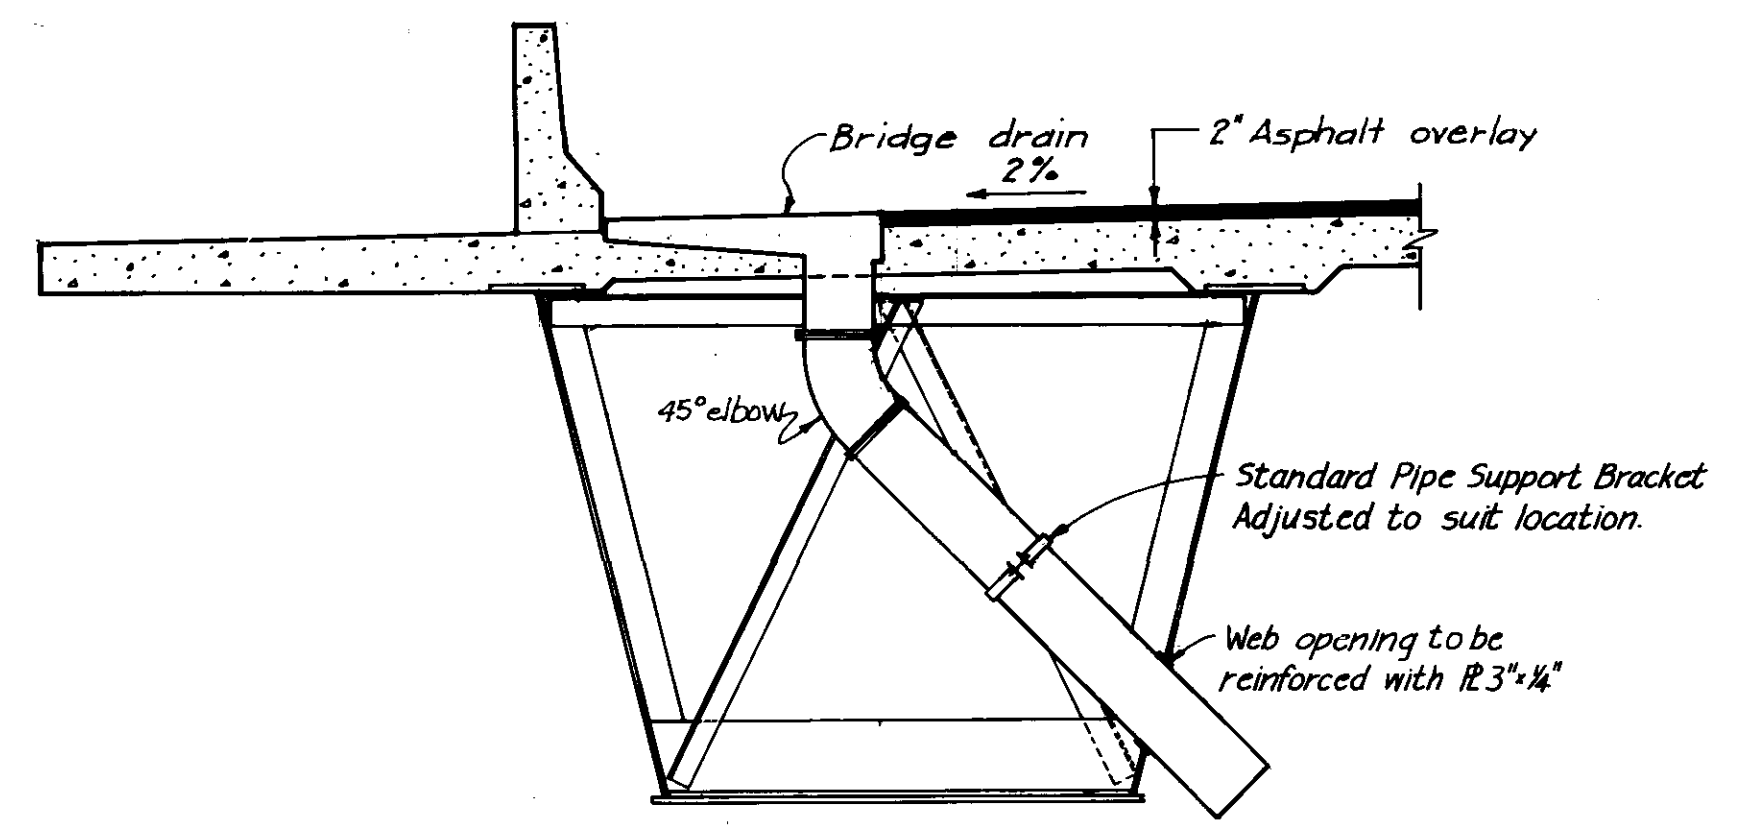

SECTION 1
241 Scale: 3/8"=1'-0"

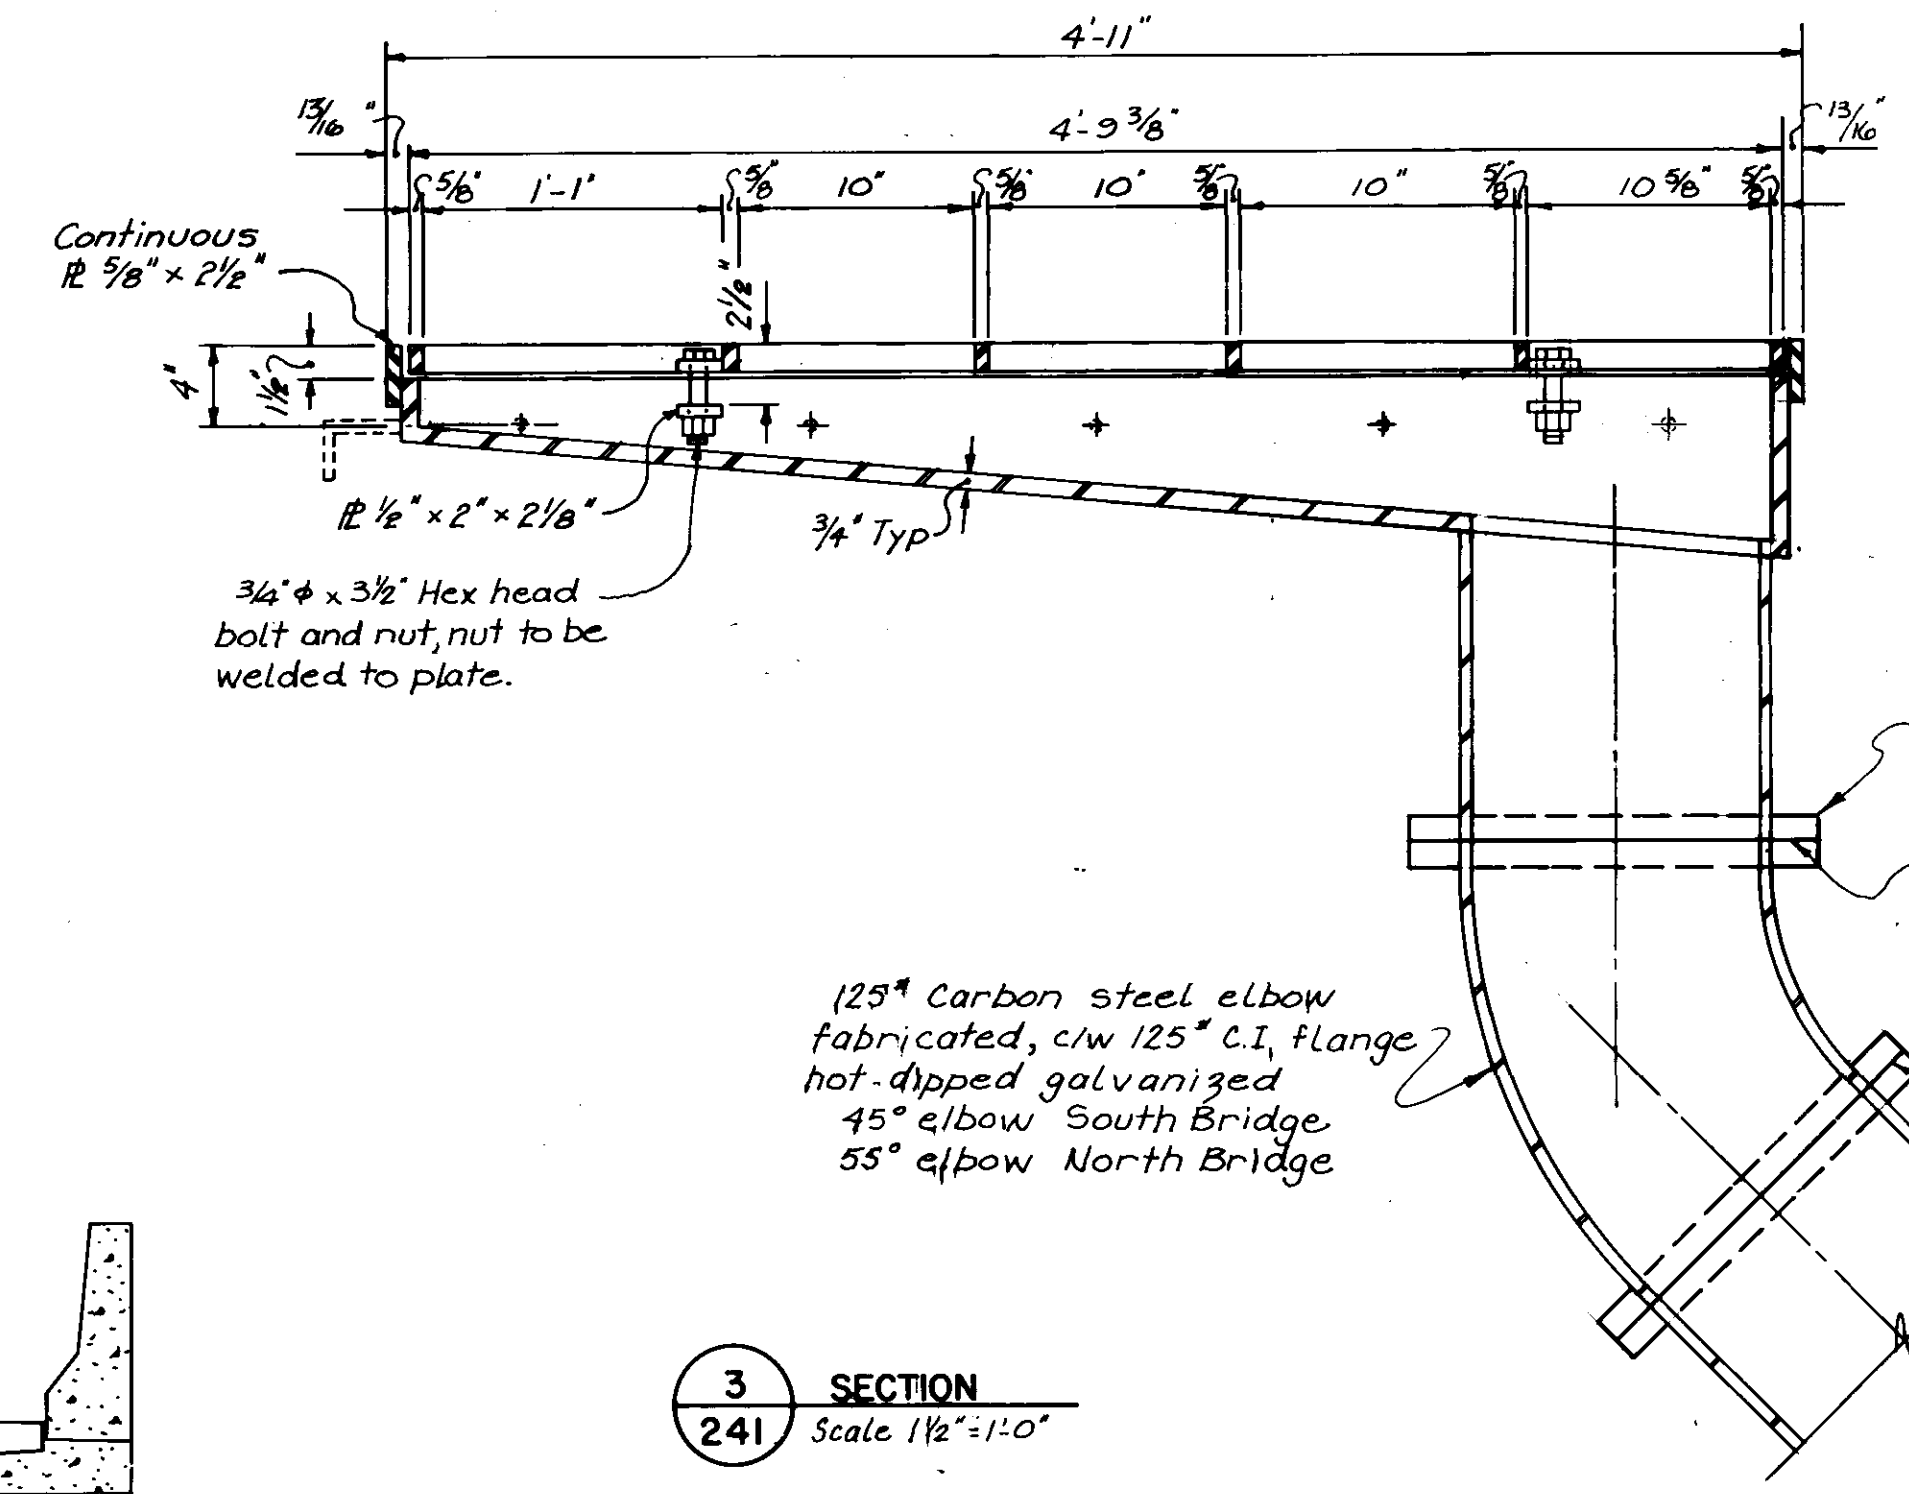

SECTION 3
241 Scale 1 1/2"=1'-0"

A SA 125" steel flange welded to pipe nuts welded to flange, hot dip galvanize after fabrication

1/8" Full face red rubber gasket Shim ring

125" Carbon steel elbow fabricated, c/w 125" C.I. flange hot-dipped galvanized


45 degree elbow South Bridge

55 degree elbow North Bridge


1/8" Full face red rubber gasket

12" Class 2 ductile iron pipe c/w 125" C.I. flange

AS-BUILT
Nov 14/79

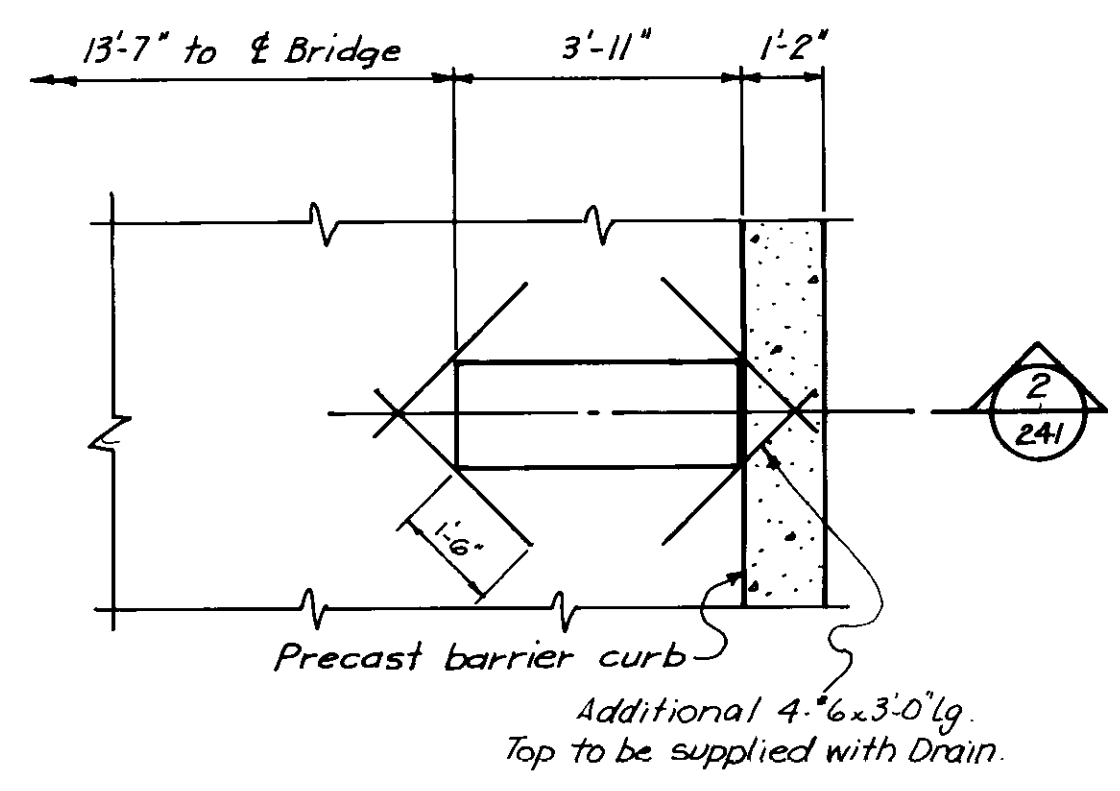

PART PLAN - NORTH BRIDGE

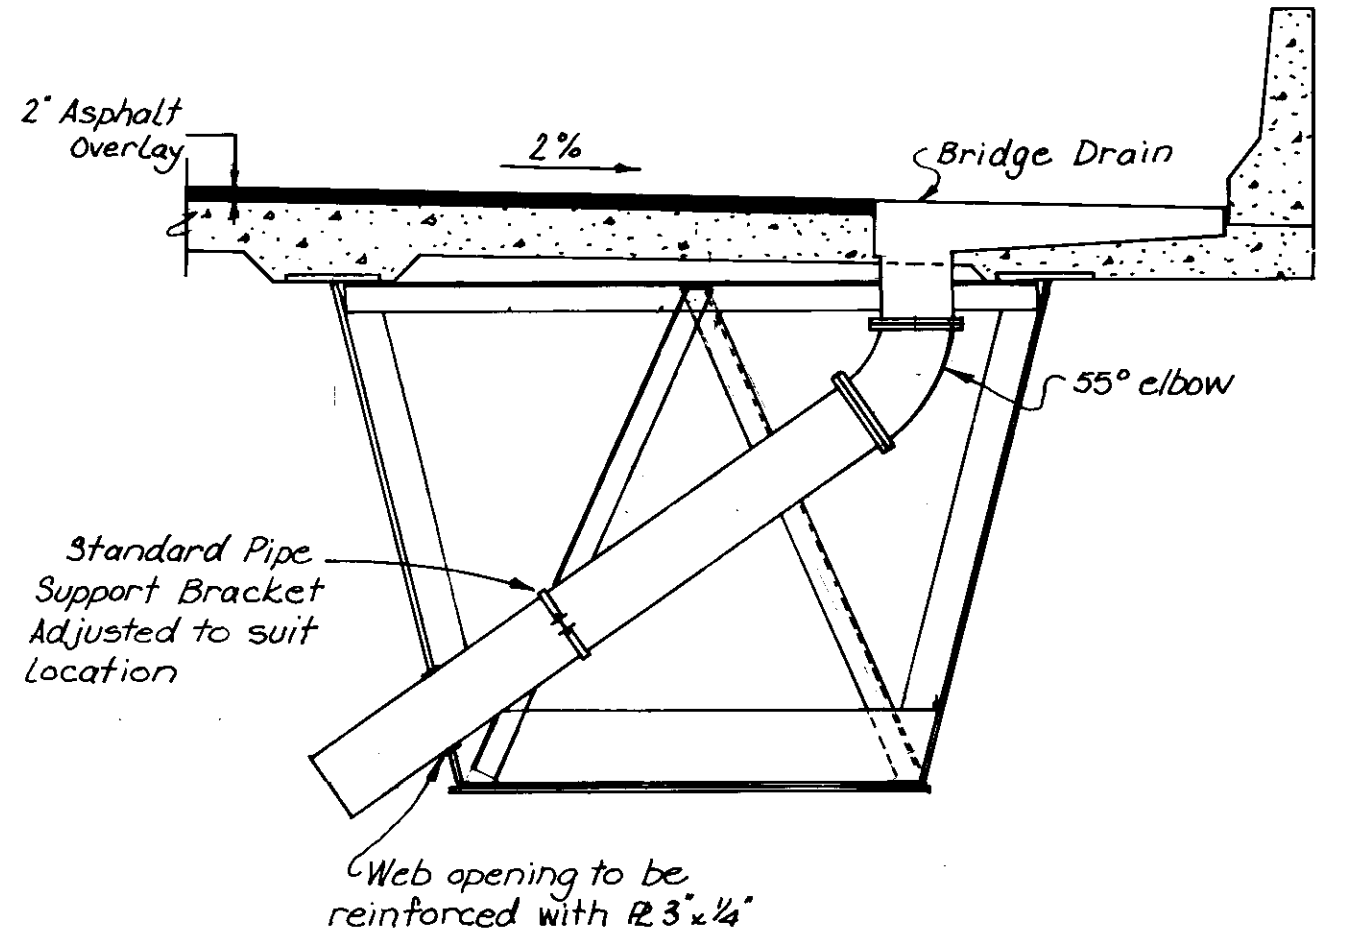

SECTION 2
241 Scale: 3/8"=1'-0"

Note:
Cut and replace Slab Top Bars to suit Drain.

Notes:
1. Bridge drains shall be fabricated from ASTM A588 or CSA G 40.21 50A steel and galvanized in accordance with ASTM A123.
2. Bolts shall be placed in nuts prior to galvanizing to protect threads.

NO.	ISSUED FOR TENDER	4.4.77	DATE	BY
NO.	REVISIONS		DATE	BY

THE CITY OF WINNIPEG
WORKS & OPERATIONS DEPARTMENT
STREETS & TRANSPORTATION DIVISION

W.L. WARDROP & ASSOCIATES LTD.
ENGINEERING CONSULTANTS
WINNIPEG - THUNDER BAY - REGINA - SASKATOON

APPROVED BY: *[Signature]* DATE 25/12/77

DRAWN BY: J.T.K. DATE DEC. 76
PRELIM. CHK.: S.T.K. DATE JAN. 77

DESIGN: S.T.K. DATE DEC. 76
CHECK: D.L.M. DATE JAN. 77

ROUTE 165


BRIDGE DRAIN DETAILS

SCALE: AS SHOWN

DRAWING NO. B-5092-241



APPROVED BY: *[Signature]* DATE 25/12/77
MANAGER OF STREETS AND TRAFFIC

110 INCHES
19
18
17
16
15
14
13
12
11
10

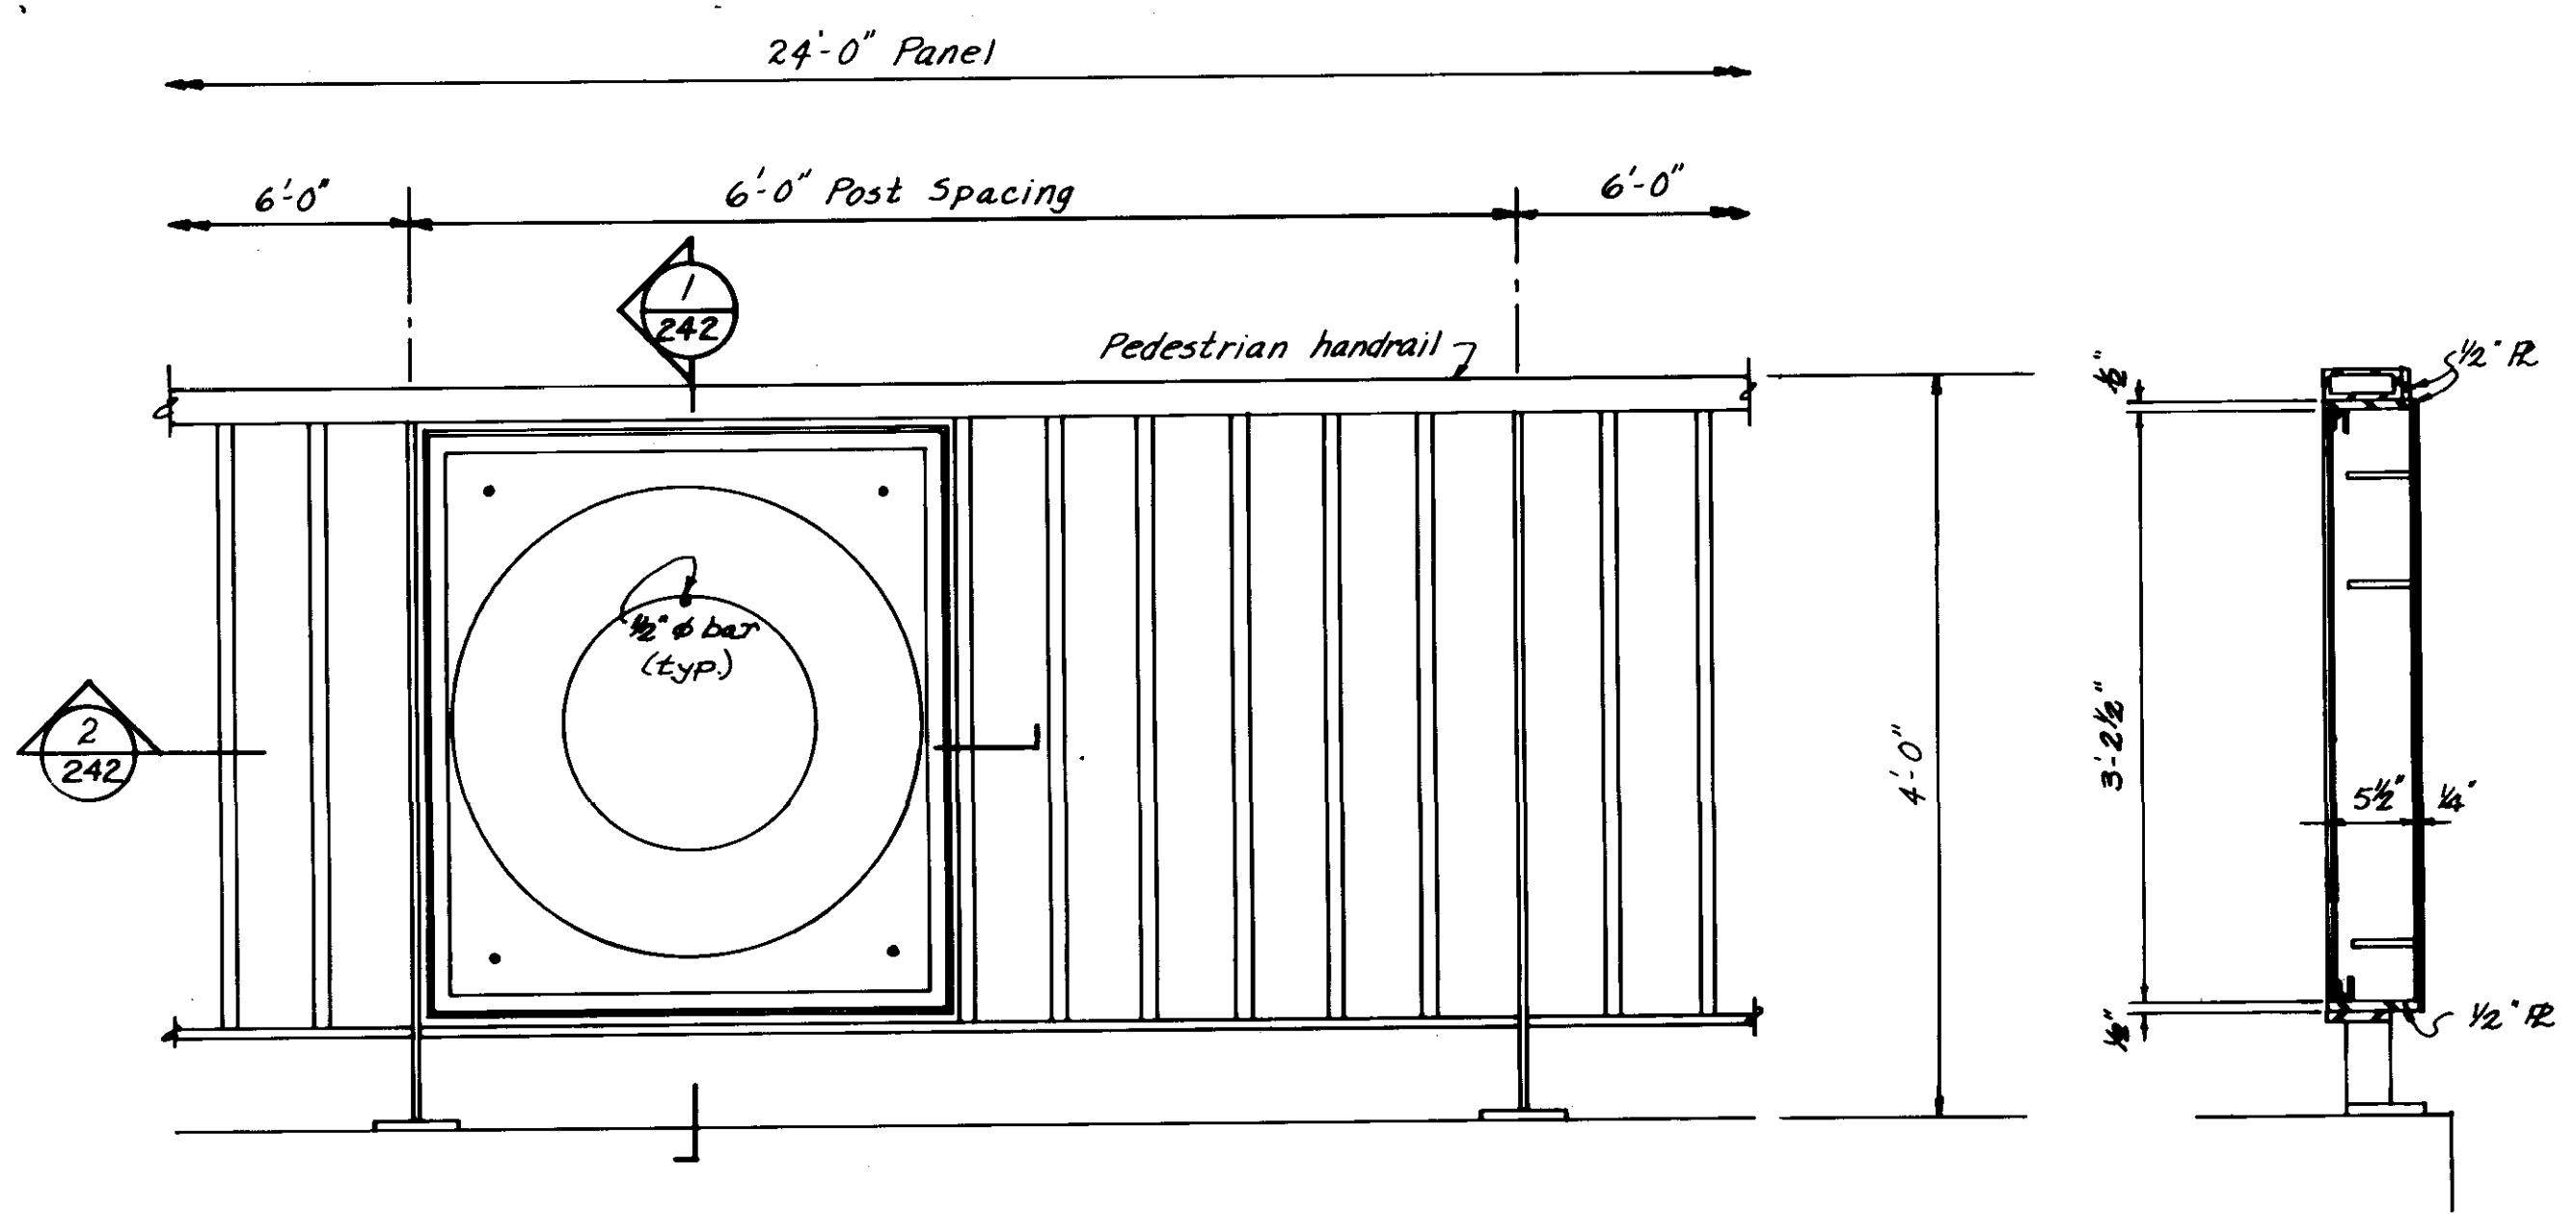


ELEVATION OF LIFE PRESERVER BOX
Scale: 1"=1'-0"

SECTION
Scale: 1"=1'-0"

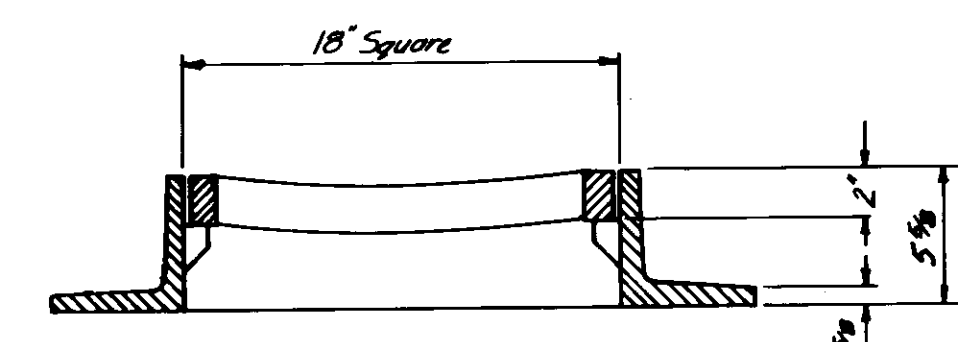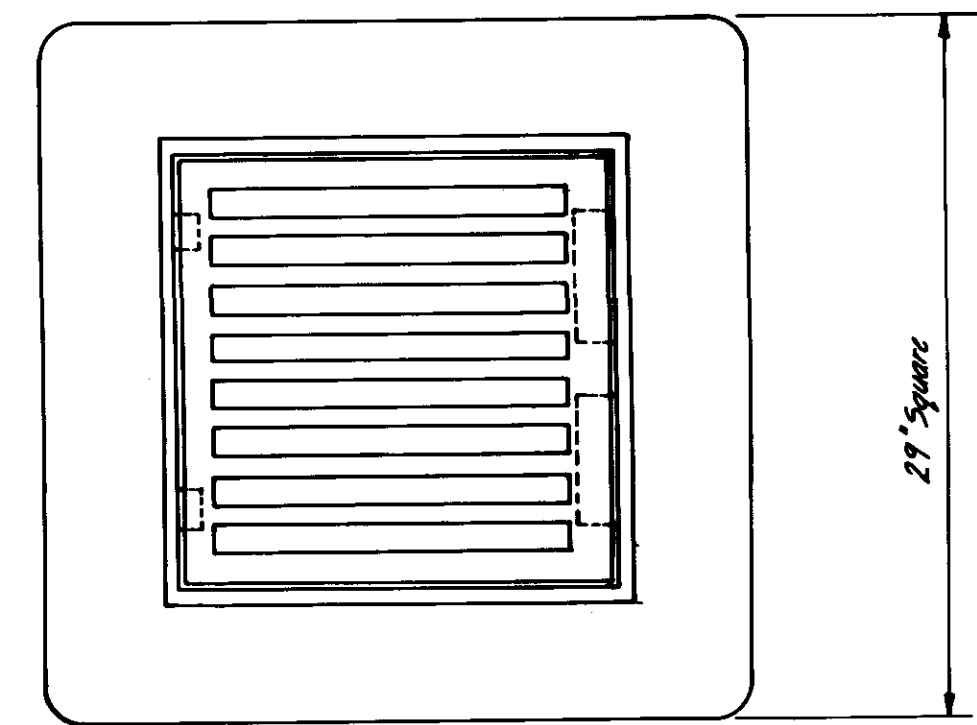


Frame Patt. M-51B-F
Cover Patt. M-51B
Frame Wt. 169 Lbs.
Frame Wt. 60 Lbs.

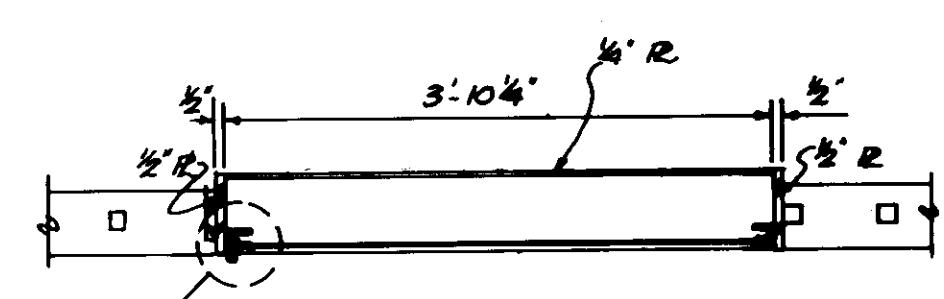


See hinge detail
this sheet


SECTION
Scale: 1"=1'-0"

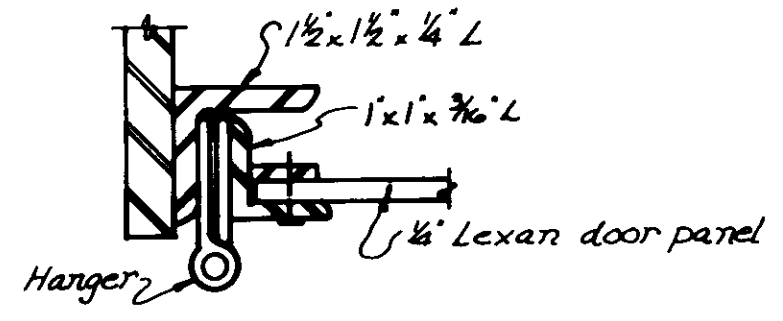

HINGE DETAIL
Scale: Half full size

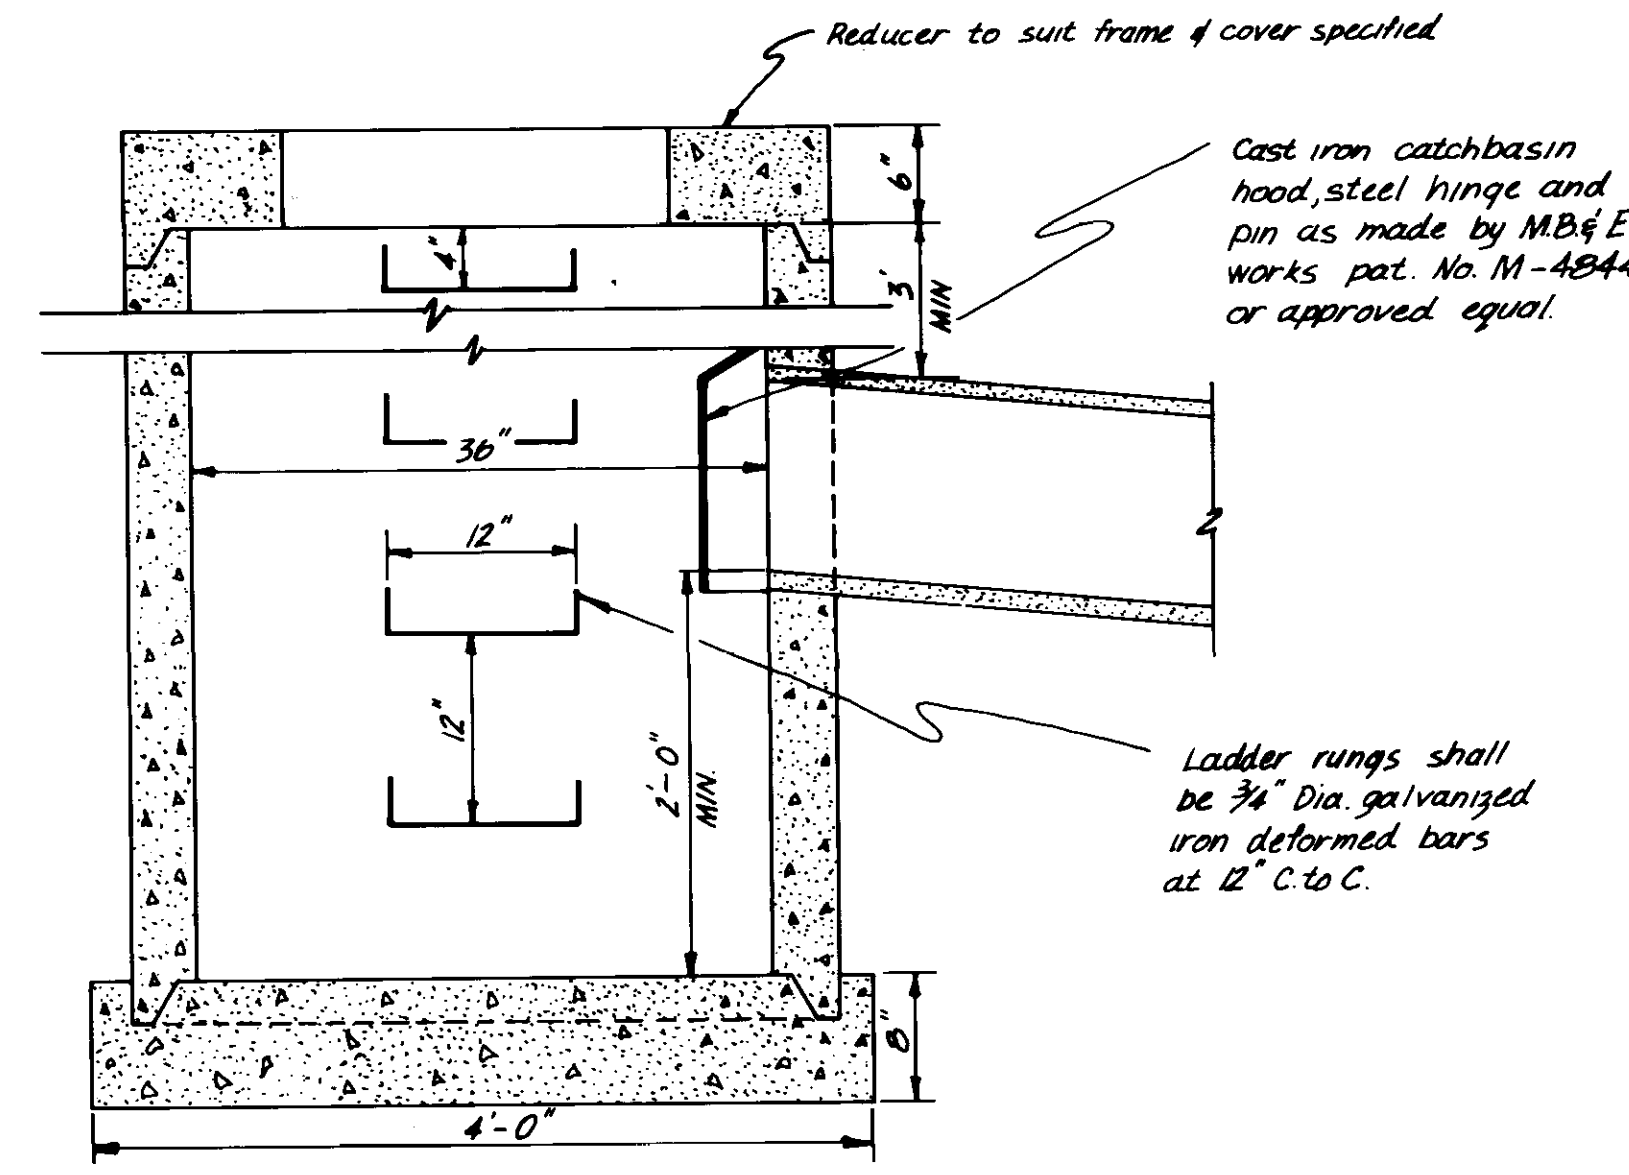

CATCHBASIN DETAIL
Scale 1"=1'-0"


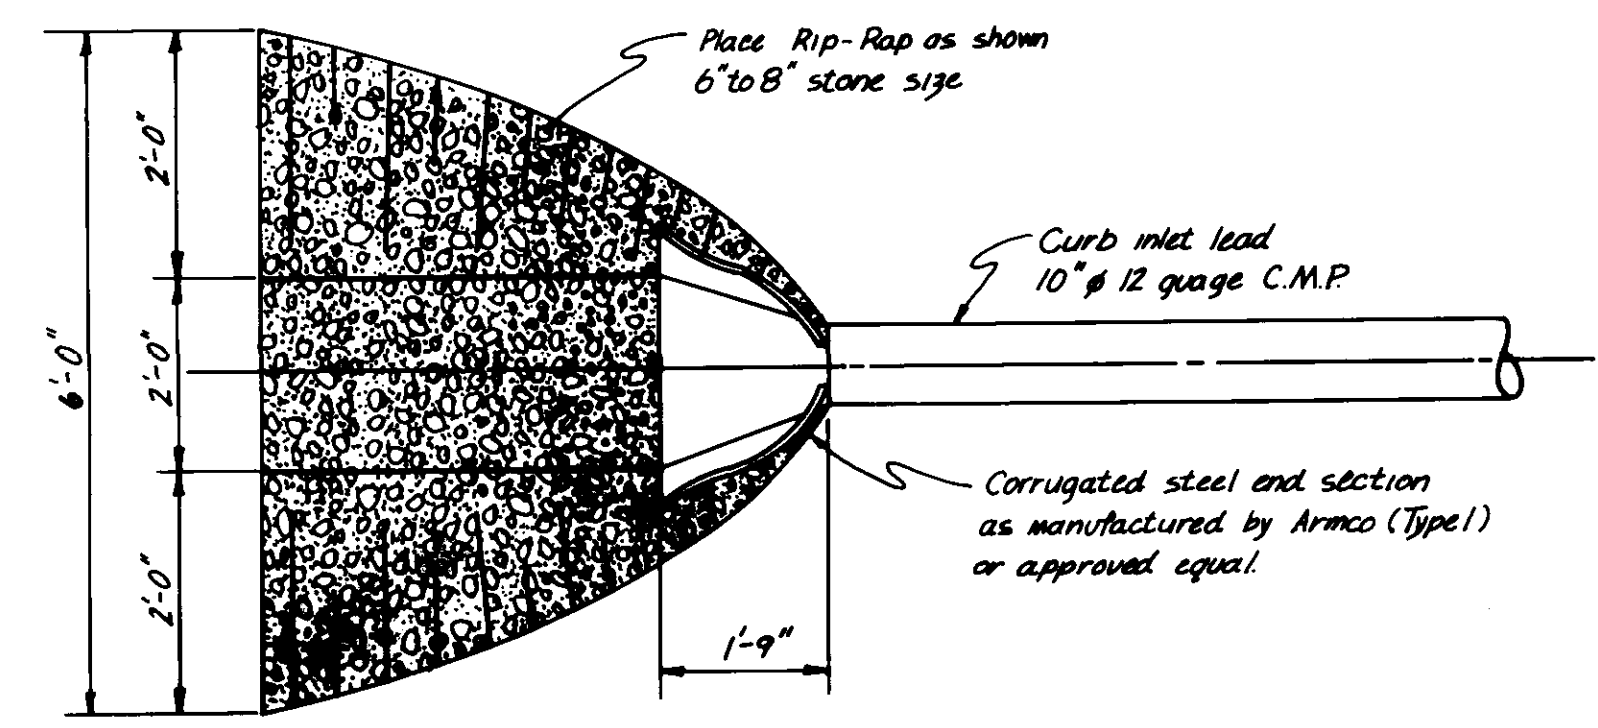


PLAN OF RIP-RAP
N.T.S.

AS BUILT
DATE FB. NO. PAGE
Nov. 14/79

				THE CITY OF WINNIPEG WORKS & OPERATIONS DEPARTMENT STREETS & TRANSPORTATION DIVISION		ROUTE 165			
				W.L. WARDROP & ASSOCIATES LTD. ENGINEERING CONSULTANTS WINNIPEG • THUNDER BAY • REGINA • SASKATOON		MISCELLANEOUS DETAILS		SCALE: AS SHOWN	
		APPROVED BY: <i>[Signature]</i> DATE: 25 JAN 77		DRAWN BY: DAP DATE: JAN 77 PRELIM. CHK: E.P.S. DATE: JAN 77		APPROVED BY: <i>[Signature]</i> DATE: 25/3/77 MANAGER OF STREETS AND TRAFFIC		DRAWING NO. B-5092-242	
REVISIONS NO. DATE BY		ISSUED FOR TENDER 4.4.77						W.L.W. NO. 74012-21	


10 INCHES
10
11
12
13
14
16
17
18
19

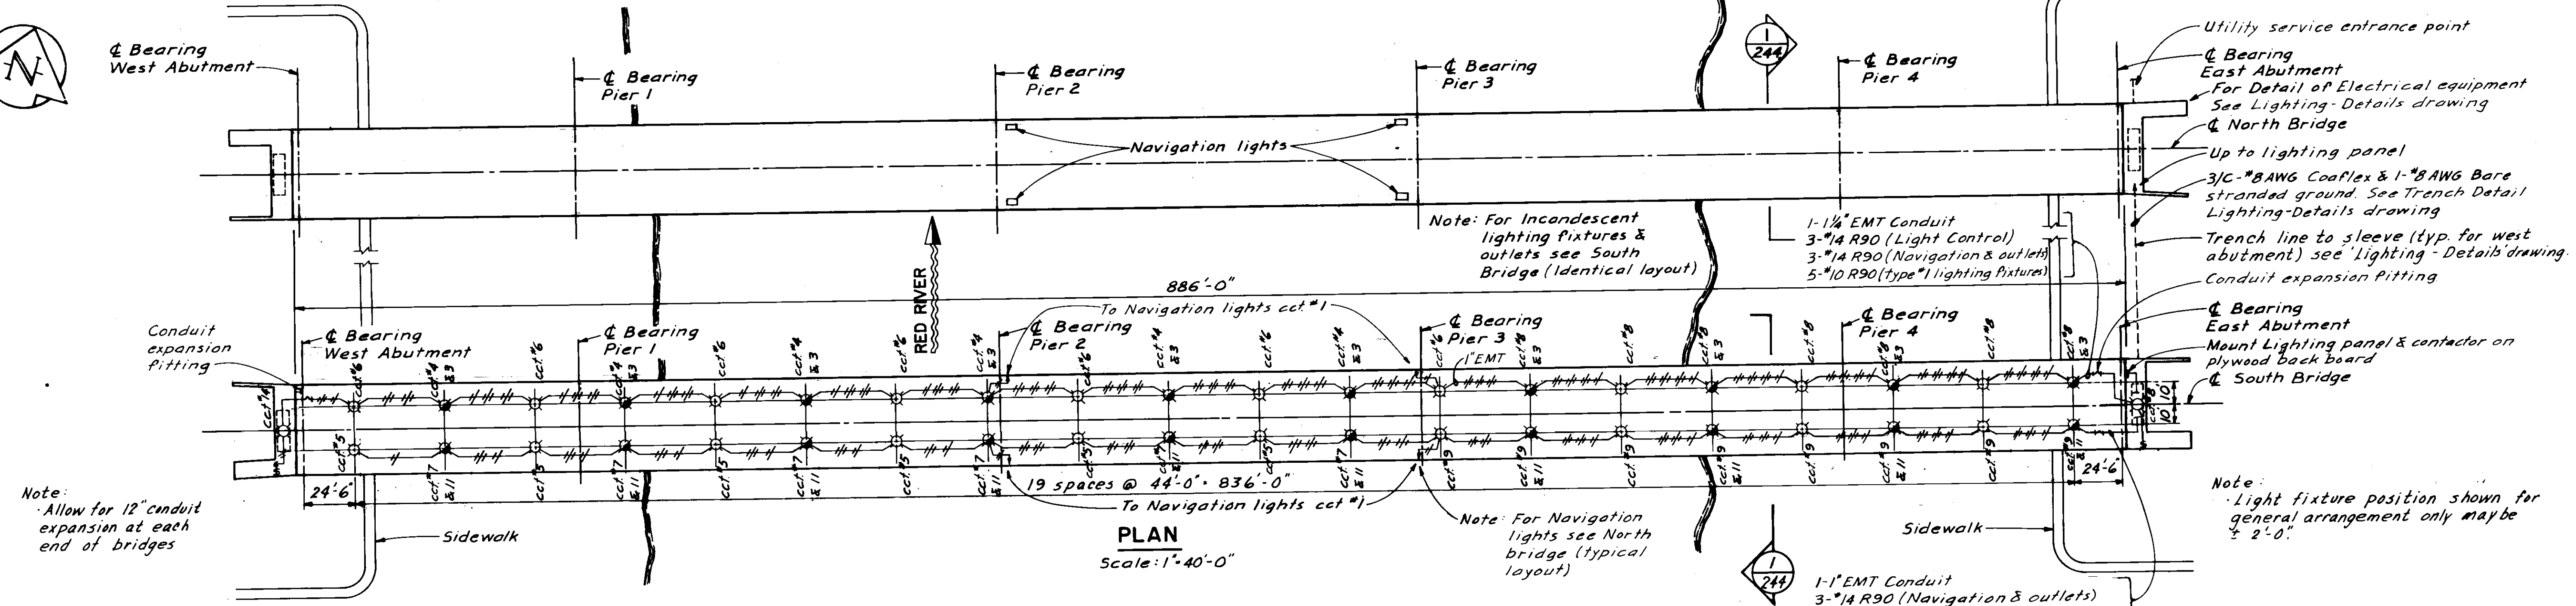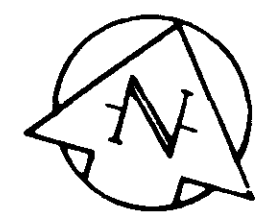

Note:
Allow for 12" conduit expansion at each end of bridges


Note:
Light fixture position shown for general arrangement only may be +/- 2'-0"

PLAN
Scale: 1"=40'-0"

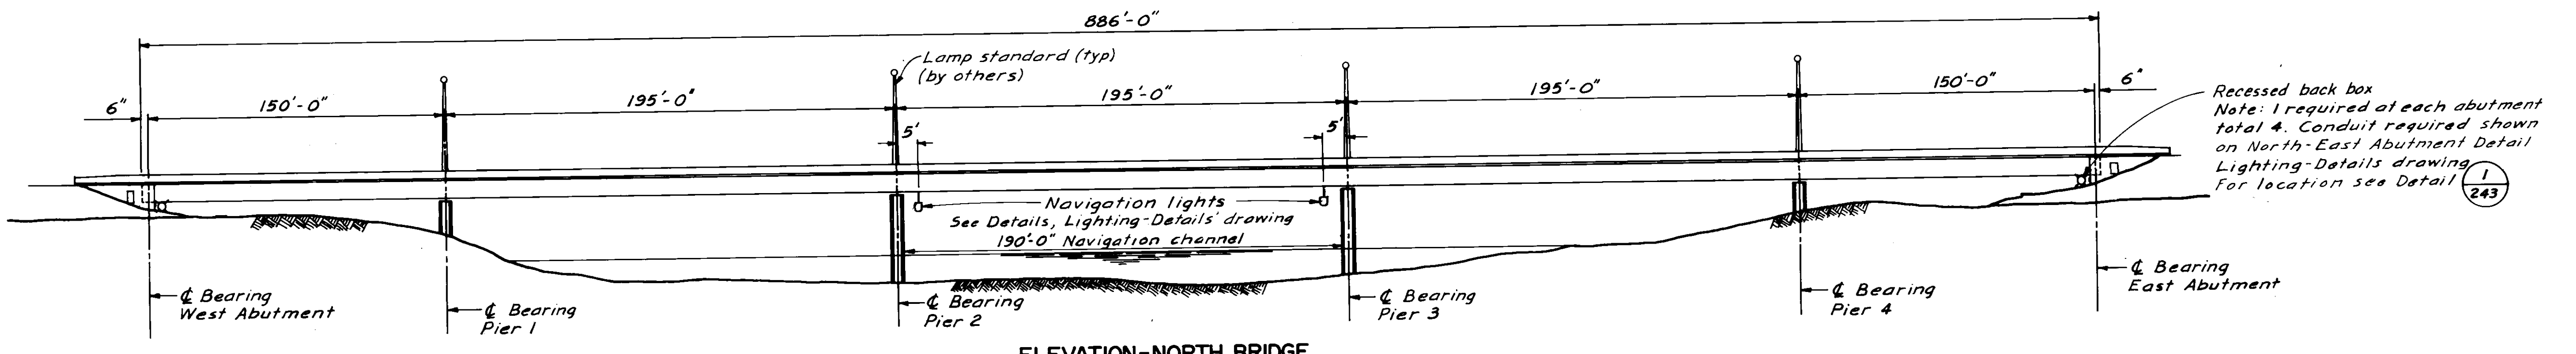

Recessed back box
Note: 1 required at each abutment total 4. Conduit required shown on North-East Abutment Detail Lighting-Details drawing For location see Detail 1 243

ELEVATION-NORTH BRIDGE
Scale: 1"=40'-0"

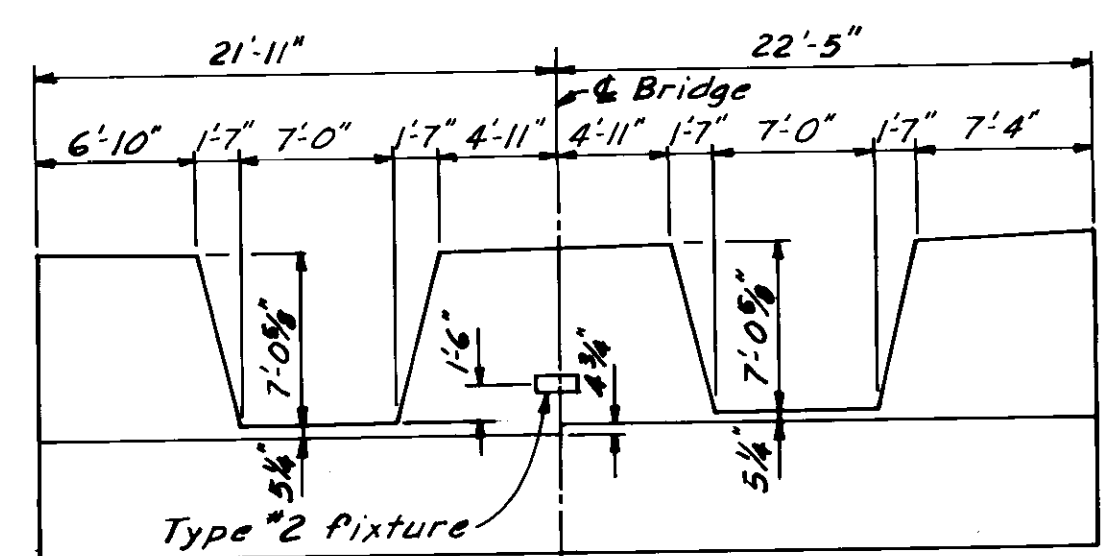


1 243
Scale: 1/8"=1'-0"

LEGEND
 X Incandescent light fixture
 X Incandescent light fixture & outlet
 NOTE: Outlets at every second fixture
 \$ Lighting control push button station (mount on stricker side of entry door)

AS - BUILT
 DATE: FB NO. PAGE
 Nov. 14/79

NO.	REVISIONS	DATE	BY
0	GENERAL REVISION	4-4-77	
0	ISSUED FOR TENDER	4-4-77	

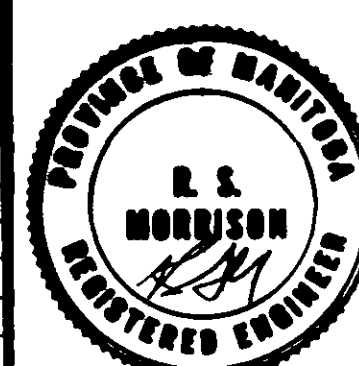

THE CITY OF WINNIPEG
 WORKS & OPERATIONS DEPARTMENT
 STREETS & TRANSPORTATION DIVISION

W.L. WARDROP & ASSOCIATES LTD.
 ENGINEERING CONSULTANTS
 WINNIPEG - THUNDER BAY - REGINA - SASKATOON

APPROVED BY: *[Signature]* DATE: 25 Mar 77
 DRAWN BY: SPB DATE: MAR 77
 PRELIM. CHK: *[Signature]* CHECK: *[Signature]*


ROUTE 165

LIGHTING - PLAN AND ELEVATION


APPROVED BY: *[Signature]* DATE: 25/3/77
 MANAGER OF STREETS AND TRAFFIC

SCALE:
AS SHOWN


DRAWING NO.
B-5092-243

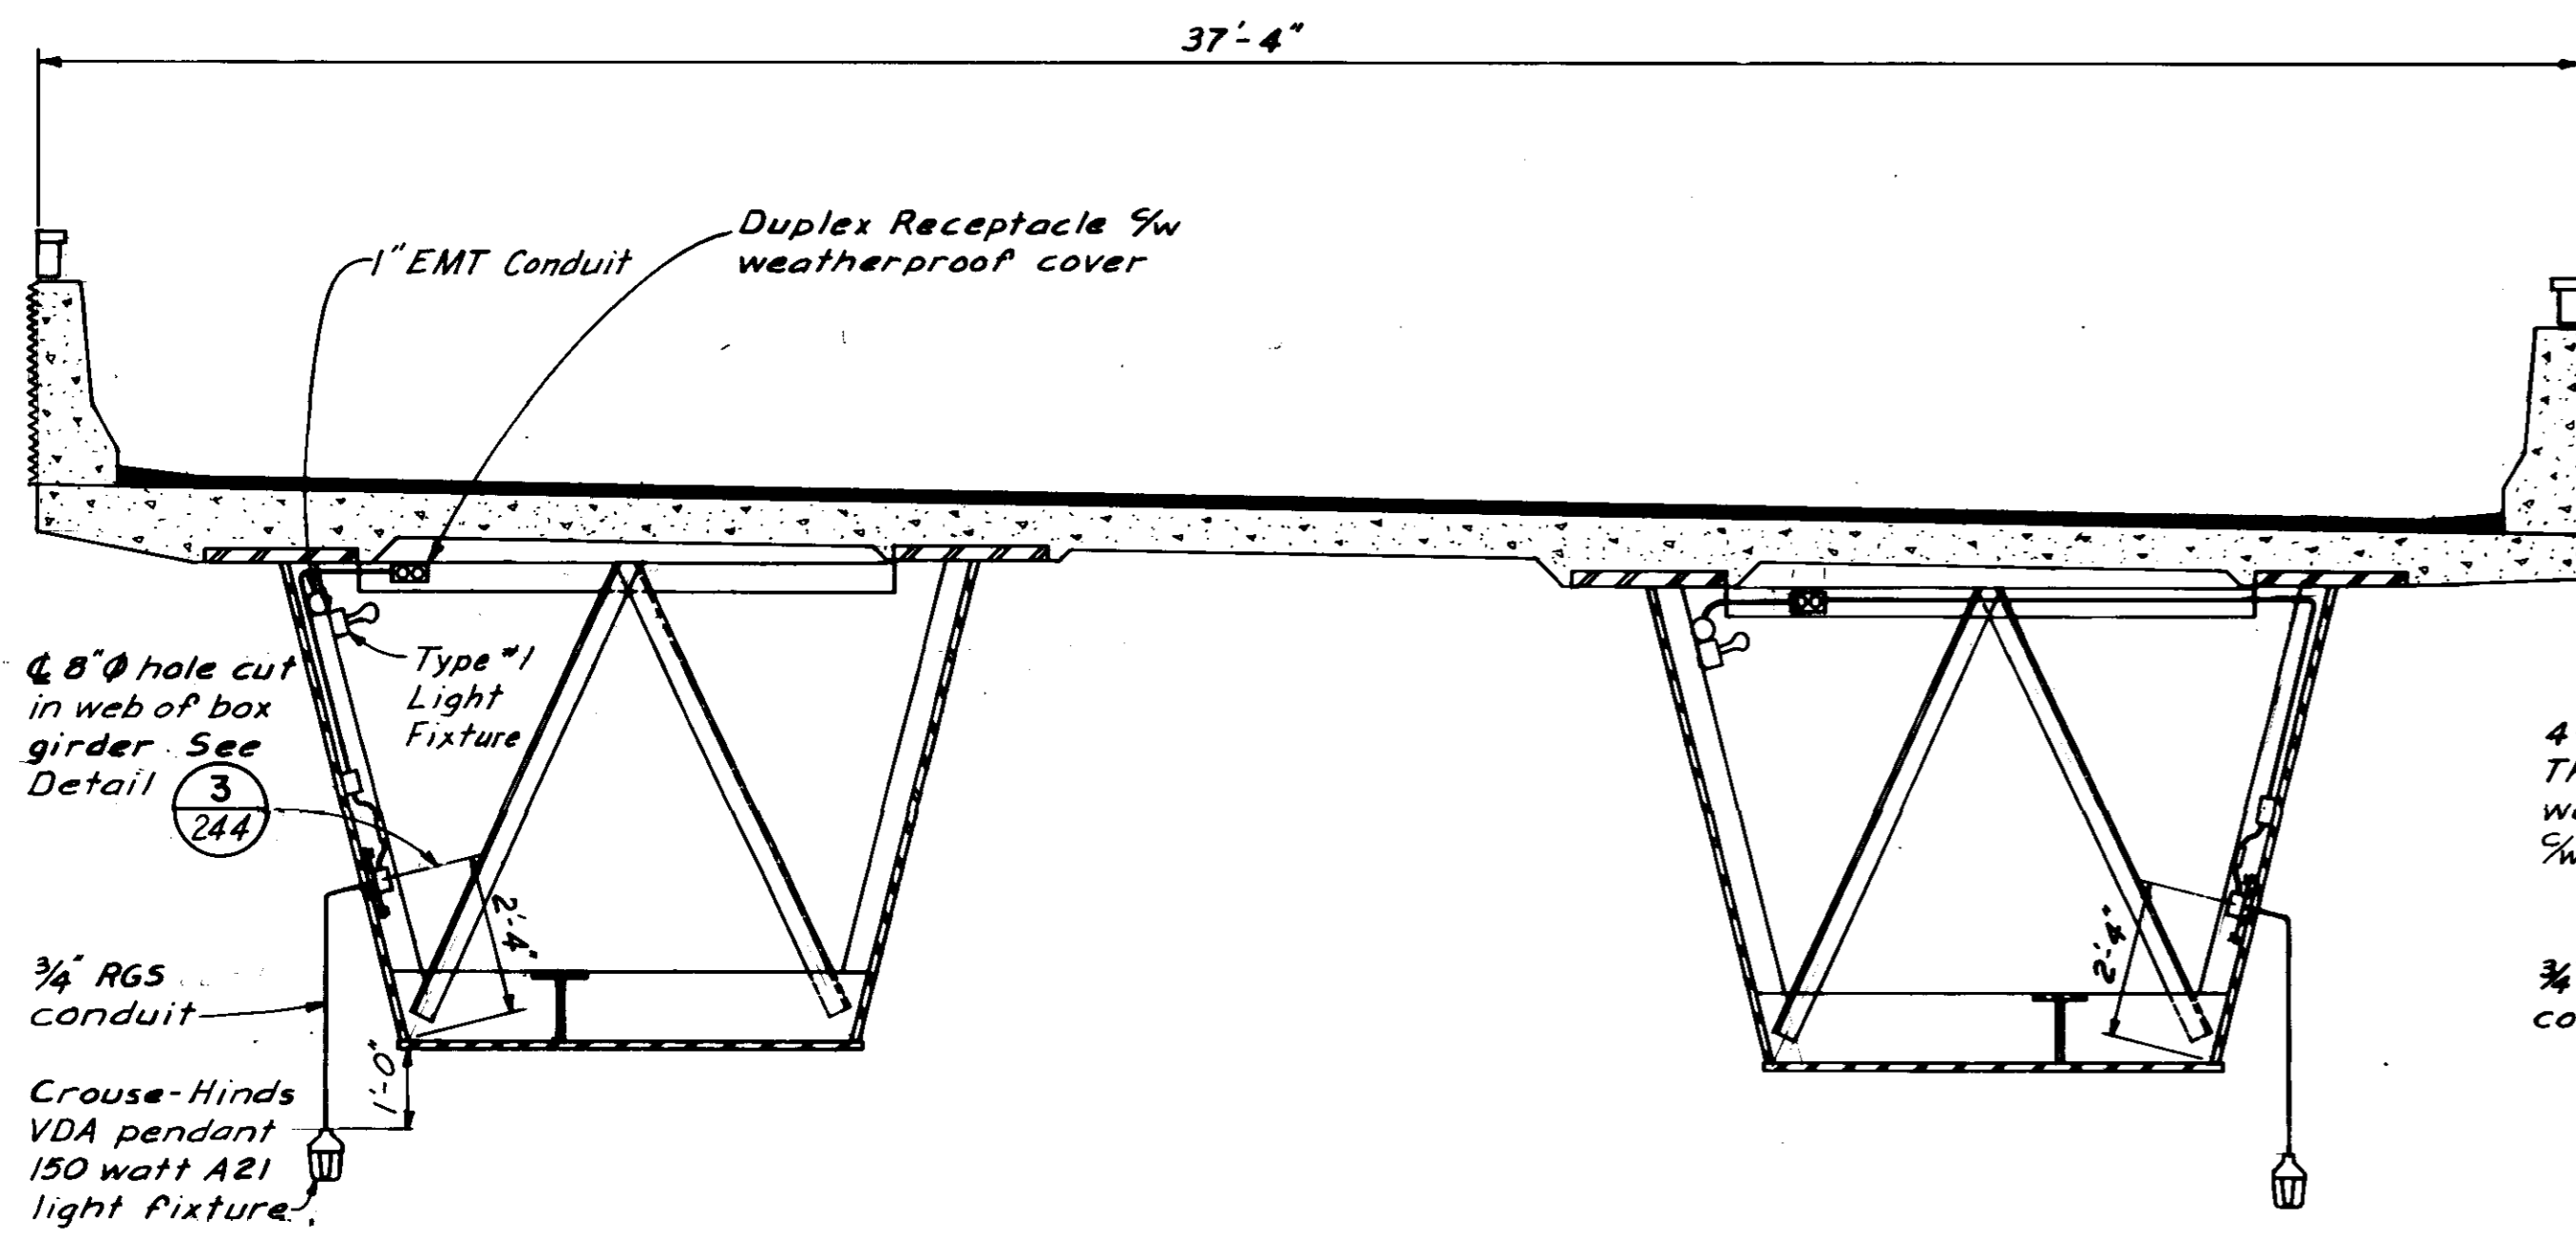


1 TYPICAL CROSS-SECTION NORTH BRIDGE
 Scale: 3/8"=1'-0"

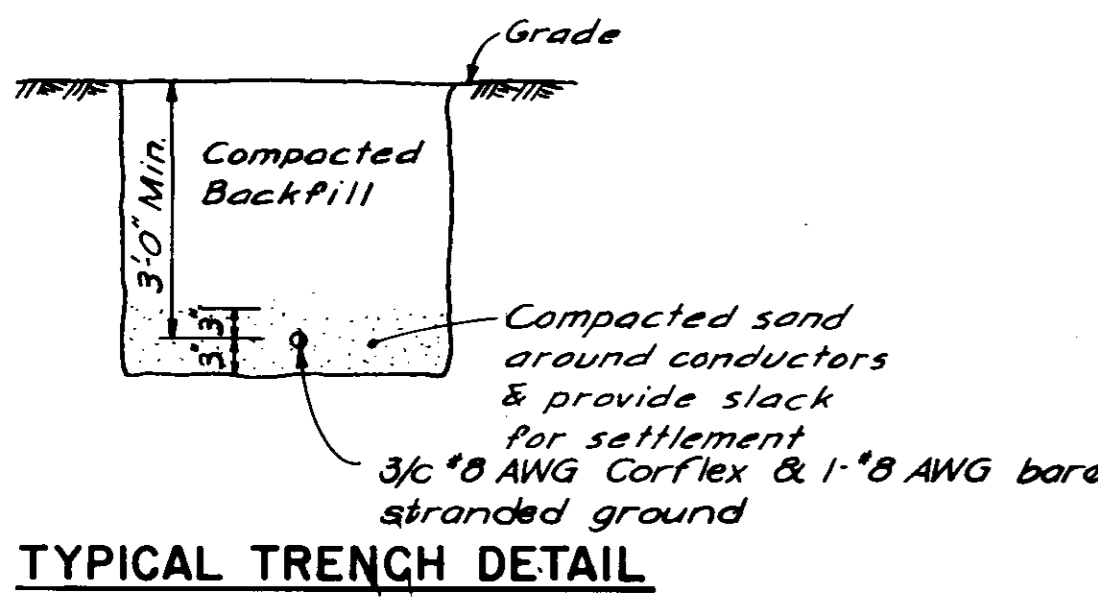


TYPICAL TRENCH DETAIL

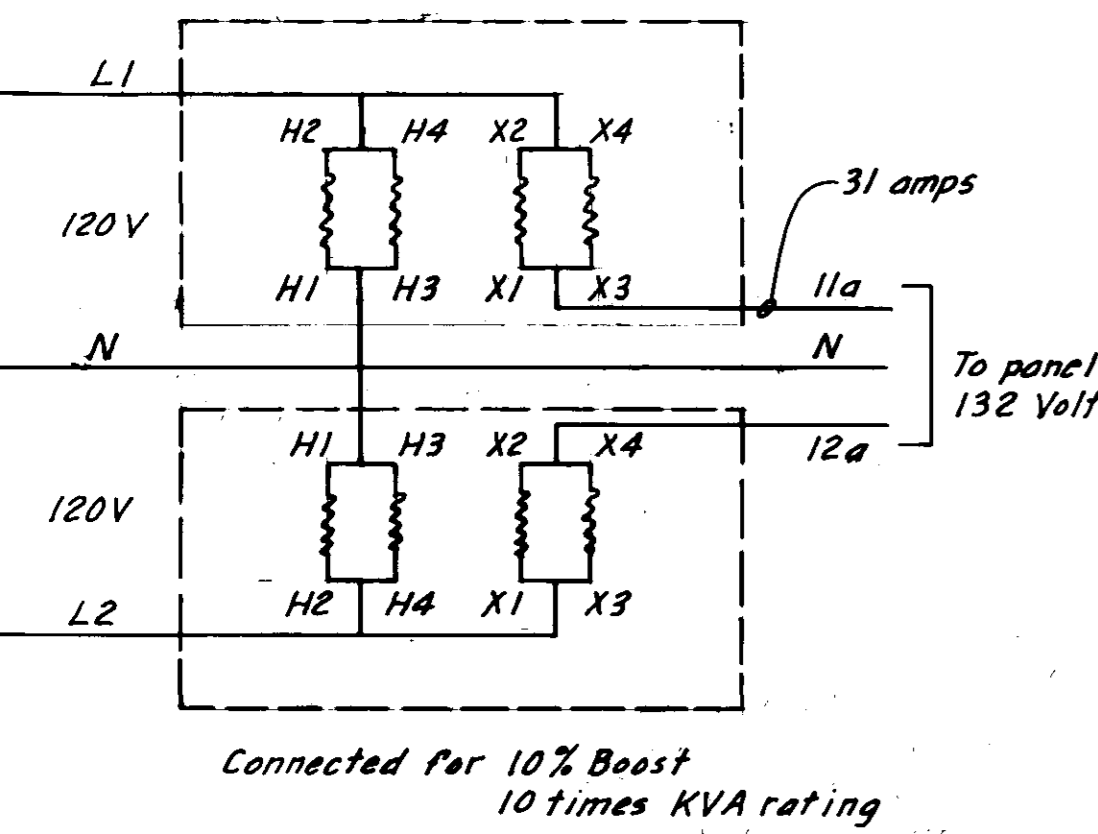


BRIDGE LIGHTING BOOSTER TRANSFORMER CONNECTION

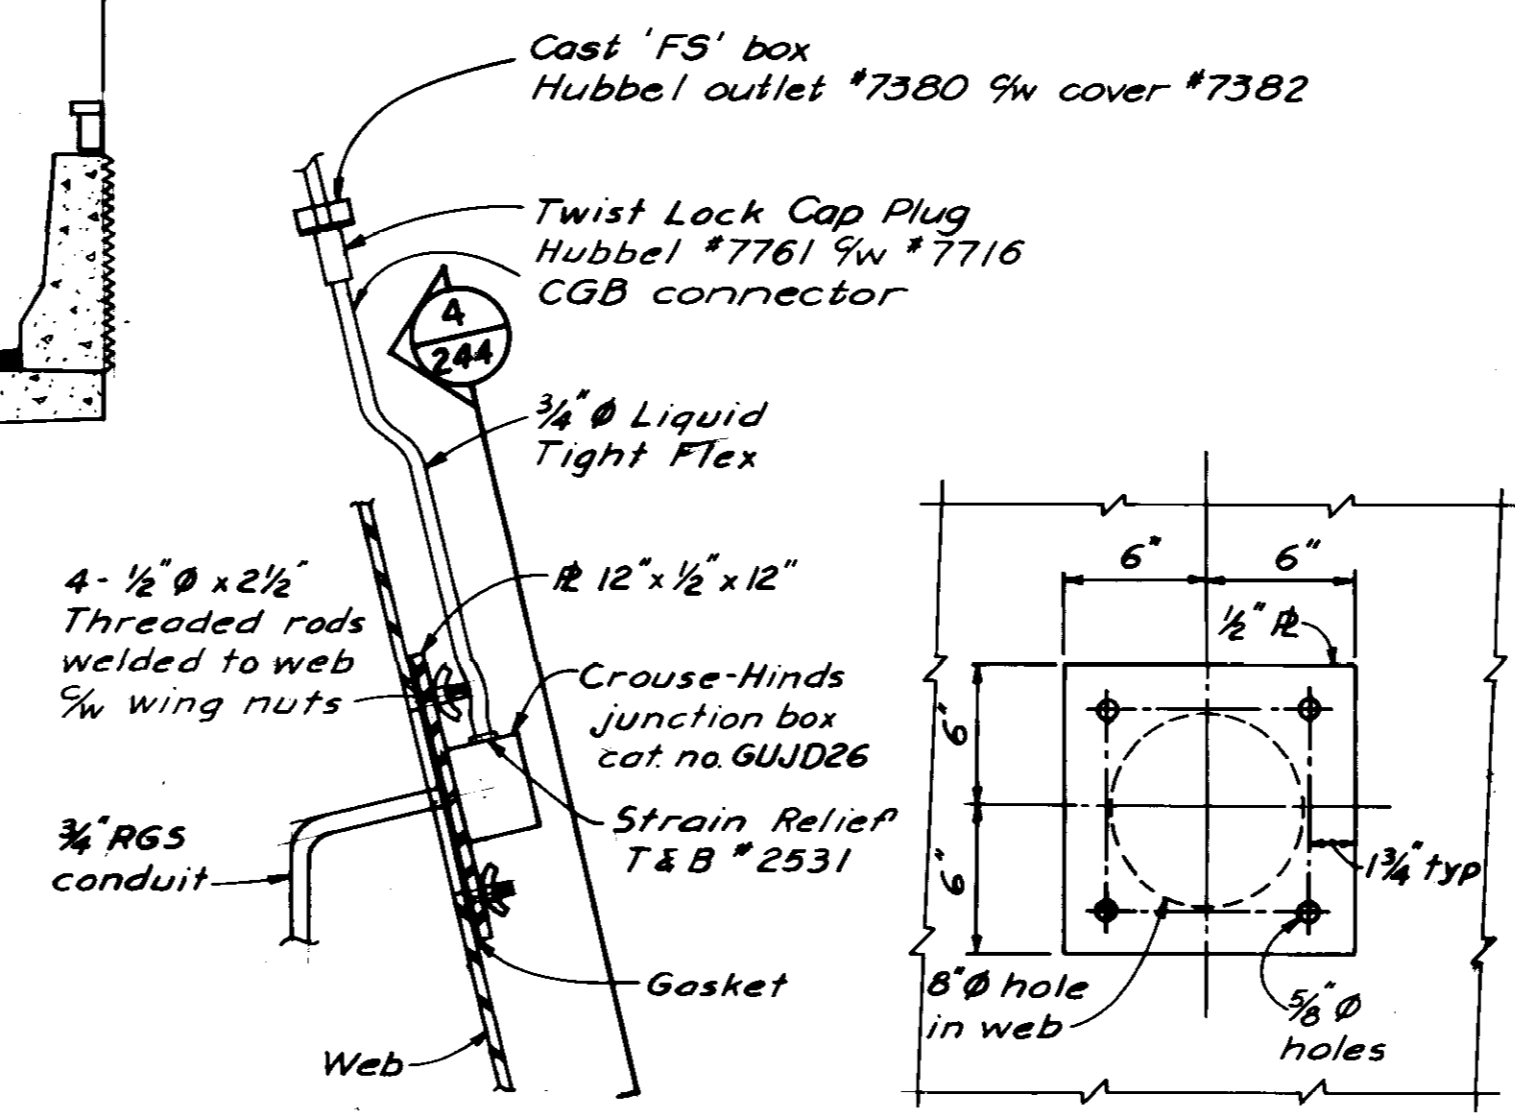


3 DETAIL
 Scale: 1/2"=1'-0"

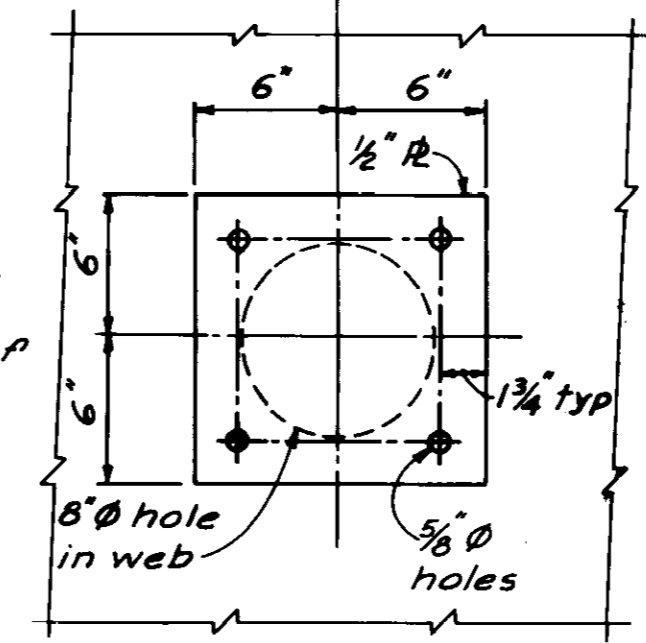

4 ELEVATION
 Scale: 1/2"=1'-0"

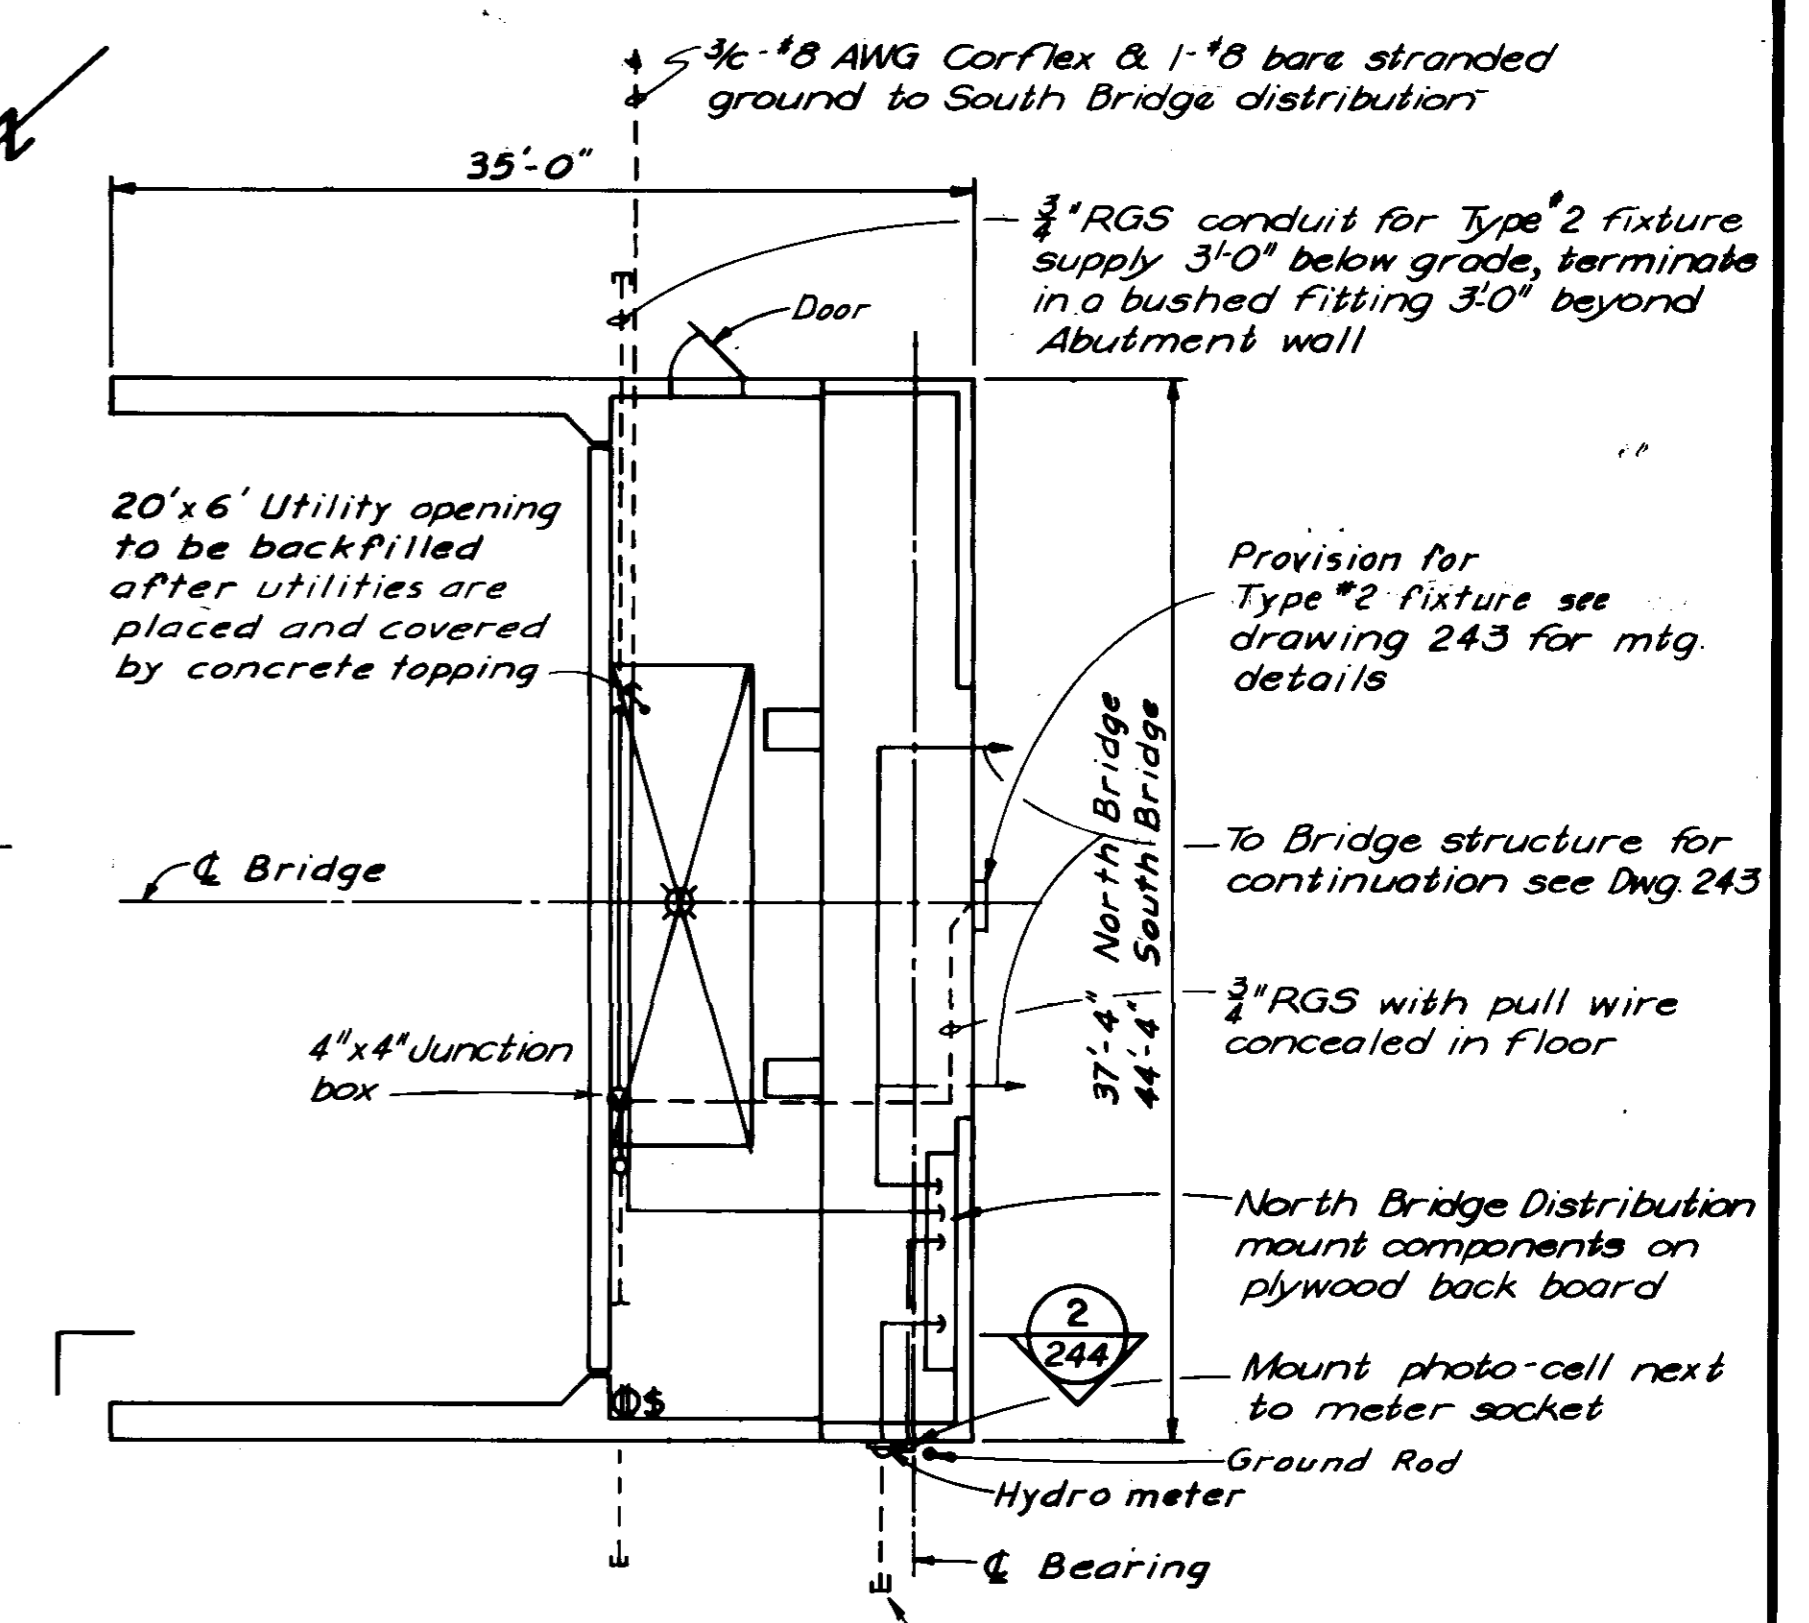

ABUTMENT PLAN
 Scale: 1/8"=1'-0"

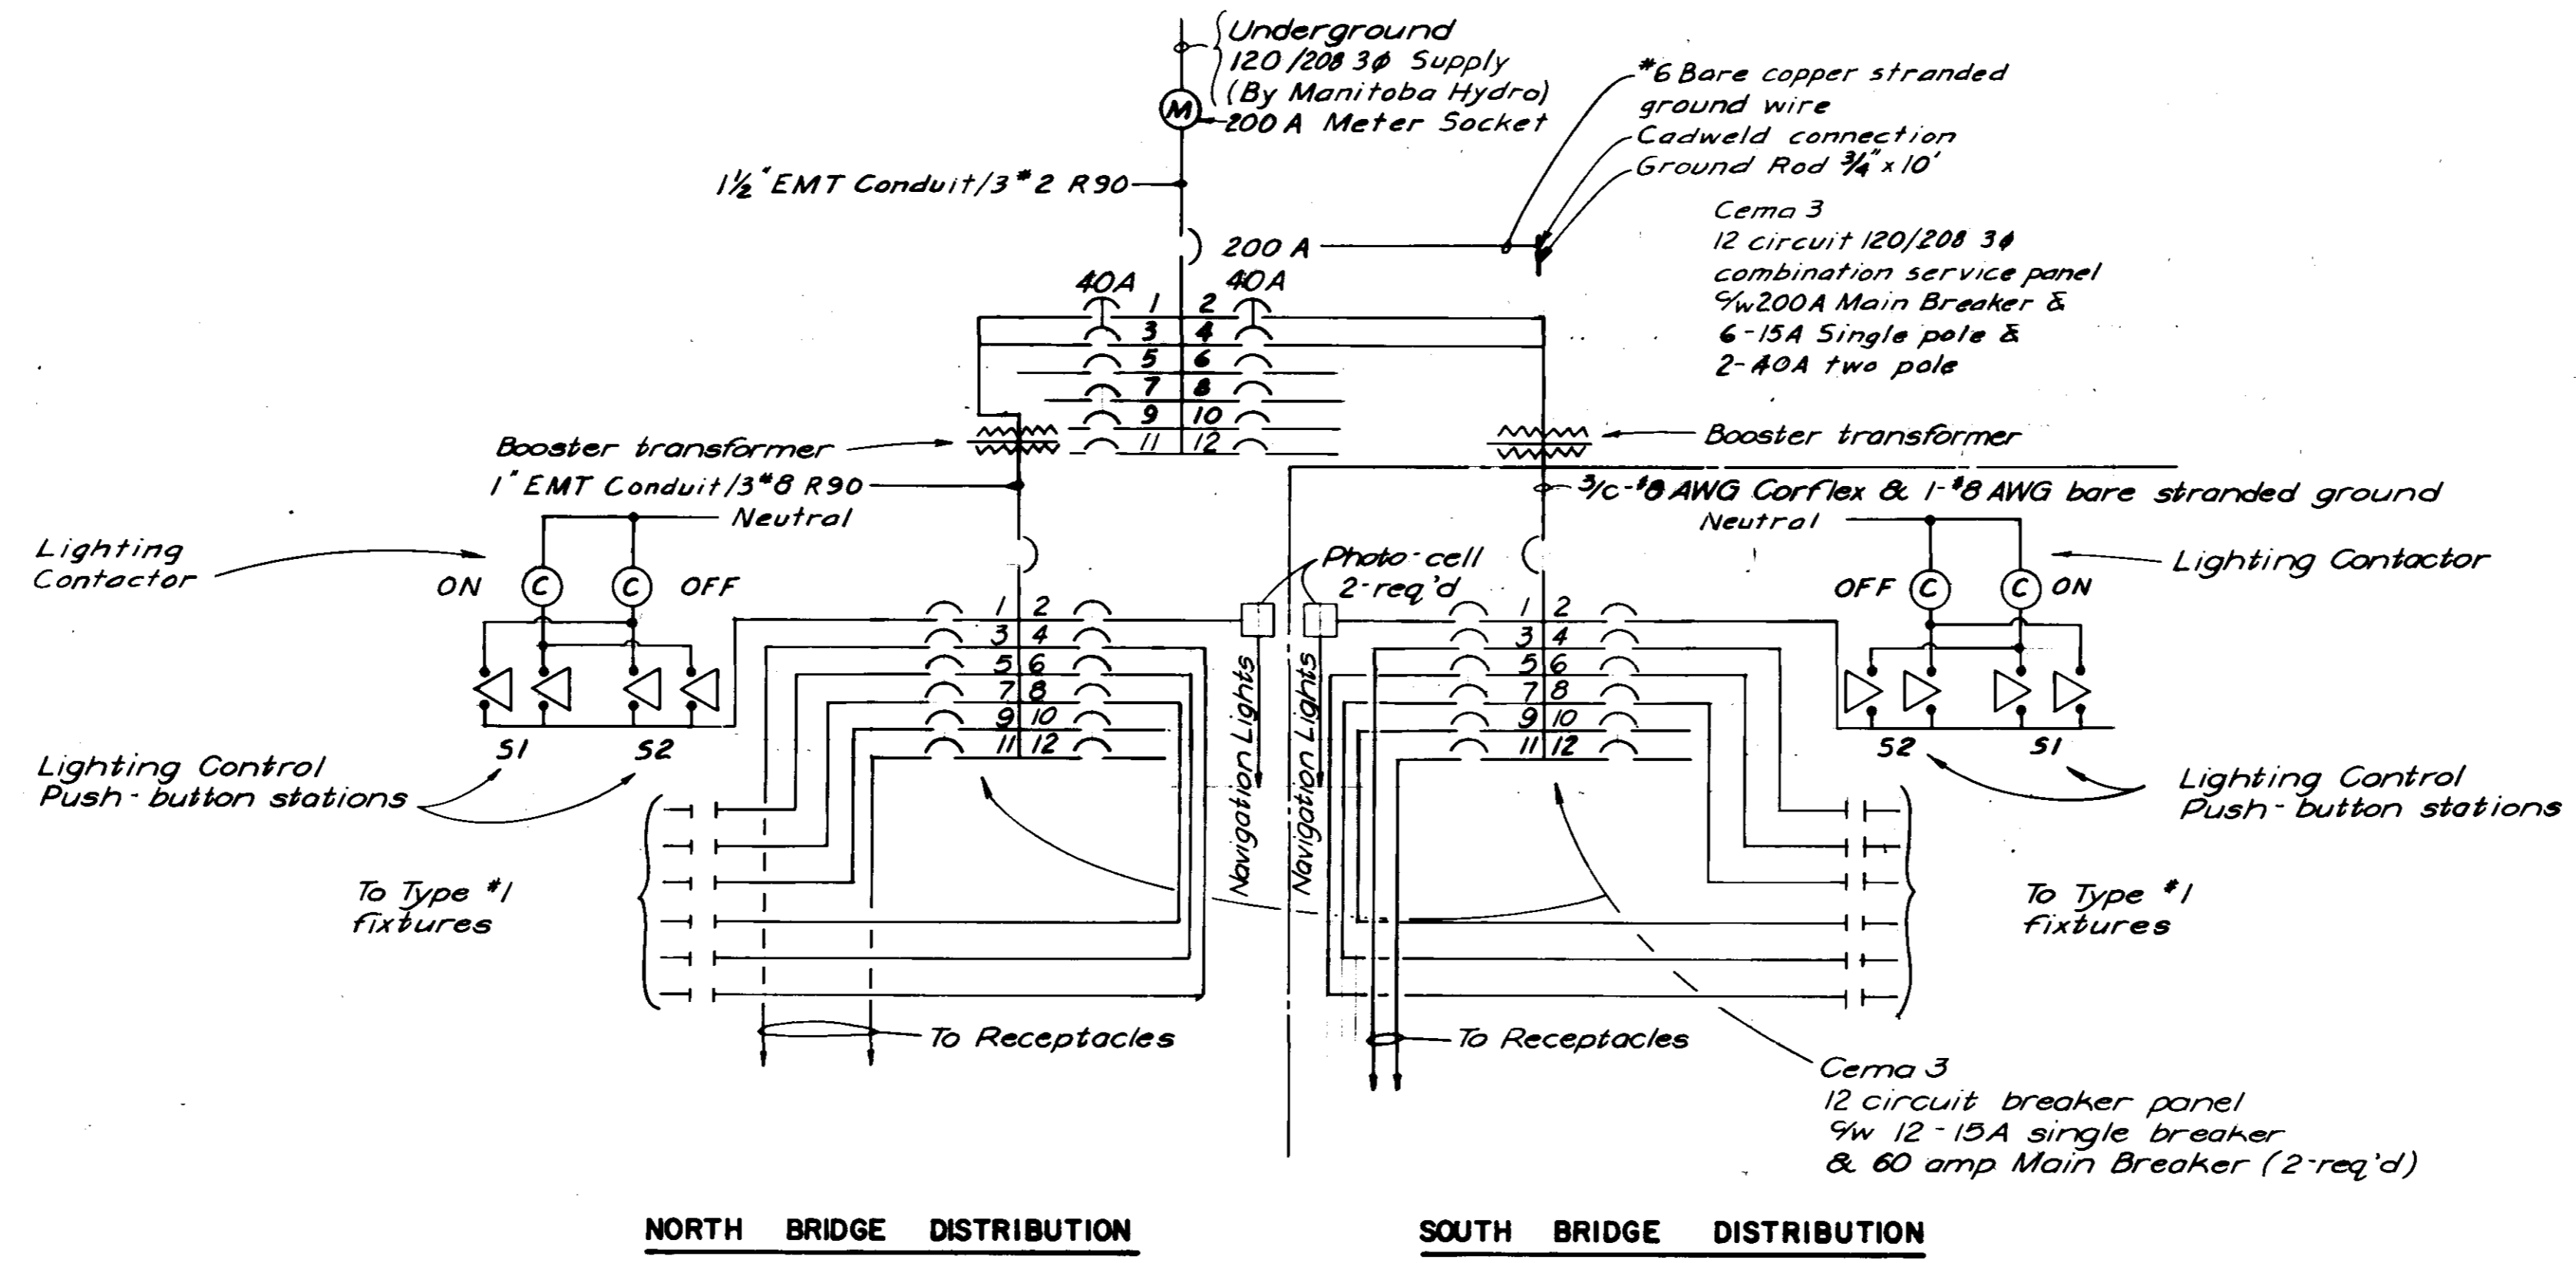

NORTH BRIDGE DISTRIBUTION

SOUTH BRIDGE DISTRIBUTION

AS - BUILT		
DATE	FB. NO.	PAGE
Nov. 14/79		

NO.	REVISIONS	DATE	BY
0	GENERAL REVISION	4-4-77	
0	ISSUED FOR TENDER	4-7-77	

THE CITY OF WINNIPEG
 WORKS & OPERATIONS DEPARTMENT
 STREETS & TRANSPORTATION DIVISION

W.L. WARDROP & ASSOCIATES LTD.
 ENGINEERING CONSULTANTS
 WINNIPEG - THUNDER BAY - REGINA - BARRIE - EDMONTON

APPROVED BY: *[Signature]* DATE: 25 MAR 77
 DRAWN BY: SPB DATE: MAR 77
 PRELIM. CHK: *[Signature]* CHECK: *[Signature]*

ROUTE 165


LIGHTING - DETAILS

SCALE: AS SHOWN

APPROVED BY: *[Signature]* DATE: 25/3/77
 MANAGER OF STREETS AND TRAFFIC

DRAWING NO. **B-5092-244**


10 INCHES
19
18
17
16
14
13
12
11
10

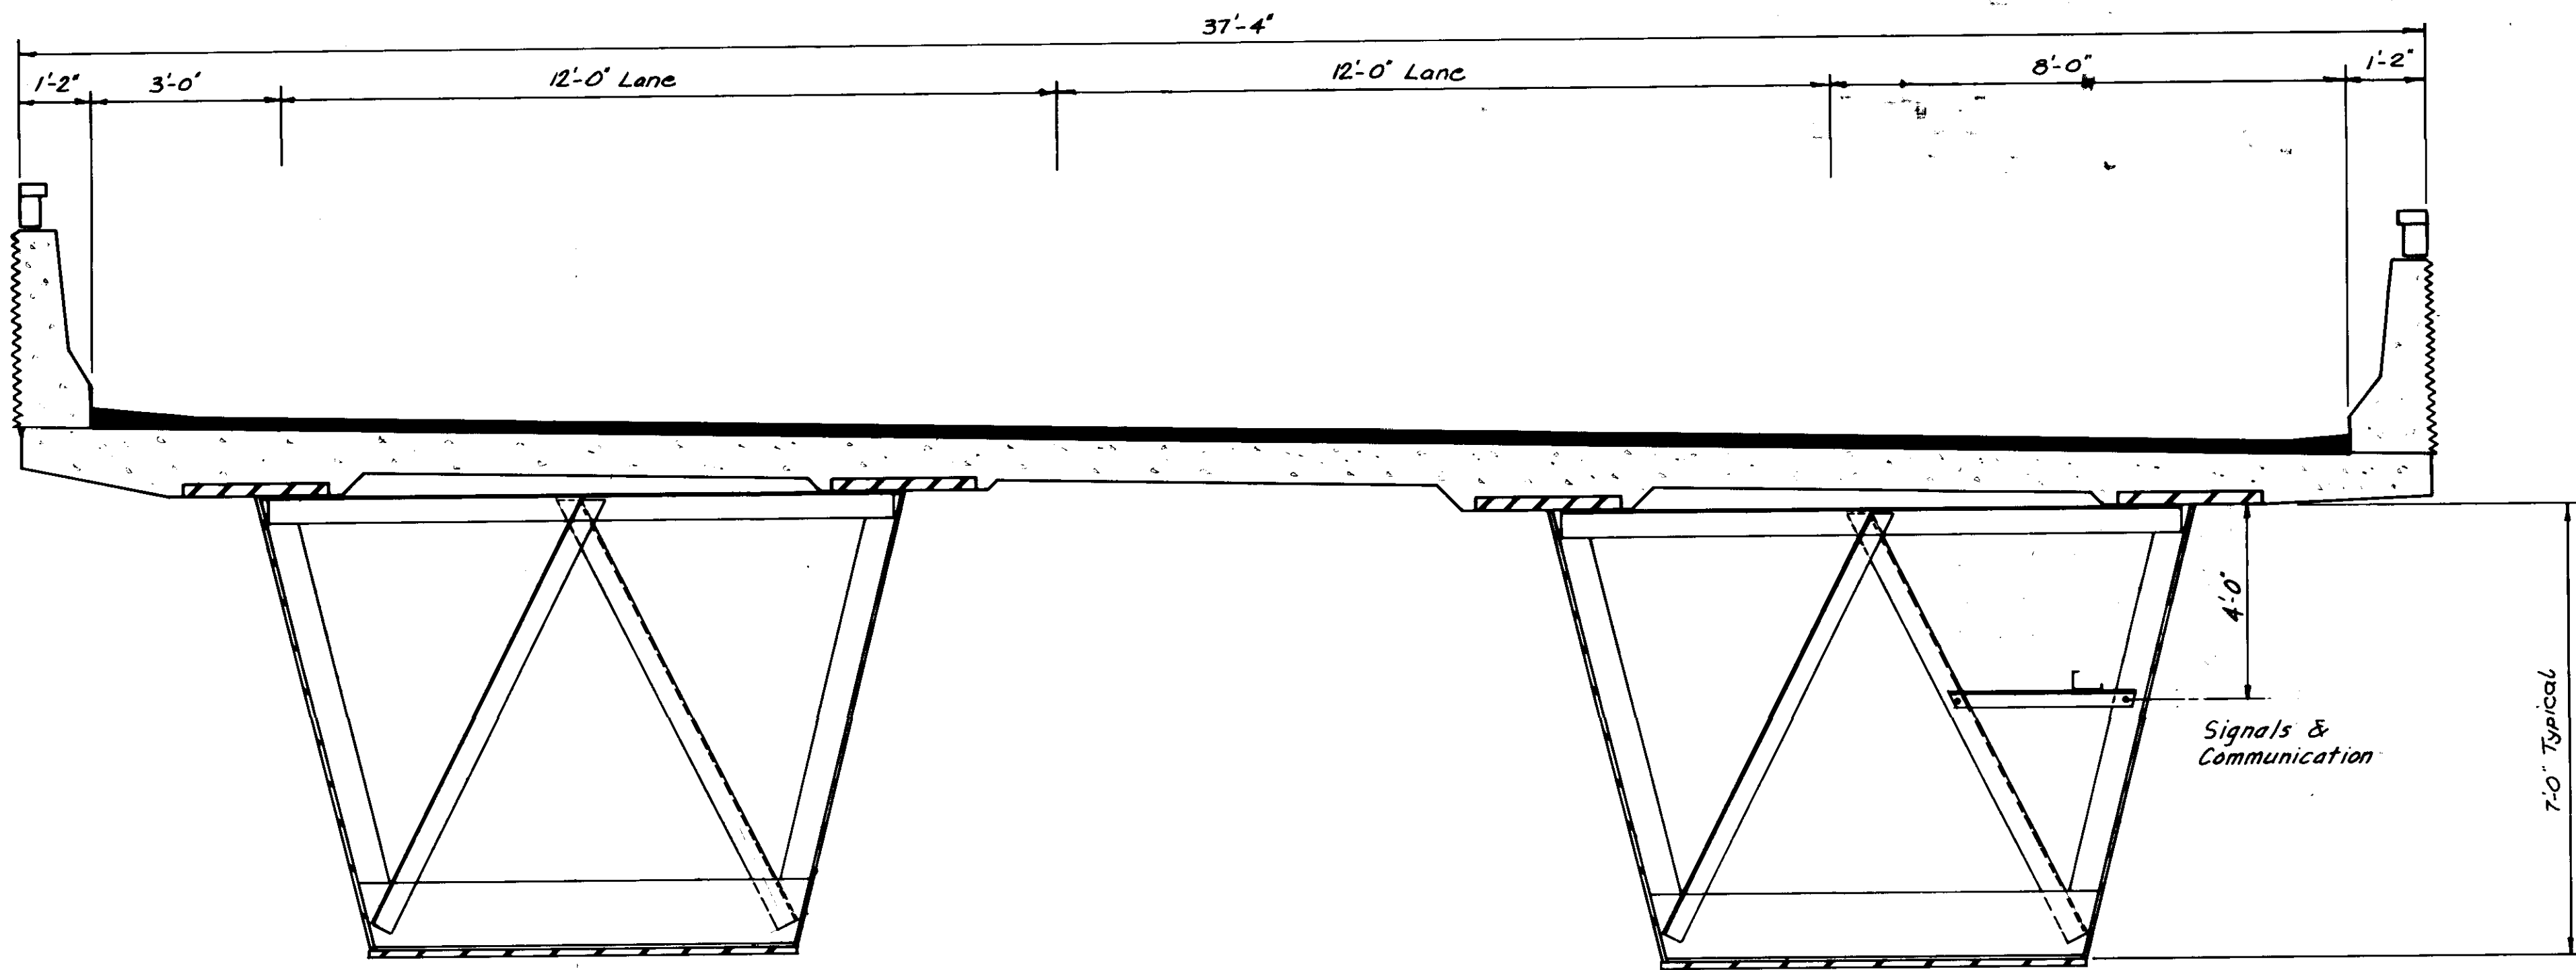

SOUTH BOX

NORTH BRIDGE

NORTH BOX

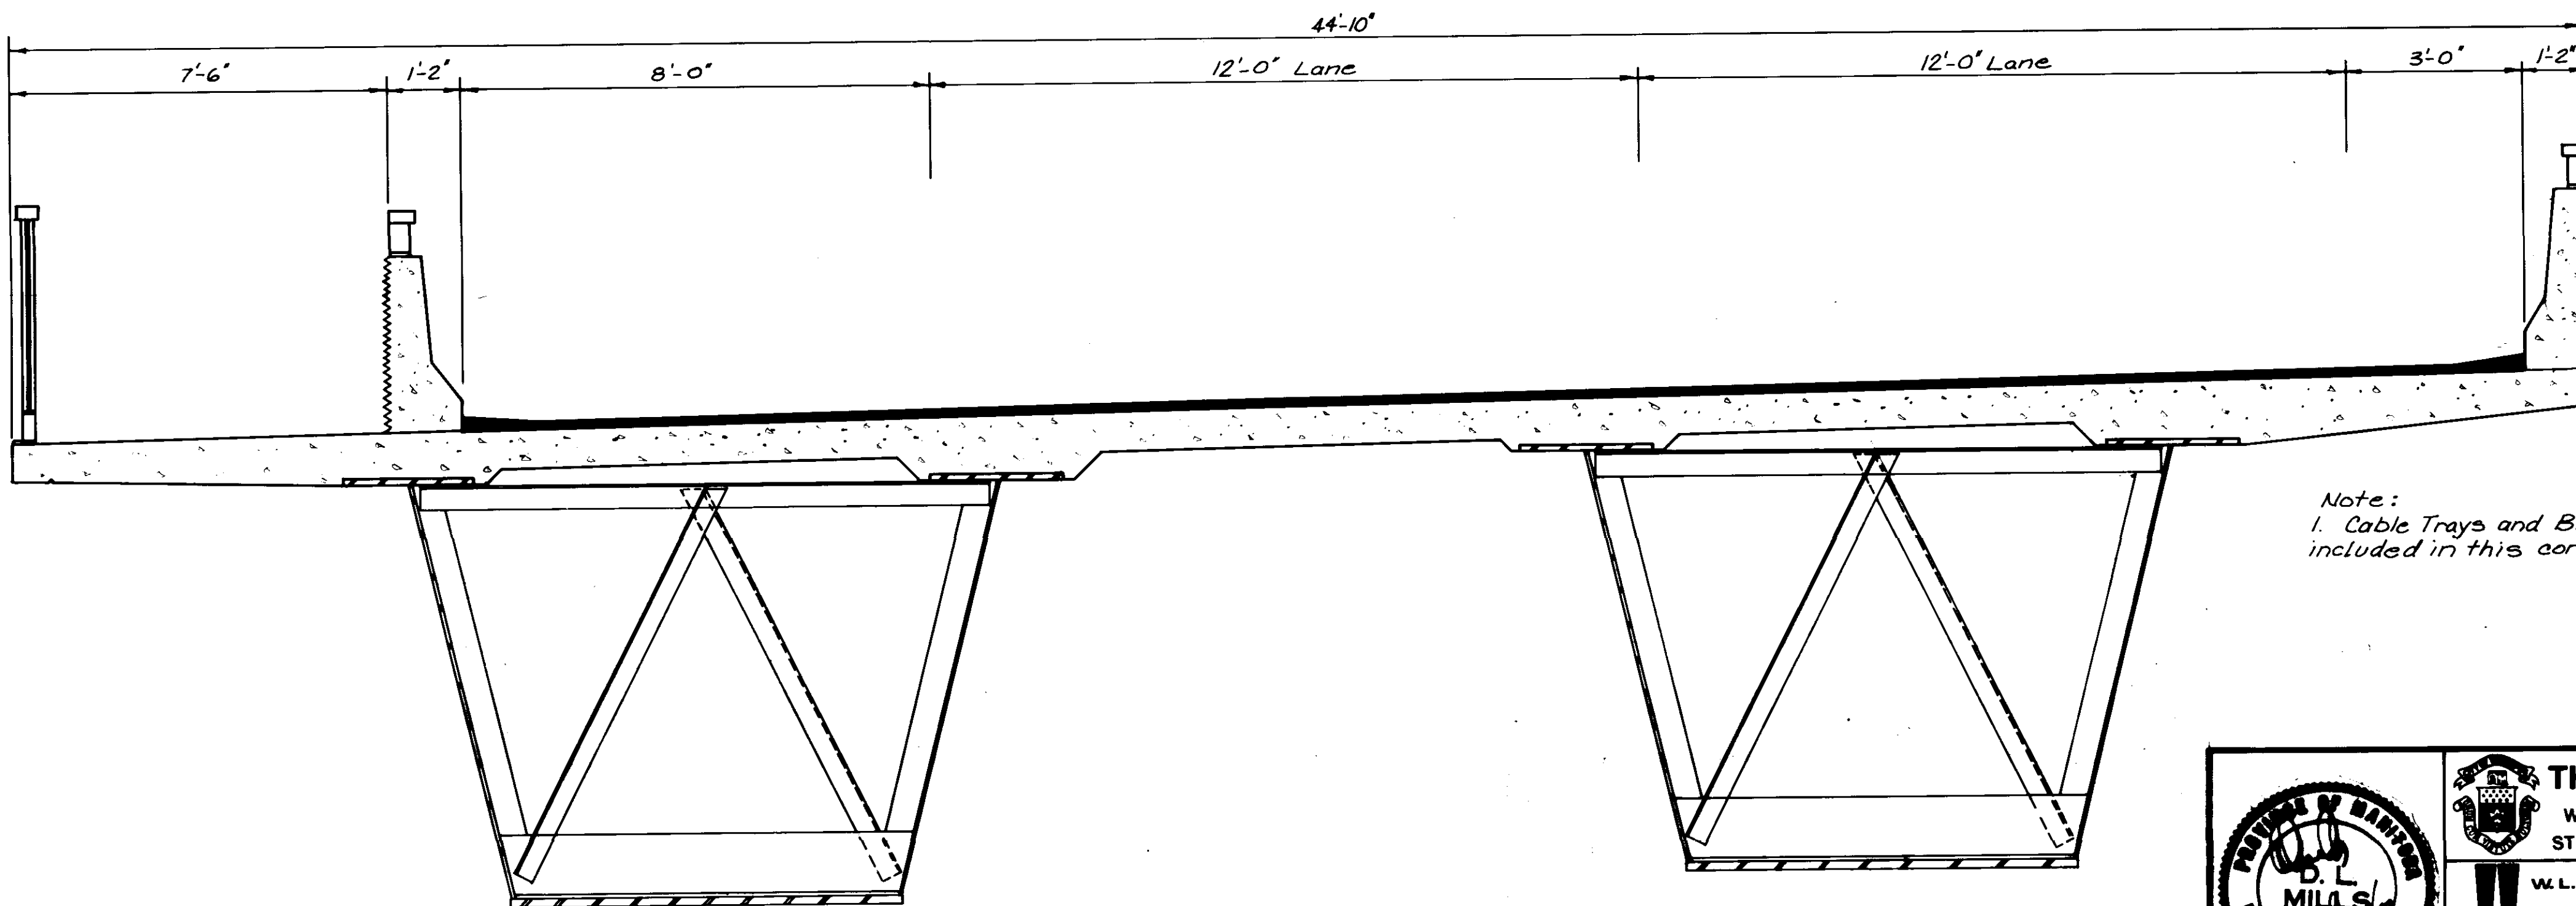

SOUTH BOX

SOUTH BRIDGE

NORTH BOX

Note:
1. Cable Trays and Brackets are not included in this contract.

AS-BUILT		
DATE	FB. NO.	PAGE

NO.	ISSUED FOR	DATE	BY

	THE CITY OF WINNIPEG WORKS & OPERATIONS DEPARTMENT STREETS & TRANSPORTATION DIVISION	ROUTE 165	SCALE: $\frac{1}{2}'' = 1'-0''$
	W.L. WARDROP & ASSOCIATES LTD. ENGINEERING CONSULTANTS <small>WINNIPEG - THUNDER BAY - REGINA - BARRIE - EDMONTON</small>	FUTURE UTILITIES	
APPROVED BY: <i>[Signature]</i> DATE: 25 MAR 77	DRAWN BY: DAP DATE: MAR 77 PRELIM. CHK.: STK DATE: MAR 77 CHECK: STK DATE: MAR 77	APPROVED BY: <i>[Signature]</i> DATE: 25 MAR 77 MANAGER OF STREETS AND TRAFFIC	DRAWING NO. B-5092-245