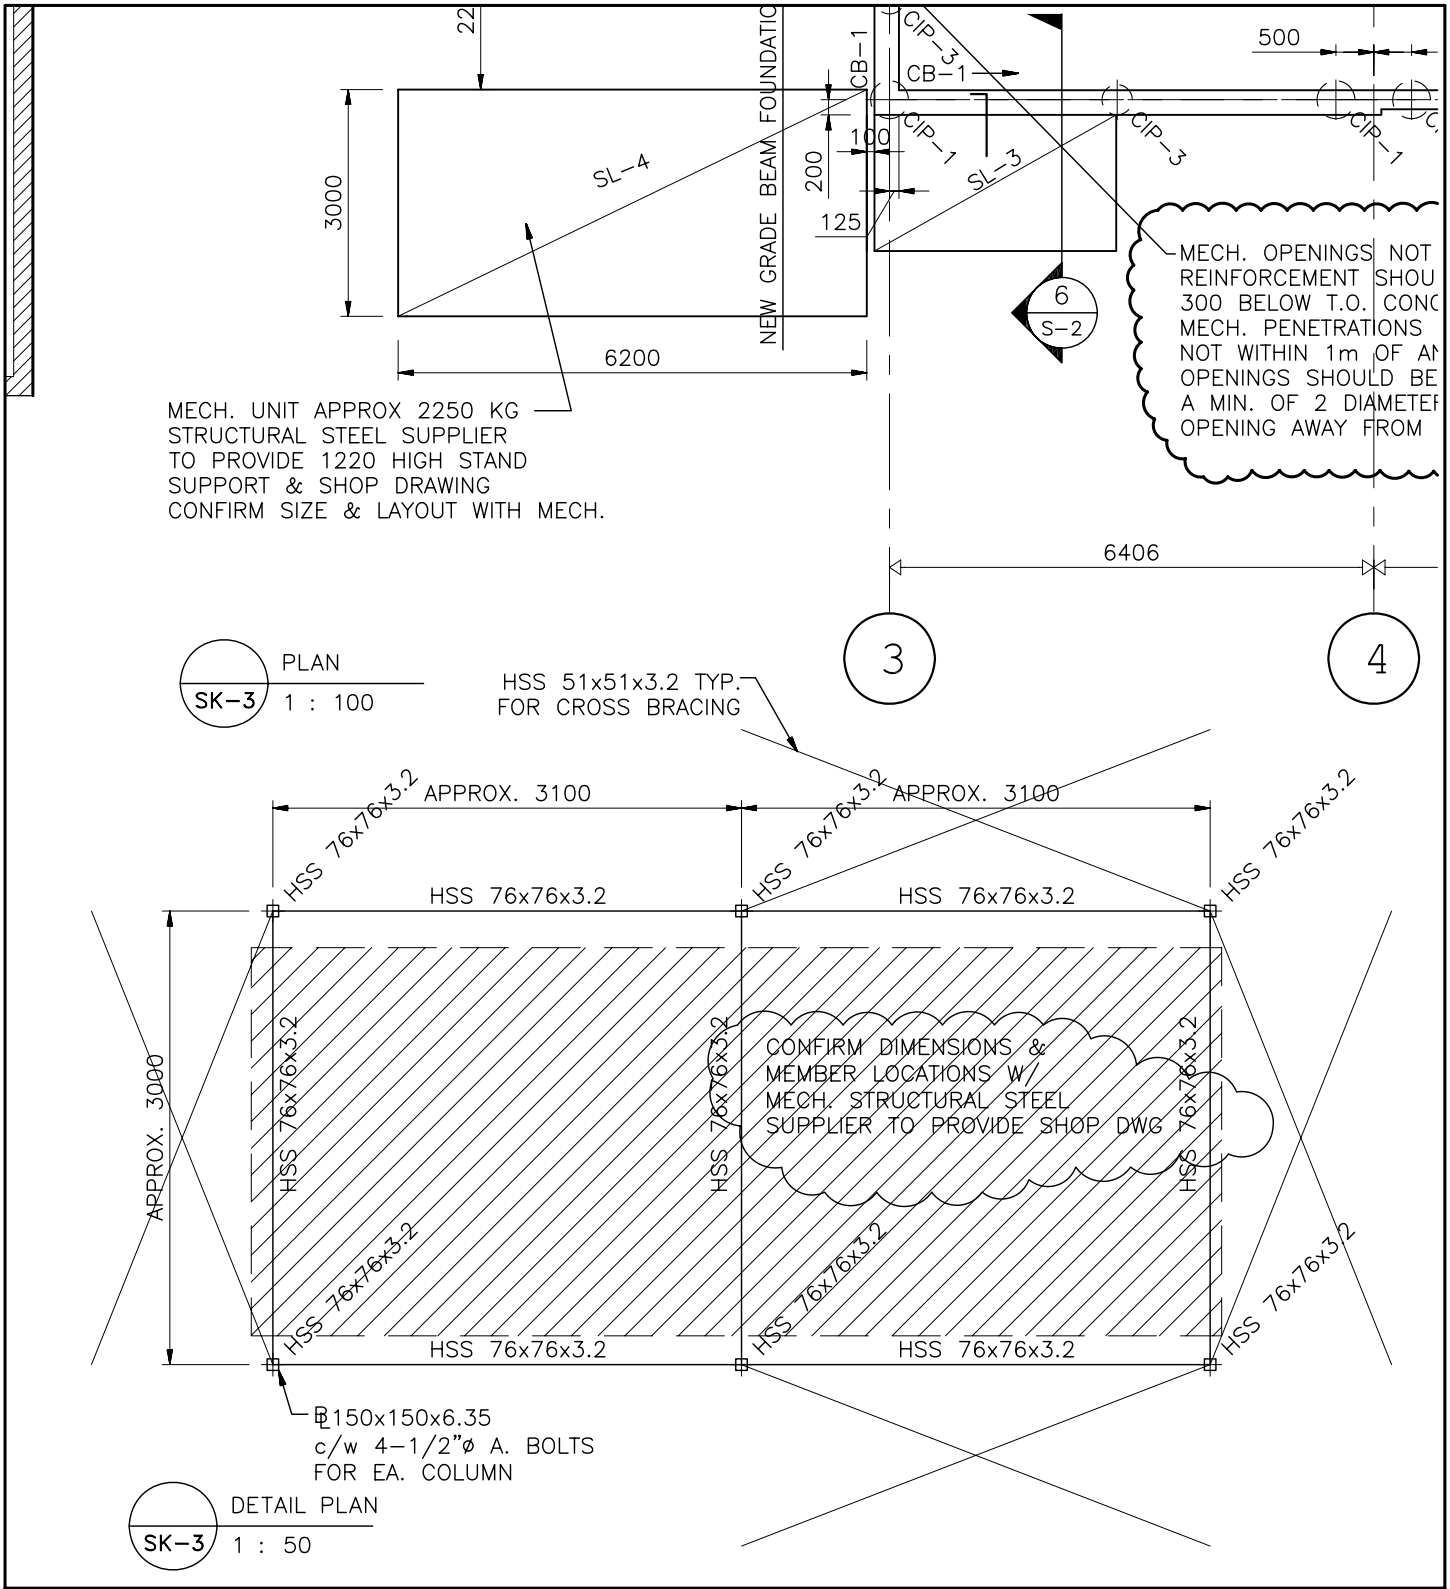

WOLFROM ENGINEERING LTD

CONSULTING ENGINEERS
345 WARDLAW AVENUE
WINNIPEG,CANADA R3L 0L5
(204)452-0041 FAX:284-8680
E-Mail: info@wolfromeng.com

DATE
JAN 29/08

SCALE
AS NOTED

SEAL

JOB TITLE
VALOUR COMMUNITY CENTRE
AHU FRAME

FILE NO.
W06440

DRAWING NO.
SK-3