

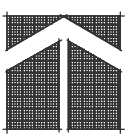


Plot file - S:\M\office\cwg\111111.dwg Plot size - Letter Plot scale - 1:1

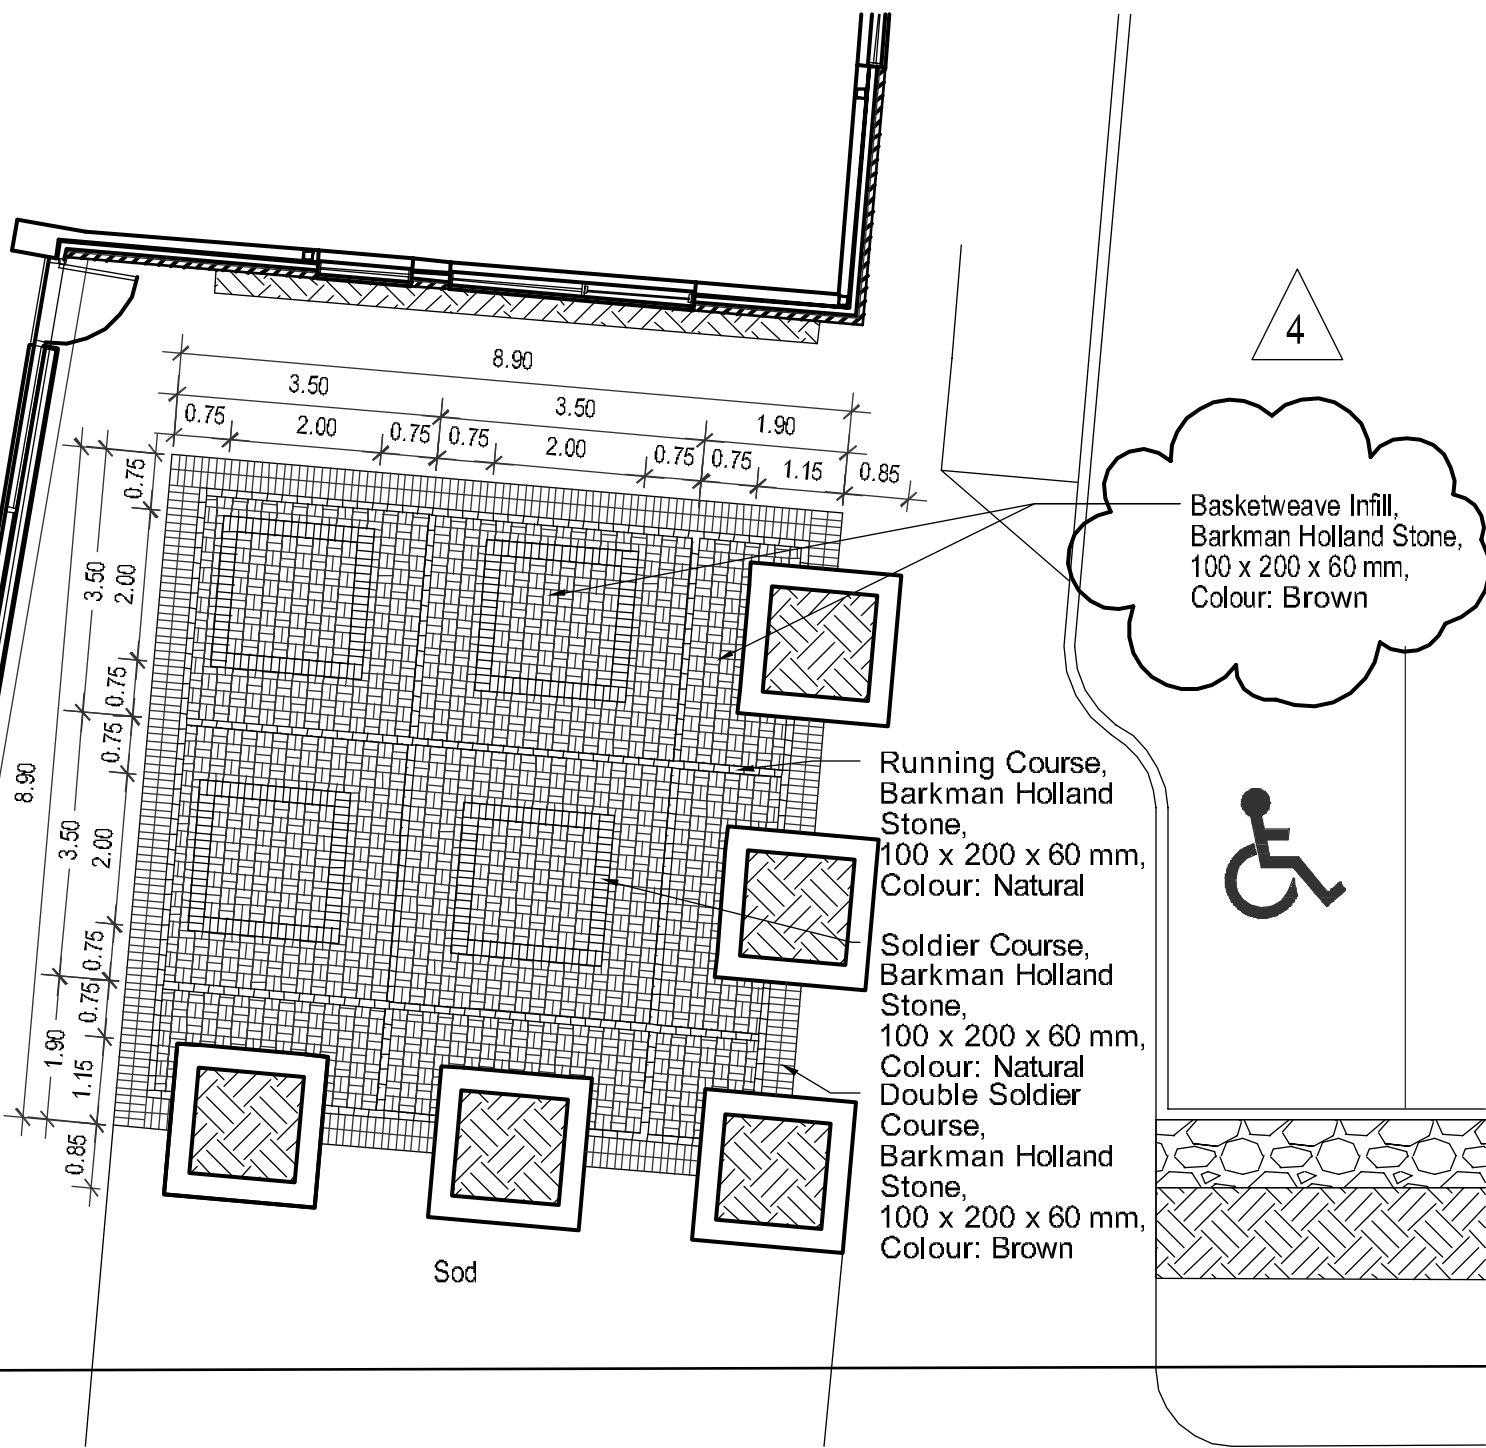

SCATLIFF + MILLER + MURRAY Inc.

A. SECTION LETTER OR DETAIL NUMBER,
 B. DRAWING WHERE SECTION OR DETAIL IS DRAWN,
 OR
 DRAWING WHERE SECTION OR DETAIL IS INDICATED,
 --- SECTION OR DETAIL SHOWN ON SAME DRAWING.

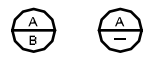

CLIENT	City of Winnipeg PP&D	SCALE	1:100
PROJECT TITLE	Bronx Park Community Centre Home of Good Neighbours Senior Centre	DATE	19-Jan-2008
DRAWING TITLE	To Replace 4/L5	FILE NO.	2006-065
		SHEET NO.	LR-2.0