

24
A7.1


WC 145

SCALE: 1:50 REVISED DRAWING

335 MM TO URINAL RIM
BARRIER FREE

500 MM TO URINAL RIM TYPICAL

152MM SELF COVERED BASE
C/W CC-1 AT TOP EDGE

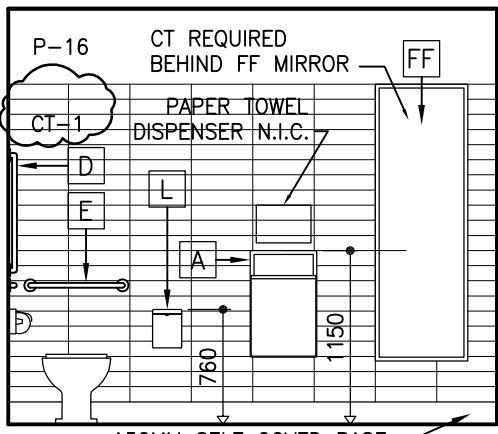

30
A7.1

WC 147

SCALE: 1:50 REVISED DRAWING

152MM SELF COVERED BASE
C/W CC-1 AT TOP EDGE

project
BRONX PARK C.C. HOME OF GNSC
WINNIPEG, MB.
REFERENCE DWG. 24/A-7.1 & 30/A-7.1
ELEVATION WC 145 & WC 147
sheet title

scale: 1:50
drawn by: MC
checked by: DH
date: 20-FEB.-2008

project no. #10 2006080
ADDENDUM #
RA-16
sheet no.

numberTEN
architectural group

winnipeg MB victoria BC
204 942.0981 250 360.2106

architecture ■ interior design ■ graphic design