


RUE AUBERT ST

TACHE AVENUE

RUE LA VERENDRYE ST

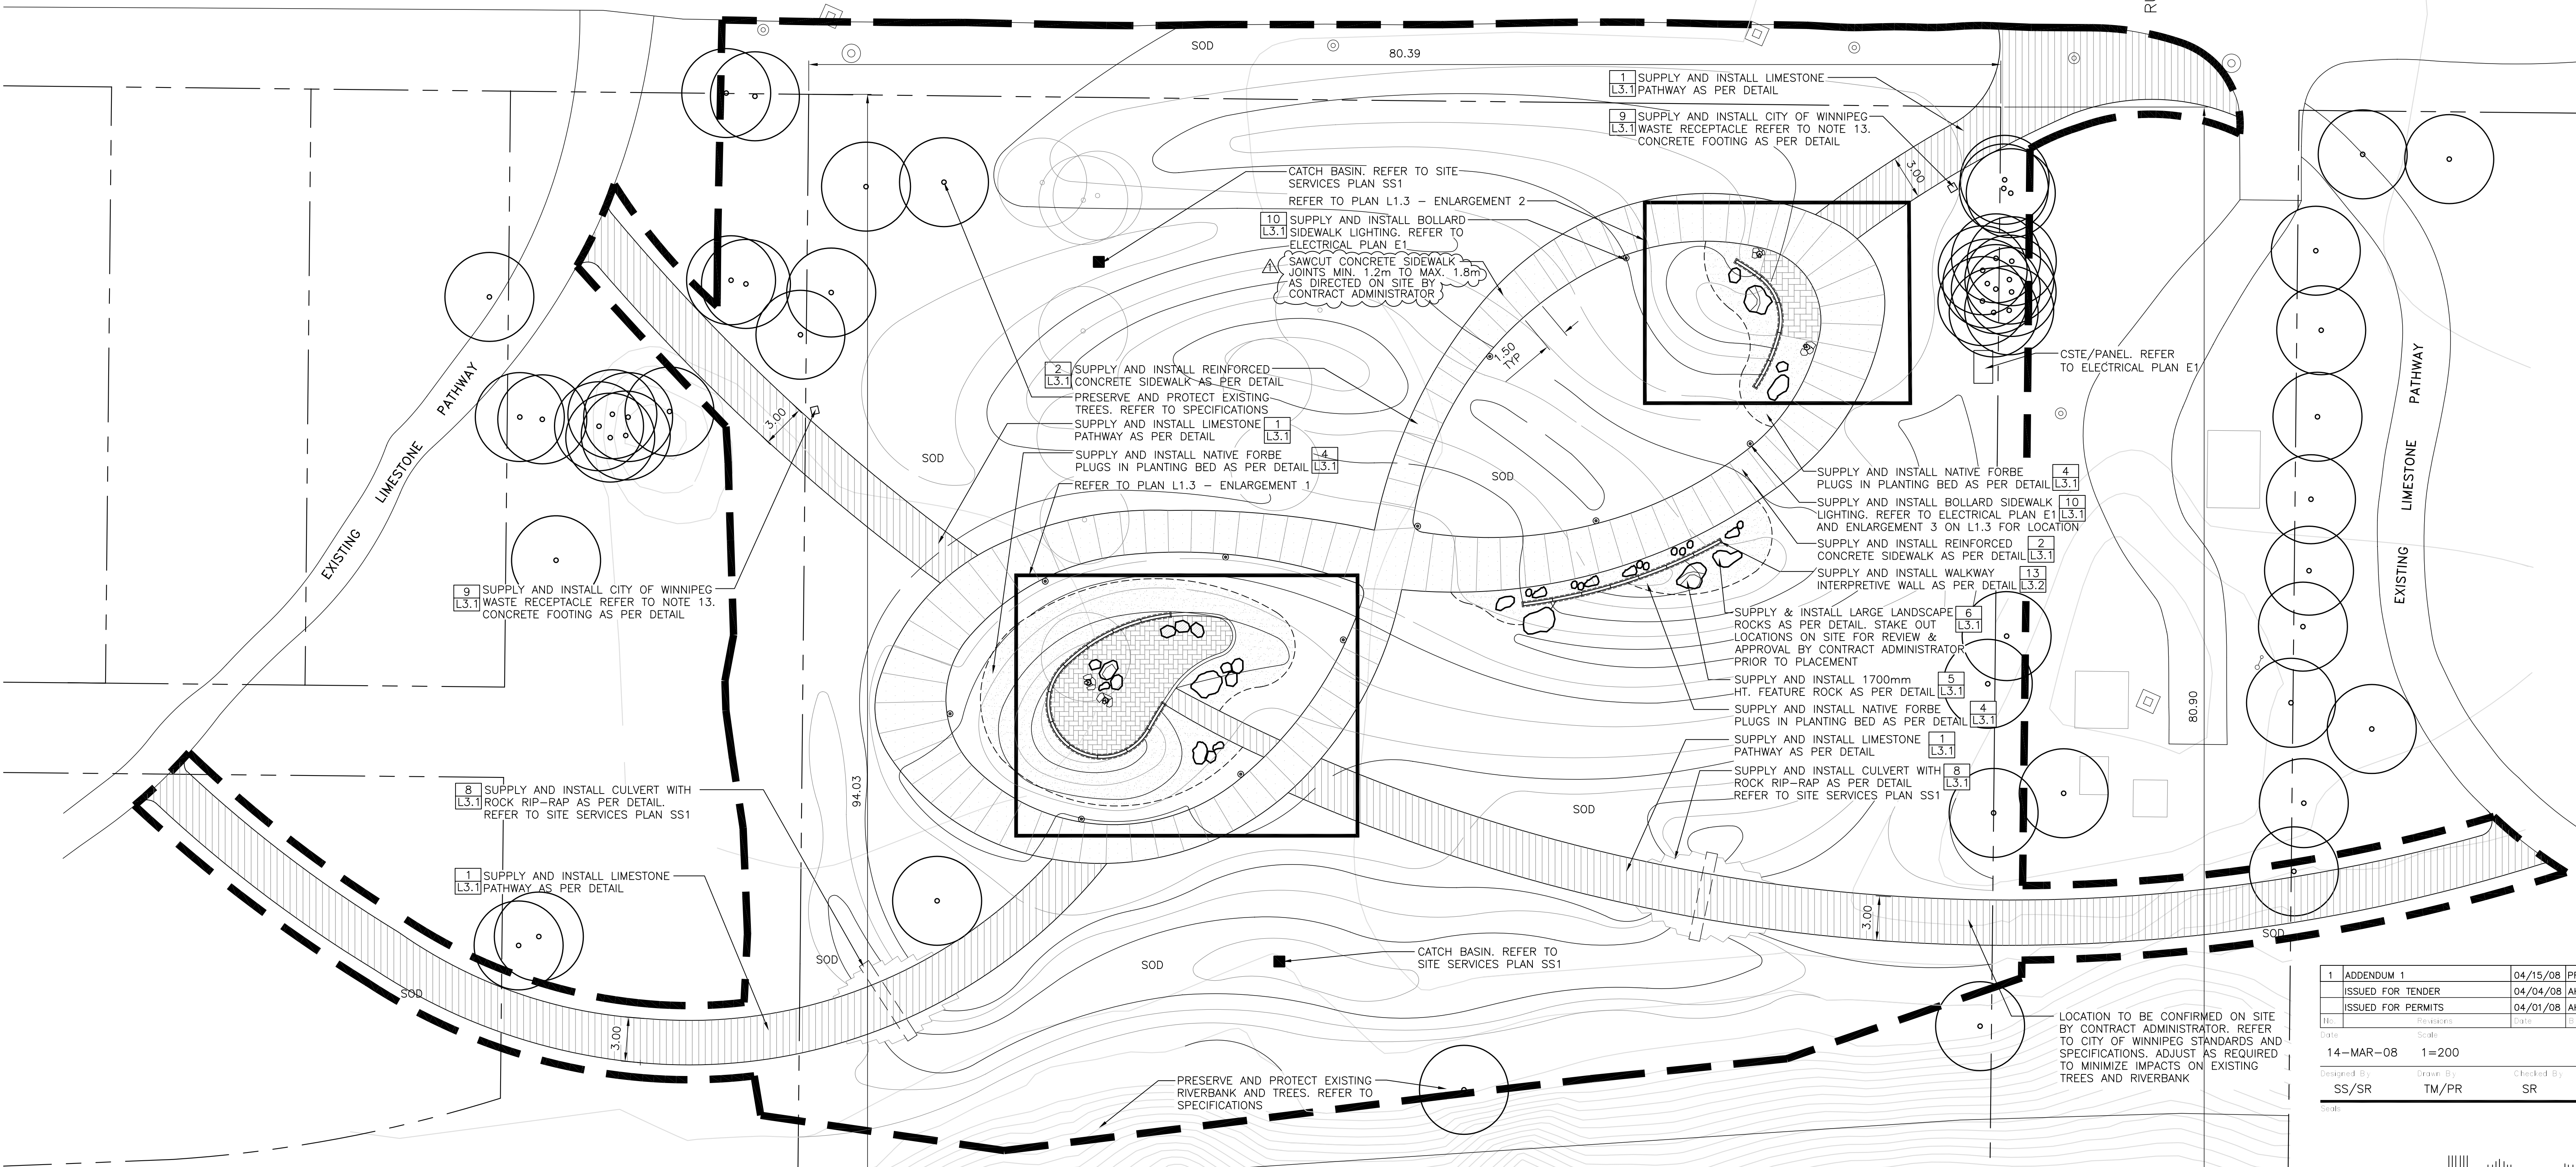

GENERAL NOTES

- CONTRACTOR TO CONFIRM LOCATION OF ALL UTILITIES PRIOR TO CONSTRUCTION.
- CONTRACTOR TO CONFIRM ALL DIMENSIONS AND REPORT ANY DISCREPANCIES TO CONTRACT ADMINISTRATOR PRIOR TO CONSTRUCTION.
- LAYOUT TO BE APPROVED BY CONTRACT ADMINISTRATOR PRIOR TO ANY CONSTRUCTION, OR REMOVALS.
- ALL DIMENSIONS ARE IN METRIC UNLESS OTHERWISE NOTED. DECIMAL NUMBERS INDICATE METERS.
- REFER ALSO TO WRITTEN SPECIFICATIONS.
- CONTRACTOR TO REPAIR ALL ON AND OFF SITE SODDED AREAS, TREES, CONCRETE, ROAD PAVING AND CURBS ETC., DAMAGED DURING CONSTRUCTION TO CONTRACT ADMINISTRATOR'S SATISFACTION AND TO THE CITY OF WINNIPEG STANDARDS AT HIS/HER OWN COST.
- CONSTRUCTION ACCESS TO BE LIMITED TO THE ROUTES SPECIFIED ON SITE BY CONTRACT ADMINISTRATOR
- FILL ALL HOLES/DEPRESSIONS LEFT BY EXCAVATION AND REMOVALS OPERATIONS TO DESIGN SUBGRADE ELEVATIONS WITH MATERIAL SUITABLE TO SURFACE FINISH. REFER TO GRADING PLAN AND WRITTEN SPECIFICATIONS
- DURING CONSTRUCTION, CONTRACTOR TO PROTECT TO CITY OF WINNIPEG STANDARDS ALL EXISTING TREES TO REMAIN
- CONTRACTOR IS RESPONSIBLE FOR ALL REMOVALS AS REQUIRED TO CONSTRUCT ALL WORKS AS SHOWN ON PLANS AND DETAILS. ALL ITEMS TO BE REMOVED MUST BE DISPOSED OF LEGALLY OFF SITE.
- ROCK PLACEMENT TO BE APPROVED ON SITE BY CONTRACT ADMINISTRATOR PRIOR TO INSTALLATION.
- PLACE ROCK BENCHES AS DIRECTED ON SITE BY CONTRACT ADMINISTRATOR.
- INSTALL STANDARD CITY OF WINNIPEG WASTE RECEPTACLE AS DIRECTED ON SITE BY CONTRACT ADMINISTRATOR.

LEGEND

- PROPERTY LINE
- LIMIT OF WORK
- PROPOSED LDS
- BOLLARD SIDEWALK LIGHTING
- FLOOD LIGHT
- CATCH BASIN
- GRAVEL
- LIMESTONE PATH
- CONCRETE SIDEWALK
- PRE-CAST CONCRETE UNIT PAVING
- NATIVE FORBE PLUGS PLANTING BED
- EXISTING TREE TO BE REMOVED
- EXISTING TREE TO REMAIN

1	ADDENDUM 1	04/15/08	PR
	ISSUED FOR TENDER	04/04/08	AH
	ISSUED FOR PERMITS	04/01/08	AH
Rev.	Revisions	Date	By
Date	Scale		
14-MAR-08	1=200		
Designed By	Drawn By	Checked By	
SS/SR	TM/PR	SR	



**ELZÉAR GOULET
MEMORIAL PARK
755 TACHE**

**LAYOUT /
PLANTING PLAN**

Project No. 07-050 Drawing No. L1.1