


1 / 18|19 SOUTH WINGWALL ELEVATION
1 : 50

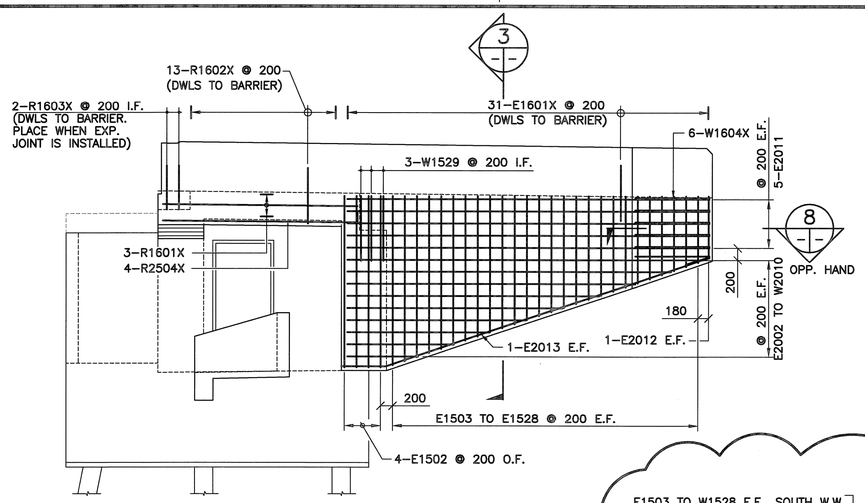


8 SECTION
1 : 20




2 / 18|19 NORTH WINGWALL ELEVATION
1 : 50

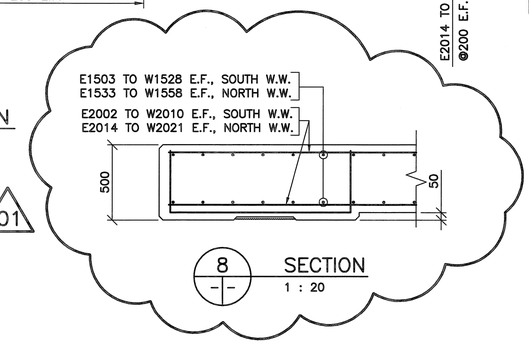


3 / -|- SECTION
1 : 20

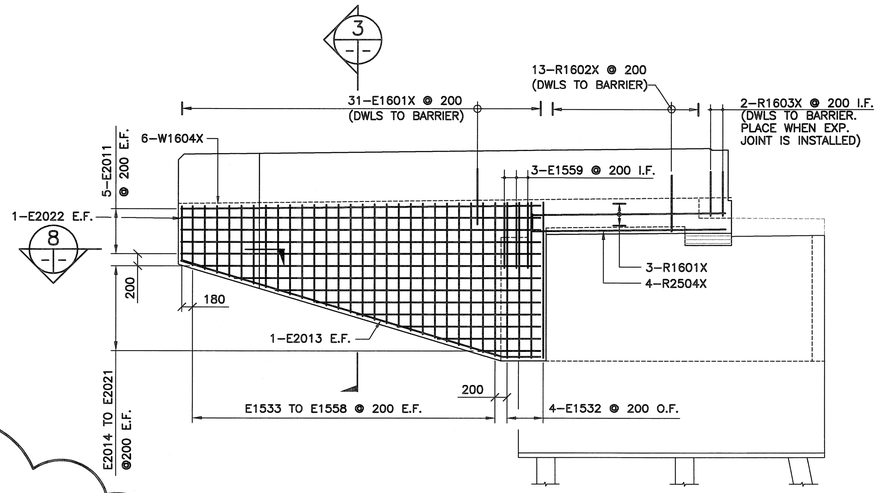


4 / -|- SECTION
1 : 20
TYP AT EACH SIDE

NOTE
BARS NOT CALLED UP HERE
REMAIN SAME AS SECTION 5

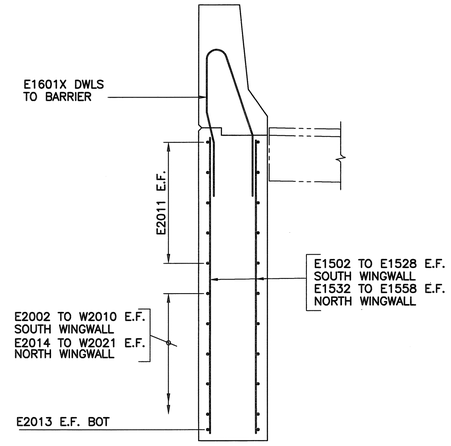


6 / 18|19 SECTION
1 : 20

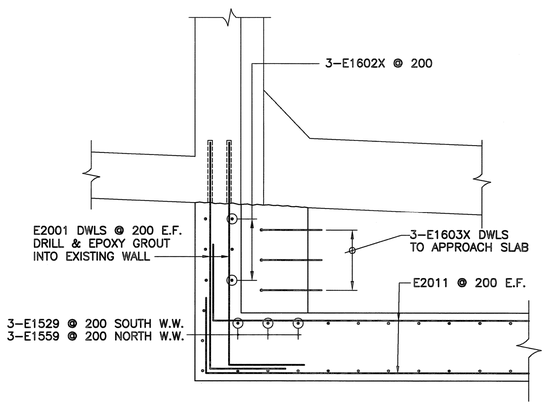


7 / 18|19 SECTION
1 : 20




5 / -|- SECTION
1 : 20
TYP AT EACH SIDE

DELETE NOTE
01

APEGM
Certificate of Authorization
Wardrop Engineering Inc.
No. 165 Expiry: April 30, 2006

| NO. | REVISIONS | DATE | BY |
|---|---|---|---|
| 01 | ISSUED FOR ADDENDUM #2 | 08.03.05 | ED |
| 00 | ISSUED FOR TENDER | 08.02.05 | E.F.S. |

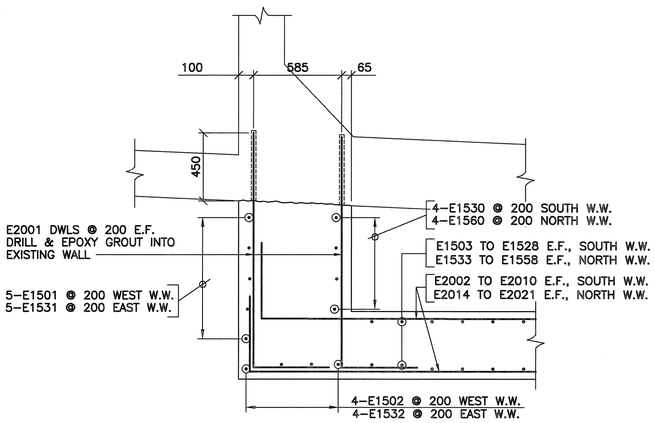B.M. ELEV. F.B.

WARDROP | Engineering Inc.

DESIGNED BY E.F.S. CHECKED BY
DRAWN BY P.S. APPROVED BY
HOR. SCALE: AS NOTED ACCEPTED BY DATE
VERTICAL:
DATE 08.02.05
RANDY FINGAS, P. ENG
BRIDGES PROJECTS ENGINEER

ORIGINAL DRAWING
REVISION "00" SEALED BY
E.F. SHEHATA
08.02.05

CONSULTANT DRAWING NO.
0600070700-DWG-S1119-00

Winnipeg

# THE CITY OF WINNIPEG
PUBLIC WORKS DEPARTMENT
TRANSPORTATION ENGINEERING DIVISION

FORT GARRY TWIN BRIDGES
WESTBOUND STRUCTURE REHABILITATION
AND ASSOCIATED ROADWORKS

CITY DRAWING NUMBER
B173-08-019W
SHEET 19 OF 54

EAST ABUTMENT
REINFORCING DETAILS 2

19