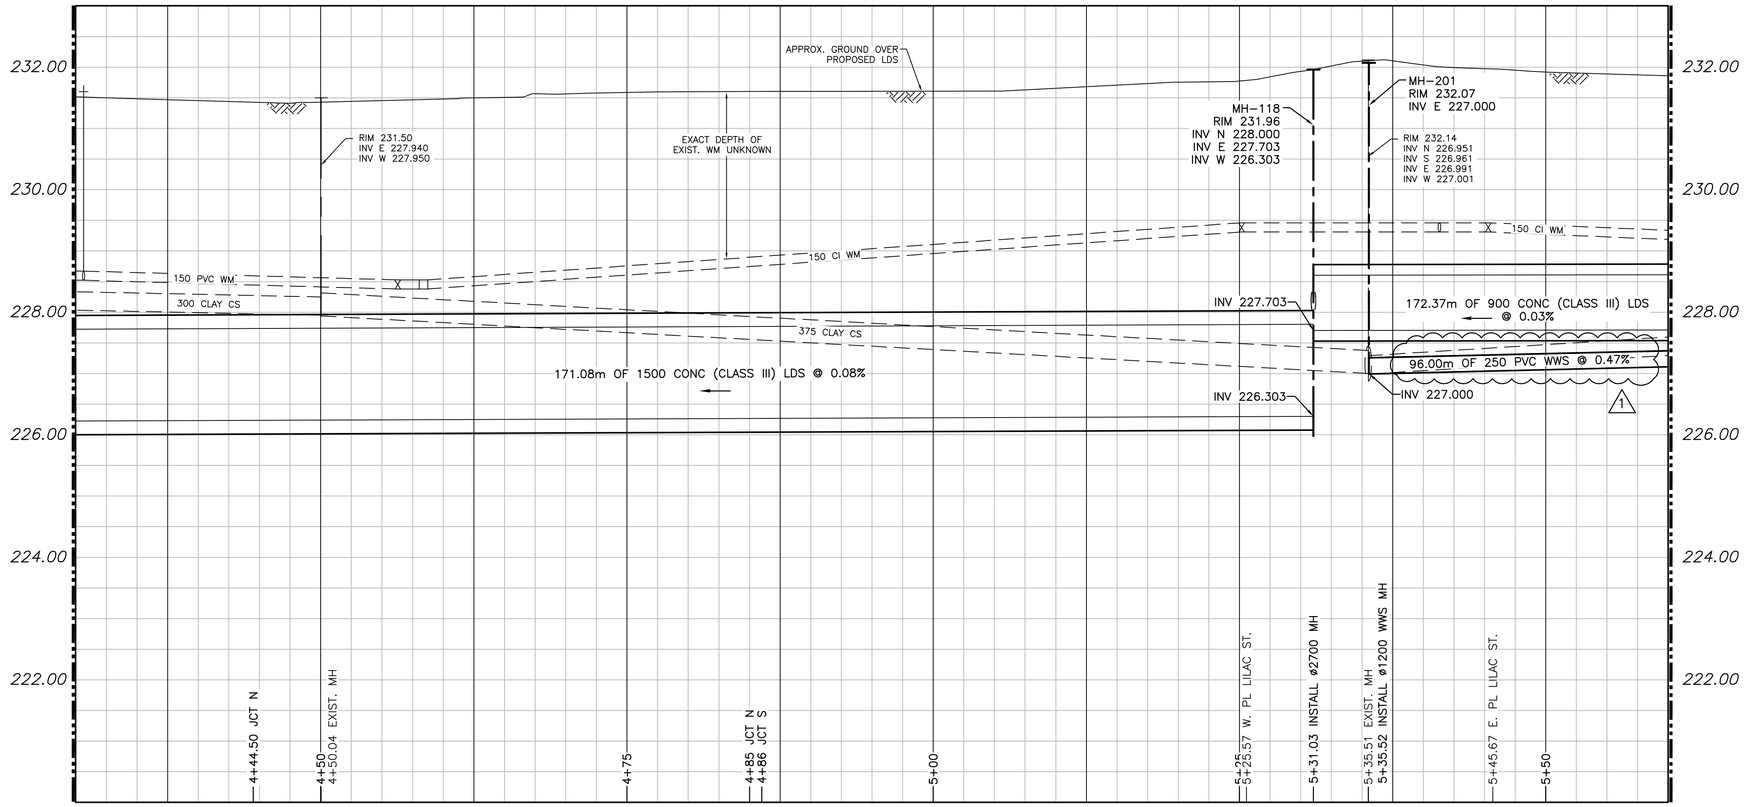


NOTE: CHAINAGES SHOWN ARE ALONG ℄ OF PROPOSED LDS

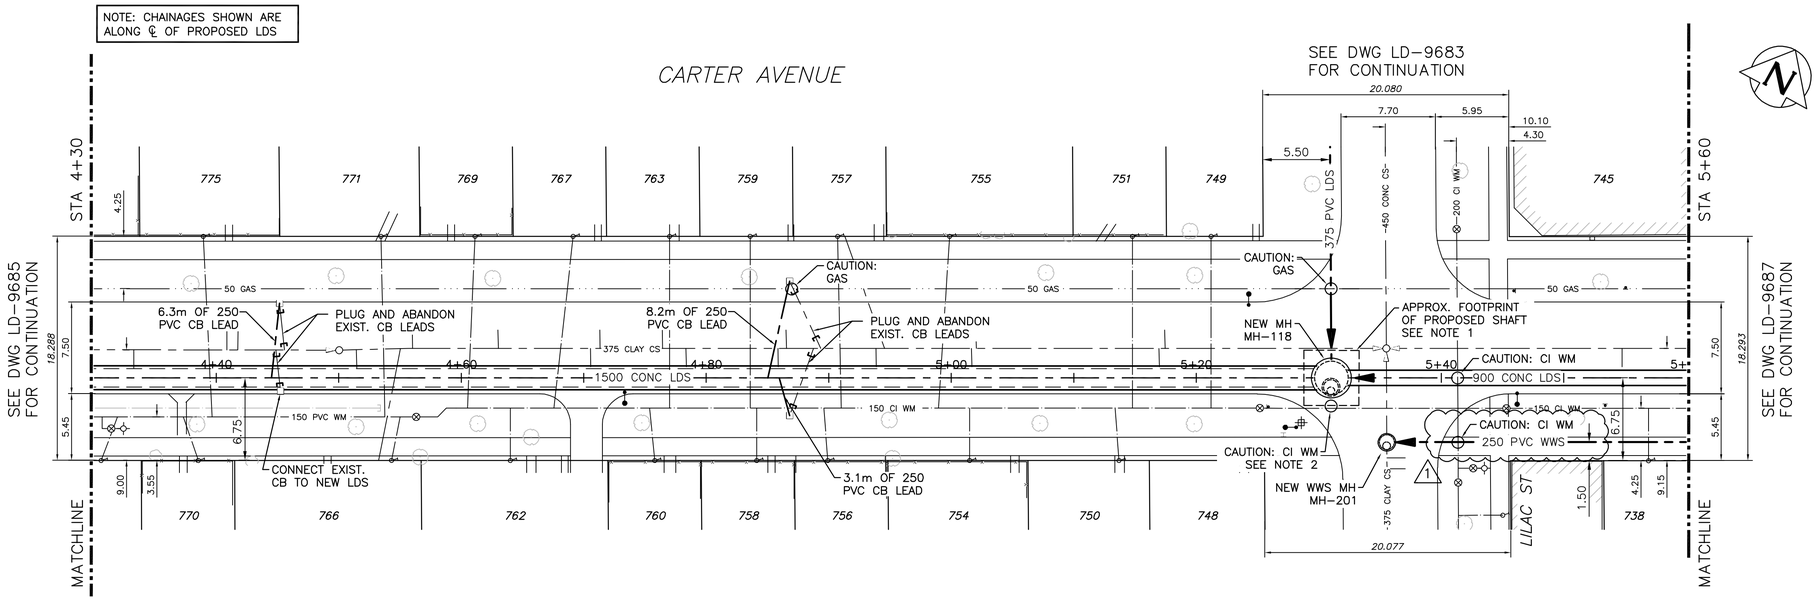


NOTES:

1. SHAFT LOCATION AS SHOWN IS FOR PLANNING PURPOSES ONLY. ACTUAL SHAFT DIMENSIONS, SHAPE AND LOCATION ARE THE RESPONSIBILITY OF THE CONTRACTOR.
2. IF EXISTING PVC WATERMAIN IS TOO CLOSE TO SHAFT, CONTRACTOR TO TEMPORARILY RELOCATE WATERMAIN (AS PER SPECIFICATIONS) AND KEEP IT IN SERVICE. CONTRACTOR WILL NOT BE ALLOWED TO TEMPORARILY CUT AND CAP WATERMAIN.
3. ALL SERVICES SHALL BE RENEWED TO PROPERTY LINE.

METRIC
WHOLE NUMBERS INDICATE MILLIMETRES
DECIMALIZED NUMBERS INDICATE METRES

0.0 5.0 10.0 15.0 20.0 25.0

## PROPERTY LIMITS DELINEATION

DELINEATION OF PROPERTY LIMITS AS SHOWN ON THIS DRAWING DOES NOT REPRESENT A "LEGAL SURVEY". JACOBS AND KGS GROUP MAKE NO REPRESENTATION OR WARRANTY AS TO THE ACCURACY OF PROPERTY LIMITS DELINEATED ON THIS DRAWING, NOR ON THE DIMENSIONAL ACCURACY OF DRAWING FEATURES RELATIVE TO THOSE PROPERTY LIMITS.

## WARNING

IF POWER EQUIPMENT OR EXPLOSIVES ARE TO BE USED FOR EXCAVATION ON THIS PROJECT THE CONTRACTOR MUST:

1) NOTIFY THE GAS COMPANY OF THE PROPOSED LOCATION OF EXCAVATION.

2) TAKE PRECAUTION TO AVOID DAMAGE TO GAS COMPANY INSTALLATIONS.

SEE PROVINCIAL REGULATION 210/72 FOR DETAILS

## LOCATION APPROVED
UNDERGROUND STRUCTURES

SUPV. U/G STRUCTURES COMMITTEE — DATE

NOTE:
LOCATION OF UNDERGROUND STRUCTURES AS SHOWN ARE BASED ON THE BEST INFORMATION AVAILABLE BUT NO GUARANTEE IS GIVEN THAT ALL EXISTING UTILITIES ARE SHOWN OR THAT THE GIVEN LOCATIONS ARE EXACT. CONFIRMATION OF EXISTENCE AND EXACT LOCATION OF ALL SERVICES MUST BE OBTAINED FROM THE INDIVIDUAL UTILITIES BEFORE PROCEEDING WITH CONSTRUCTION.

B.M. ELEV.

| NO. | REVISIONS | DATE | BY |
|---|---|---|---|
| 1 | ISSUED FOR ADDENDUM NO. 1 | 21/04/28 | JBC |
| 0 | ISSUED FOR TENDER | 21/03/26 | JBC |

Jacobs KGS GROUP

| | |
|---|---|
| DESIGNED BY SDG | CHECKED BY MD |
| DRAWN BY JBC | APPROVED BY |
| HOR. SCALE: 1:250 VERTICAL: 1:50 | RELEASED FOR CONSTRUCTION: DATE |

ENGINEER'S SEAL
ORIGINAL SIGNED BY S.D. GODON ON 21/04/07

CONSULTANT DRAWING NO.
C-2013

ENGINEERS GEOSCIENTISTS MANITOBA
Certificate of Authorization
CH2M HILL Canada Ltd.
No. 1441

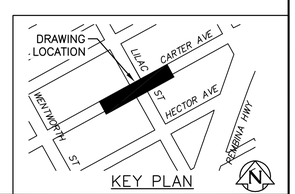


Winnipeg
THE CITY OF WINNIPEG
WATER AND WASTE DEPARTMENT

PROJECT TITLE
COCKBURN AND CALROSSIE COMBINED SEWER RELIEF WORKS – CONTRACT 6B
CARTER AVENUE
57.1 E WENTWORTH STREET TO 14.3 E LILAC STREET

SHEET 14 OF 20
COMPUTER FILE NAME C-2013.dwg
CITY DRAWING NUMBER LD-9686

FileName C:\pw_workdir\ch2mhill_wbg\jcortez1\d0445899\