




**A** SECTION - NAIRN AVE - STA. 1+095  
SCALE: H=1:100, V=1:50

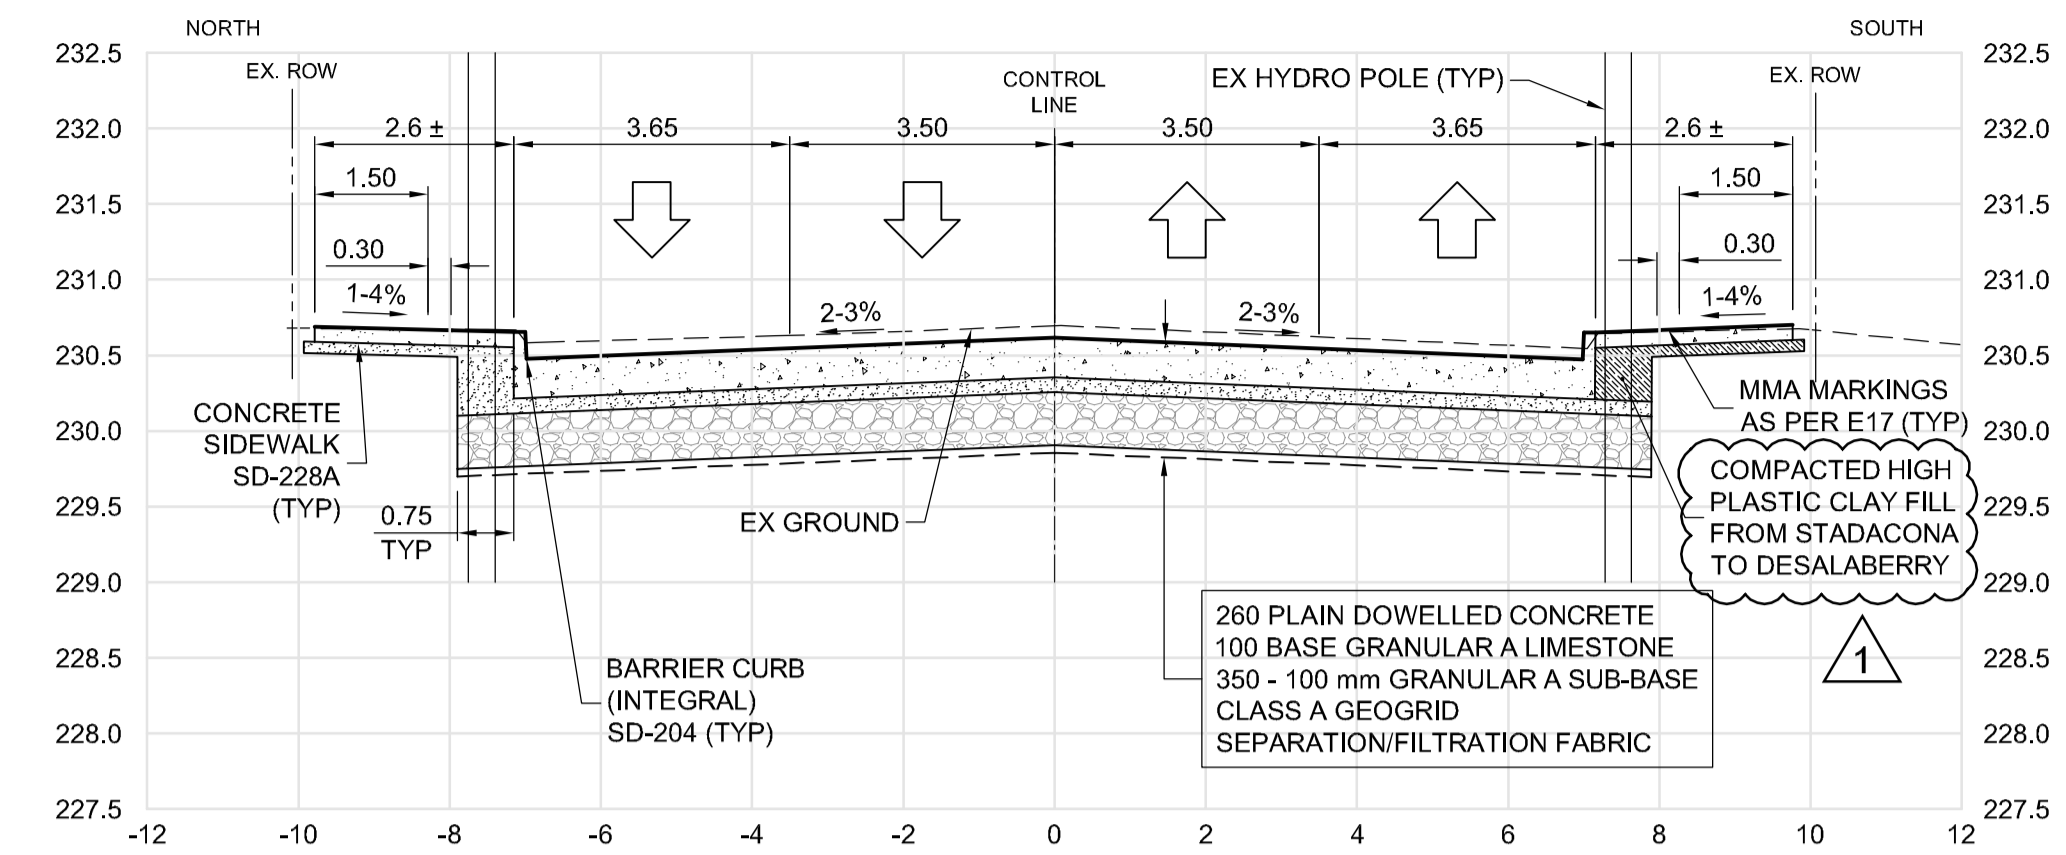


**B** SECTION - NAIRN AVE - STA. 1+295  
SCALE: H=1:100, V=1:50

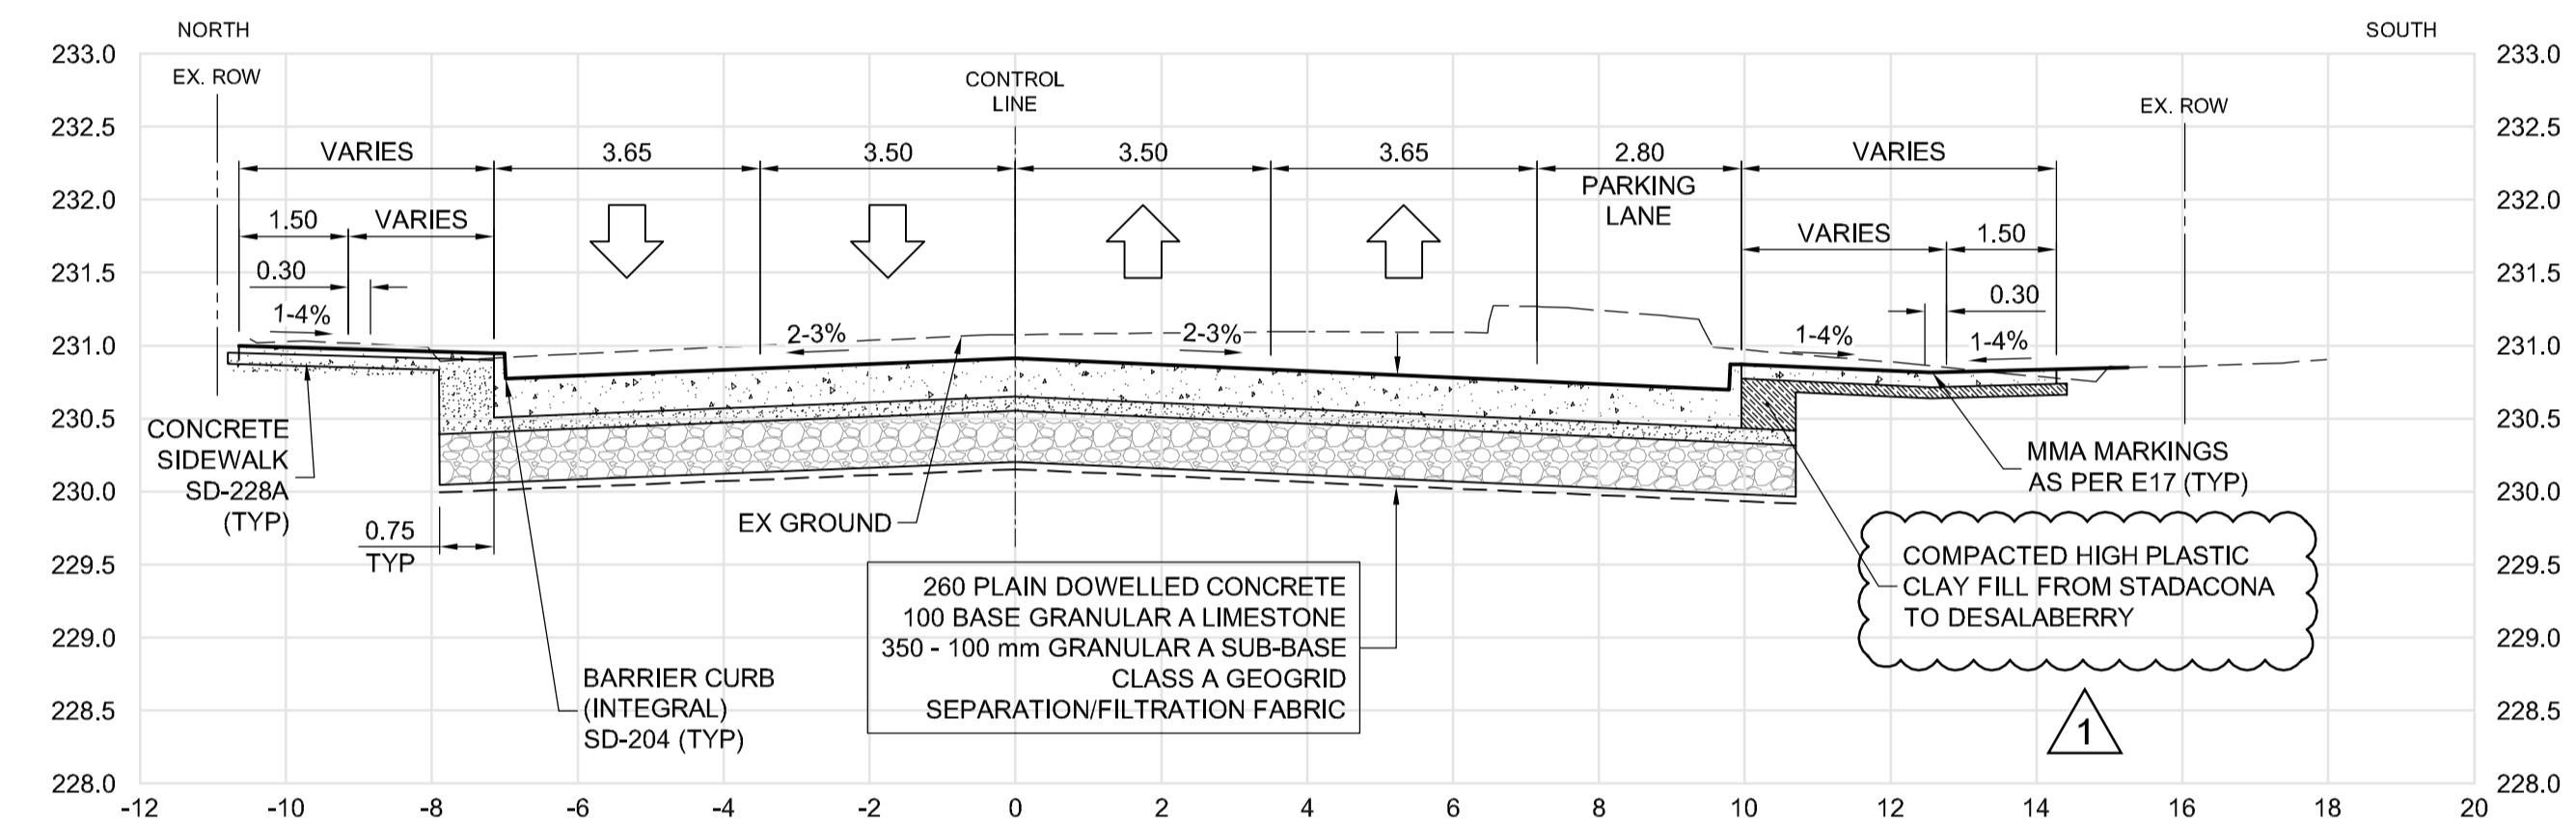

**C** SECTION - NAIRN AVE - STA. 1+375  
SCALE: H=1:100, V=1:50

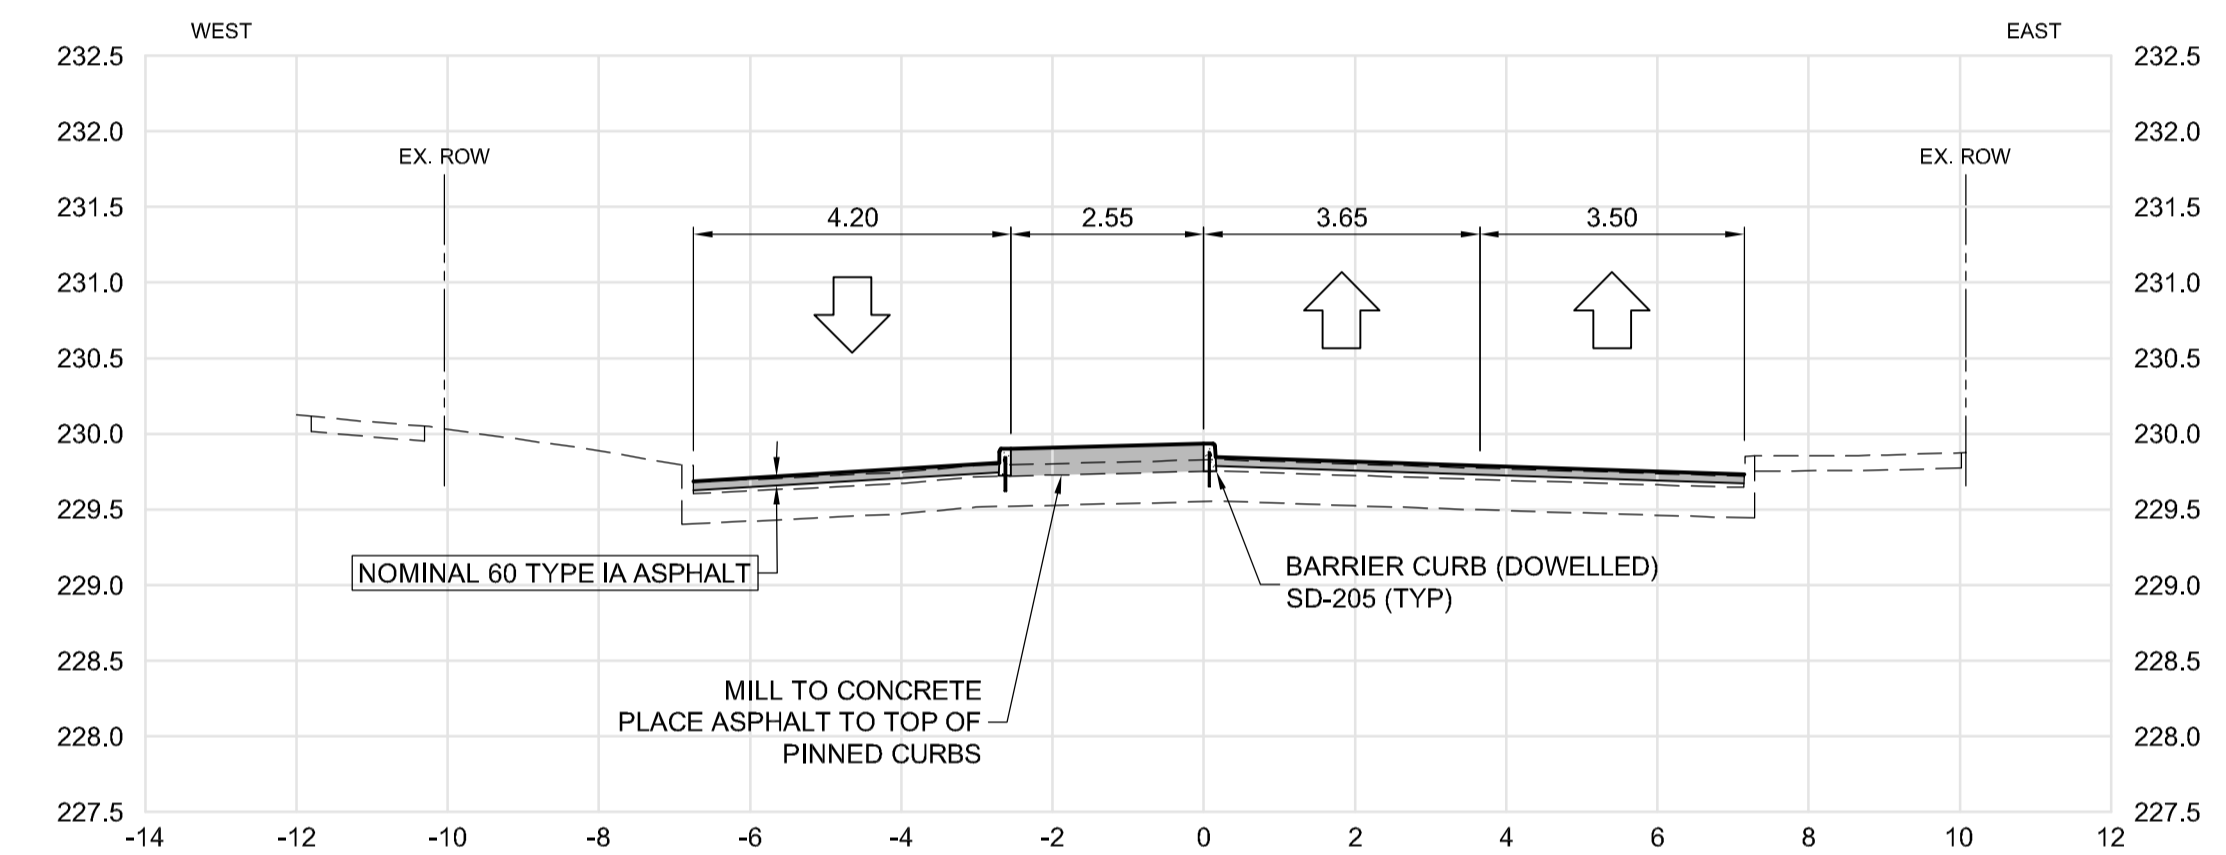

**D** SECTION - STADACONA ST - STA. 1+085  
SCALE: H=1:100, V=1:50

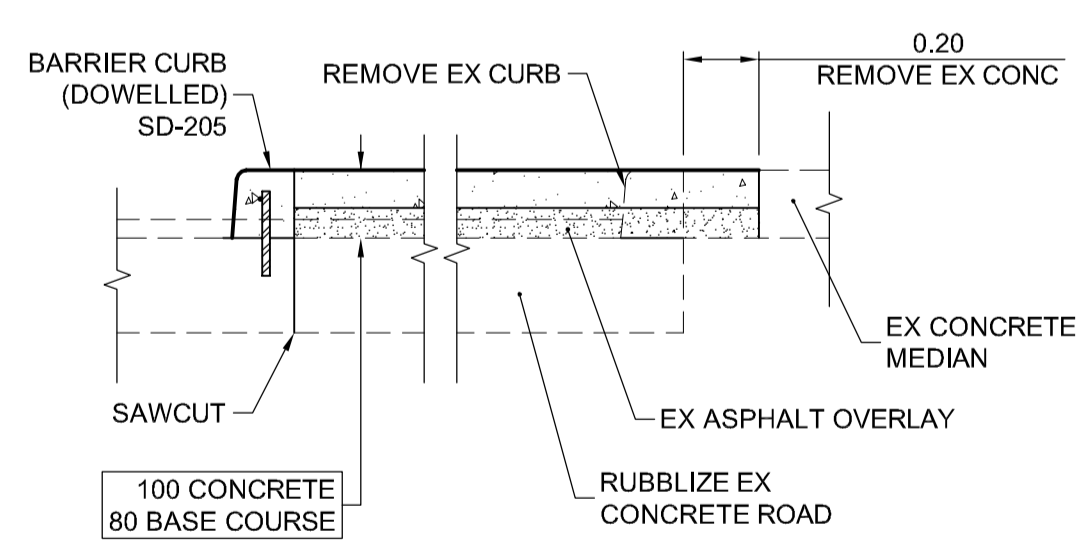

**1** CONCRETE MEDIAN EXTENSION  
SCALE: 1:25

**PRELIMINARY ONLY  
NOT FOR CONSTRUCTION**

**ES ENGINEERS  
GEOSCIENTISTS  
MANITOBA**  
Certificate of Authorization  
**Dillon Consulting Limited (MB)**  
No. 1789 Date: 2022/03/09

UNDERGROUND STRUCTURES APPROVED BY NAV KAHLON, C.E.T. 2022/03/11 SUPV. U/G STRUCTURES DATE		B.M. ELEV.	DESIGNED BY TJH/MRD DRAWN BY TJH CHECKED BY TS APPROVED BY TJP	ENGINEER'S SEAL	<b>THE CITY OF WINNIPEG</b> PUBLIC WORKS DEPARTMENT <b>2021 REGIONAL STREET PROGRAM</b> NAIRN AVENUE RECONSTRUCTION AND WATERMAIN RENEWAL	CITY DRAWING NUMBER P-3556-10
LOCATION OF UNDERGROUND STRUCTURES AS SHOWN ARE BASED ON THE BEST INFORMATION AVAILABLE, BUT NO GUARANTEE IS GIVEN THAT ALL EXISTING UTILITIES ARE SHOWN OR THAT THE GIVEN LOCATIONS ARE EXACT. CONFIRMATION OF EXISTENCE AND EXACT LOCATION OF ALL SERVICES MUST BE OBTAINED FROM THE INDIVIDUAL UTILITIES BEFORE PROCEEDING WITH CONSTRUCTION.		1 ISSUED FOR ADDENDUM #1 22/03/18 TJP 0 ISSUED FOR TENDER 22/03/09 TJP NO. REVISIONS DATE BY	HOR. SCALE AS NOTED VERTICAL AS NOTED	RELEASED FOR CONSTRUCTION DATE		SHEET 10 OF 21 CONSULTANT DRAWING NUMBER
				CONSULTANT PROJECT NUMBER 21-2462	NAIRN AVE - SECTIONS	CONSULTANT DRAWING NUMBER

C:\pwworking\directory\projects\2021\401p\m57051\212462-CI-CO-SECTIONS.dwg