
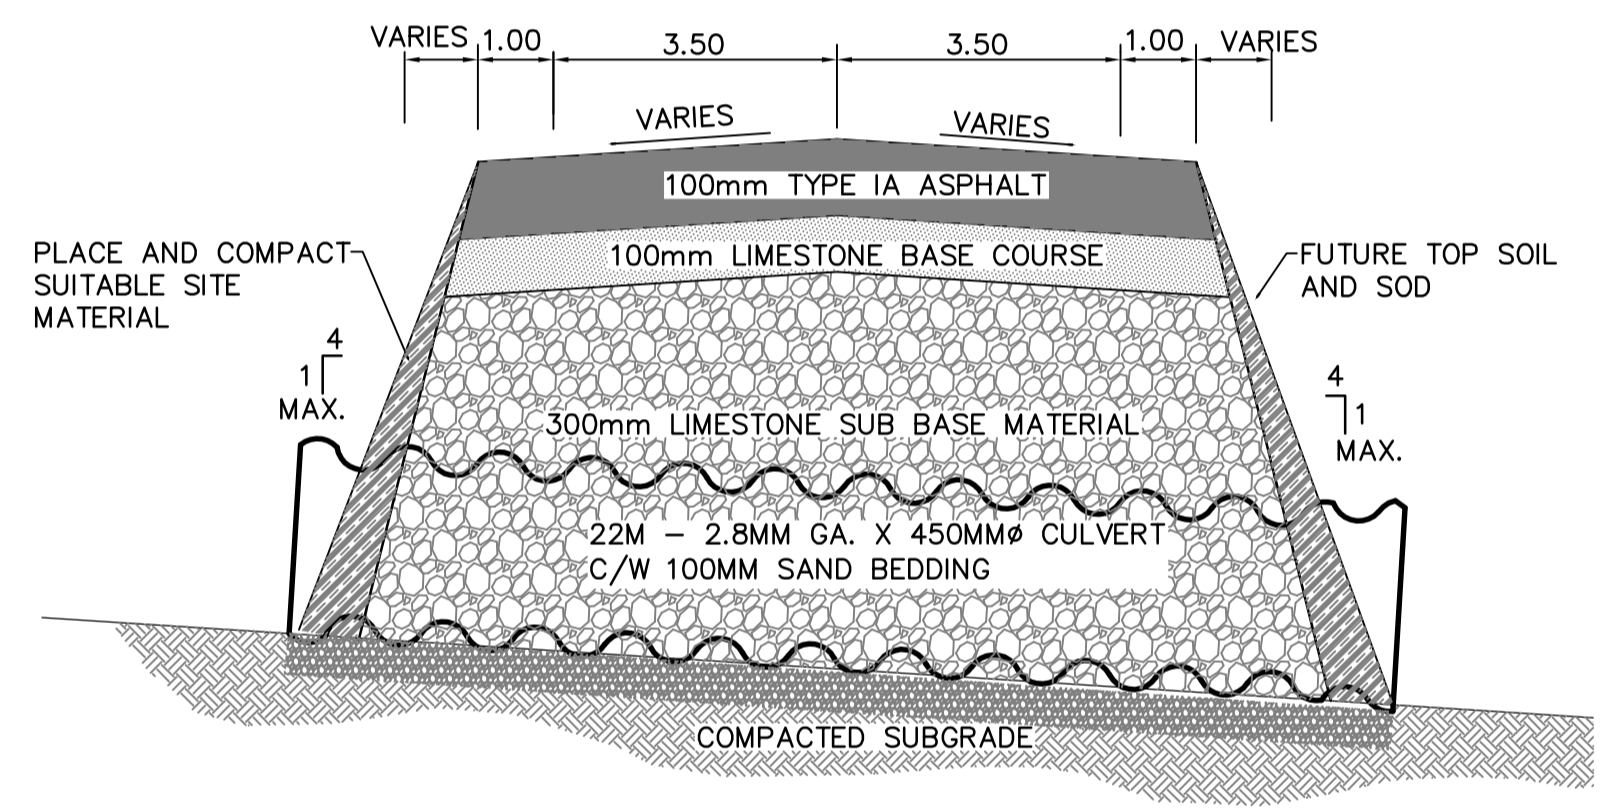
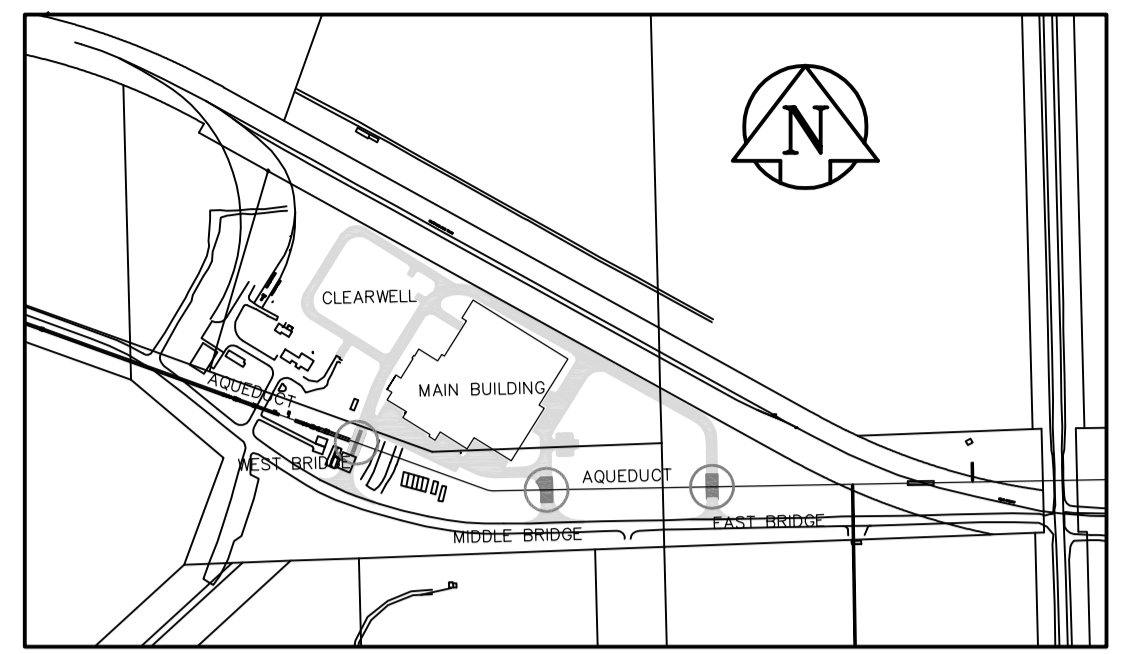


HIGH POINT ELEV = 237.646
 HIGH POINT STA = 0+578.323
 PVI STA = 0+581.500
 PVI ELEV = 238.060
 A.D. = 10.9744
 K = 2.8662

NOTE: PLACE 50mm ASPHALT TYPE 1A PAVEMENT IN THIS CONTRACT ONLY

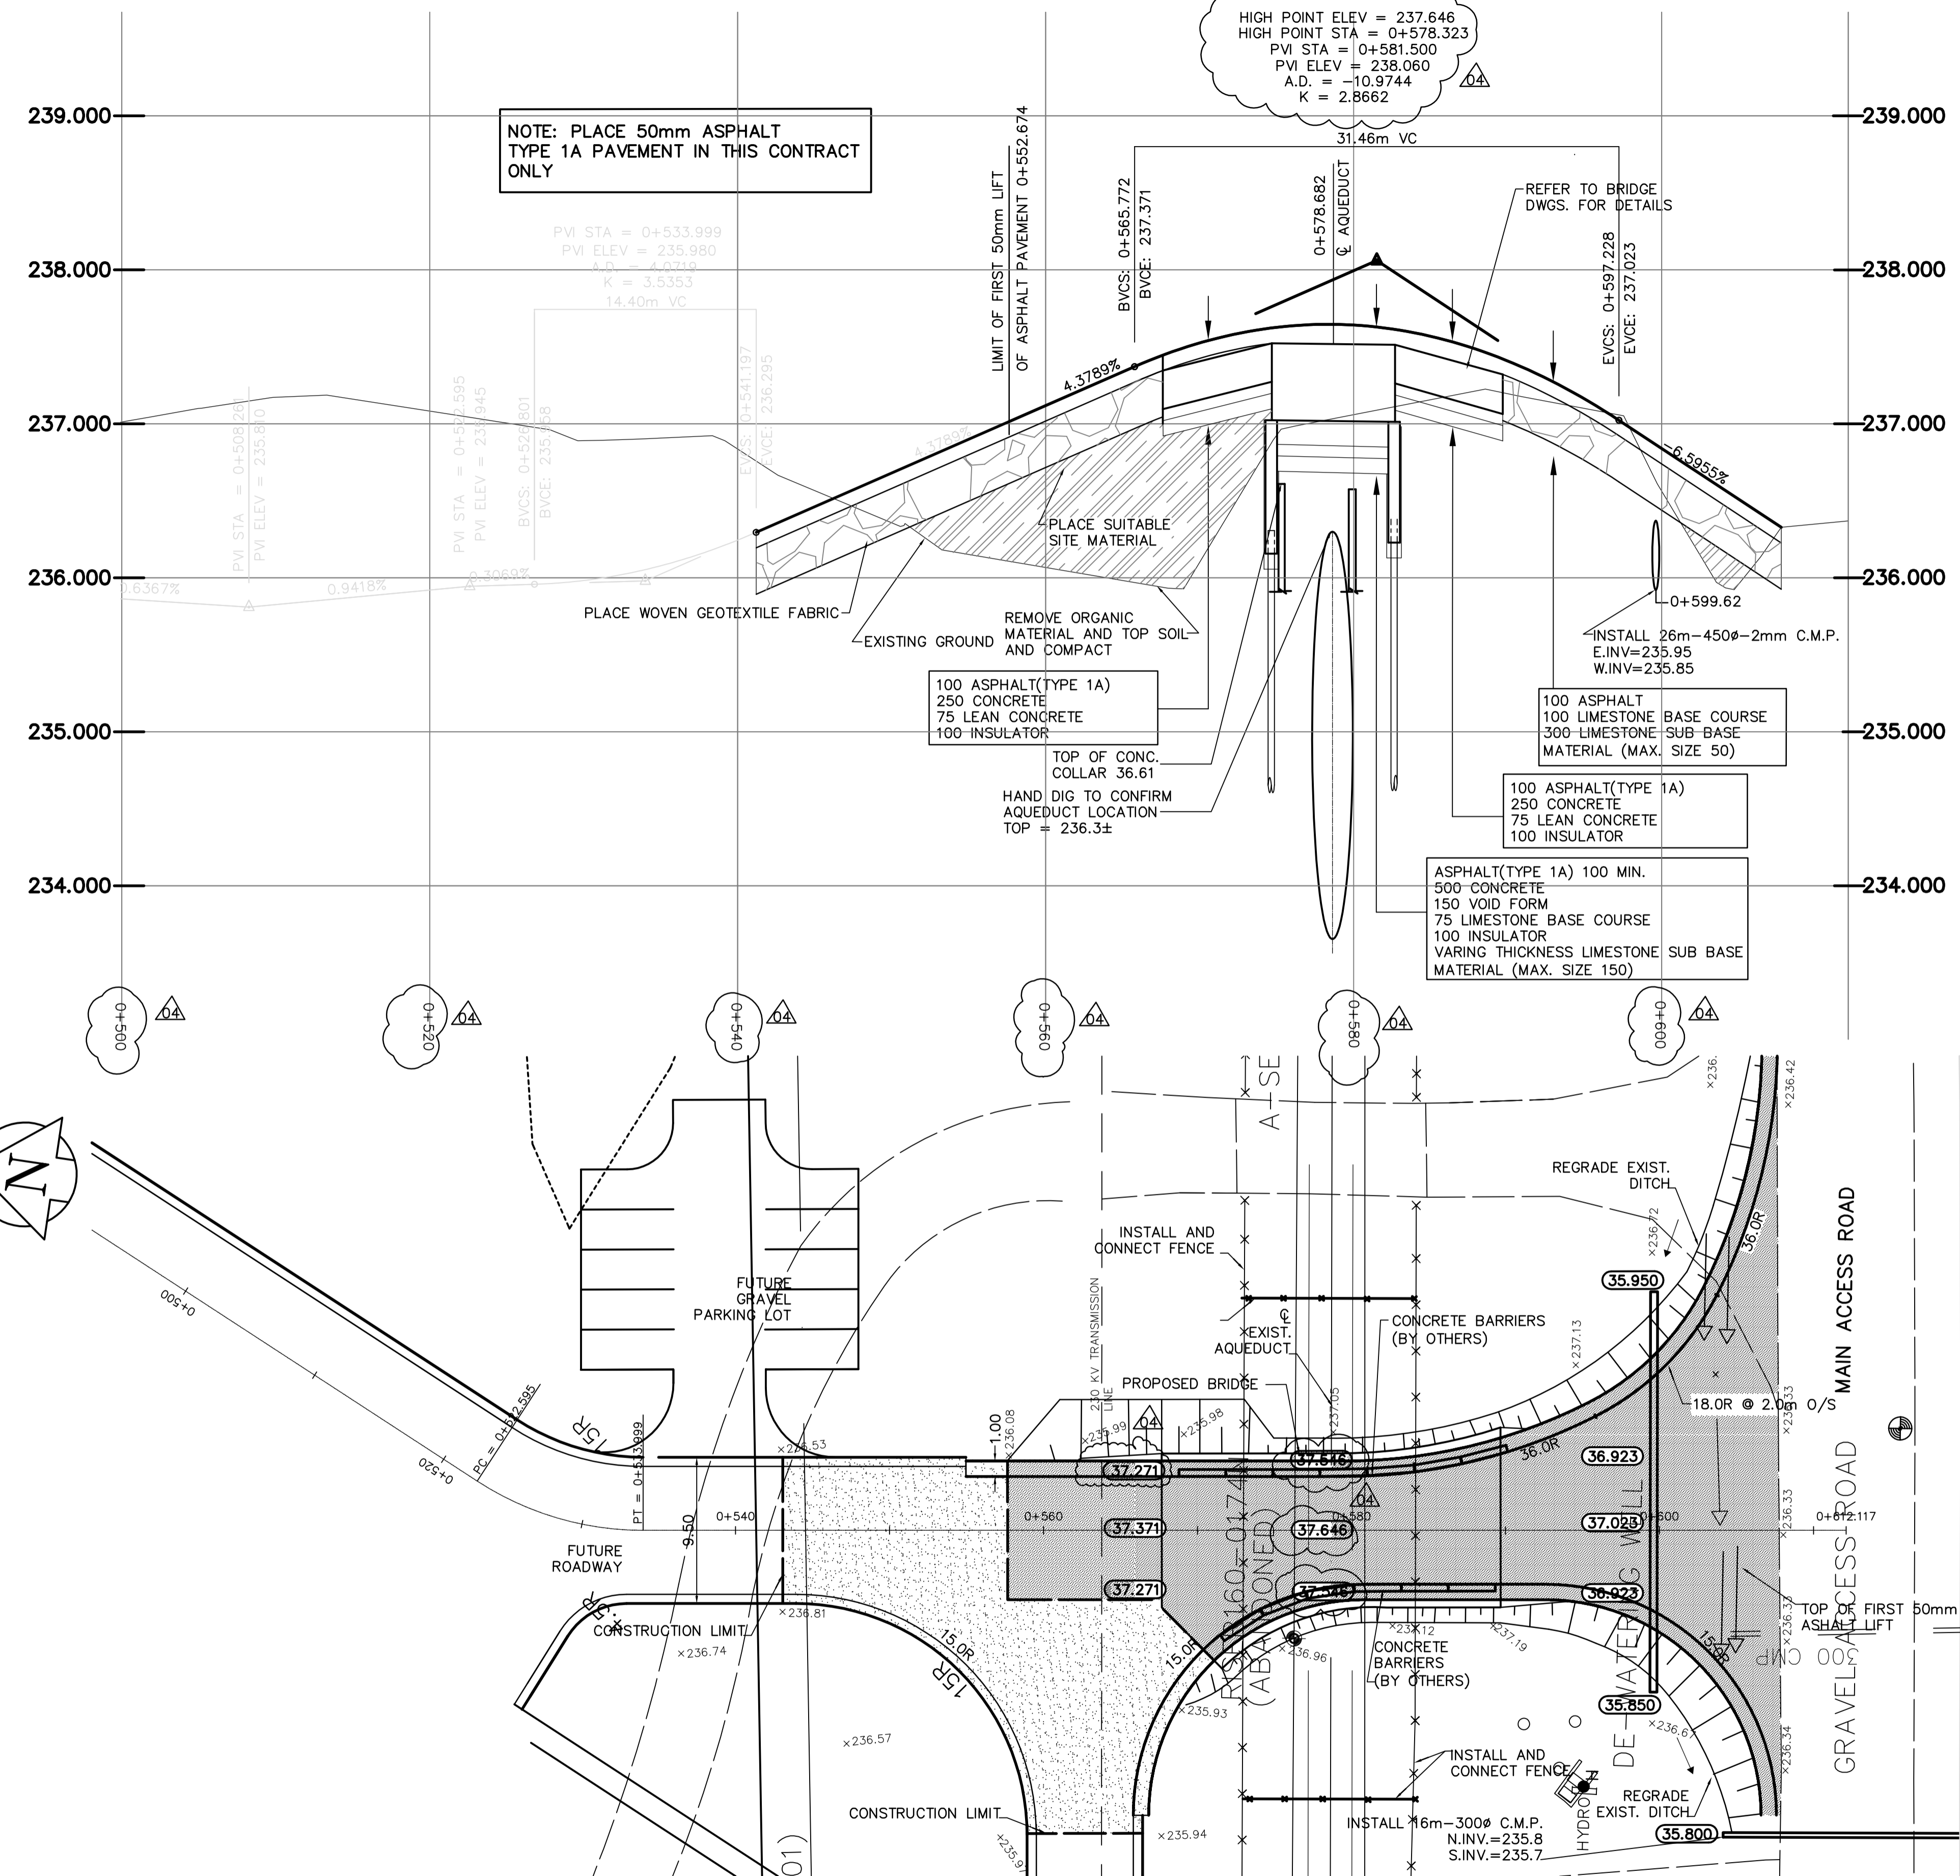

REFERENCE NOTES:
 A. ADD 200.00 TO OBTAIN GEODETIC DATUM
 B. ALL EXISTING UNDERGROUND UTILITIES SHALL BE CONFIRMED PRIOR TO CONSTRUCTION.

INFORMATION ONLY

METRIC
 WHOLE NUMBERS INDICATE MILLIMETRES
 DECIMALIZED NUMBERS INDICATE METRES

150 mm W.M.	WATERMAIN	150 mm W.M.	HYDRO M.T.S.	CONCRETE	PROPERTY LINE	SURVEY BAR	ELEVATION	TREE	ANODE	CONCRETE SIDEWALK	FENCE
Hydrant symbol	HYDRANT	Valve symbol	VALVE	Asphalt symbol	ASPHALT	Survey bar symbol	SURVEY BAR	Tree symbol	TREE	Concrete sidewalk symbol	CONCRETE SIDEWALK
300mm L.D.S.	LAND DRAINAGE SEWER	250mm L.D.S.	WASTEWATER SEWER	Manhole symbol	MANHOLE	Catch basin symbol	CATCH BASIN	Curb inlet symbol	CURB INLET	Junctions symbol	JUNCTIONS
250mm W.W.S.	WASTEWATER SEWER	250mm W.W.S.	WASTEWATER SEWER	Culvert symbol	CULVERT	Gas symbol	GAS	Existing symbol	EXISTING	Proposed symbol	PROPOSED

APEGM
 Certificate of Authorization
 Earth Tech Canada Inc.
 No. 730

B.M. ELEV.			
04	583-2005-FI-0-083-ET	06/10/17	BC
03	583-2005-FI-0-081	06/10/13	JC
02	ISSUED FOR CONSTRUCTION	06/06/02	BC
01	583-2005 ADDENDUM 3	06/03/09	KC
00	ISSUED FOR TENDER	06/02/07	JC
NO.	REVISIONS	DATE	BY

DESIGNED BY	JNC	CHECKED BY	JNC
DRAWN BY	PAAP/BC	APPROVED BY	DJT
SCALE:	1:250	RELEASED FOR CONSTRUCTION BY:	R. SOROKOWSKI
DATE	2005/08/29	DATE	2006/02/07

ENGINEER'S SEAL
 ORIGINAL SIGNED BY
 J.N. CRANG
 2006/02/07

THE CITY OF WINNIPEG
 WATER AND WASTE DEPARTMENT
 ENGINEERING DIVISION

WATER TREATMENT PLANT
 AQUEDUCT BRIDGES
 FOUNDATIONS AND CONCRETE STRUCTURES

CIVIL
 ROADWORKS AND MIDDLE BRIDGE
 PLAN-PROFILE

CITY FILE NUMBER
 SHEET OF
 CITY DRAWING NUMBER
1-060N-A-C0162-001-04D