




**A** DETAIL  
WT-S038 1:10

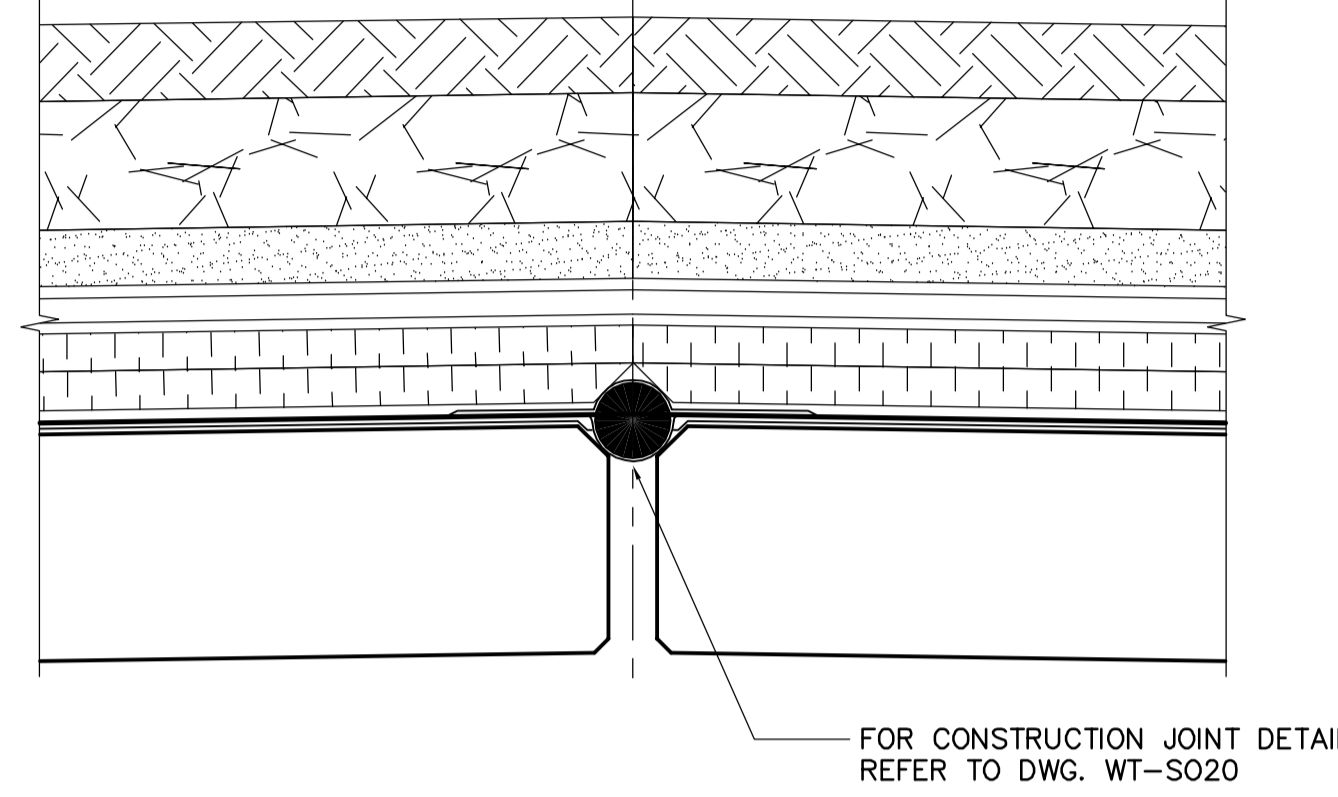

**2** SECTION  
WT-S038 1:10

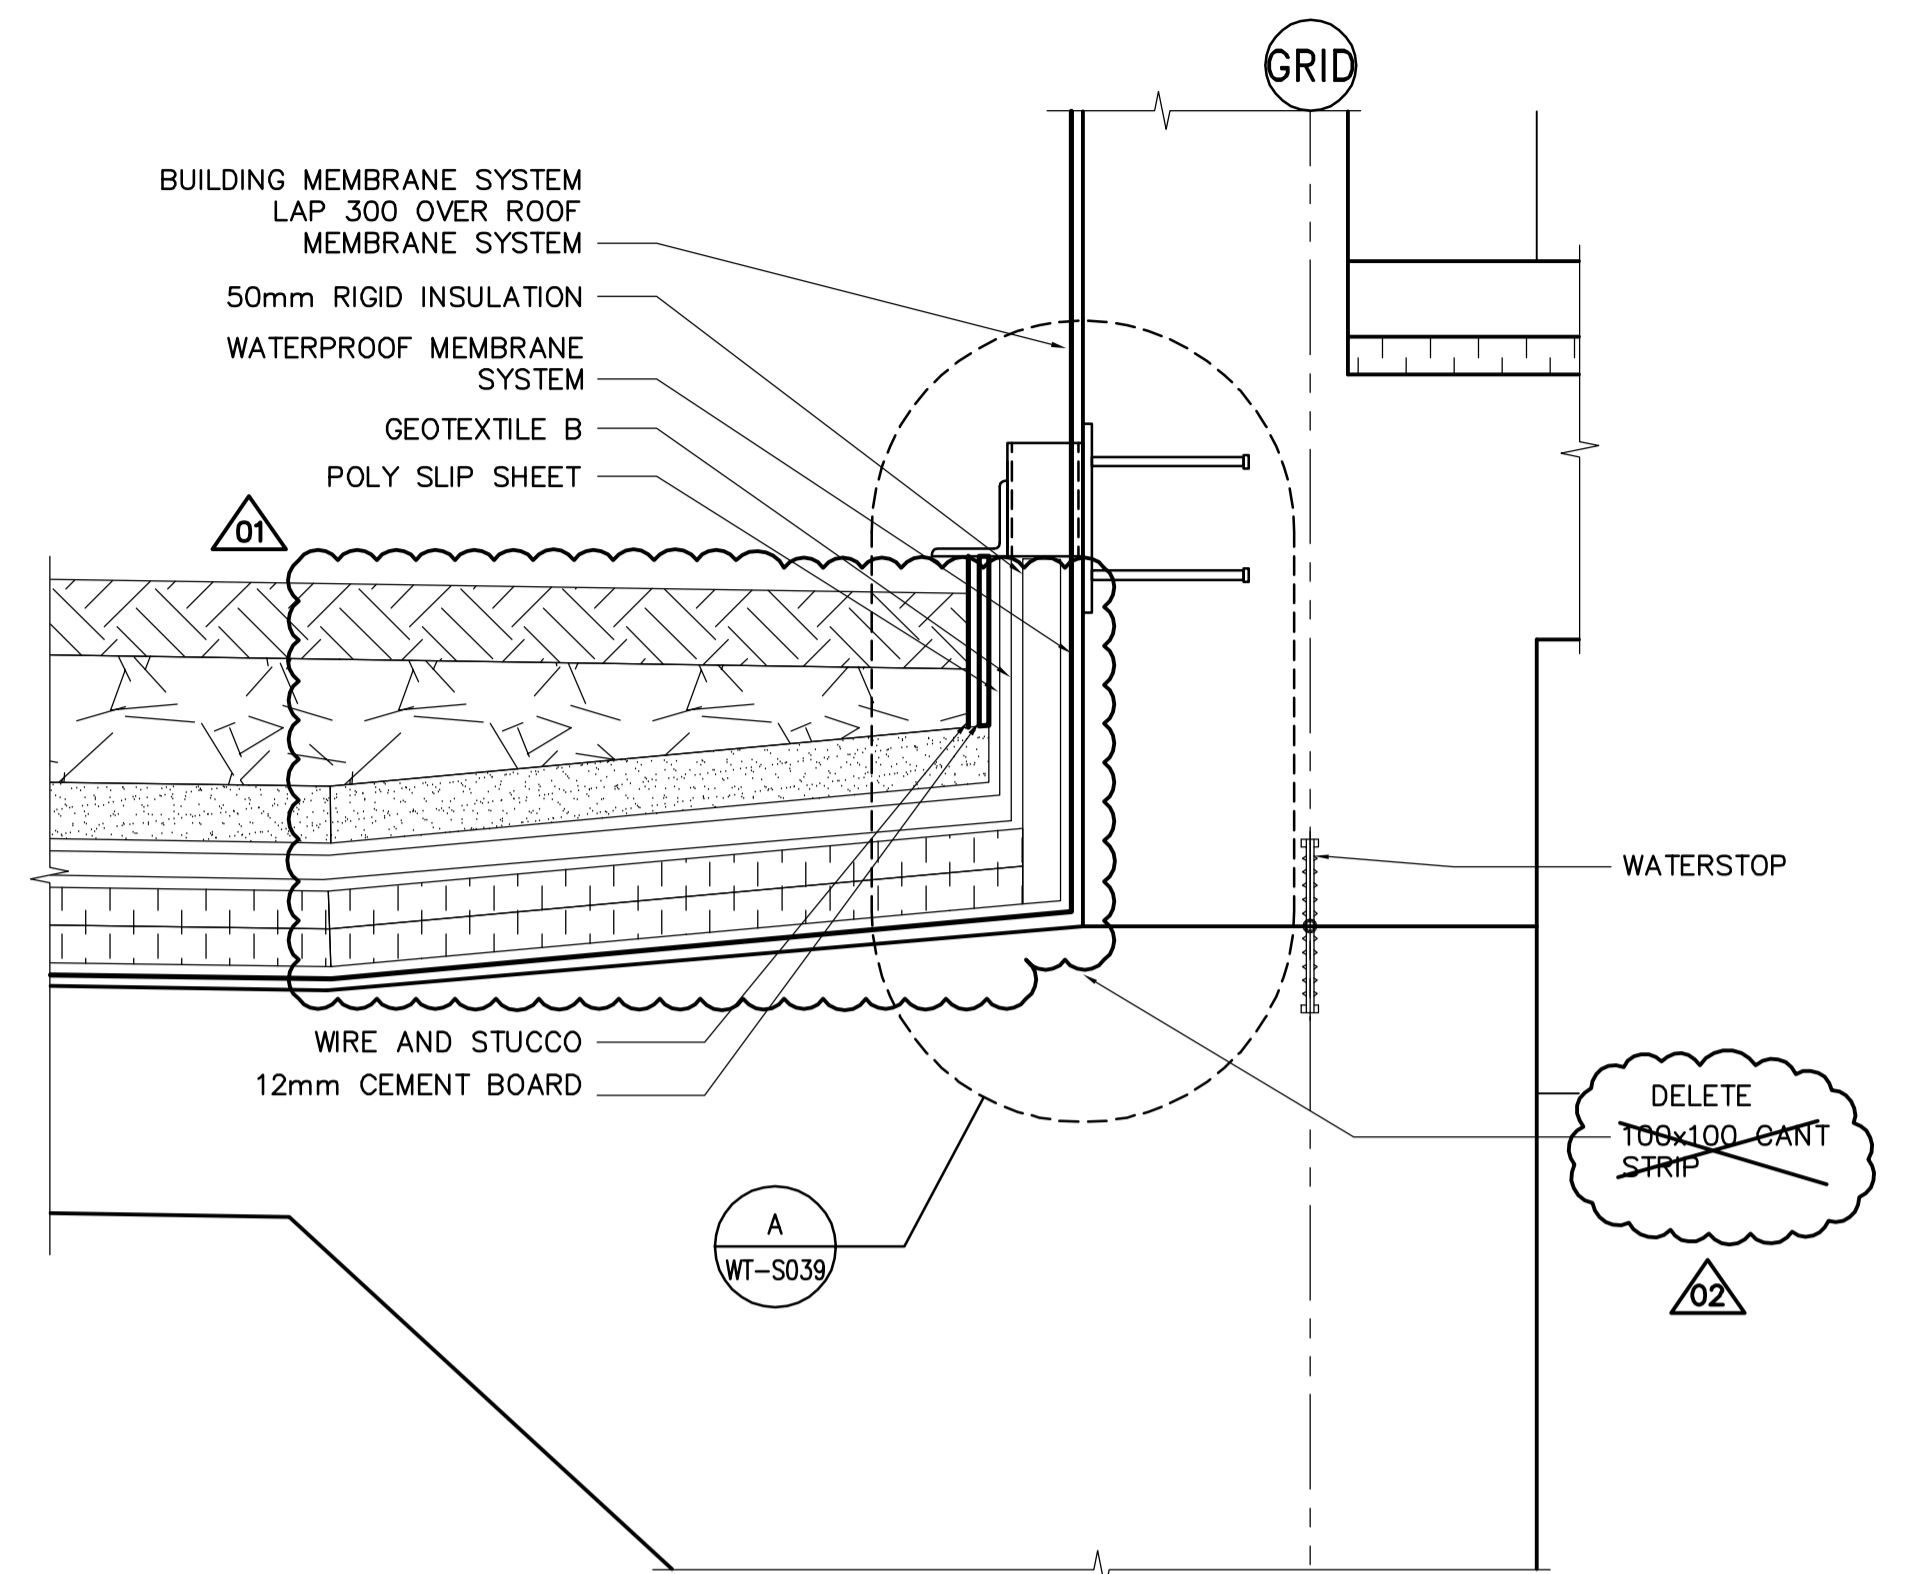

**3** SECTION  
WT-S038 1:10

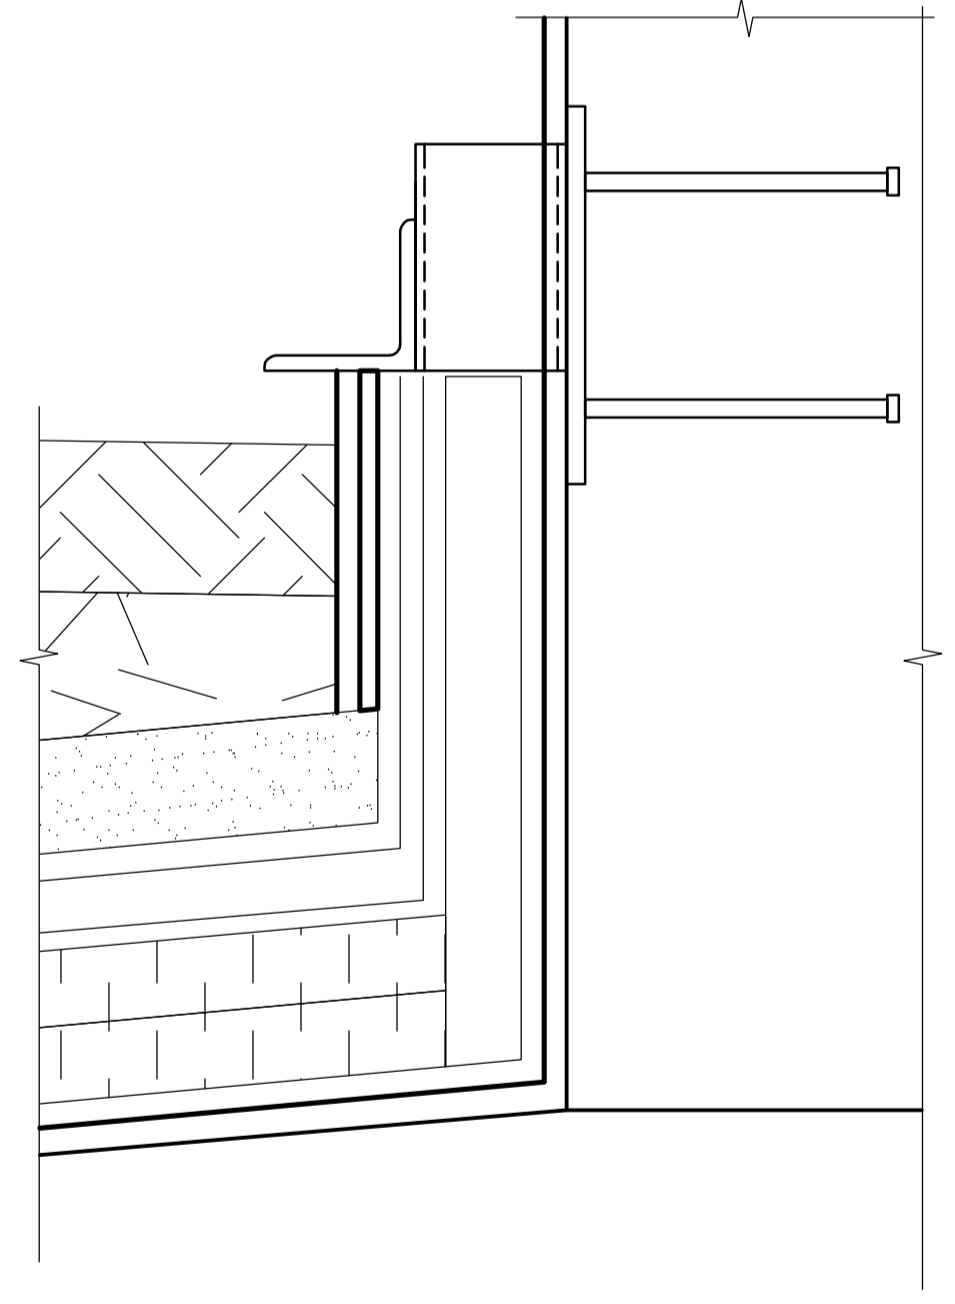

**A** DETAIL  
WT-S038 1:5

**INFORMATION ONLY**

**APEGM**  
Certificate of Authorization  
Earth Tech Canada Inc.  
No. 730 Expiry: April 30, 2006

NO.	REVISIONS	DATE	BY
03	ISSUED FOR CONSTRUCTION	05/06/08	C.T.
02	166-2005 ADDENDUM 2	05/05/12	C.T.
01	166-2005 ADDENDUM 1	05/05/06	C.T.
00	ISSUED FOR TENDER	05/04/17	C.T.

DESIGNED BY	CHECKED BY	DRAWN BY	APPROVED BY
FK	MK	C.T. / WDB	AHL

HOR. SCALE: AS NOTED  
VERTICAL SCALE:

RELEASED FOR CONSTRUCTION BY:  
**R. SOROKOWSKI**

DATE 2005/03/09 DATE 2005-04-17

ENGINEER'S SEAL  
ORIGINAL SIGNED BY  
F.A. KEMP  
2005/04/17  
CONSULTANT DRAWING NO.  
WT-S039

**THE CITY OF WINNIPEG**  
WATER AND WASTE DEPARTMENT  
ENGINEERING DIVISION

**WATER TREATMENT PLANT CLEARWELL CONSTRUCTION**

STRUCTURAL ROOF DRAINAGE SECTIONS AND DETAILS

CITY FILE NUMBER  
SHEET OF  
CITY DRAWING NUMBER  
**1-060T-A-S0039-001-03D**