



STARTER UNIT

FIELD

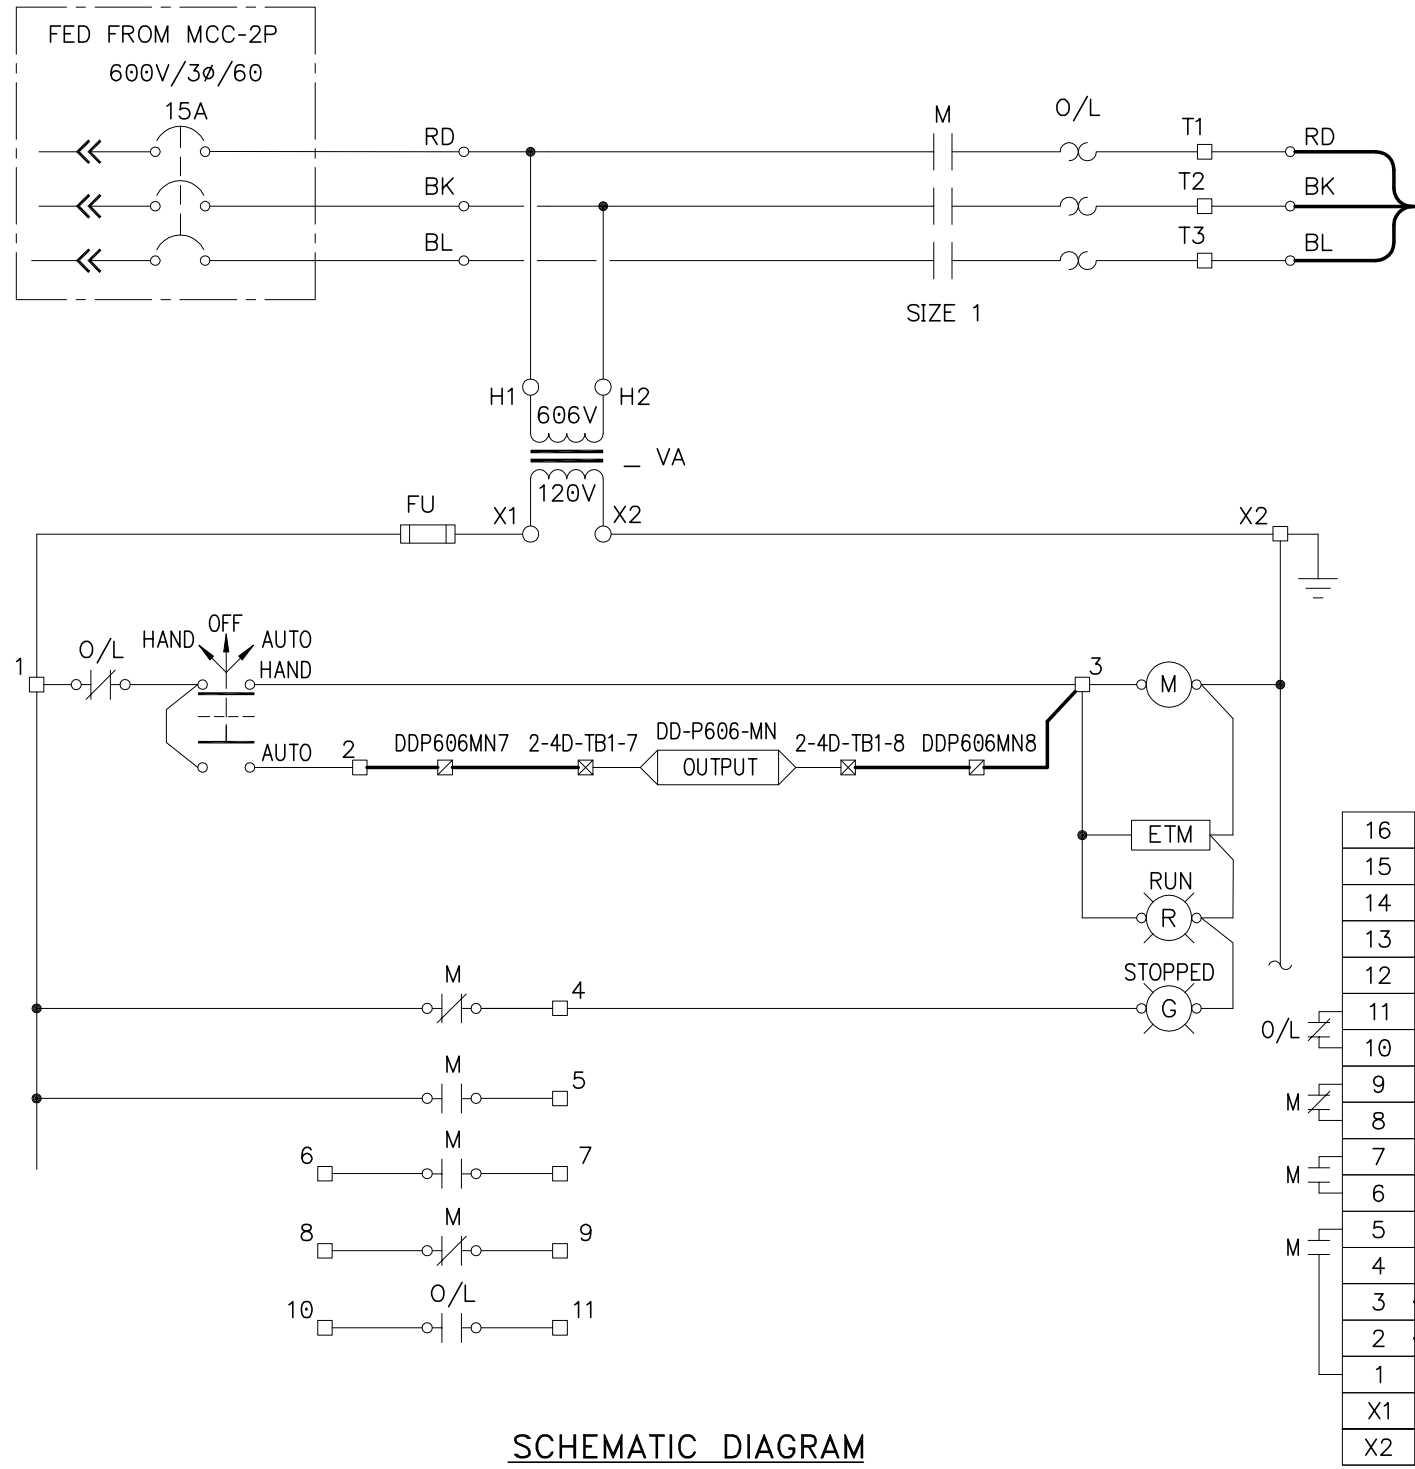

SCHEMATIC DIAGRAM

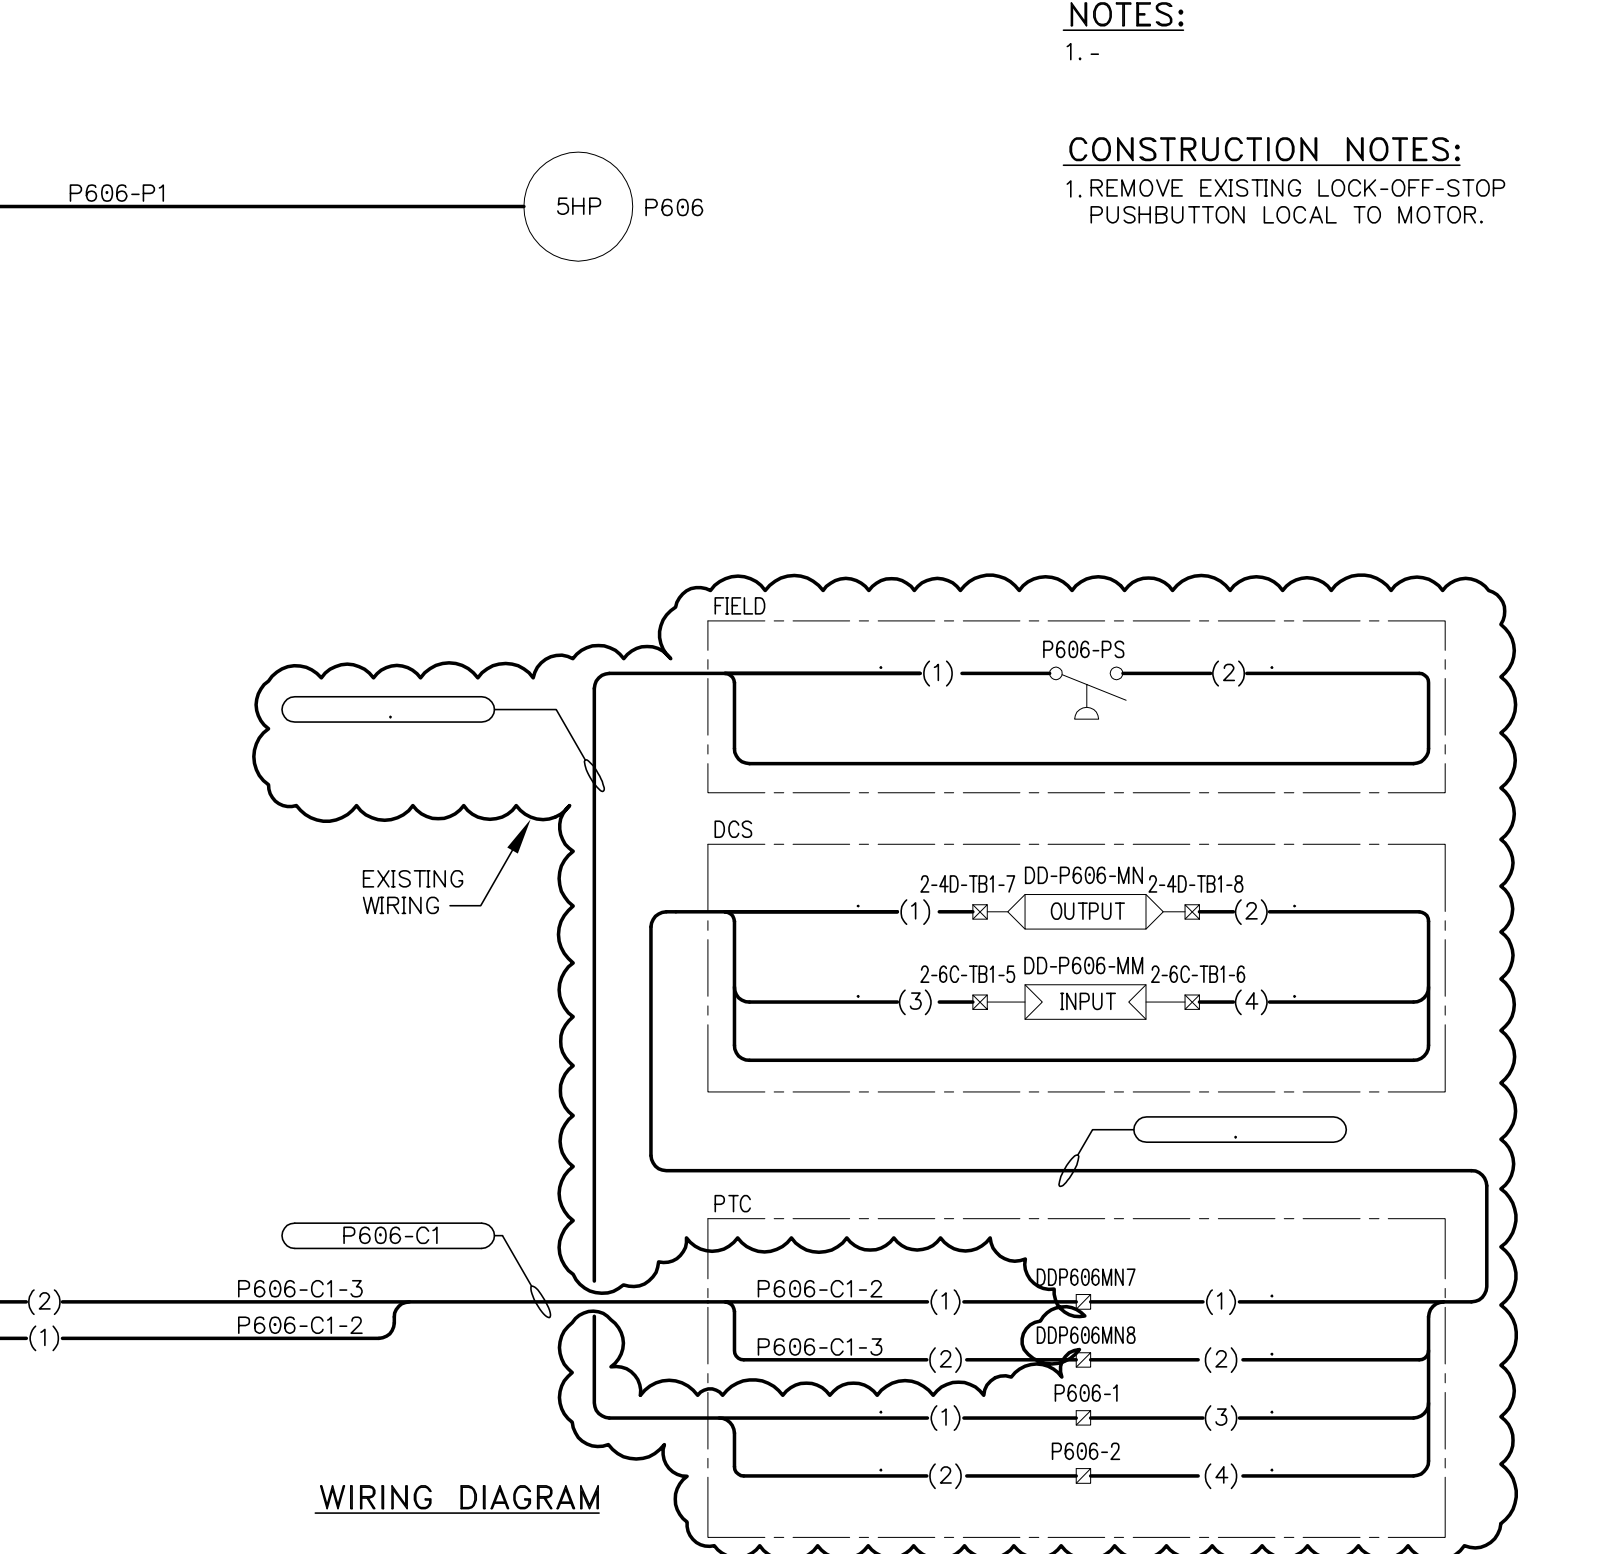

WIRING DIAGRAM

NOTES:

1. -

CONSTRUCTION NOTES:

1. REMOVE EXISTING LOCK-OFF-STOP PUSHBUTTON LOCAL TO MOTOR.

LEGEND

- () CONDUCTOR IDENTIFICATION
- STARTER TERMINALS
- ⊠ DCS TERMINALS
- ⊡ PTC TERMINALS
- FIELD WIRING
- PANEL WIRING
- WIRE CONNECTION
- PILOT LIGHT
- ETM ELAPSED TIME METER



B.M. ELEV.	FIELD BOOK #:	KGS GROUP CONSULTING ENGINEERS & PROJECT MANAGERS	CH2MHILL	ENGINEER'S SEAL	THE CITY OF WINNIPEG WATER AND WASTE DEPARTMENT
POSTED TO LBIS				PROVINCE OF MANITOBA REGISTERED PROFESSIONAL ENGINEER R.E. WILLMS	
DESIGNED BY	DDW	CHECKED BY	REW	TENDER No: 25-2008 FILENAME: 1-0101P-E0026-001 PLOT DATE: 15/02/08	NORTH END WATER POLLUTION CONTROL CENTRE MOTOR STARTER P606-2PF26 WINTER EXHAUST FAN 2 CLARIFIERS 4 & 5
DRAWN BY	GCN	APPROVED BY	.		
HOR. SCALE	N.T.S.	RELEASED FOR CONSTRUCTION			
NO. REVISIONS	DATE	DATE	DATE	19/01/07	SHEET 001 OF 001 CITY DRAWING NUMBER 1-0101P-E0026-001