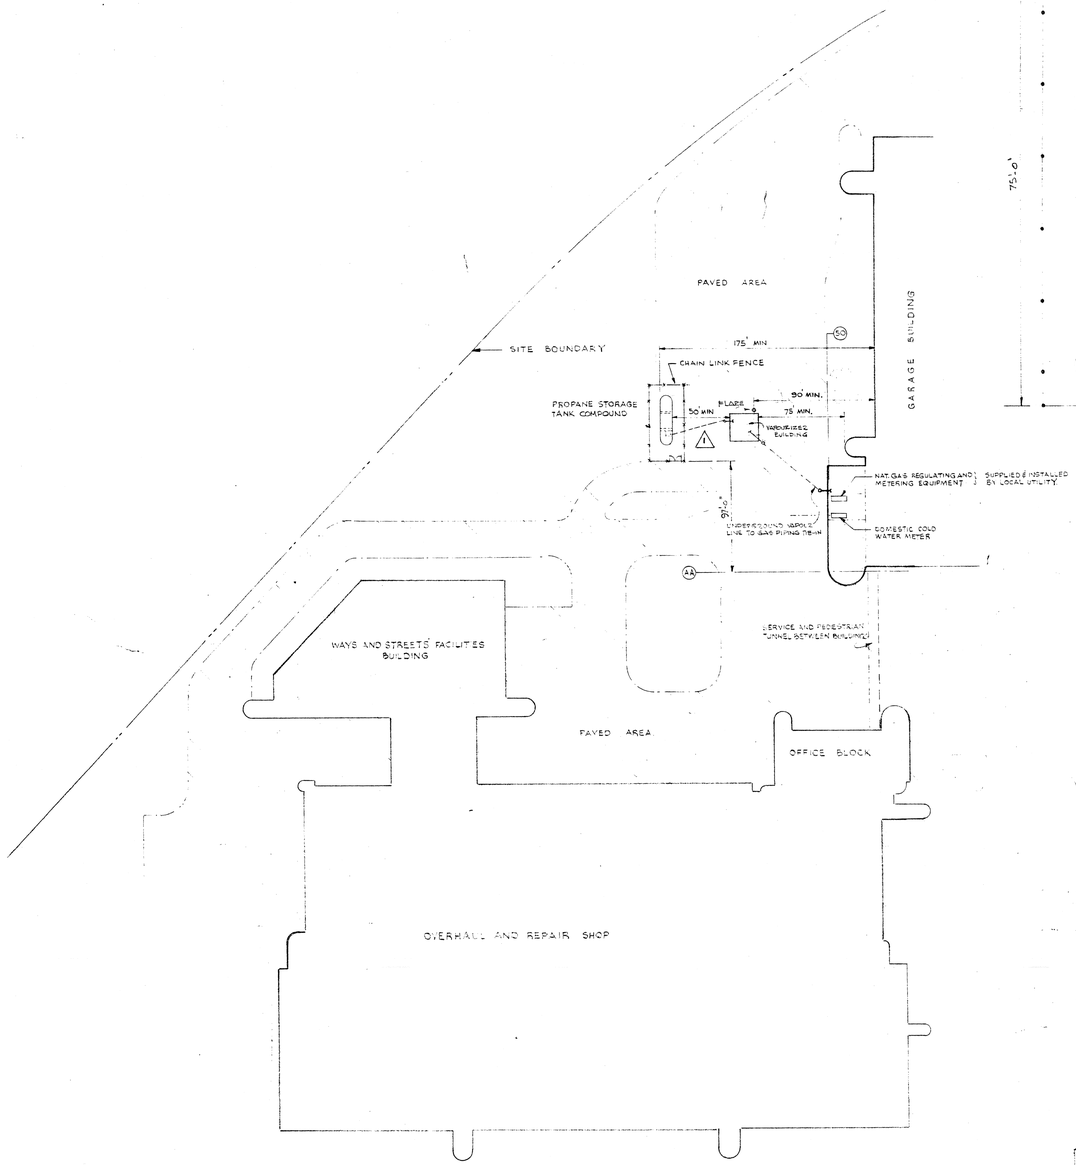

PARTIAL SITE PLAN
SCALE 1" = 50'-0"

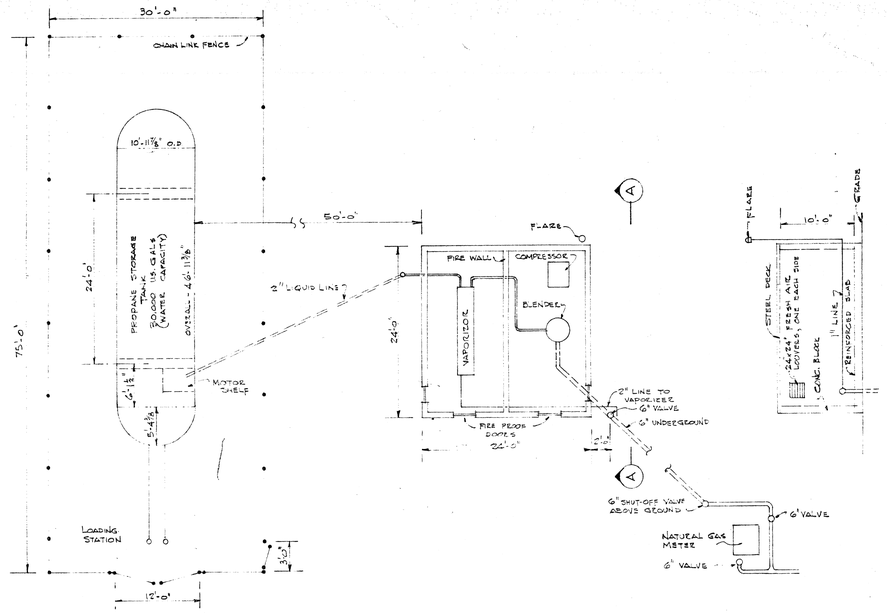

LAYOUT of PROPANE-AIR-PLANT
SCALE 1/8" = 1'-0"

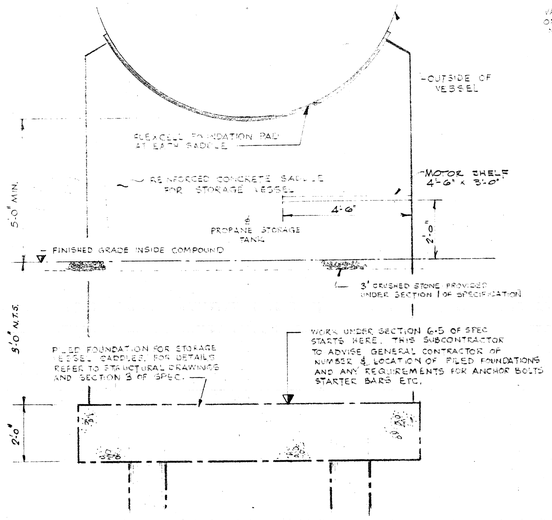

PROPANE STORAGE TANK FOUNDATION DETAIL

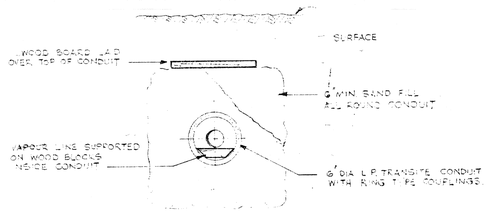

DETAIL OF BURIED VAPOUR LINE
SCALE 1/2" = 1'-0"

2185-651

MECHANICAL
J. T. F. THORPE
PROFESSIONAL ENGINEER
PROVINCE OF MANITOBA

LICENSED TO PRACTICE IN THE PROVINCE OF MANITOBA
My Licence Expires 10 Jan. 1968

DATE	ISSUE No.	REV. No.	DESCRIPTION	DRAWN BY
26 OCT 67	5		AS BUILT.	M.H.G.
17 MAY 68	4	1	LAYOUT AT PROPANE TANK COMPOUND REVISED PER BKTS & PROV. DEPT OF LABOUR APPROVAL	
21/5/67	3	0	FOR CONSTRUCTION	
19 JAN. 68	2	0	FOR TENDER	
20 OCT 67	1	0	FOR APPROVAL	

ISSUE OR REVISION

METROPOLITAN CORPORATION OF GREATER WINNIPEG
STREETS AND TRANSIT DIVISION

TRANSIT STORAGE AND SHOP FACILITIES

BULK PROPANE STORAGE FACILITIES

CONSULTING PROFESSIONAL ENGINEERS
A. D. MARGISON AND ASSOCIATES LIMITED
1155 LESLIE STREET, DON MILLS, ONTARIO

ARCHITECTS
Waisman Ross • Blankstein Coop Gillmor Hanna
10 DONALD STREET, WINNIPEG, MANITOBA

APPROVED
DEPUTY DIRECTOR OF STREETS AND TRANSIT

DRAWN BY
CHECKED J.T.T.
FILE No.
SHEET No.

DATE AUGUST '67
SCALE AS SHOWN
DRAWING No. 2185-651
MECHANICAL