


DEMOLITION NOTES:

- ① EXISTING TREES TO BE PROTECTED.
- ② EXISTING TREES TO BE REMOVED.
- ③ EXISTING SHRUBS TO BE REMOVED.
- ④ EXISTING SOD TO BE REMOVED.
- ⑤ EXISTING SOD TO BE PROTECTED.
- ⑥ EXISTING FENCE AND WALL TO BE PROTECTED.
- ⑦ EXISTING FENCE TO BE REMOVED.
- ⑧ EXISTING STRUCTURES TO BE PROTECTED AND POWERWASHED TO REMOVE DIRT AND GRAFFITI.
- ⑨ EXISTING LIGHT STANDARD TO BE REMOVED. - SEE ELEC.
- ⑩ EXISTING TRASH RECEPTACLE TO BE RELOCATED PER CWPG.
- ⑪ EXISTING TRAFFIC SIGNAL TO BE PROTECTED.
- ⑫ EXISTING PHONE BOOTH AND CONCRETE PAD TO BE REMOVED. CONTRACTOR TO CONTACT MTS FOR INSTRUCTIONS.
- ⑬ EXISTING CONCRETE PAD TO BE REMOVED.
- ⑭ EXISTING CONCRETE SIDEWALK TO BE PROTECTED.
- ⑮ EXISTING CONCRETE PLANTER TO BE PROTECTED.
- ⑯ EXISTING CONCRETE CURB TO BE PROTECTED AND POWERWASHED TO REMOVE DIRT AND GRAFFITI.
- ⑰ EXISTING WALKWAY TO BE REMOVED.
- ⑱ EXISTING VALVE TO BE PROTECTED.
- ⑲ EXISTING LIGHT BOLLARDS TO BE REMOVED AND REINSTALLED IN THE SAME LOCATION. PROTECT EXISTING WIRING

REVISION #1

REVISION #1

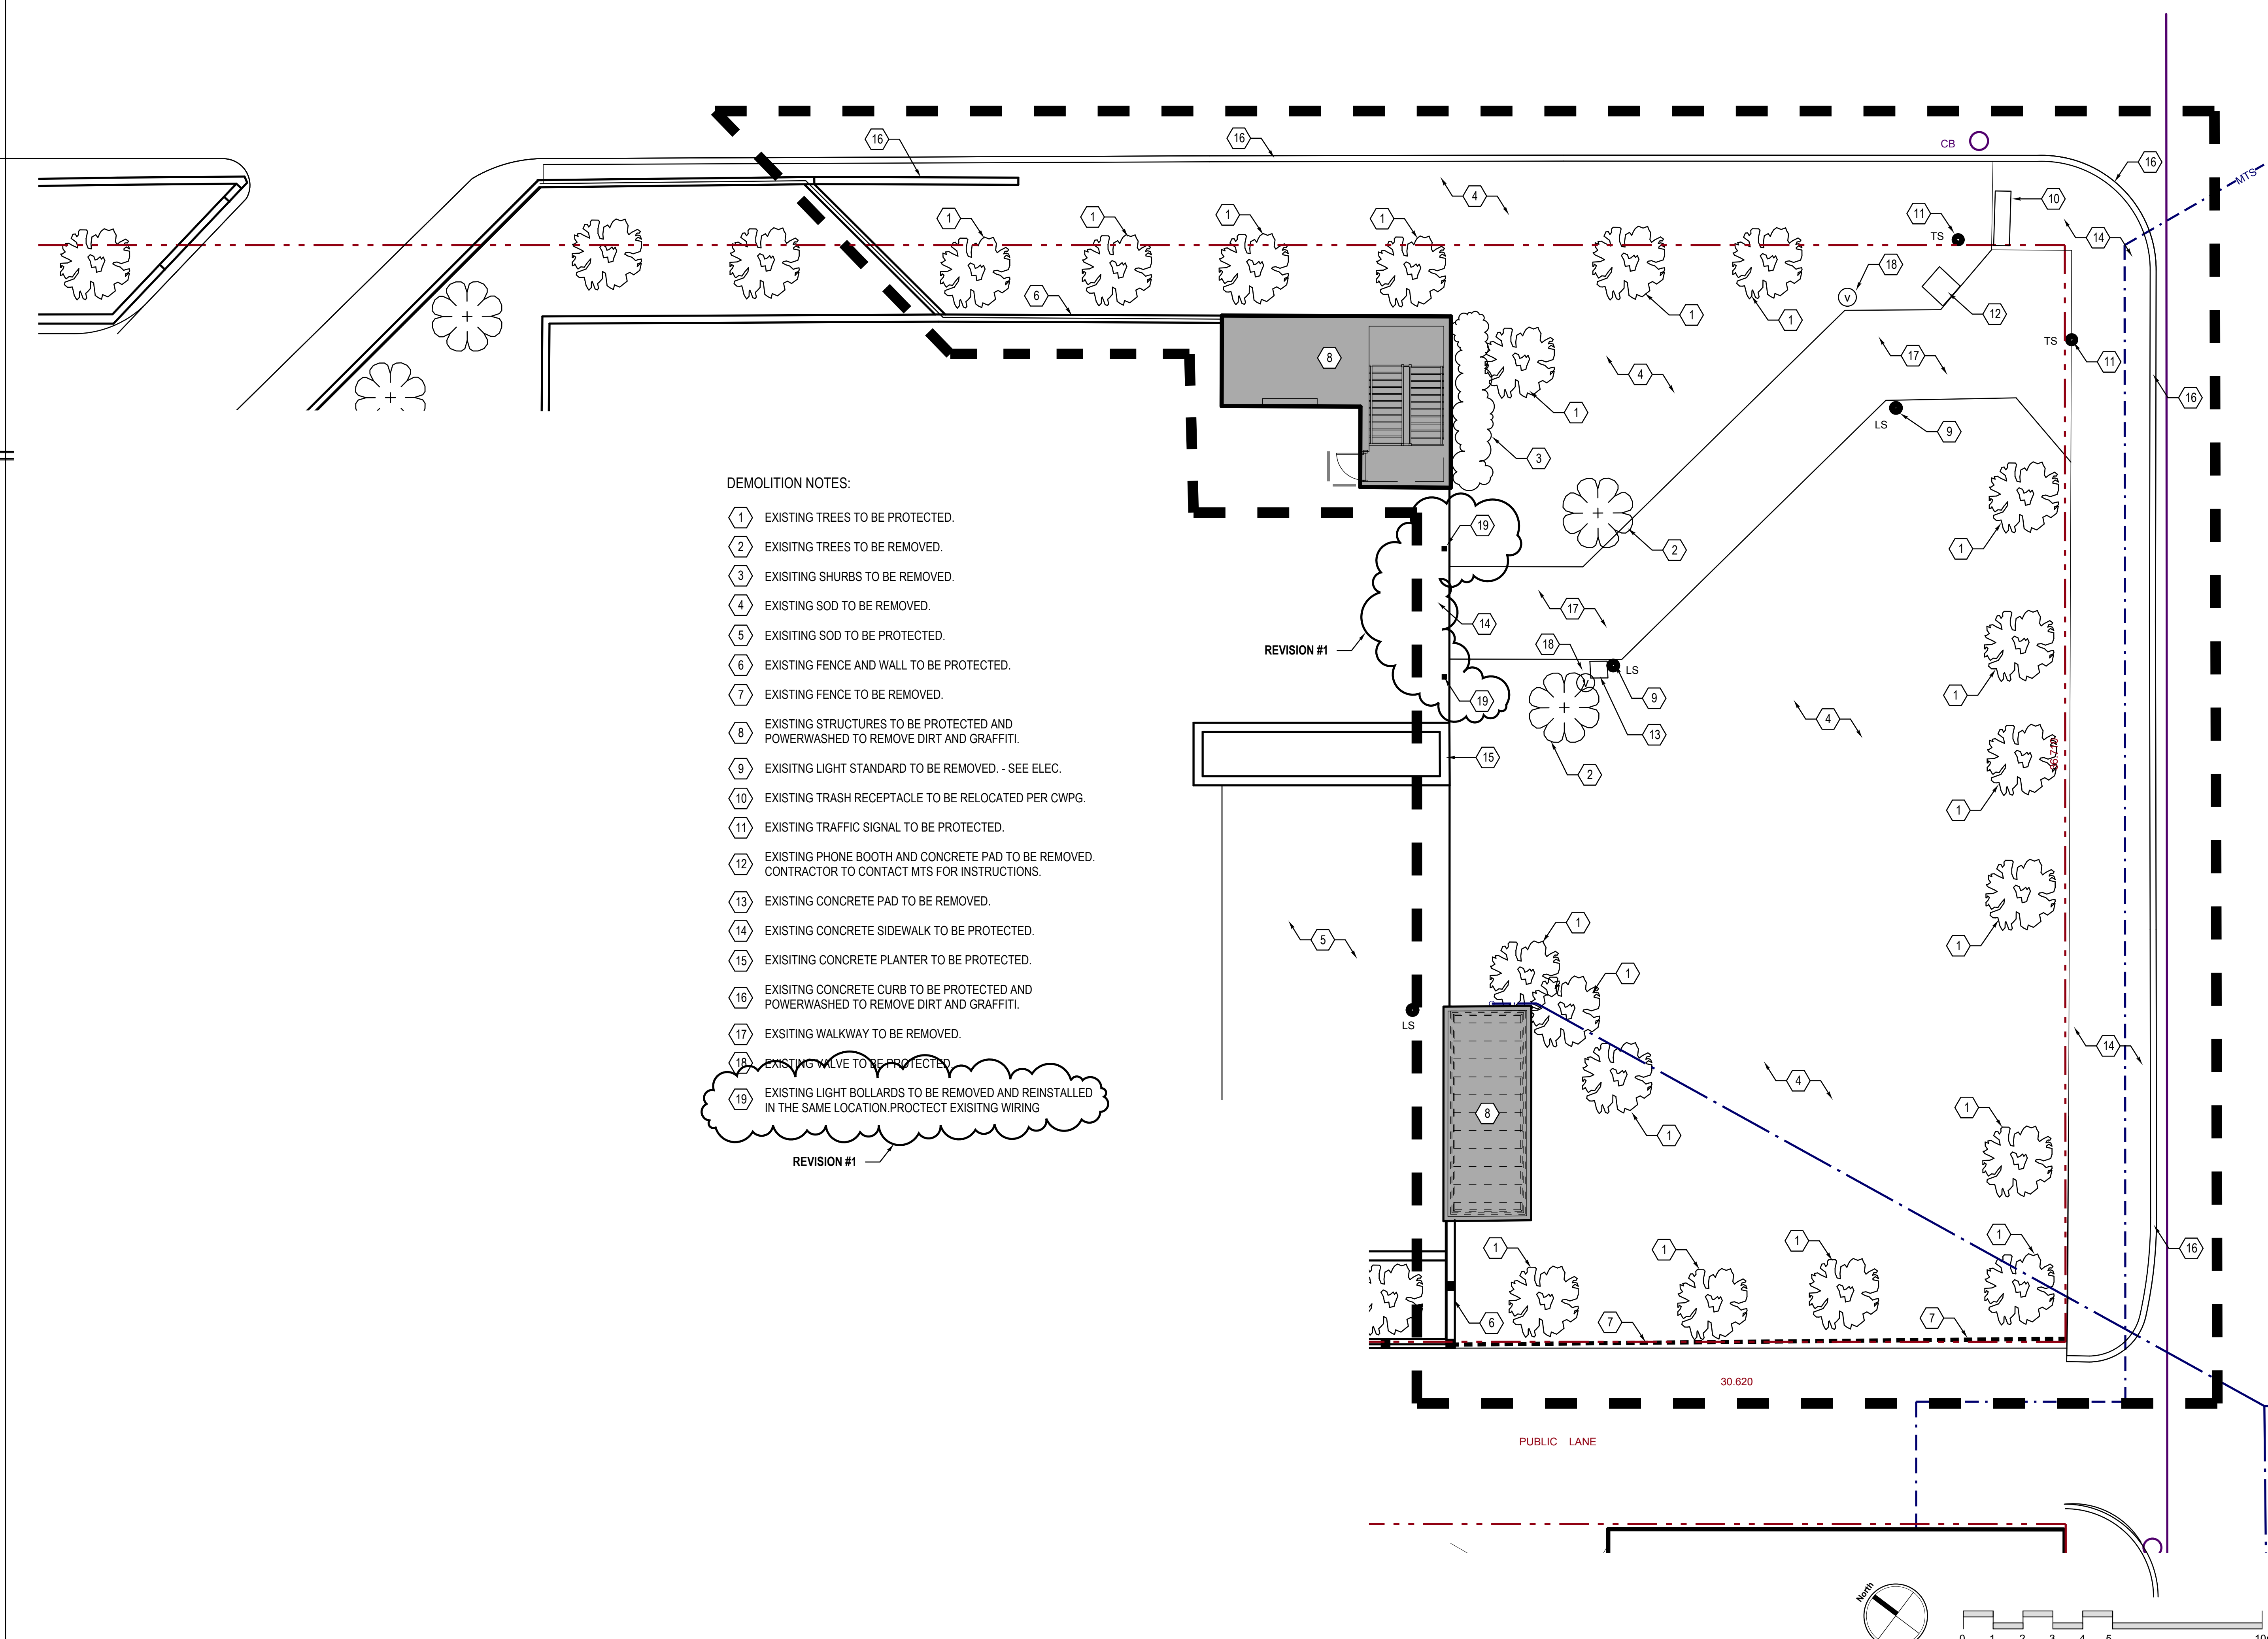

2 - ISSUED FOR ADDENDUM #1 JULY 7, 2014

1 - ISSUED FOR TENDER JUNE 16, 2014

ISSUE NOTES	DATE

THIS DRAWING MUST NOT BE SCALED.  
 THE GENERAL CONTRACTOR SHALL VERIFY ALL DIMENSIONS, DATUMS AND LEVELS PRIOR TO COMMENCEMENT OF WORK. ALL ERRORS AND OMISSIONS TO BE REPORTED IMMEDIATELY TO THE LANDSCAPE ARCHITECT.  
 VARIATIONS & MODIFICATIONS TO WORK SHOWN ON THESE DRAWINGS SHALL NOT BE CARRIED OUT WITHOUT WRITTEN PERMISSION FROM THE LANDSCAPE ARCHITECT.

THIS DRAWING IS THE EXCLUSIVE PROPERTY OF THE LANDSCAPE ARCHITECTS AND CAN BE REPRODUCED ONLY WITH THE PERMISSION OF THE LANDSCAPE ARCHITECTS, IN WHICH CASE THE REPRODUCTION MUST BEAR THEIR NAME AS LANDSCAPE ARCHITECTS.

PROFESSIONAL SEALS

**HTFC**  
 PLANNING & DESIGN  
 500-115 Bannatyne Avenue East Winnipeg, MB R3B 0R3  
 PHONE 204 944 9907 WEB htfc.mb.ca

PROJECT TITLE  
**MILLENNIUM LIBRARY PARK  
 PHASE TWO  
 - ST MARY & SMITH ENTRANCE**  
 WINNIPEG, MANITOBA

SHEET TITLE  
**DEMOLITION PLAN**

DRAWN <b>RG</b>	REVIEWED <b>MG</b>	DRAWING NO. <b>L1.0</b>
SCALE <b>1:100</b>	PROJECT No. <b>14-020</b>	

DATE PRINTED  
 11:41 AM Mon, Jul 7, 2014

**PRELIMINARY - NOT FOR CONSTRUCTION**