


EXISTING	LEGEND-PLAN	PROPOSED	EXISTING	LEGEND-PLAN	PROPOSED	EXISTING	LEGEND-PLAN	PROPOSED
150 WM	WATERMAIN	150 WM	SWALE	MANHOLE	RIGHT-OF-WAY	300 LDS	LAND DRAINAGE SEWER	300 LDS
400 FM	FEEDERMAIN	400 FM	CATCHBASIN	HYDRO BOX	GAS	250 WWS	WASTEWATER SEWER	250 WWS
300 CS	COMBINED SEWER	300 CS	HYDRO POLE	ANCHOR	HYDRO	300 CS	COMBINED SEWER	300 CS
200 FCM	FORCEMAIN	200 FCM	LIGHT STANDARD	TREE	MTS	200 FCM	FORCEMAIN	200 FCM
HYDRANT	HYDRANT	VALVE	SURVEY BAR	CURB	SOD	HYDRANT	HYDRANT	VALVE
CURB STOP	CURB STOP	SIGNAL CONTROLLER	SIGNAL CONTROLLER	ROAD ASPHALT	ELEVATION	CURB STOP	CURB STOP	SIGNAL CONTROLLER
EXISTING	LEGEND-PLAN	PROPOSED	EXISTING	LEGEND-PLAN	PROPOSED	EXISTING	LEGEND-PLAN	PROPOSED

LOCATION APPROVED UNDERGROUND STRUCTURES	DATE
SUPV. U/G STRUCTURES COMMITTEE	

NOTE: LOCATION OF UNDERGROUND STRUCTURES AS SHOWN ARE BASED ON THE BEST INFORMATION AVAILABLE. BUT NO GUARANTEE IS GIVEN THAT ALL EXISTING UTILITIES ARE SHOWN OR THAT THE GIVEN LOCATIONS ARE EXACT. CONFIRMATION OF EXISTENCE AND EXACT LOCATION OF ALL SERVICES MUST BE OBTAINED FROM THE INDIVIDUAL UTILITIES BEFORE PROCEEDING WITH CONSTRUCTION.

NO.	REVISIONS	DATE	BY
1	ISSUED FOR PCN No. 6	19.04.29	DRA

DESIGNED BY	DAL	CHECKED BY	DRA
DRAWN BY	NL	APPROVED BY	EFS
HOR. SCALE:	1 : 250	ACCEPTED BY	DATE
VERTICAL:	1 : 25	ORIGINAL DRAWING SIGNED BY:	D. MUHURDAREVIC, P.ENG.
		DATE	19.04.29

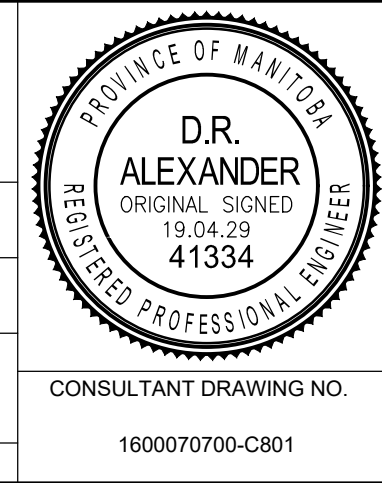

TETRA TECH

THE CITY OF WINNIPEG
PUBLIC WORKS DEPARTMENT
ENGINEERING DIVISION

SASKATCHEWAN AT STURGEON CREEK
BRIDGE CONSTRUCTION

SASKATCHEWAN AVENUE PATHWAY
PLAN AND PROFILE

CITY DRAWING NUMBER: P3487-17-801
SHEET 2 OF 5

CONSULTANT DRAWING NO. 1600070700-C801