


TENDER 763-2020

RENTAL OF OFFICE AND WASHCAR TRAILERS

APPENDIX A WASHCAR TRAILER LAYOUT

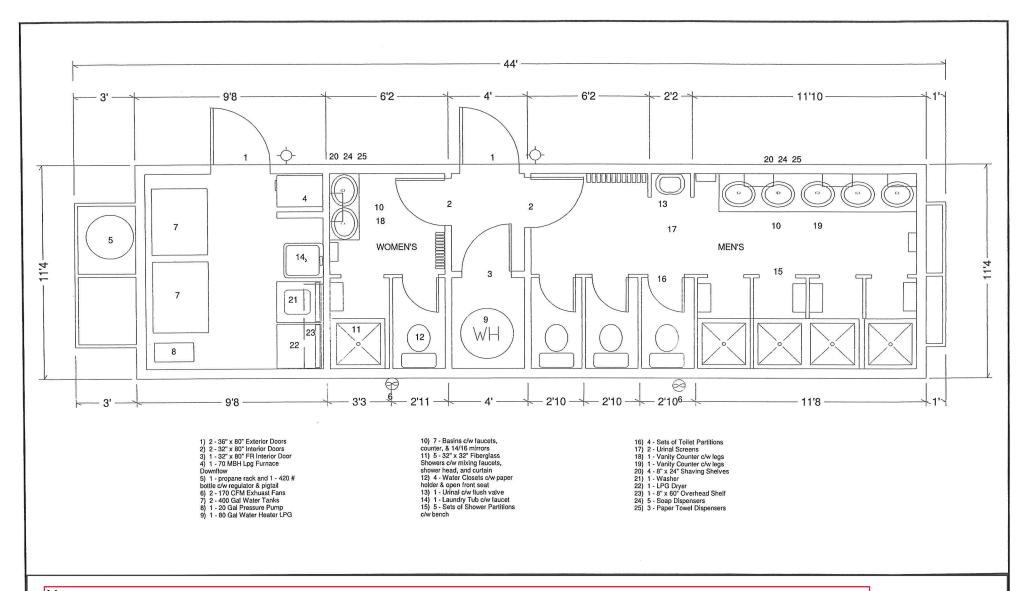

Notes:

1. Remove laundry equipment (washer and dryer) and replace with lockers to hold clothing and footwear etc.